


PLAN	DATE	BY
SURVEYED		
PLOTTED		
NOTE BOOK		
NO.		

PROFILE	DATE	BY
SURVEYED		
PLOTTED		
NOTE BOOK		
NO.		

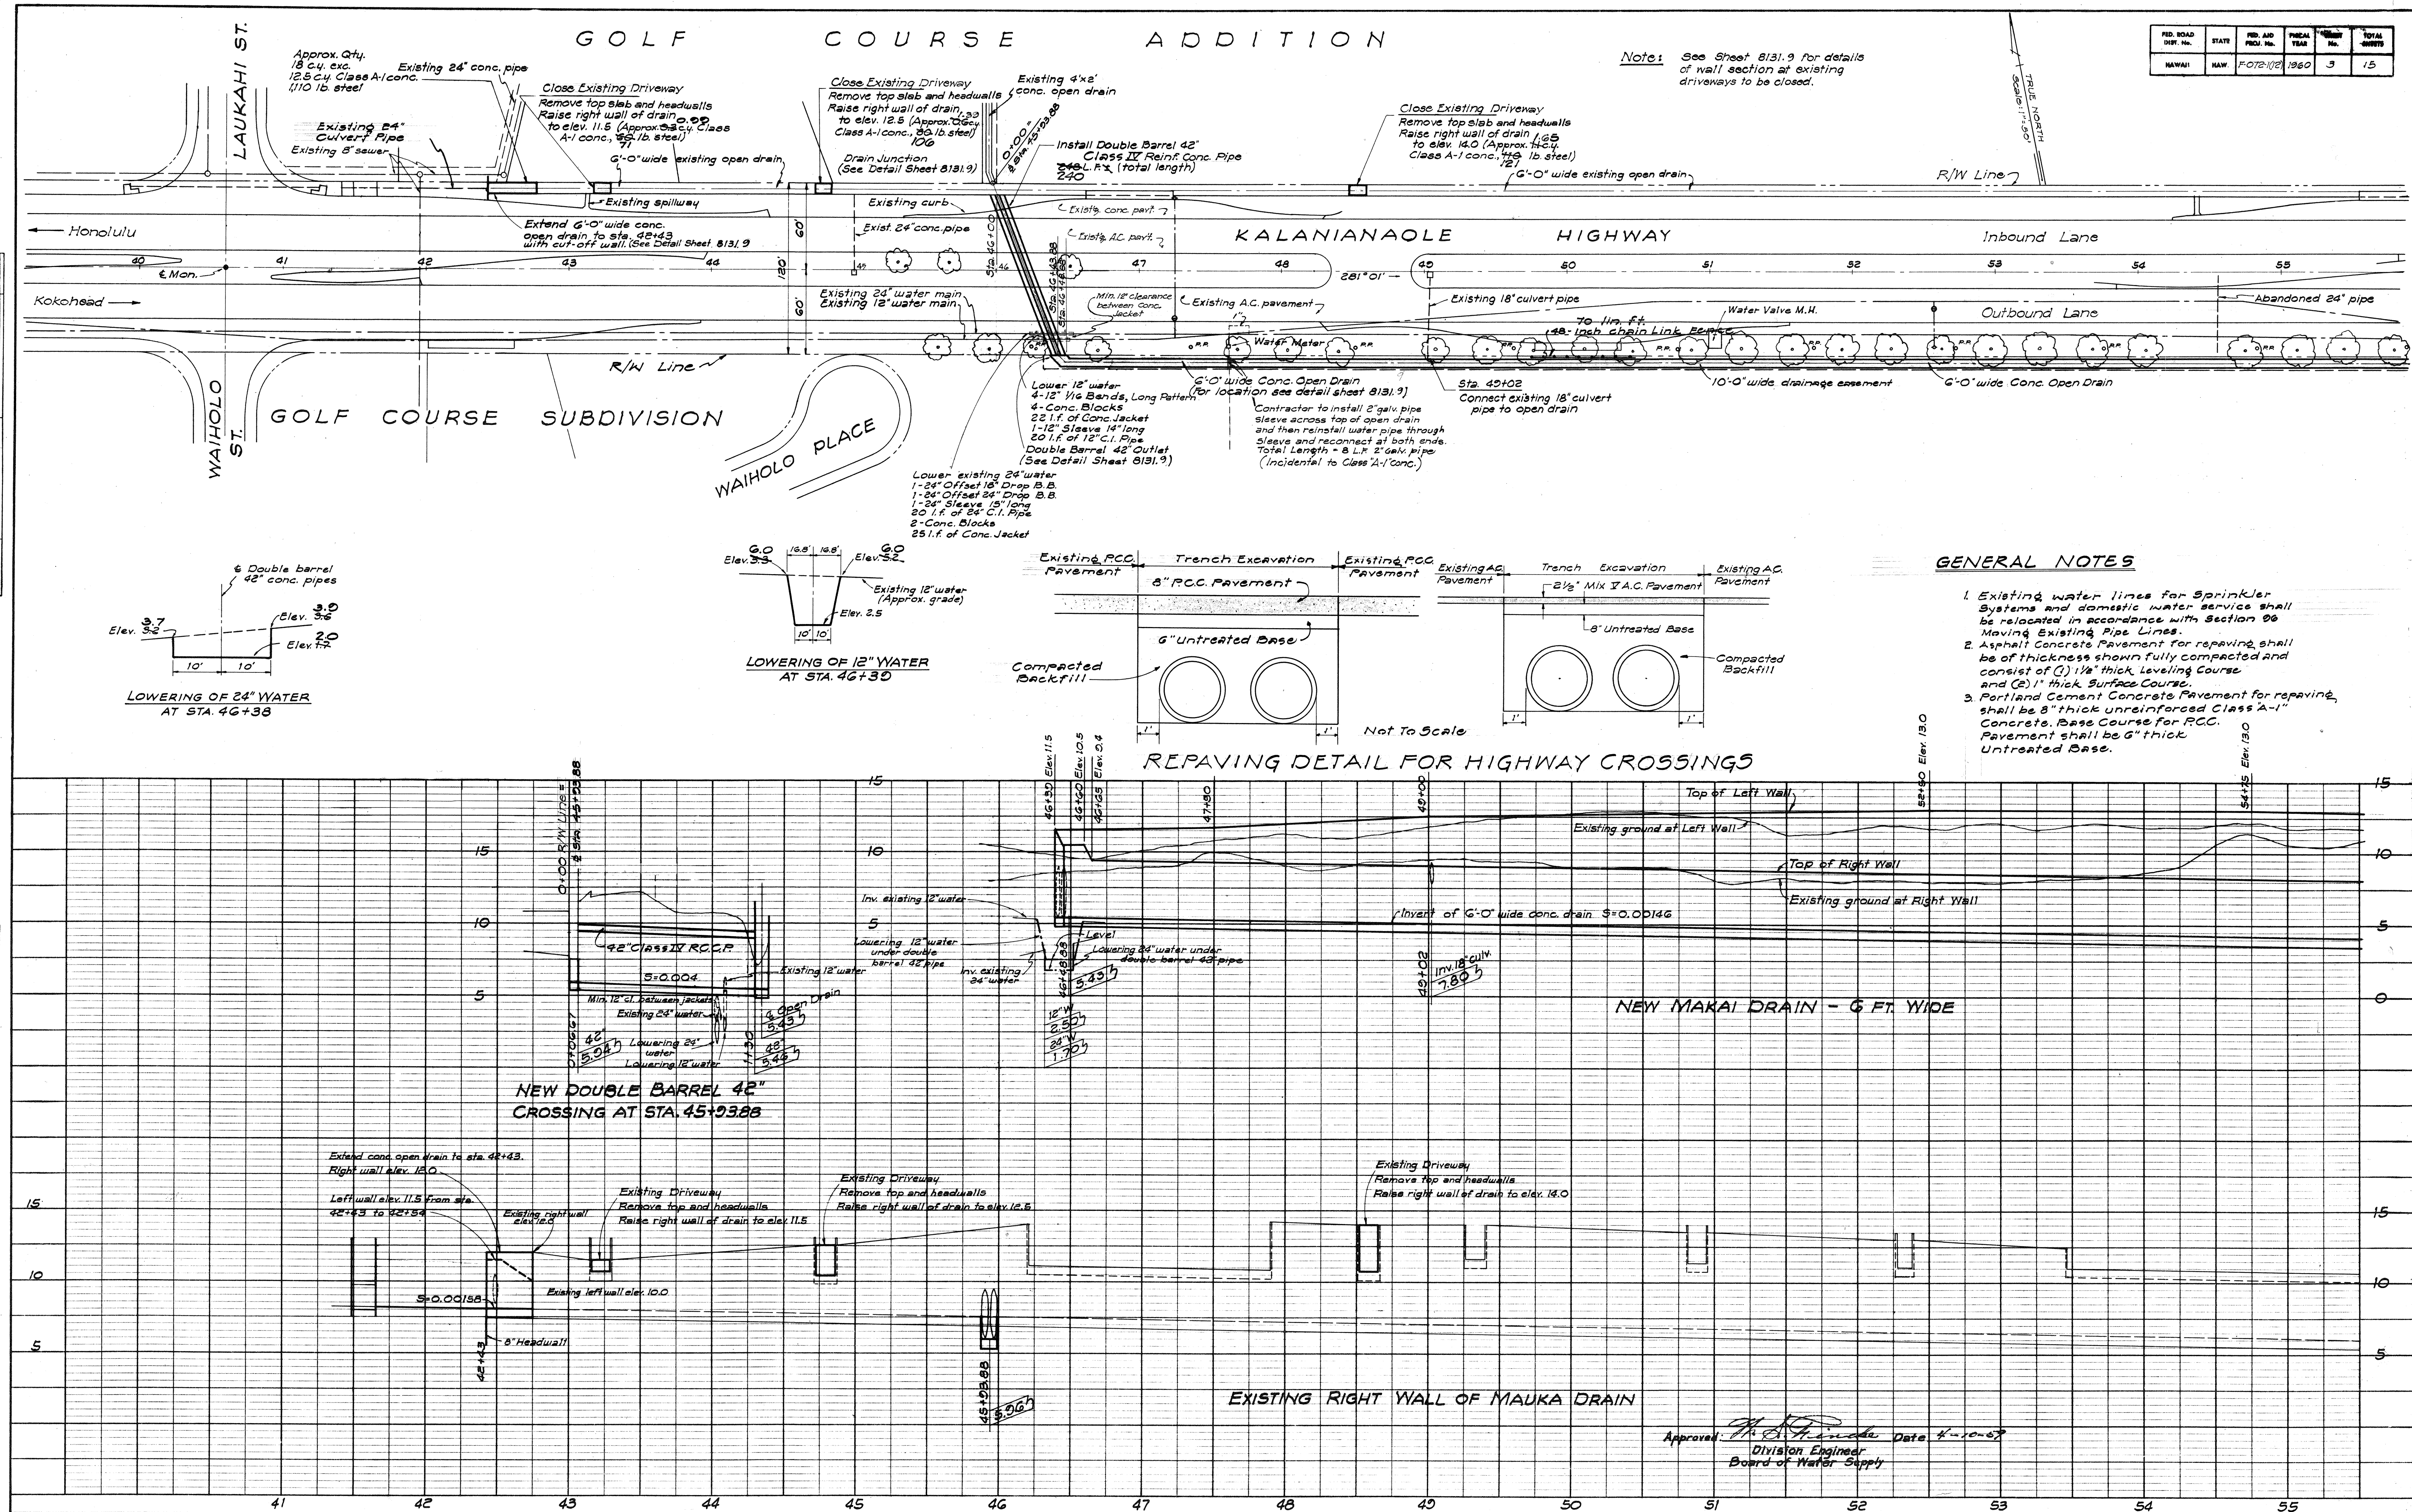

PLAN	SURVEYED	BY	DATE
	PLOTTED ALIGNMENT CHECKED RT. OF WAY CHECKED		
NOTE BOOK			
NO.			

PROFILE				BY	DATE
NOTE BOOK		SURVEYED			
		PLOTTED			
		GRADES CHECKED			
NO.		B. M.'S. NOTED			
		STRUCTURE NOTATIONS CH'KD.			

