SHEET NO. DESCRIPTION

Title Sheet

2-5 Plan & Profile

6-11 Special Drainage Structures

12 IOx5 Conc. Box Culvert
STA. 35+13

Misc. Water Details

14+15 Standard Details

STATE OF HAWAII

HAWAII STATE HIGHWAY DEPARTMENT

HONOLULU, HAWAII

AS — BUILT PLANS OF

KALANIANAOLE HIGHWAY DRAINAGE IMPROVEMENTS

FEDERAL AID PROJECT NO. F-072-1(12)

DISTRICT OF HONOLULU ISLAND OF OAHU

SCALES



PLAN SHEETS IN THIS SET WHICH HAVE BEEN CHANGED INCLUDE NOS. 8131. 2, 2A, 3, 4, 5, 6, 7, 8, 10, 11 & 12.

NOTE:

ALL CHANGES MADE DURING CONSTRUCTION HAVE BEEN NOTED IN RED ON THESE SHEETS AND CHECKED BY:


LOCATION OF PROJECT

CAPOTTONI

for DISTRICT ENGINEER

Jan. 13, 1961

DATE

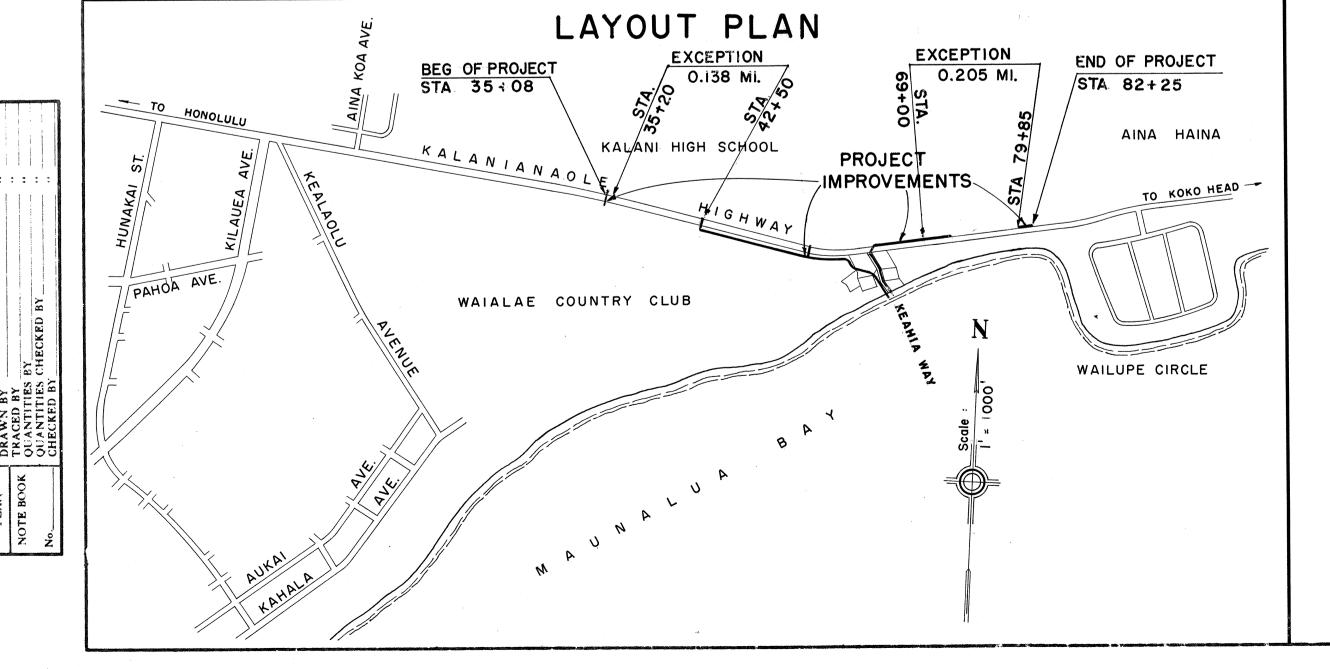

and the first of the second with the

GROSS LENGTH 0.893 MILE EXCEPTION 0.343 MILE NET LENGTH MILE

PROVED Date 4-10-59

Date 4-10-59

STATE HIGHWAY ENGINEER

DEPARTMENT OF COMMERCE
BUREAU OF PUBLIC ROADS

APPROVED:

DIVISION ENGINEER DATE

FED. ROAD STATE FED. AID FISCAL SHEET TOTAL PROJ NO. YEAR NO. SHEETS

HAWAII HAW F-072-1(12) 1960 [15

8131.