



B.M. No. M-2 Elev. 2.54
U.S.G.S. Monument at
Sta. 95+50± Left 150± from C of Road

B.M. No. 8 Elev. 117.28
Top of Spike P.I. No. 4

FED. ROAD DIST. NO.	STATE	PROJ. NO.	FISCAL YEAR	SHEET NO.	TOTAL SHEETS
HAWAII	HAW.	B720161	1961	3	4

PLAN	DATE	BY
SURVEYED		
PLOTTED		
NOTES BOOK		
BY AIR WAY CHECKED		
NO.		

PROFILE	DATE	BY
SURVEYED		
PLOTTED		
NOTES BOOK		
BY AIR WAY CHECKED		
NO.		

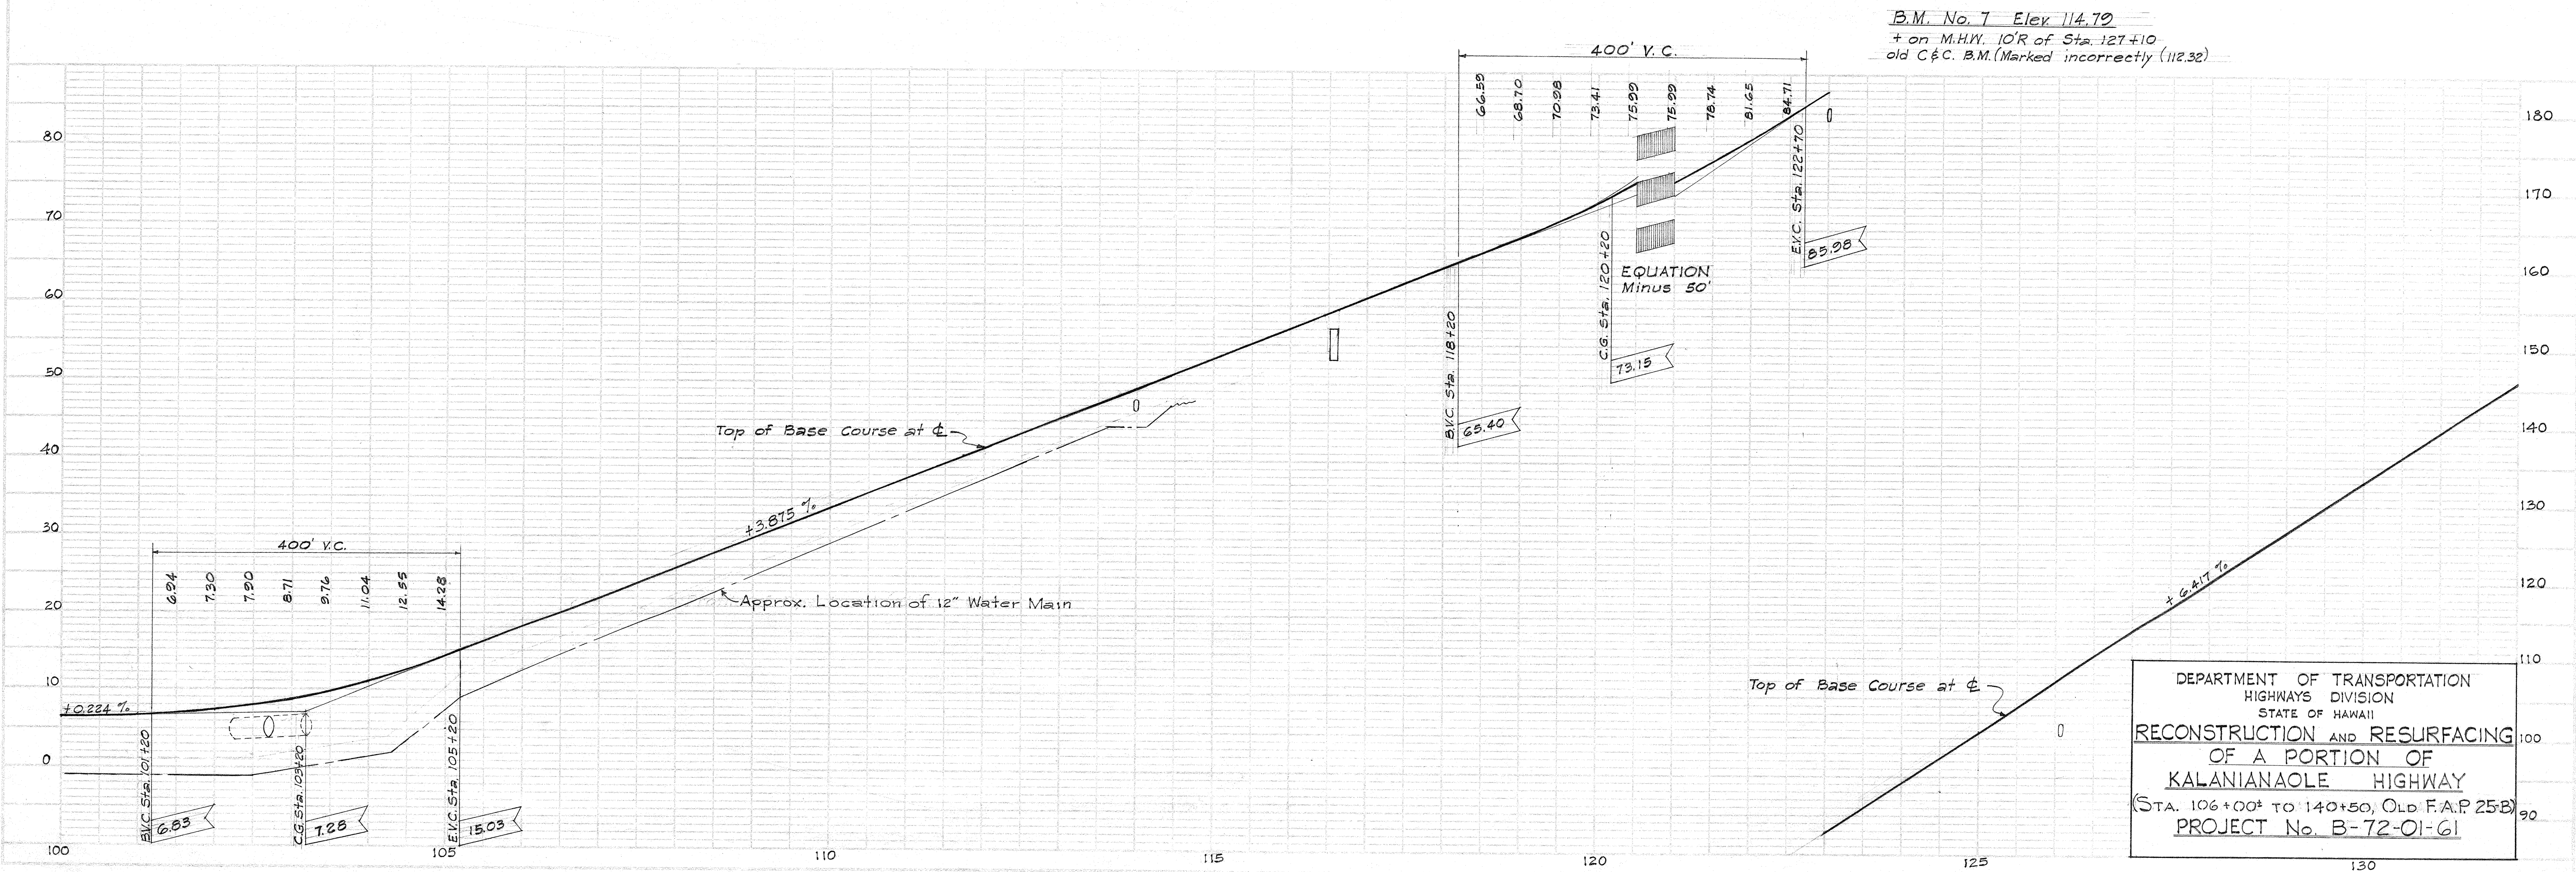
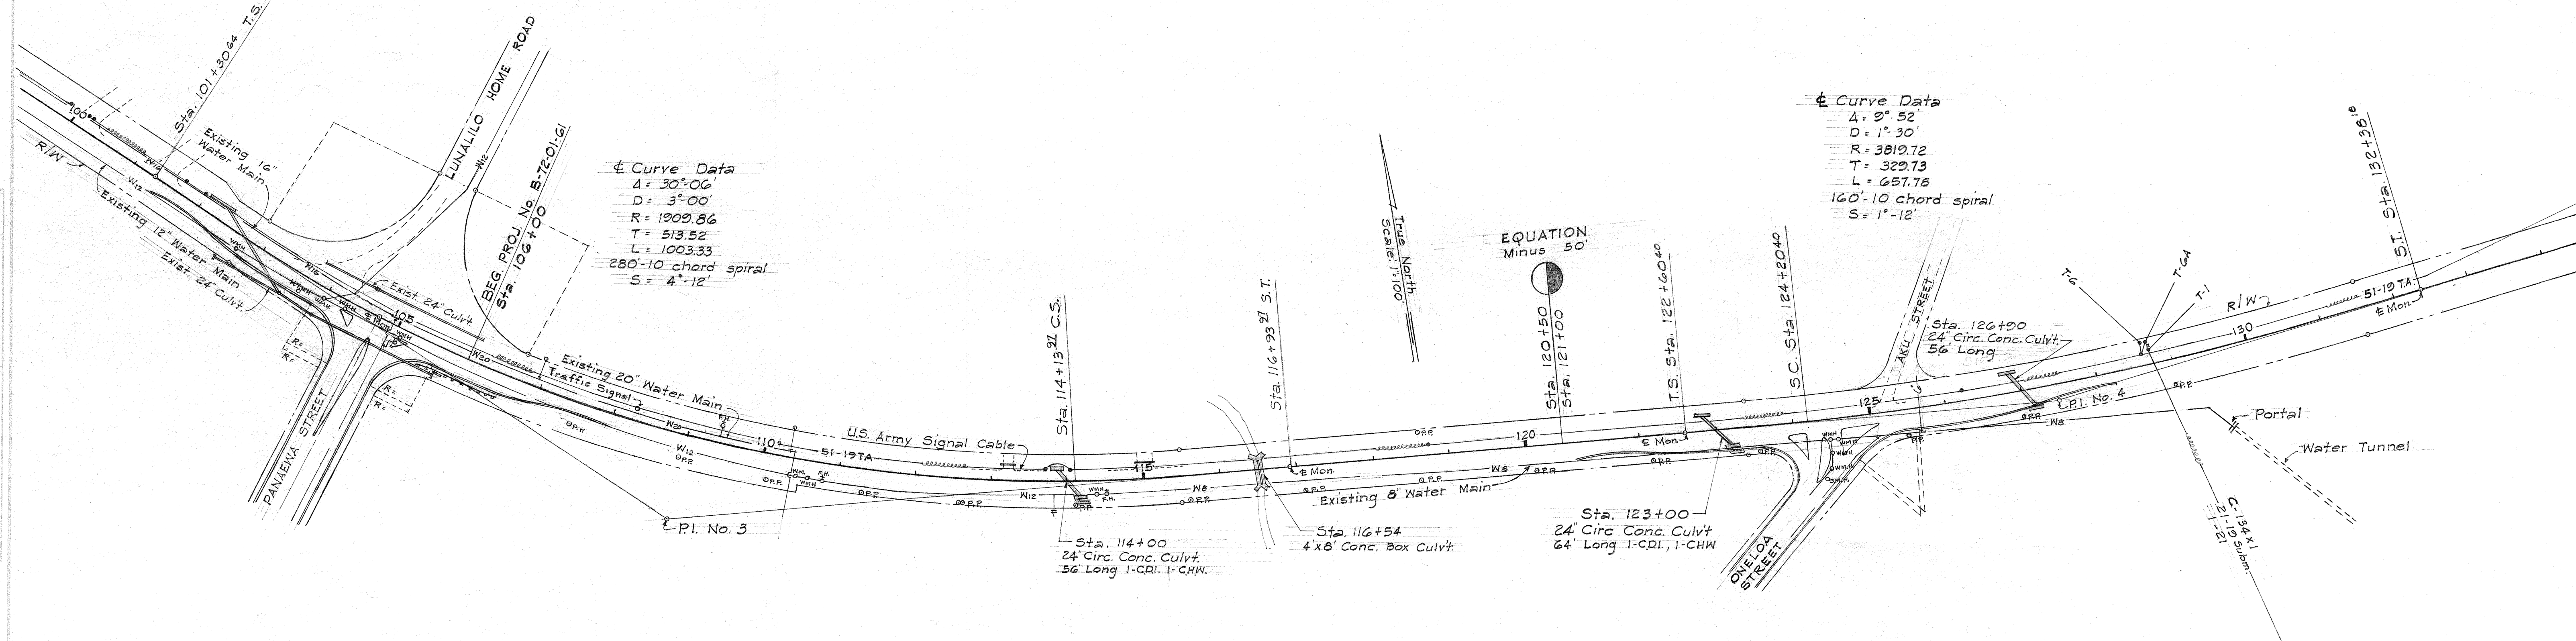


DEPARTMENT OF TRANSPORTATION
HIGHWAYS DIVISION
STATE OF HAWAII
RECONSTRUCTION AND RESURFACING
OF A PORTION OF
KALANIANA'OLE HIGHWAY
(Sta. 106+00± to 140+50, Old F.A.P. 25B)
PROJECT No. B-72-01-G1

FED. ROAD DIST. No.	STATE	PROJ. No.	FISCAL YEAR	SHEET No.	TOTAL SHEETS
HAWAII	HAW.	B720161	1961	4	4

PLAN	SURVEYED	DATE
NOTE BOOK	ALIGNED	11/10/61
NO.	1	

PROFILE	SURVEYED	DATE
NOTE BOOK	GRADES CHECKED	11/10/61
NO.	1	

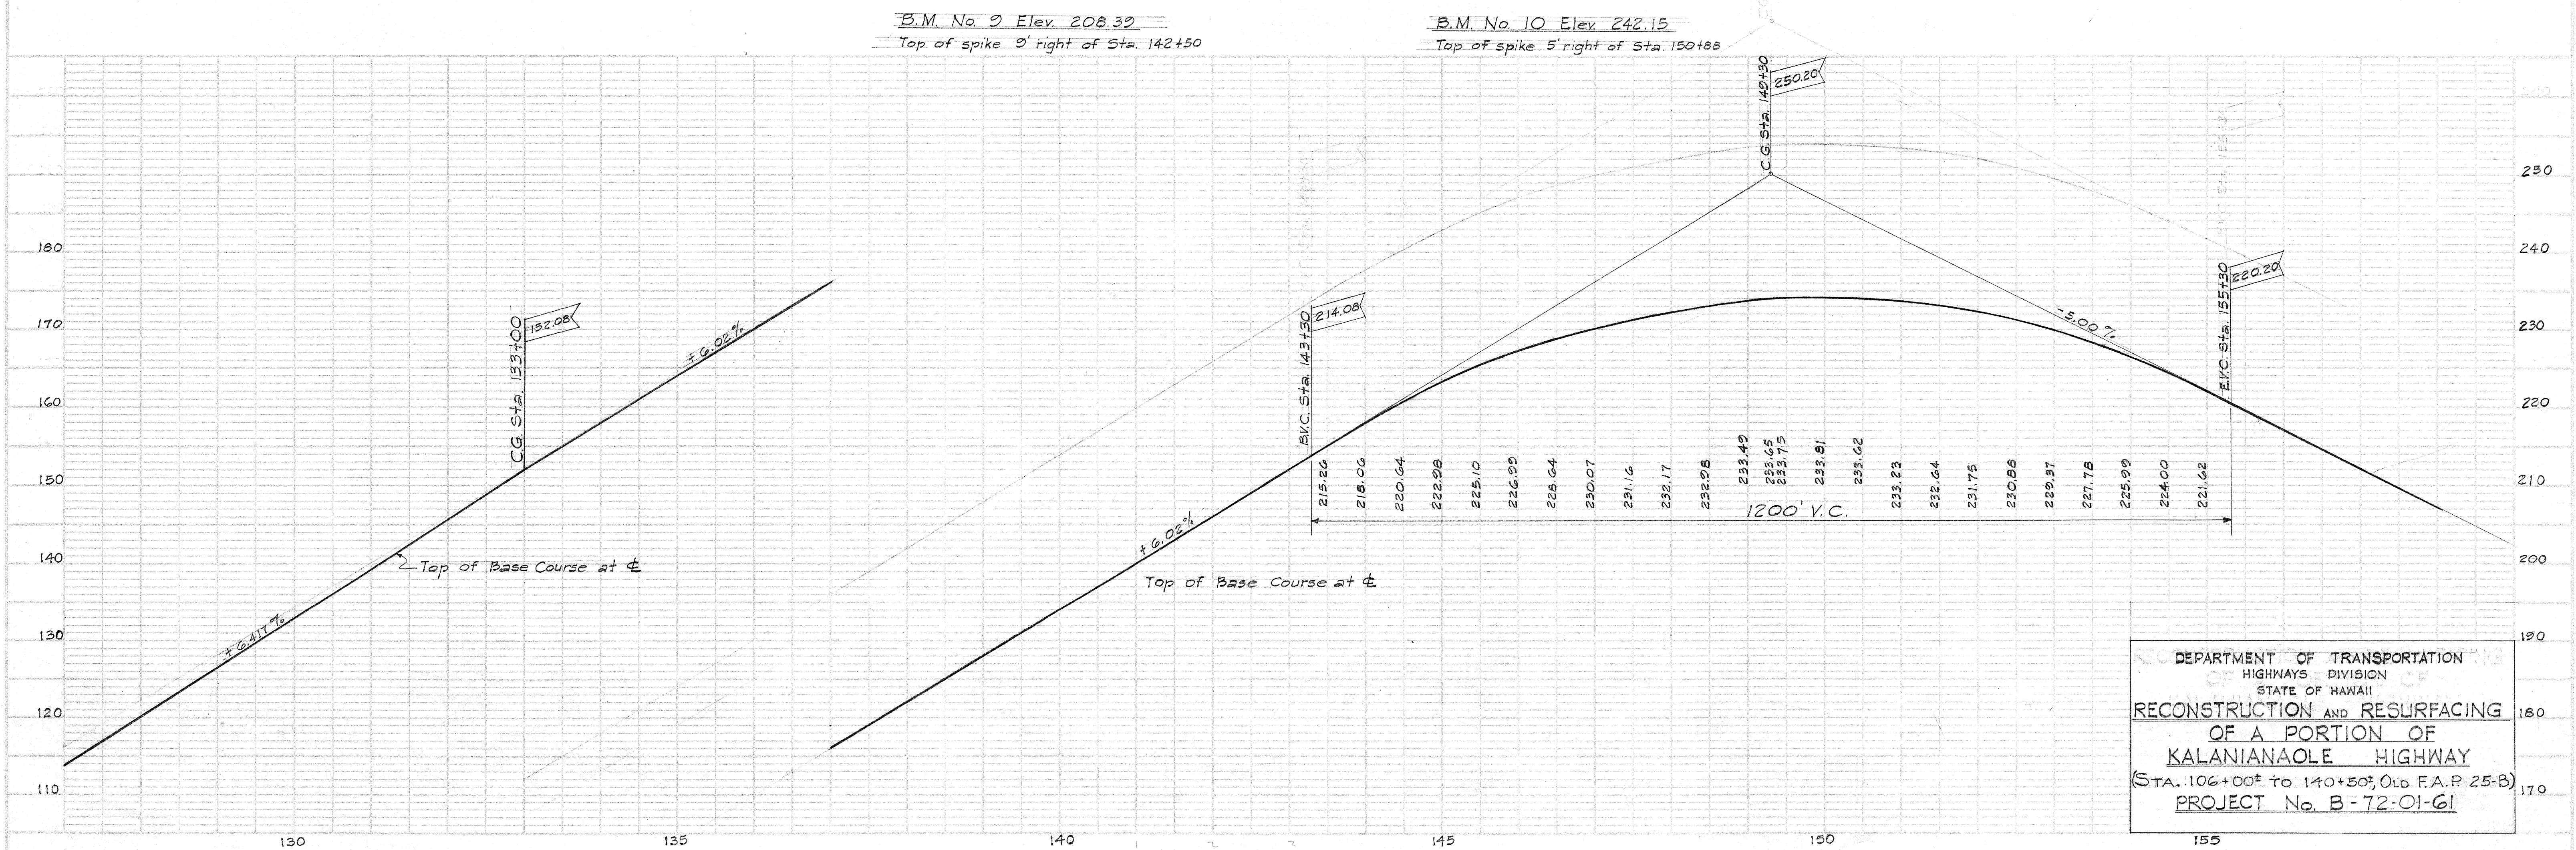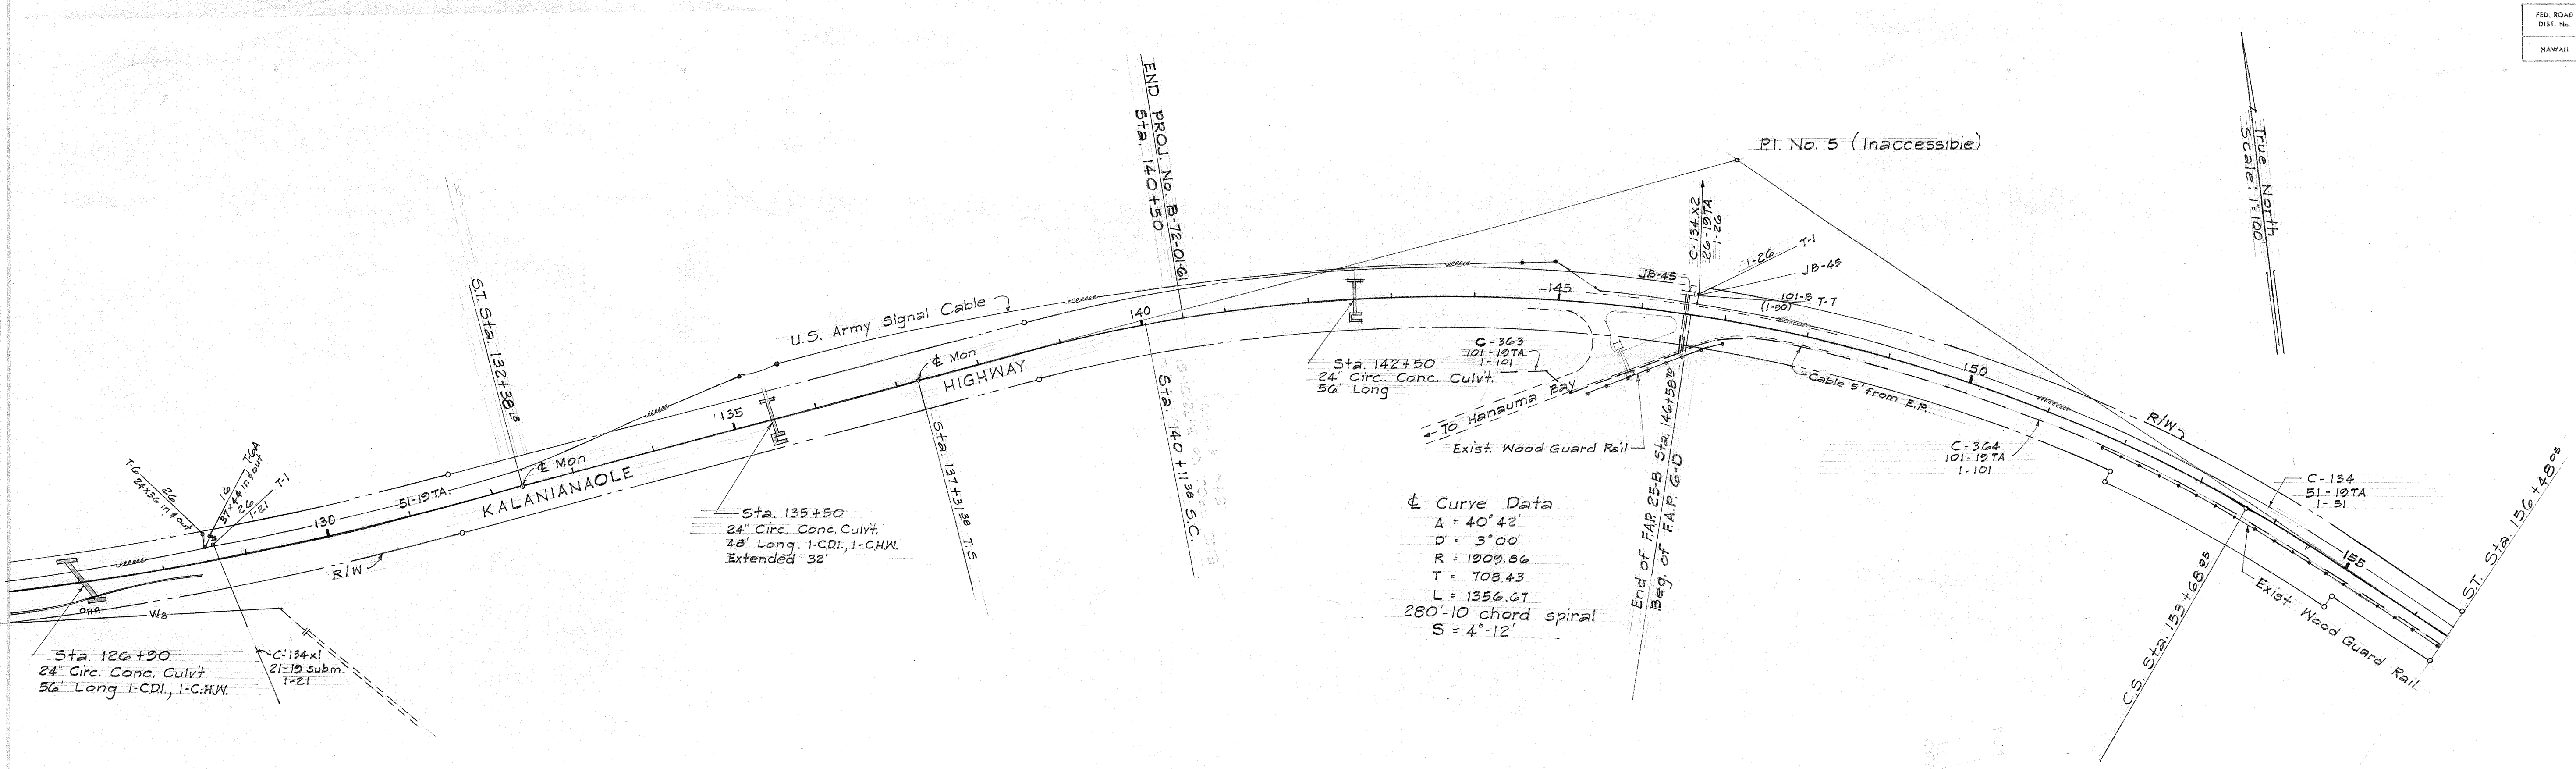

DEPARTMENT OF TRANSPORTATION
HIGHWAYS DIVISION
STATE OF HAWAII
RECONSTRUCTION AND RESURFACING
OF A PORTION OF
KALANIANA'OLE HIGHWAY
(Sta. 106+00 to 140+50, Old F.A.P. 25-B)
PROJECT No. B-72-01-61