


INDEX TO DRAWINGS	
SHEET NO.	DESCRIPTION
1	TITLE SHEET
2	TYPICAL SECTION
3-4	PLAN & PROFILE

STATE OF HAWAII
DEPARTMENT OF TRANSPORTATION
HIGHWAYS DIVISION
HONOLULU, HAWAII
"AS-BUILT"
PLANS FOR

THE RECONSTRUCTION & RESURFACING
OF PORTION OF KALANIANA'OLE HIGHWAY

STA. 106+00± TO 140+50±, OLD F.A.P. 25-B

PROJECT NO. B-72-01-61

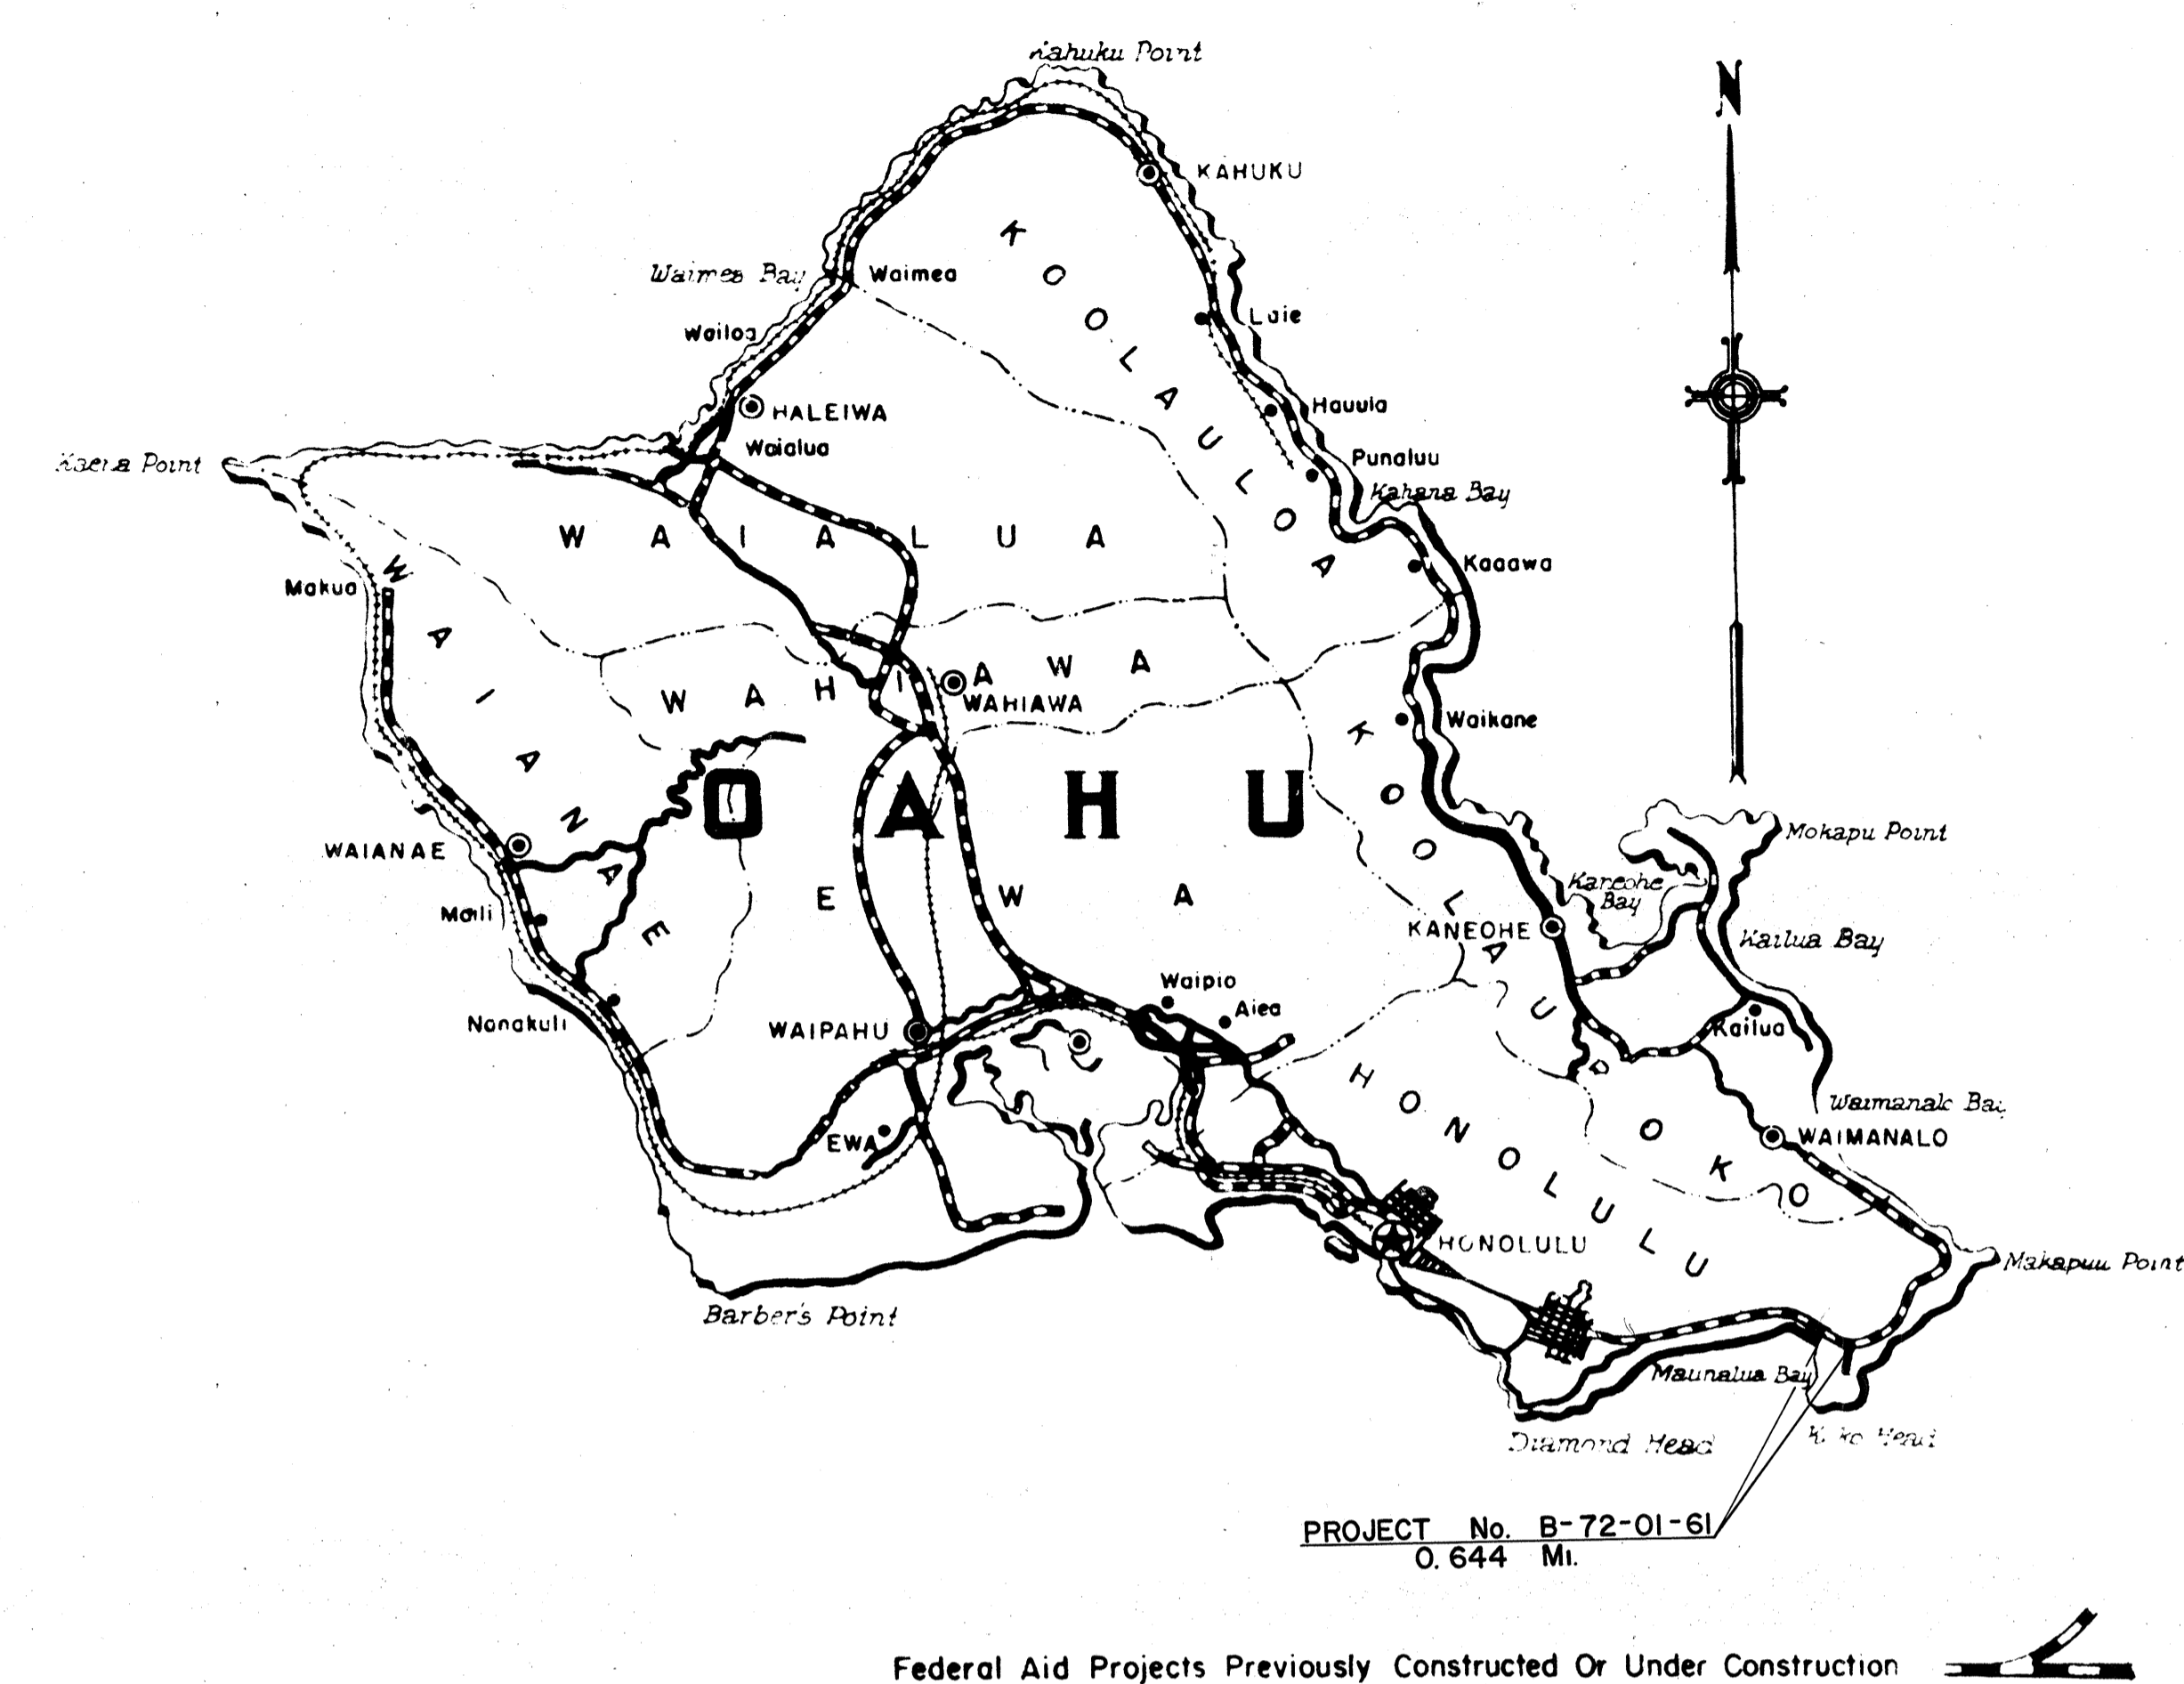

LAYOUT OF PROJECT
Scale: 1"= 300'
LENGTH OF PROJECT = 0.644 Mi.



THIS PROJECT HAS BEEN COMPLETED
WITHOUT ANY "AS-BUILT" CHANGES

Stanley Imahiro
PROJECT ENGINEER

APPROVED: _____ DATE 12/12/61
[Signature]
DIRECTOR OF TRANSPORTATION