





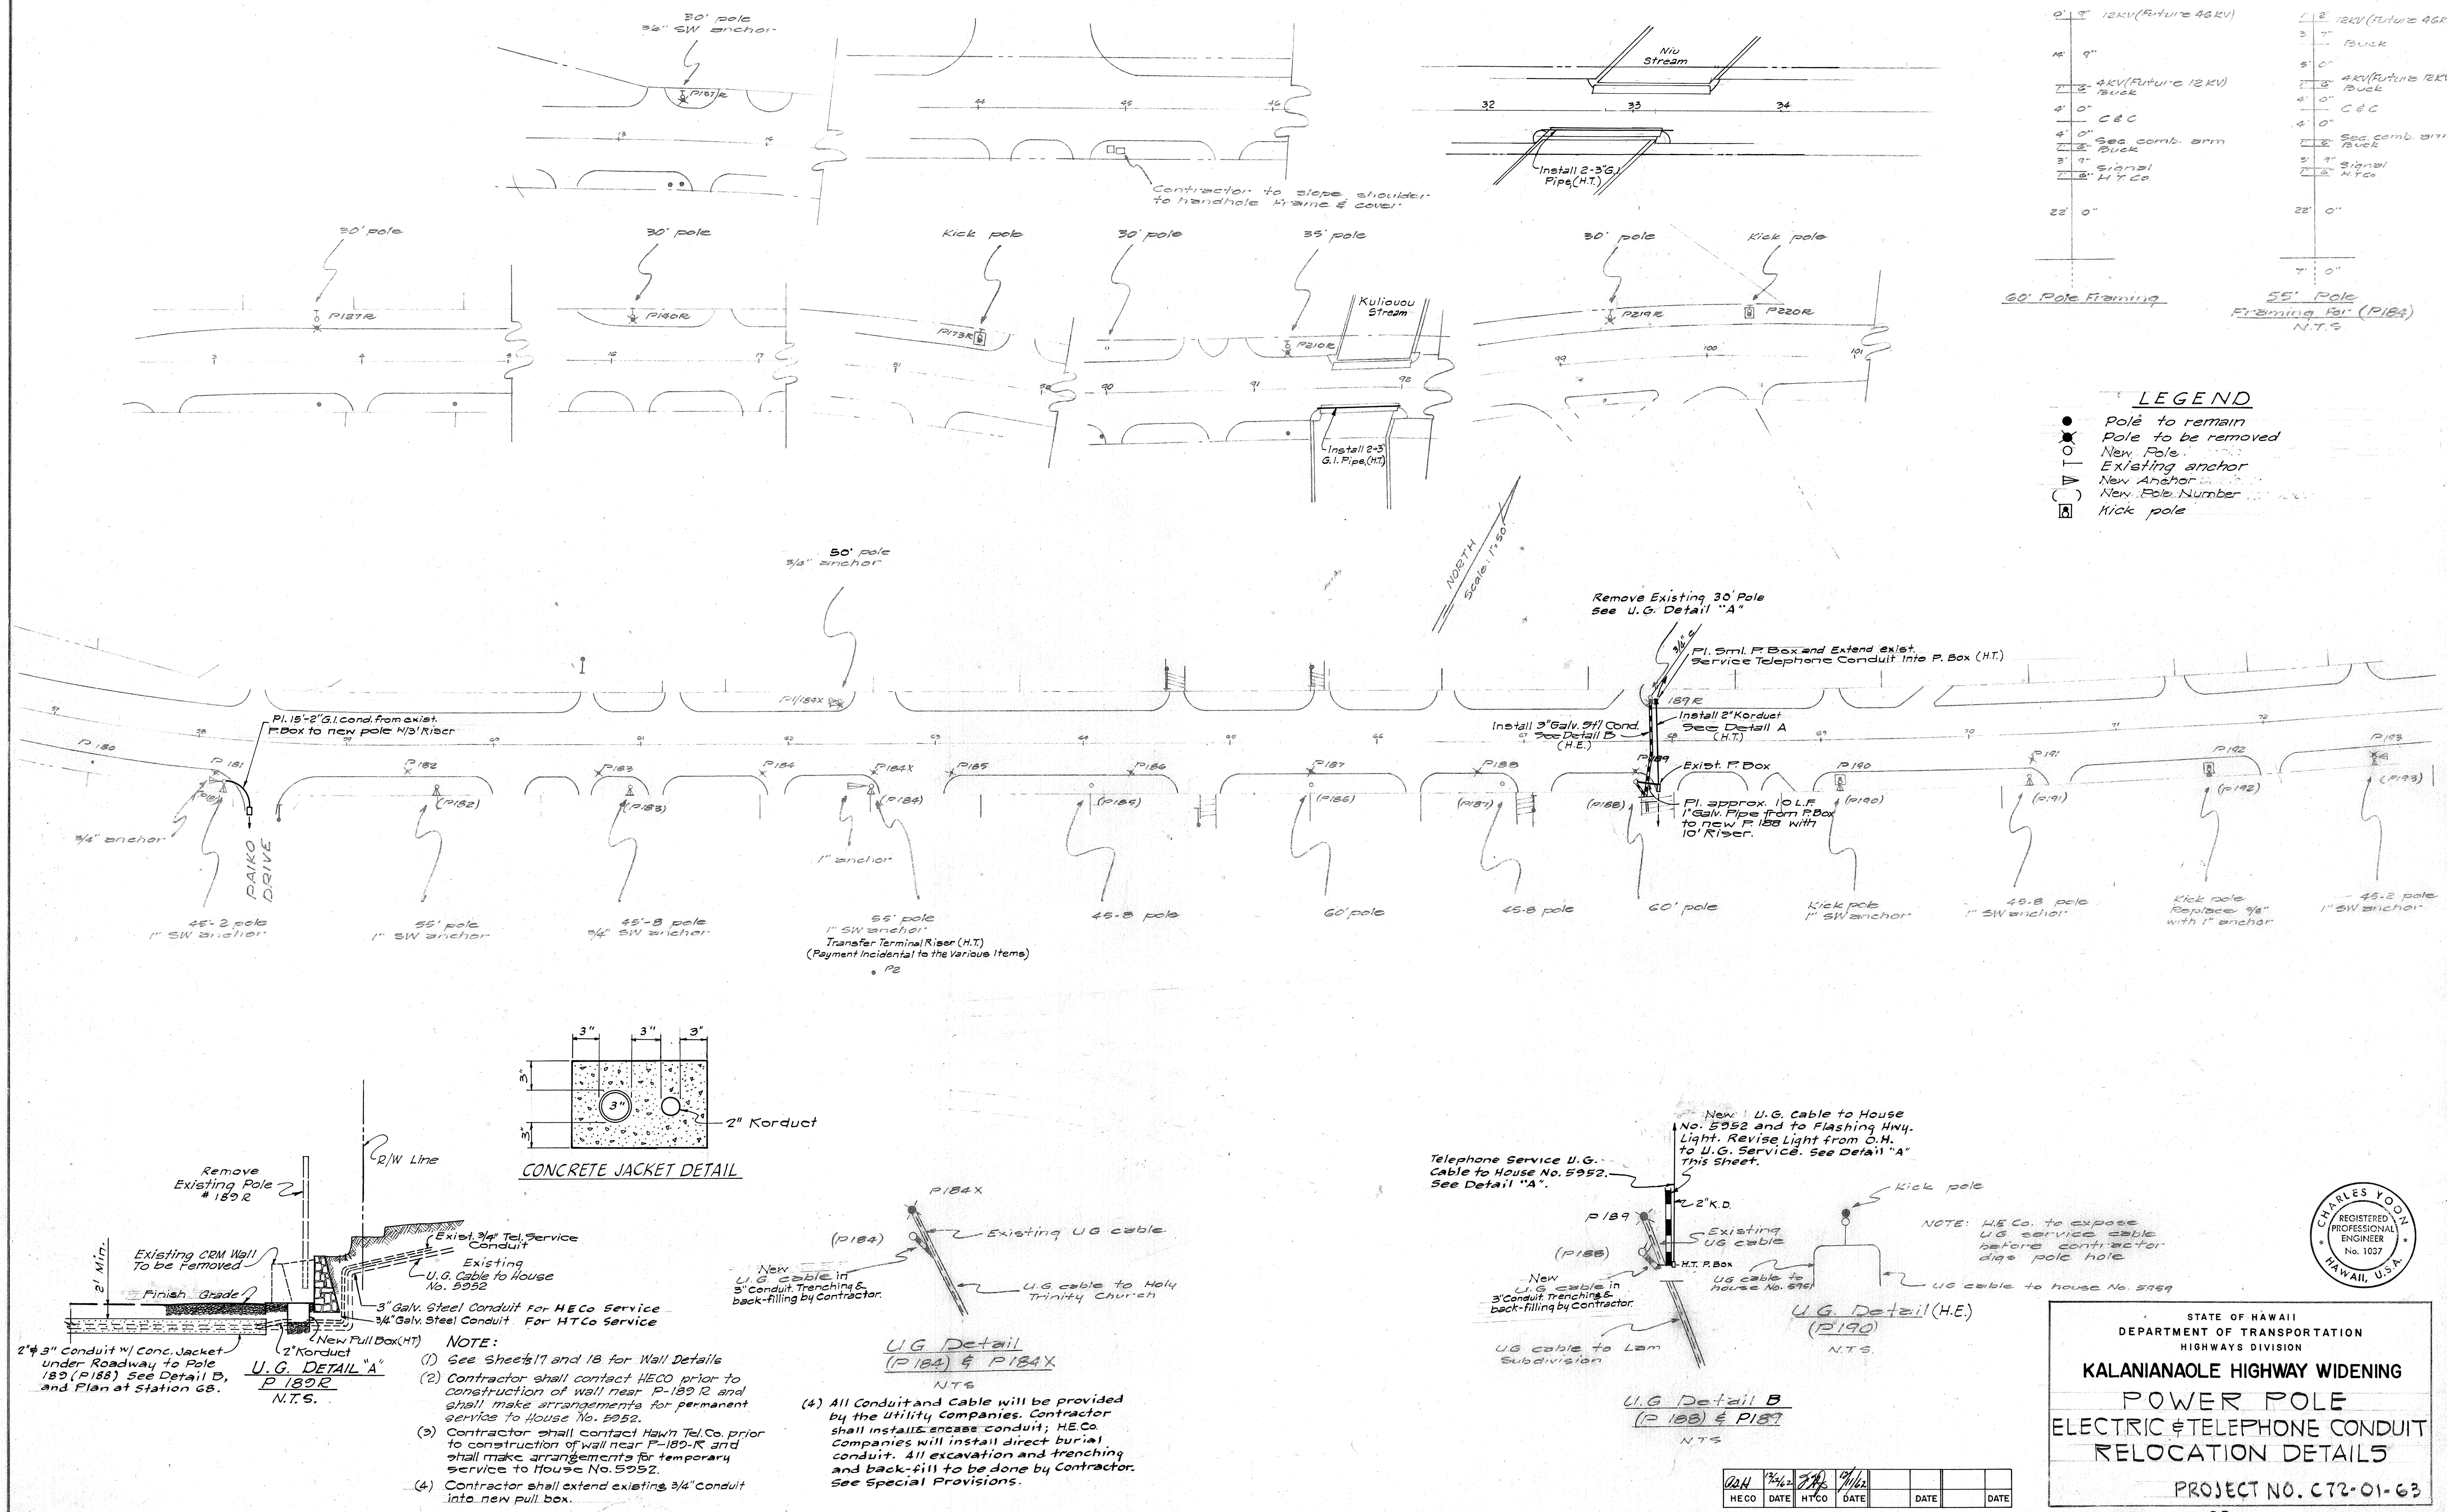


0' 1" 12KV (Future 46KV)	1' 8" 12KV (Future 46KV)
2' 0" Buck	3' 0" Buck
4' 0" 4KV (Future 12KV) Buck	5' 0" 4KV (Future 12KV) Buck
4' 0" C & C	4' 0" C & C
4' 0" Sec. Comb. Arm Buck	4' 0" Sec. Comb. Arm Buck
3' 0" Signal H.T. Co	3' 0" Signal H.T. Co
22' 0"	22' 0"
7' 0"	7' 0"


60' Pole Framing

55' Pole Framing for (P184) N.T.S.

- LEGEND**
- Pole to remain
 - Pole to be removed
 - New Pole
 - Existing anchor
 - New Anchor
 - New Pole Number
 - Kick pole

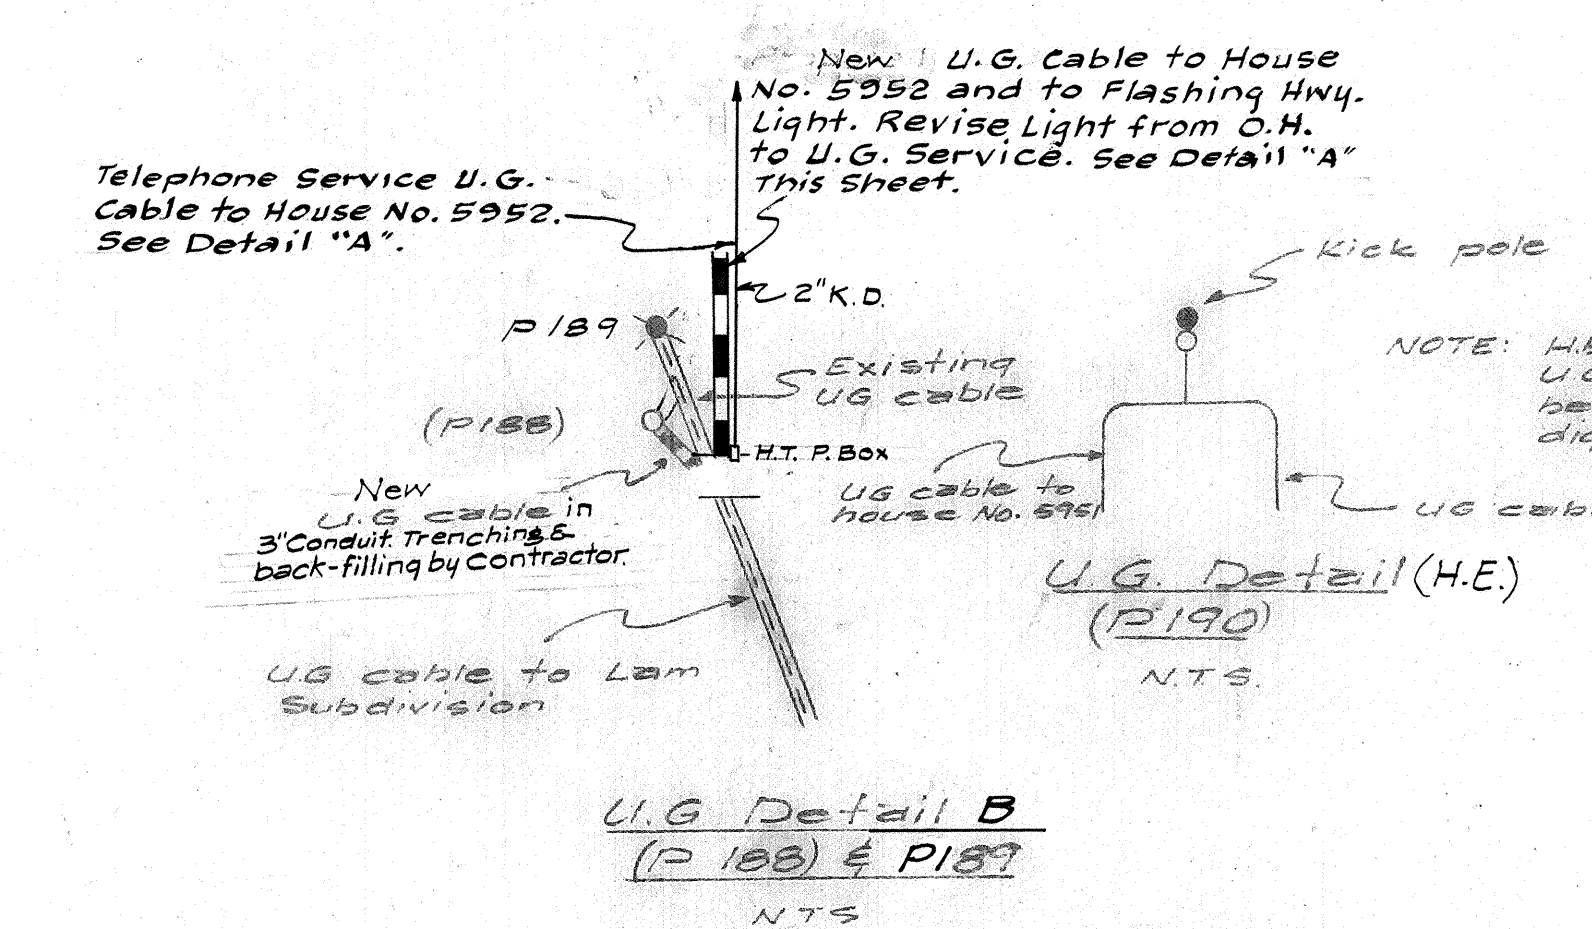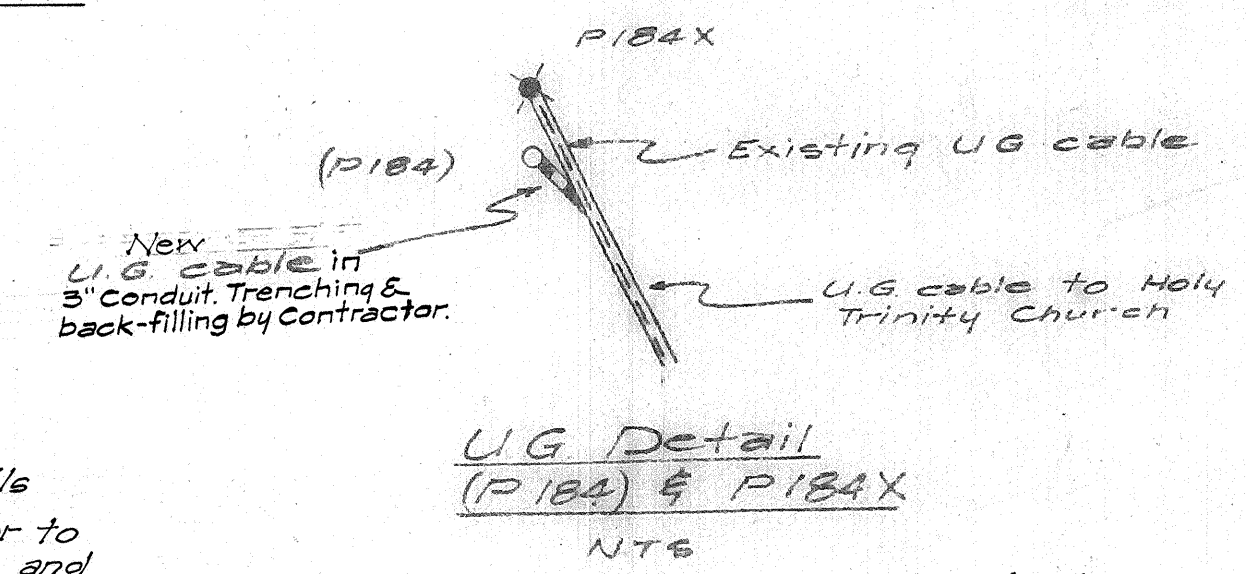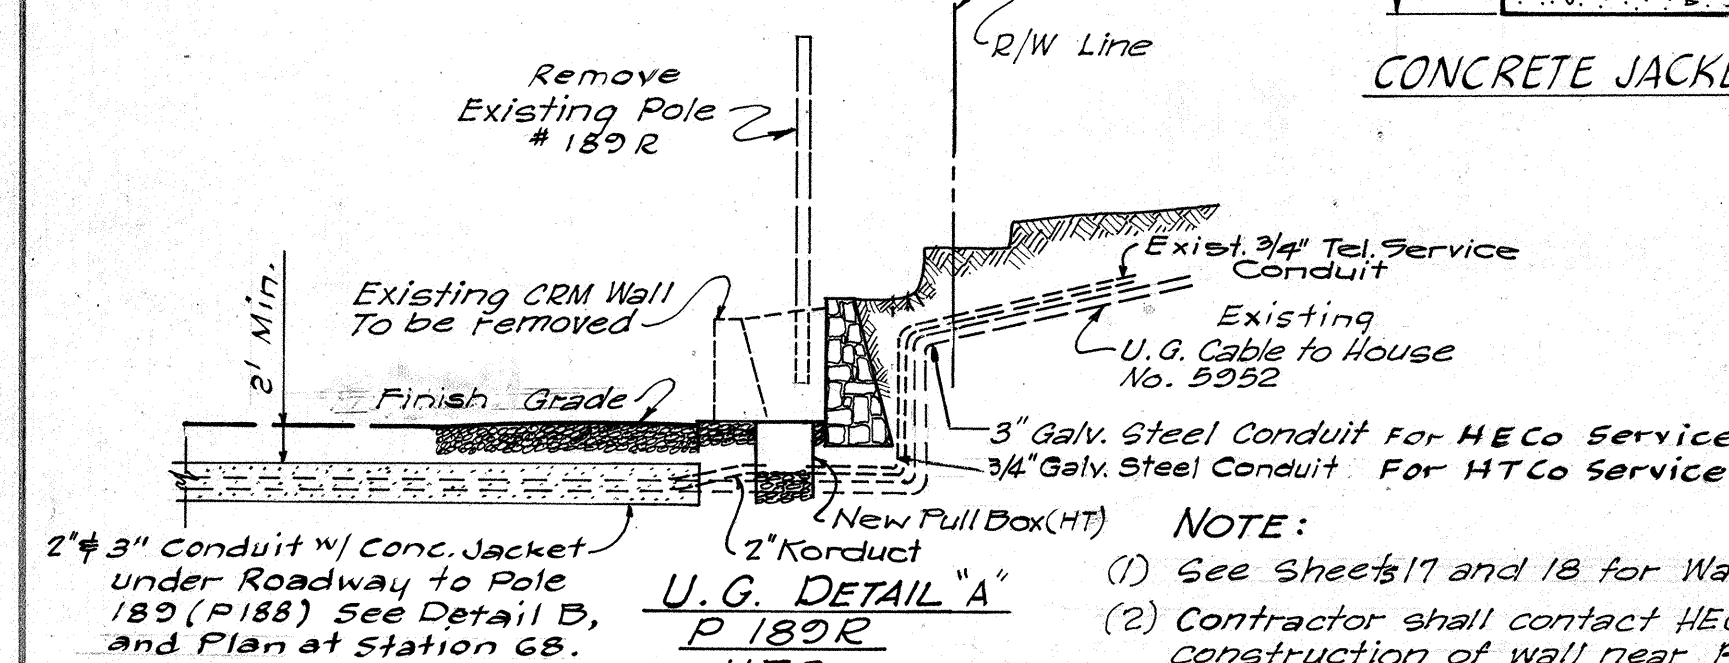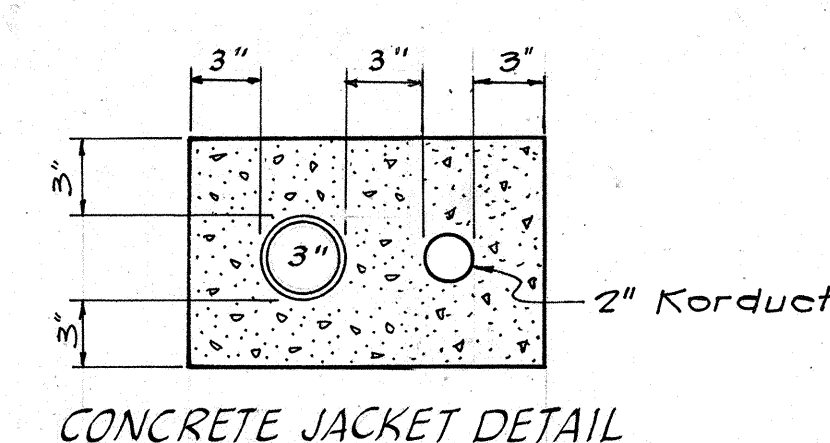

DATE	_____
SURVEY PLOTTED BY	_____
DESIGNED BY	_____
TRACED BY	_____
NOTE BOOK	_____
CHECKED BY	_____
NO.	_____

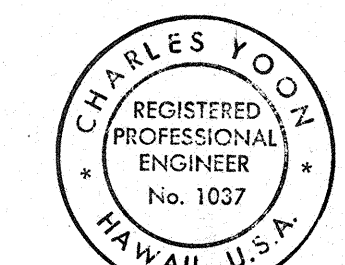

STATE OF HAWAII
DEPARTMENT OF TRANSPORTATION
HIGHWAYS DIVISION

KALANIANA'OLE HIGHWAY WIDENING

POWER POLE

ELECTRIC & TELEPHONE CONDUIT

RELOCATION DETAILS

PROJECT NO. C-72-01-63

SHEET No. 22 OF 42 SHEETS

HECO	DATE	HTCO	DATE	DATE	DATE