



INDEX TO DRAWINGS	
SHEET NO.	DESCRIPTION
1	TITLE
2	GENERAL NOTES
3	TYP. & SPECIAL SECTION
4-11	PLAN & PROFILE
12	KIRKWOOD ST. INTERSECTION
13	HAWAII LOA ST. INTERSECTION
14	MAY WAY & SUMMER ST. INTER.
15-19	WALL DETAILS
20	DRAINAGE DETAILS
21	FIRE HYD. RELOCATION DETS.
22	POLE RELOCATION DETS.
23	BORING LOGS
24-27	NIU BRIDGE
28-33	KULIOUOU BRIDGE
34-37	TRAFFIC SIGNS
38-49	STANDARD DETAILS

STATE OF HAWAII  
DEPARTMENT OF TRANSPORTATION  
HIGHWAYS DIVISION  
HONOLULU, HAWAII

"AS BUILT" PLANS OF  
KALANIANA'OLE HIGHWAY WIDENING  
KIRKWOOD STREET TO MAY WAY

PROJECT NO. C-72-01-63

FED. ROAD DIST. NO.	STATE	PROJ. NO.	FISCAL YEAR	SHEET NO.	TOTAL SHEETS
HAWAII	HAW	C-72-01-63	1963	1	49

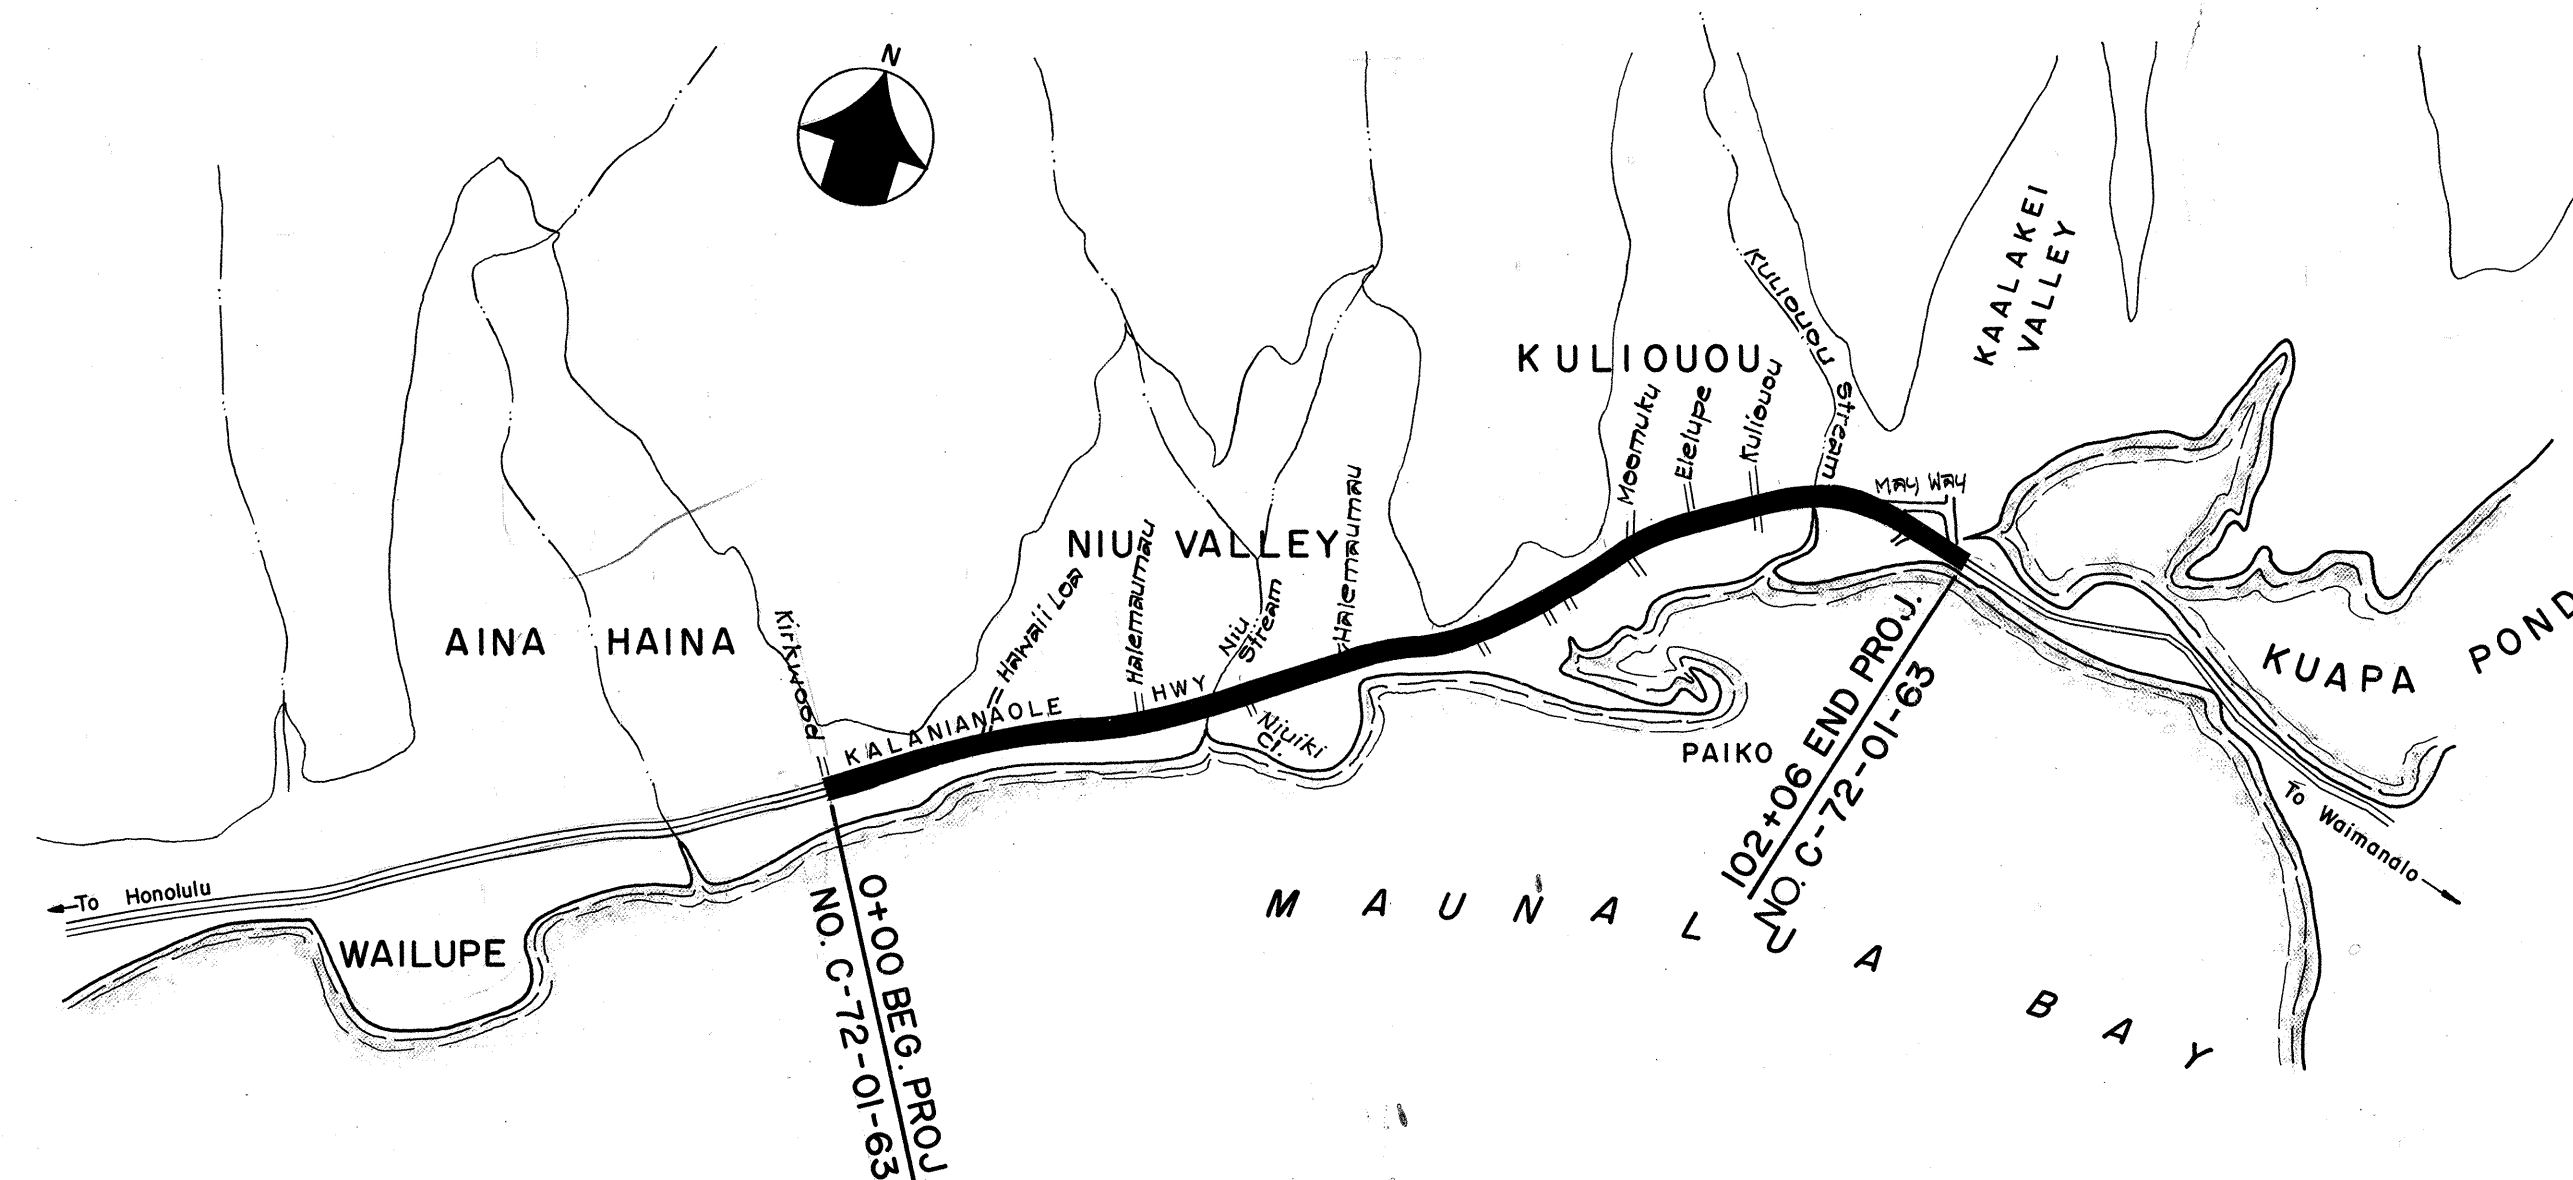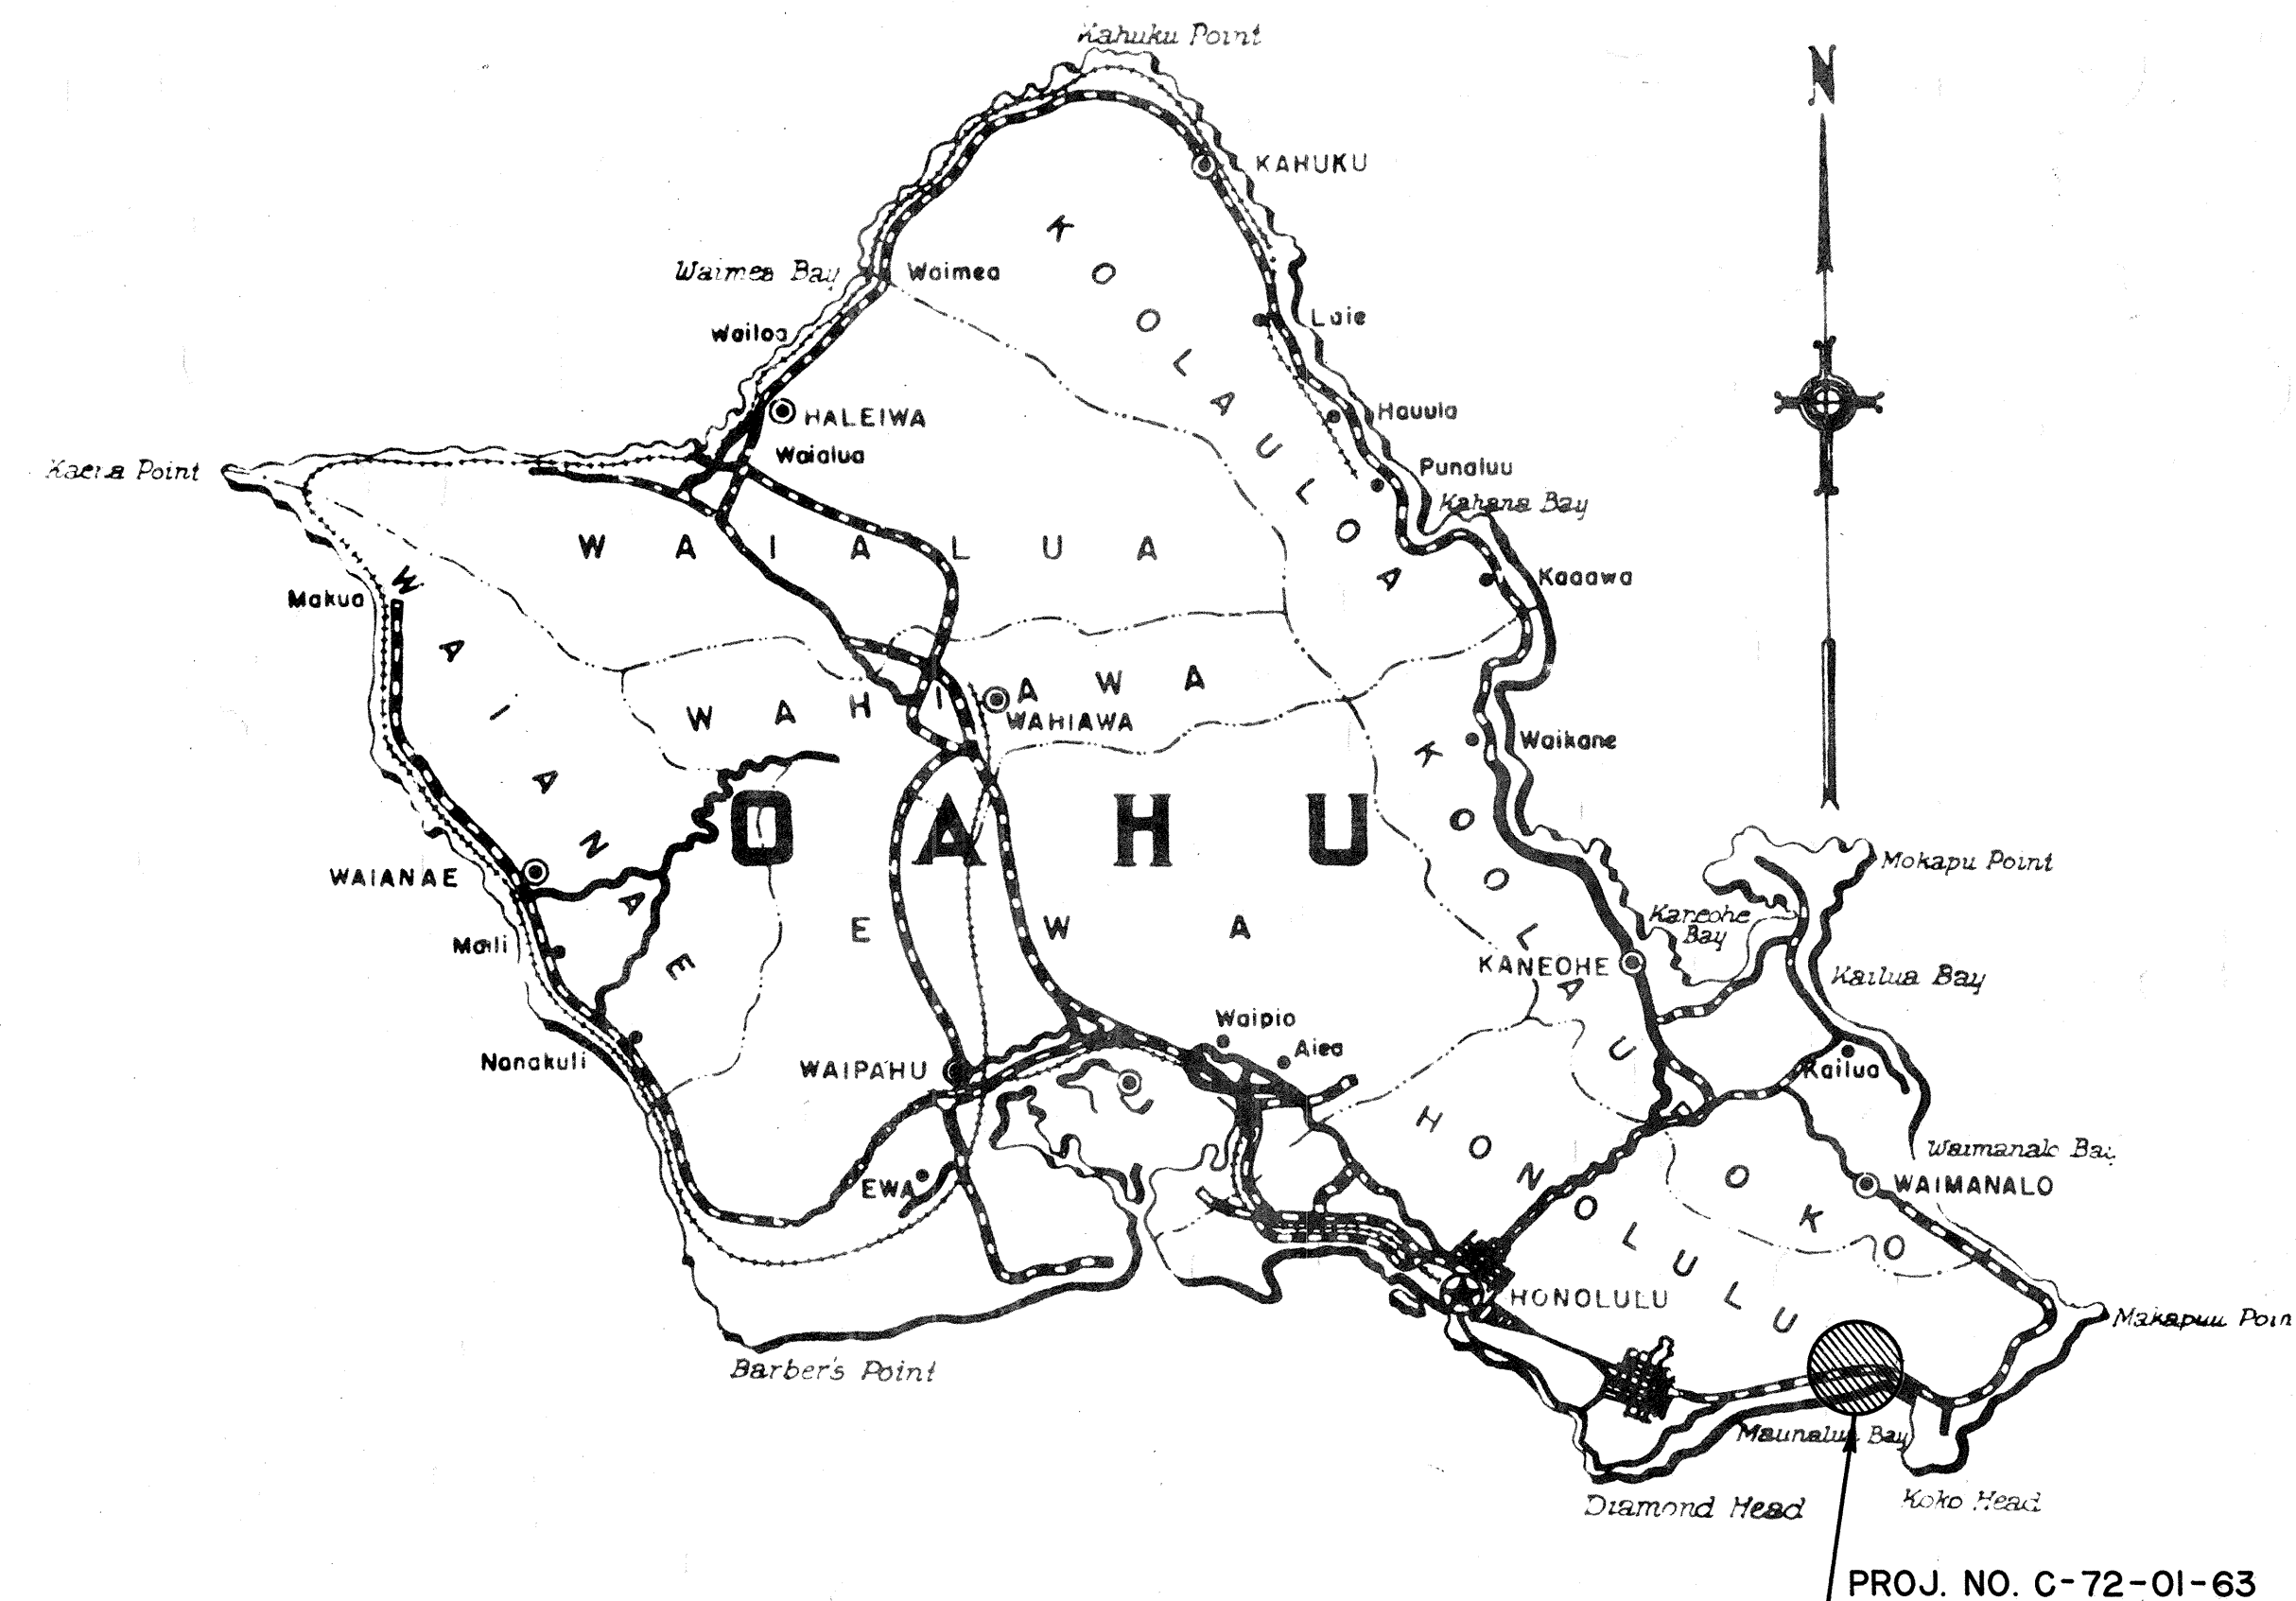

LOCATION MAP

SCALE: 1"= 2000'

GROSS LENGTH OF PROJECT.....1.933 MILES  
BRIDGES.....0.246 MILES  
NET LENGTH OF PROJECT.....1.687 MILES

NOTE:

ALL CHANGES MADE DURING CONSTRUCTION  
HAVE BEEN NOTED IN RED ON THESE TRACINGS  
AND CHECKED BY:

*for T. Cratani*  
RESIDENT ENGINEER  
3/22/66  
DATE

L. FREDERICK PACK ASSOCIATES OF HAWAII LTD.  
ENGINEERING CONSULTANTS - CITY PLANNING - AERIAL MAPPING  
HONOLULU, HAWAII

*Charles Yoon*  
CHARLES YOON, REG. PROF. ENGR. CERT. NO. 1037  
DATE Dec. 10, 1960

APPROVED: DATE 21 Mar 63  
*Felix M. Matala*  
DIRECTOR OF TRANSPORTATION

DESIGNED BY	DATE
DRAWN BY	
TRACED BY	
NOTE BOOK	
QUANTITIES CHECKED BY	
CHECKED BY	