


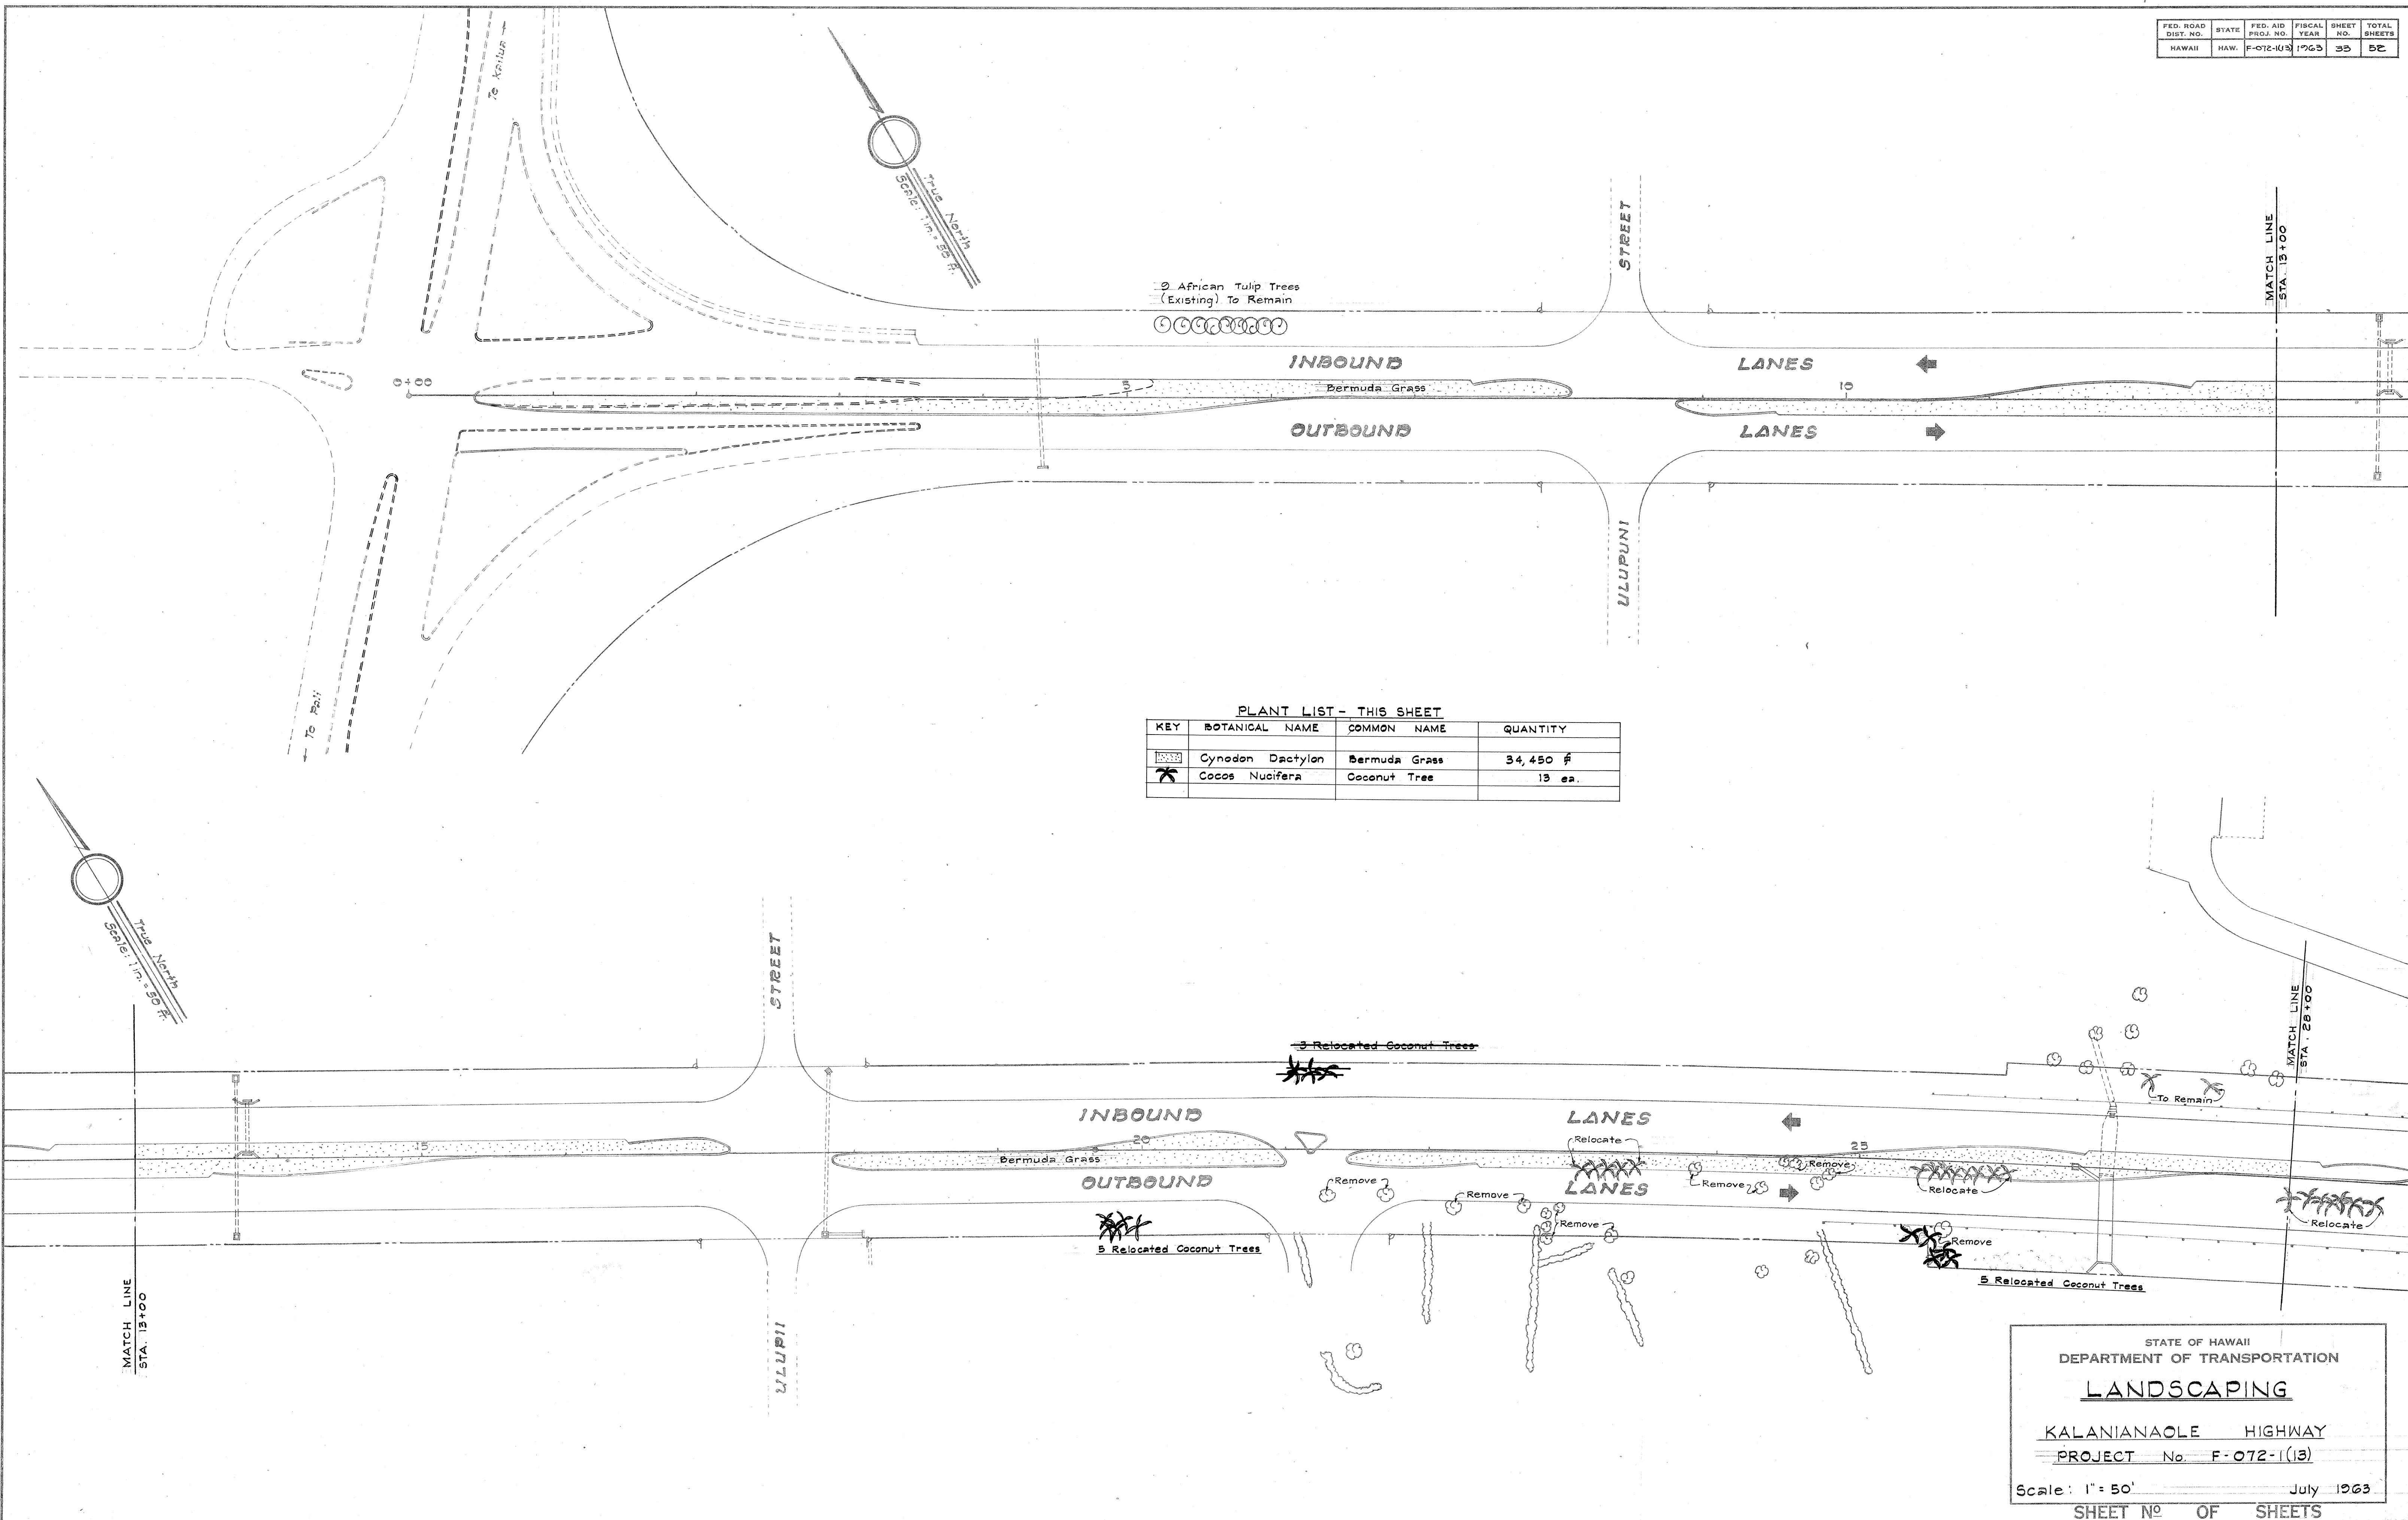


PLANT LIST - THIS SHEET

KEY	BOTANICAL NAME	COMMON NAME	QUANTITY
[Stippled Box]	Cynodon Dactylon	Bermuda Grass	34,450 #
[X]	Cocos Nucifera	Coconut Tree	13 ea.

ORIGINAL PLAN
DATE
DRAWN BY
CHECKED BY
NOTE BOOK
QUANTITIES BY
No.

STATE OF HAWAII
DEPARTMENT OF TRANSPORTATION
LANDSCAPING
KALANIANAʻOLÉ HIGHWAY
PROJECT No. F-072-1(13)
Scale: 1" = 50' July 1963
SHEET No. OF SHEETS

FED. ROAD DIST. NO.	STATE	FED. AID PROJ. NO.	FISCAL YEAR	SHEET NO.	TOTAL SHEETS
HAWAII	HAW.	F-072-1(4)	1963	34	52

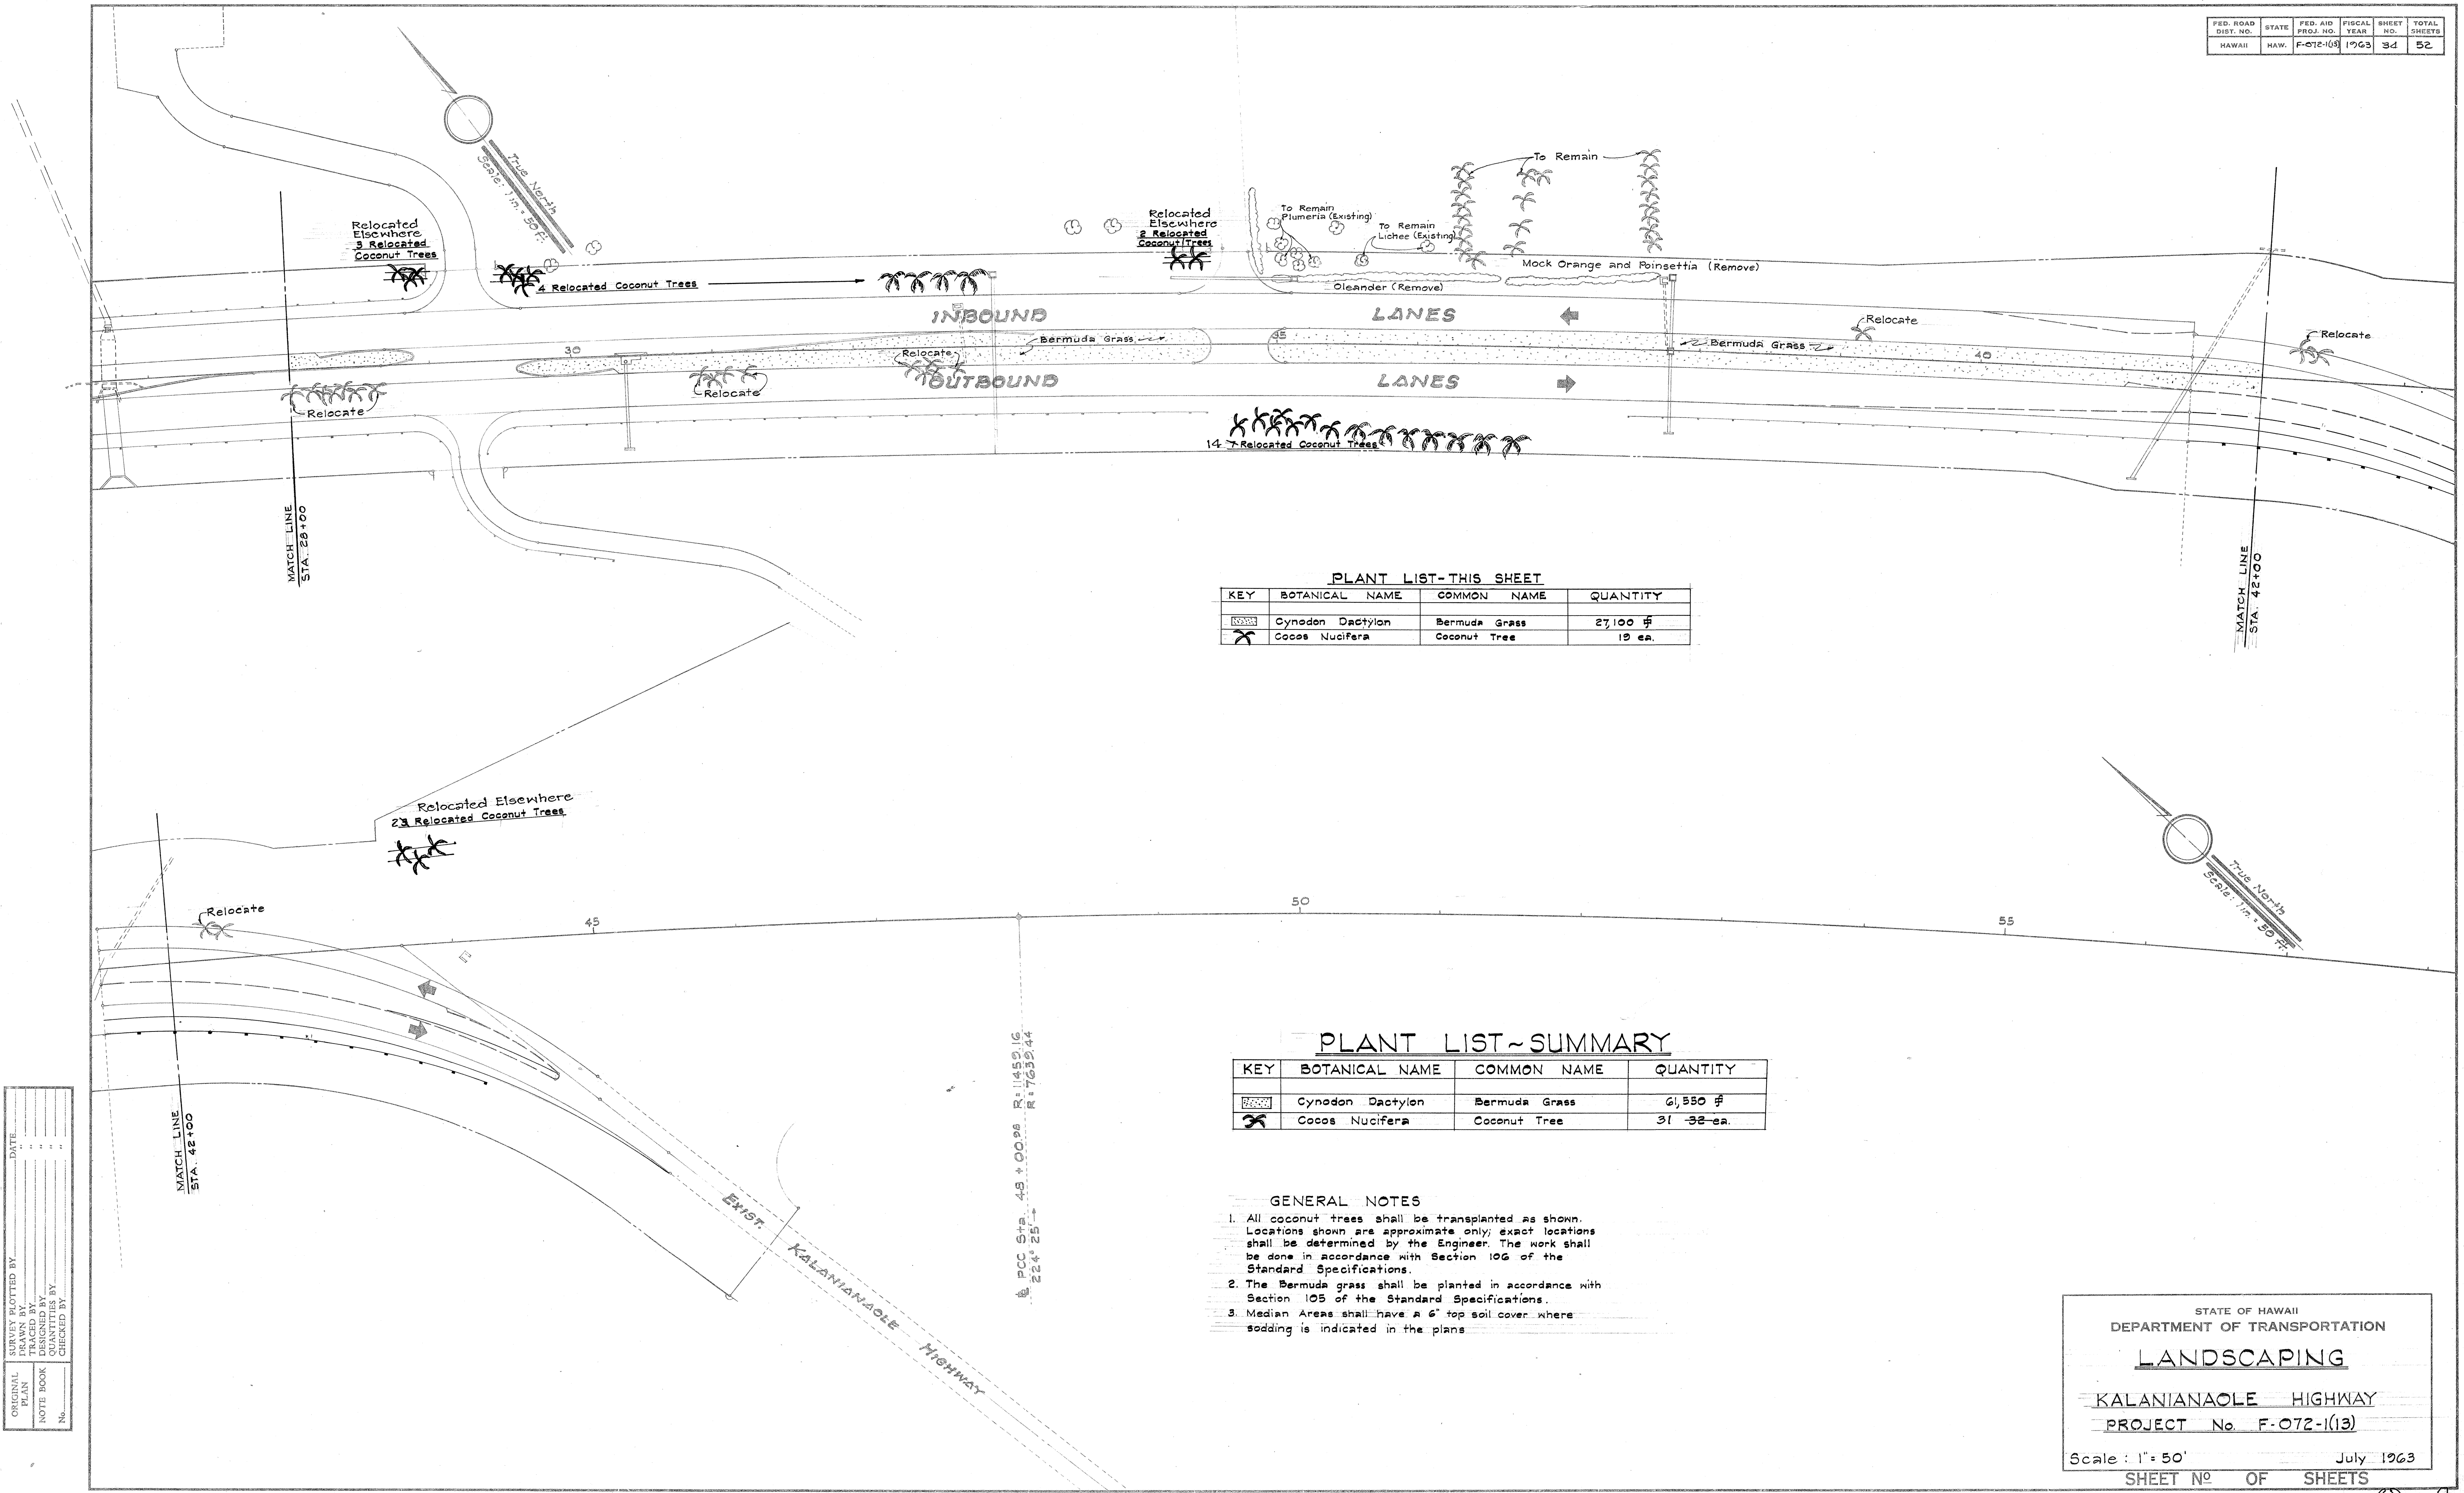

PLANT LIST-THIS SHEET

KEY	BOTANICAL NAME	COMMON NAME	QUANTITY
	Cynodon Dactylon	Bermuda Grass	27,100 #
	Cocos Nucifera	Coconut Tree	19 ea.

PLANT LIST ~ SUMMARY

KEY	BOTANICAL NAME	COMMON NAME	QUANTITY
	Cynodon Dactylon	Bermuda Grass	61,550 #
	Cocos Nucifera	Coconut Tree	31 -32 ea.

GENERAL NOTES

1. All coconut trees shall be transplanted as shown. Locations shown are approximate only; exact locations shall be determined by the Engineer. The work shall be done in accordance with Section 106 of the Standard Specifications.
2. The Bermuda grass shall be planted in accordance with Section 105 of the Standard Specifications.
3. Median Areas shall have a 6" top soil cover where sodding is indicated in the plans.

STATE OF HAWAII
DEPARTMENT OF TRANSPORTATION

LANDSCAPING

KALANIANA'OLE HIGHWAY

PROJECT No. F-072-1(13)

Scale: 1" = 50' July 1963

SHEET NO OF SHEETS