

INDEX TO DRAWINGS	
SHEET NO.	DESCRIPTION
1	TITLE SHEET
2 - 4	TYPICAL ROAD SECTIONS
5 - 9	PLAN & PROFILE
	DETAILS
10 - 13	1. Roadway
14	2. Highway Lighting
14 - 20	3. Drainage
21 - 28	WATER SYSTEM WITH DETAILS
29 - 32	TRAFFIC SIGNS WITH DETAILS
33 - 34	LANDSCAPING
35 - 52	CROSS SECTIONS

STATE OF HAWAII

DEPARTMENT OF TRANSPORTATION

HIGHWAYS DIVISION

HONOLULU, HAWAII

"AS BUILT"

PLANS OF

KALANIANA'OLE HIGHWAY

KAILUA JUNCTION TOWARDS WAIMANALO

FEDERAL AID PROJECT NO. F-072-1(13)

DISTRICT OF KOOLAUPOKO

ISLAND OF OAHU

SCALES:

PLAN & PROFILE.....HOR.....1"= 50'

VER.....1"= 10'

CROSS SECTION.....HOR.....1"= 10', 1"= 20'

VER.....1"= 10', 1"= 20'

NOTE:

ALL CHANGES MADE DURING CONSTRUCTION

HAVE BEEN NOTED IN RED ON THESE TRACINGS

AND CHECKED BY:

F. H. Shimizu




RESIDENT ENGINEER

DATE *July 20, 1966*

NET LENGTH OF ROADWAY.....1.326 MI.

BRIDGES OVER 20'-0" SPAN.....0.000 MI.

GROSS LENGTH OF PROJECT.....1.326 MI.

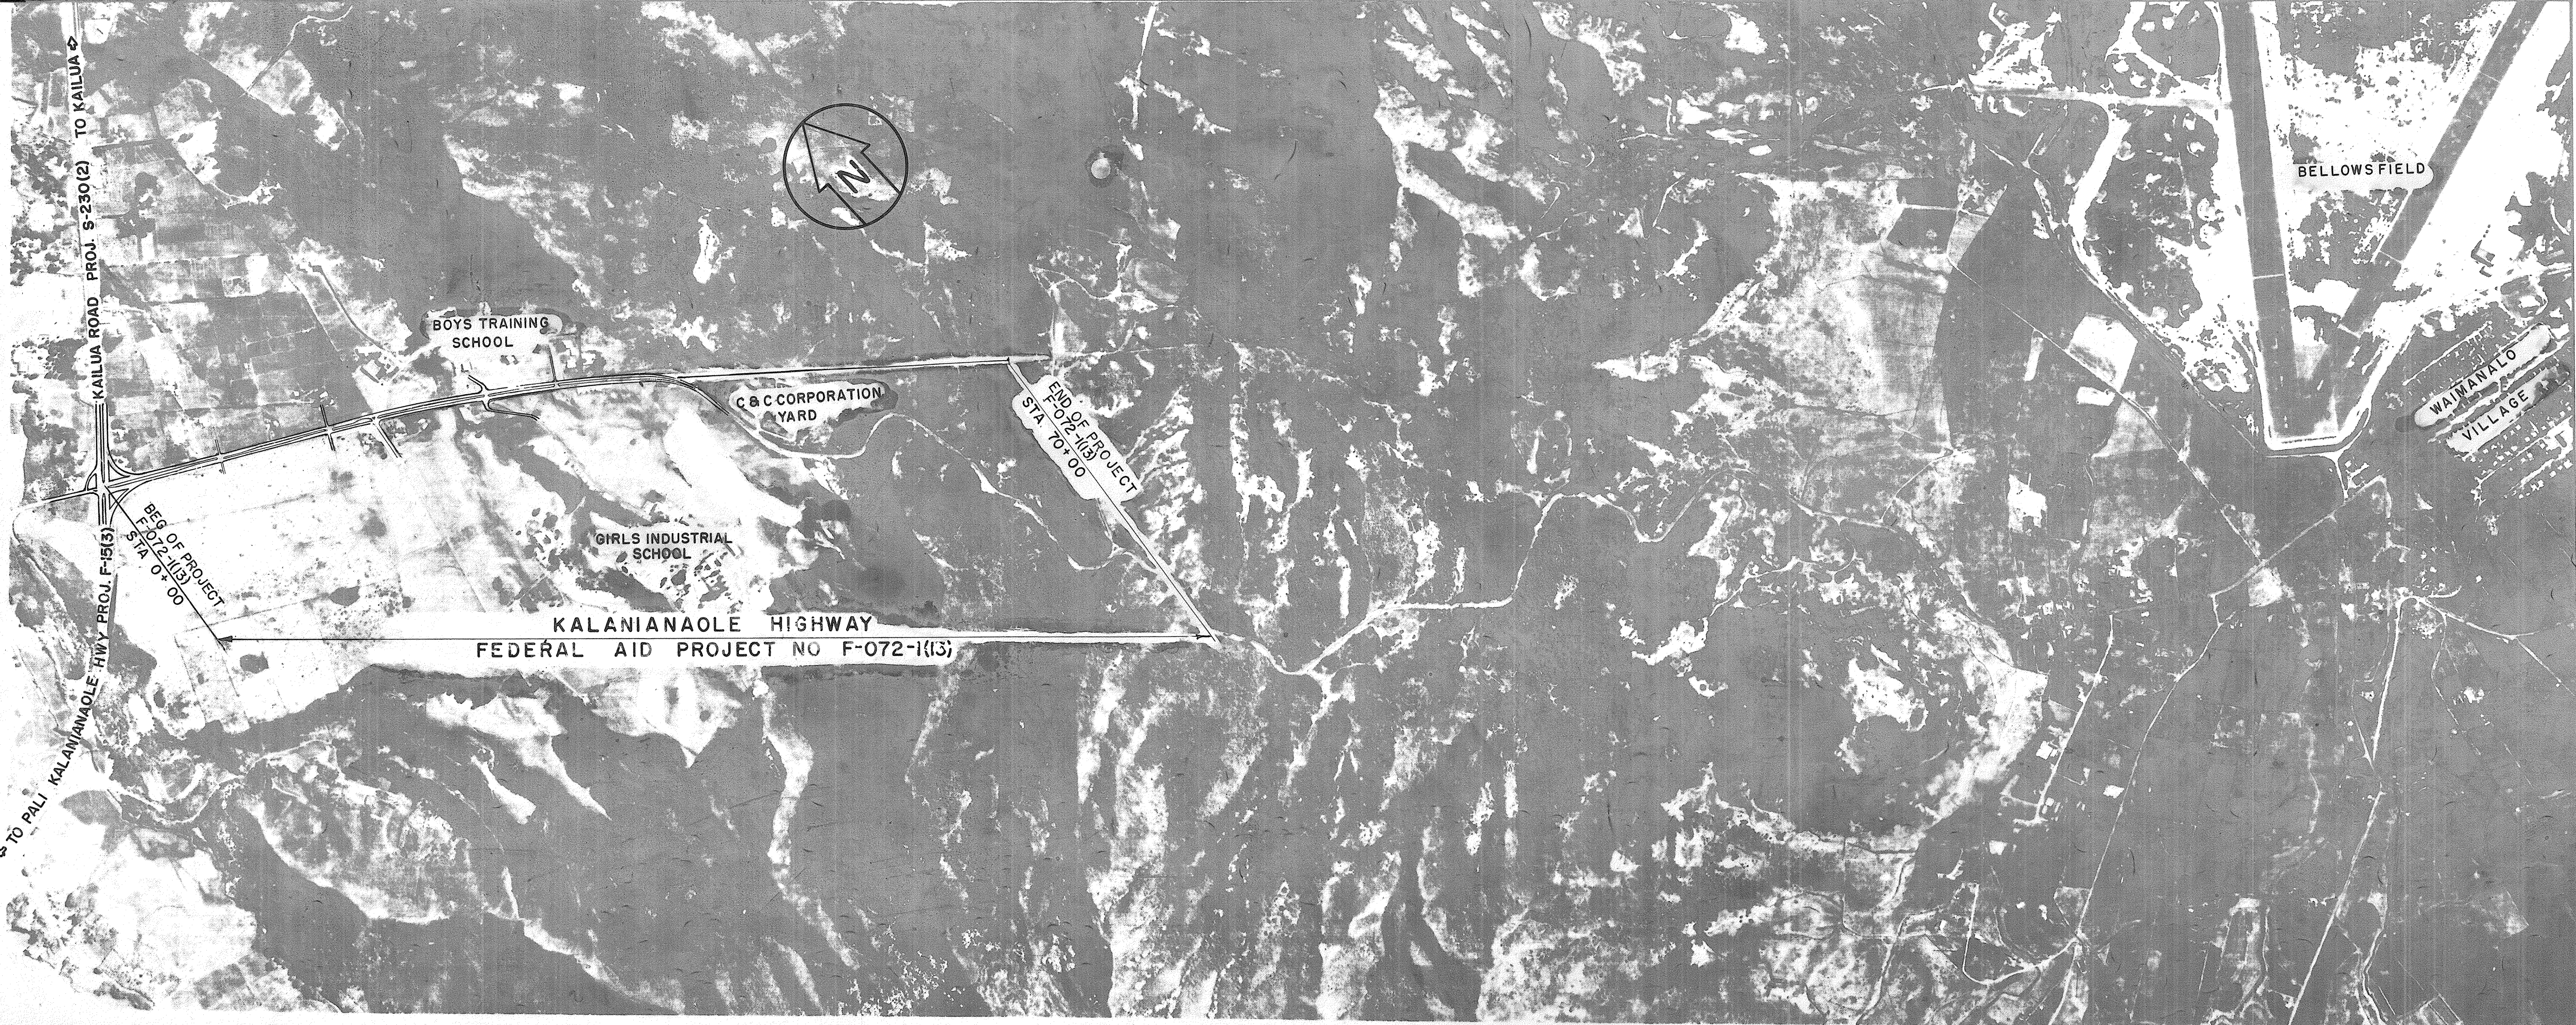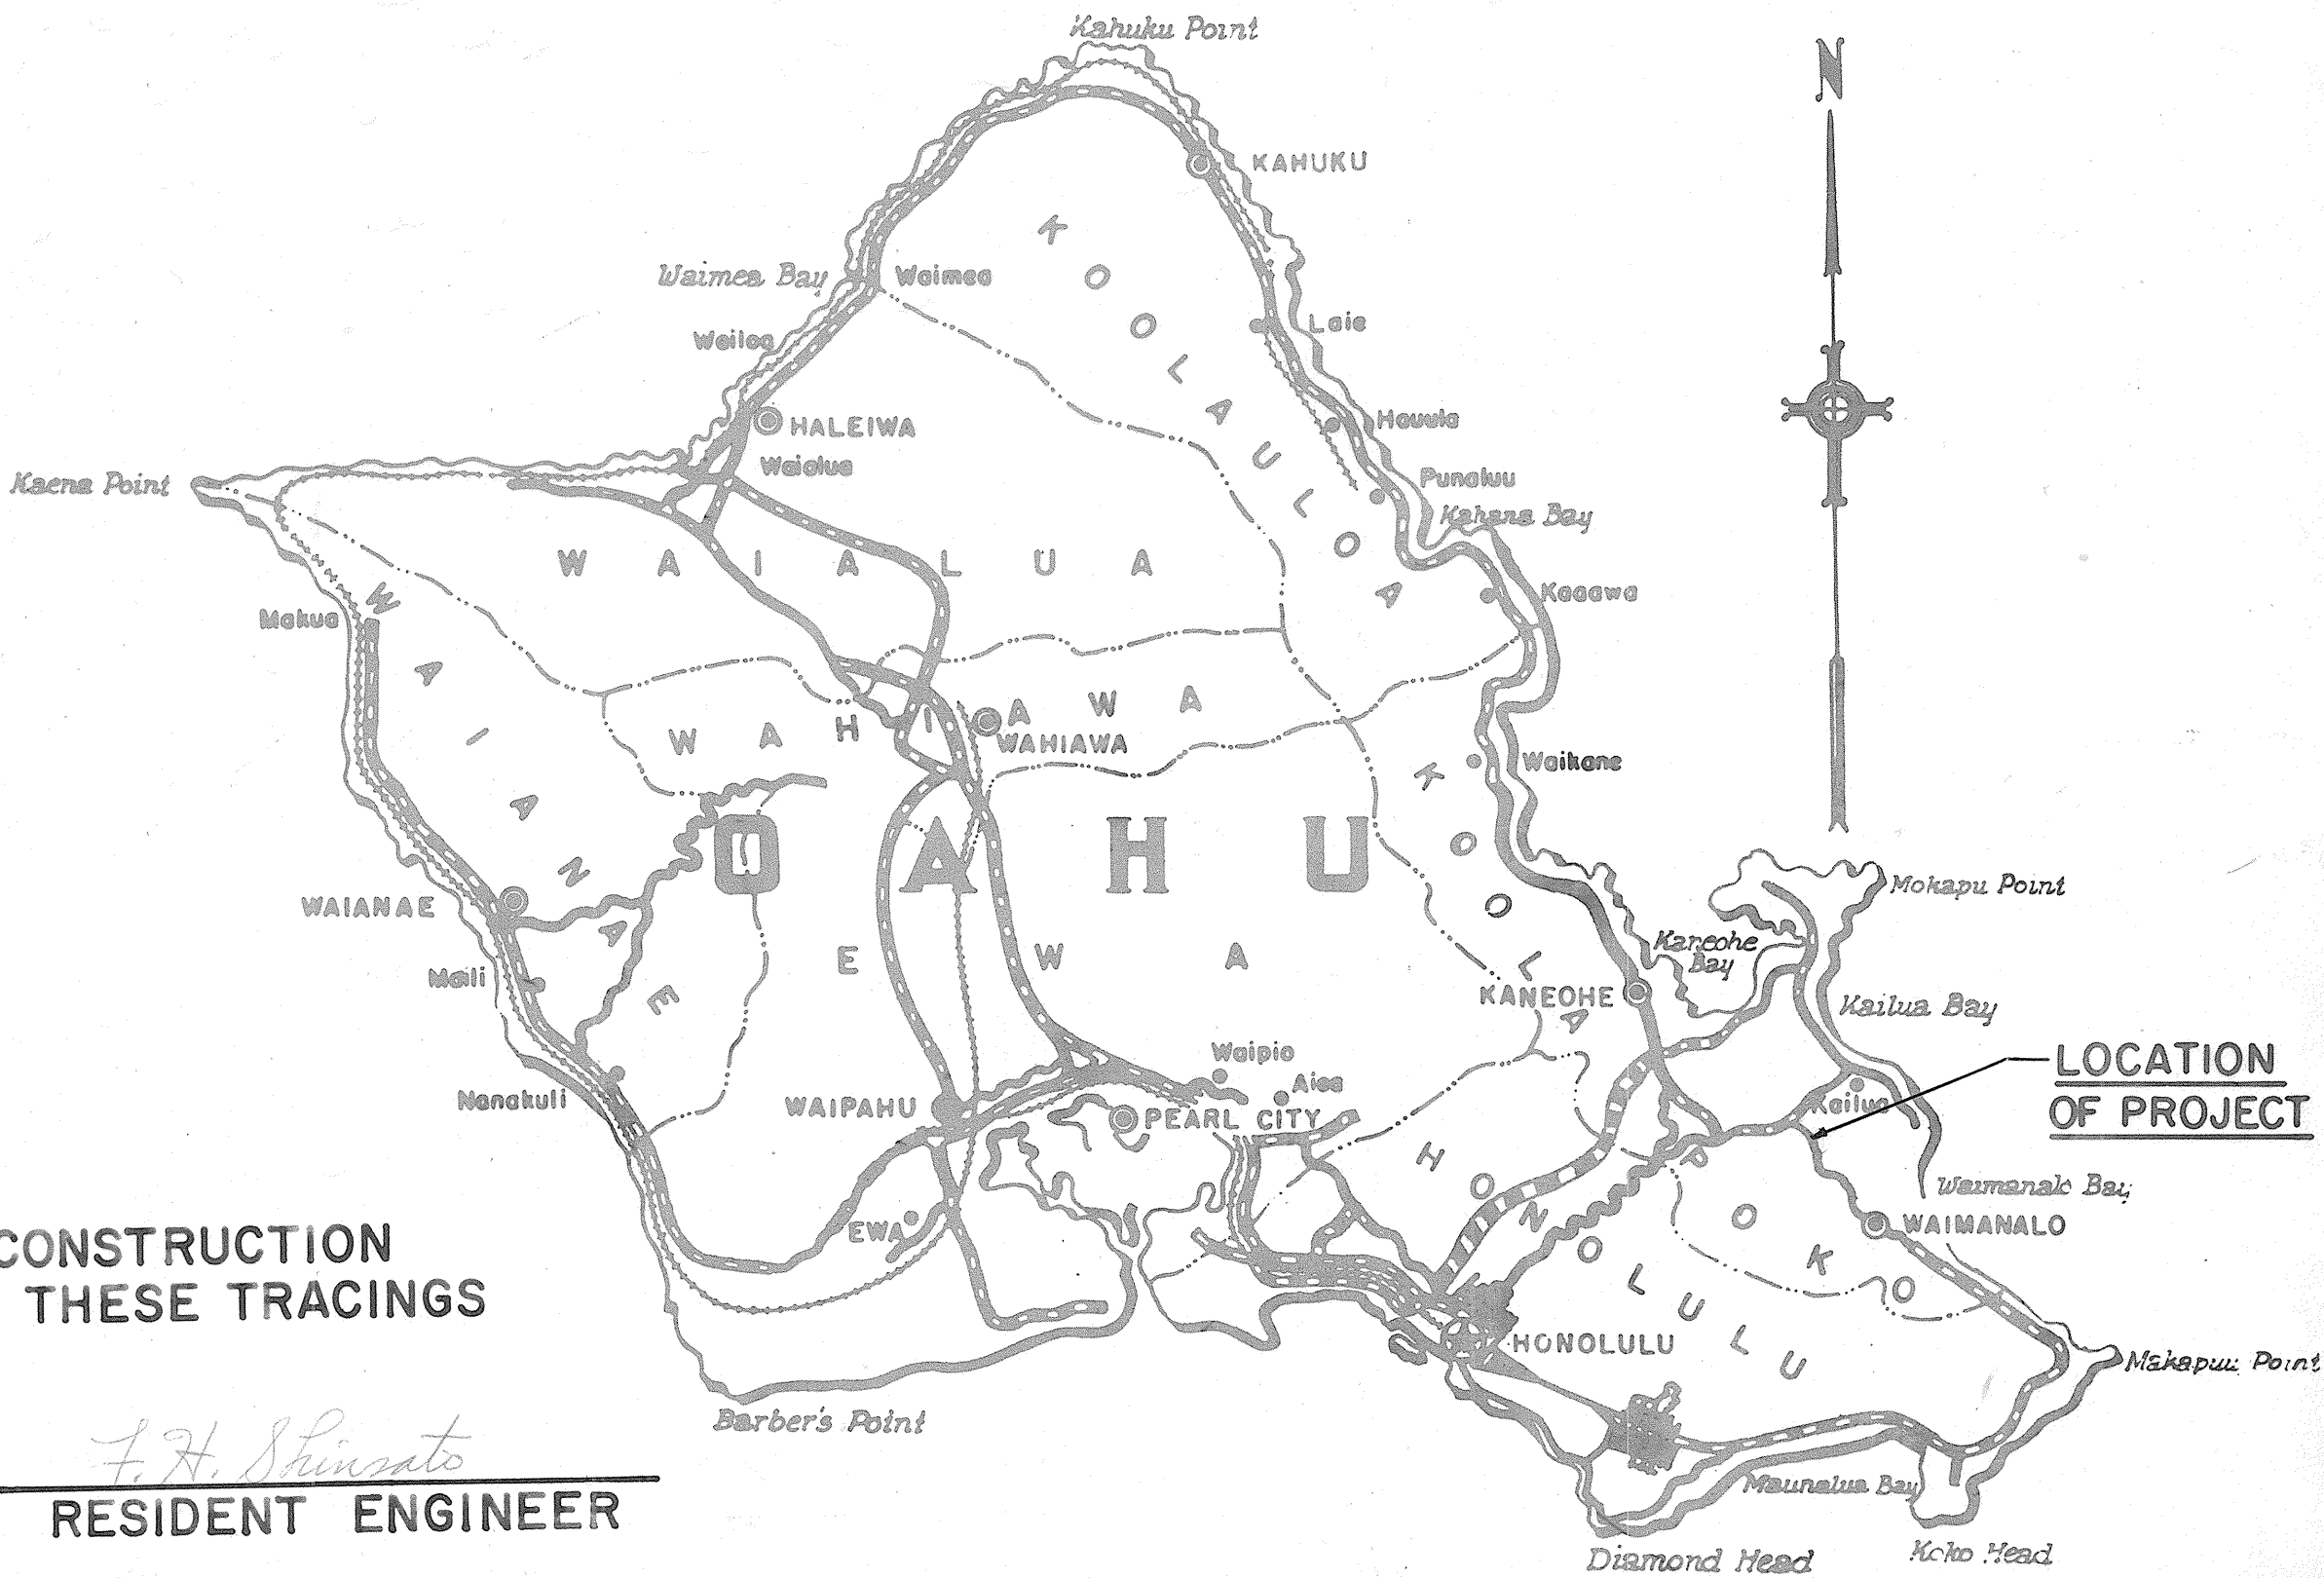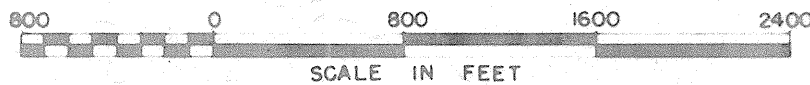

Federal Aid Projects Previously Constructed Or Under Construction

DESIGN CLASSIFICATION

ADT (1963)	4,300
DESIGN ADT	27,200
DHV	11 %
D	75/25
T	3 %
V	45 M.P.H.

APPROVED

DATE *4 Sept 63*

Leino Watson

DIRECTOR OF TRANSPORTATION

DEPARTMENT OF COMMERCE

BUREAU OF PUBLIC ROADS

APPROVED

DIVISION ENGINEER

DATE