



STATE	PROJ. NO.	FISCAL YEAR	SHEET NO.	TOTAL SHEETS
HAW.	C-72-01-65	1964	2	9

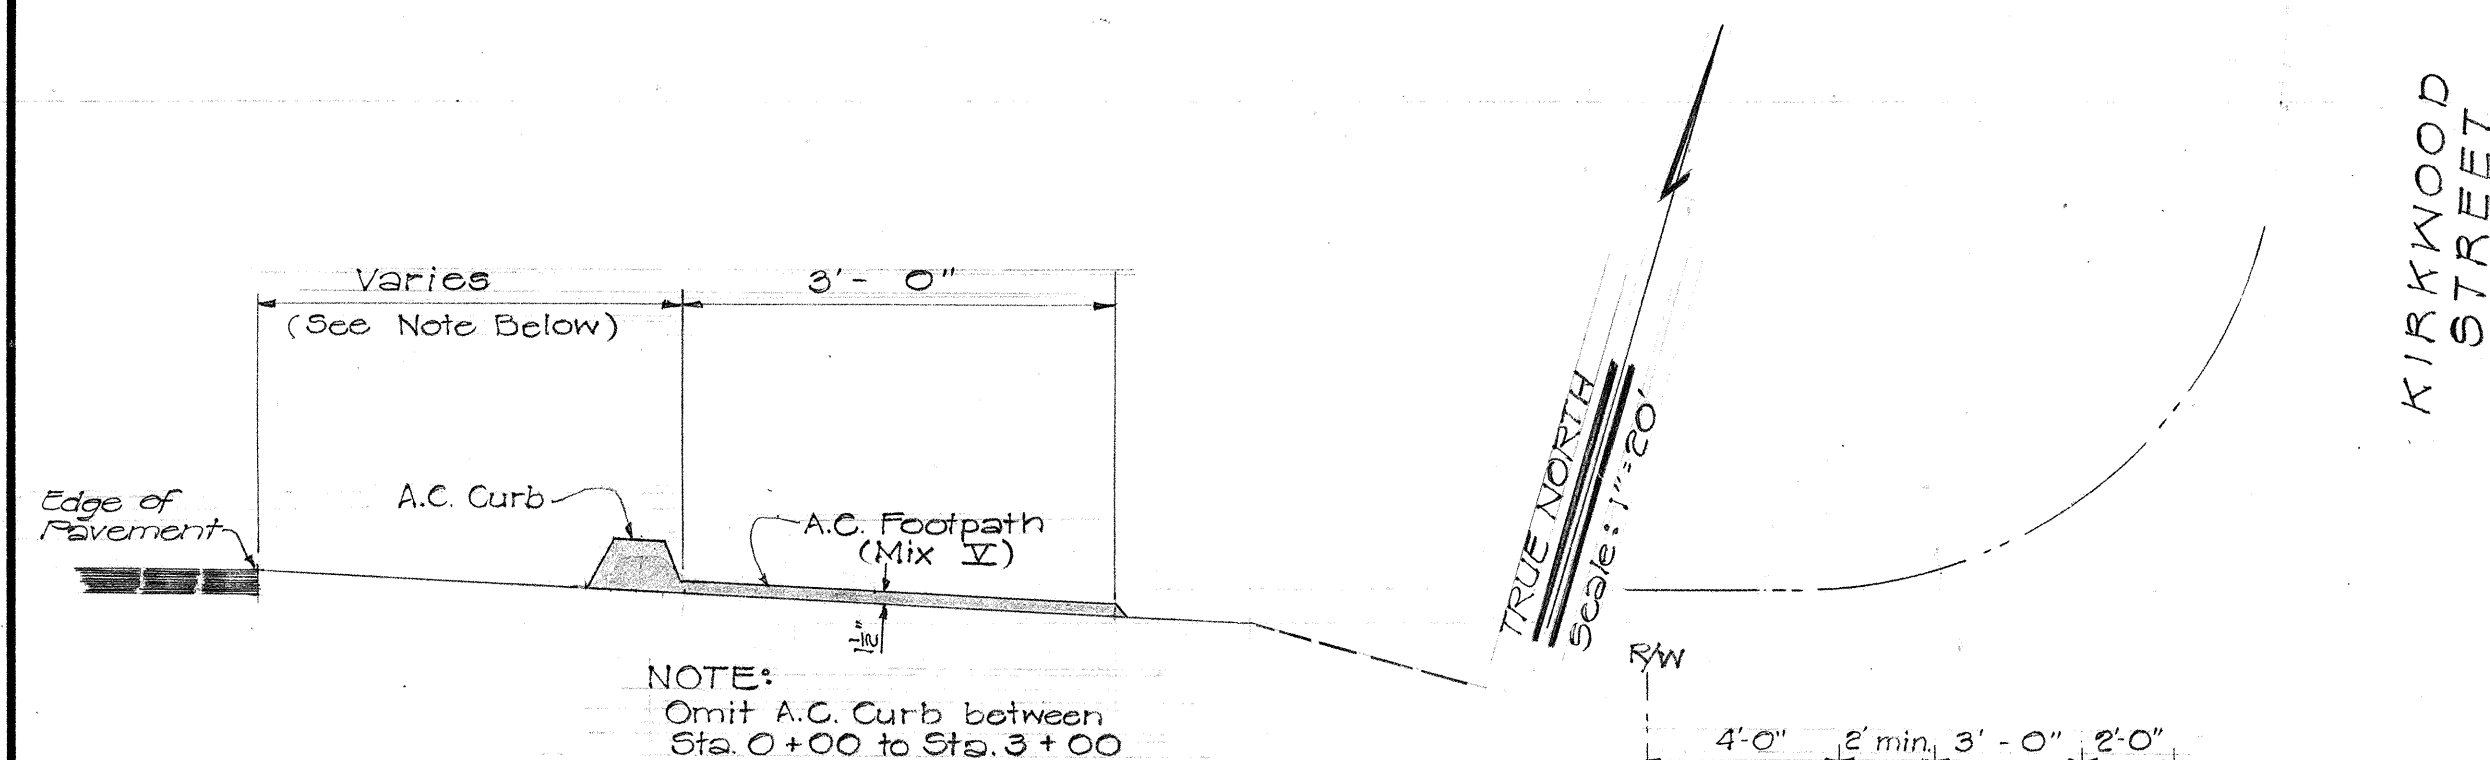

TYPICAL SECTION


Not to Scale
NOTE: See Sht. No. 8 for detail of A.C. Curb. All dimensions shown on plan are edge of pavement or existing curb line to outside edge of proposed footpath.

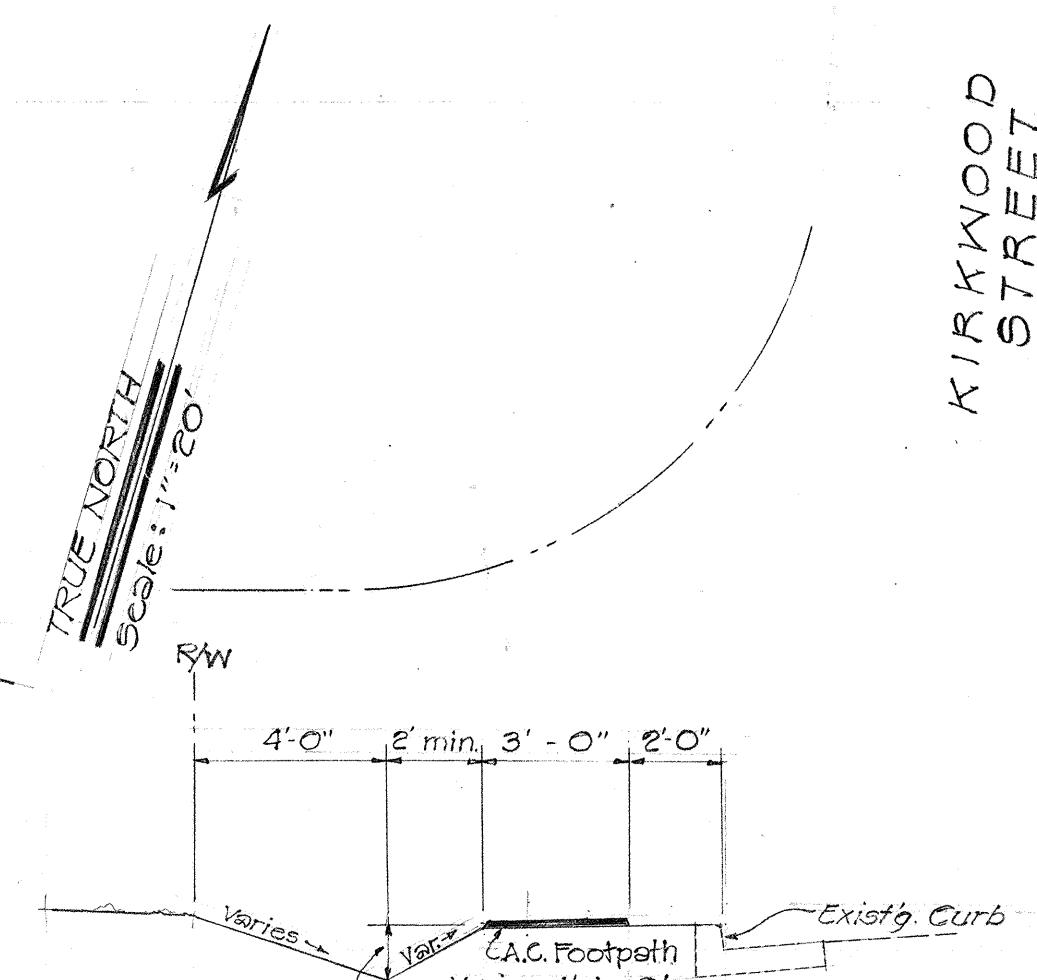



TYPICAL SECTION-SWALE

STA. 1+55± TO STA. 2+35±
Scale: 1/4" = 1'-0"

KIRKWOOD STREET
STA. 0+00 BEG. OF PROJ. C-72-01-65

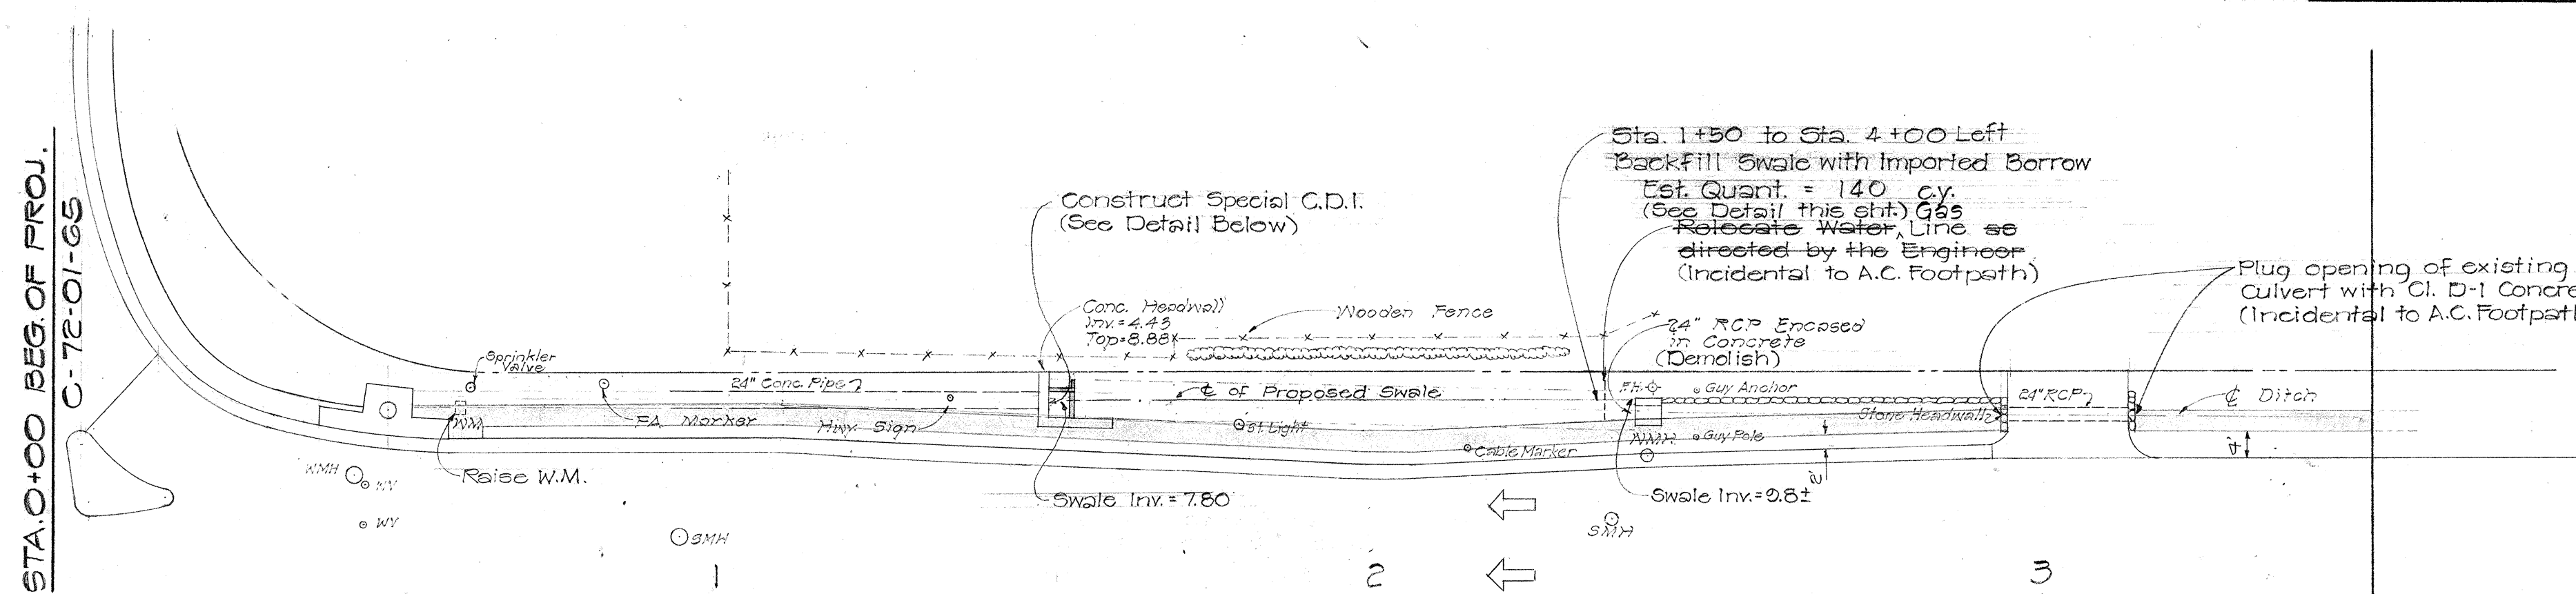



PROJ. NO. C-72-01-65

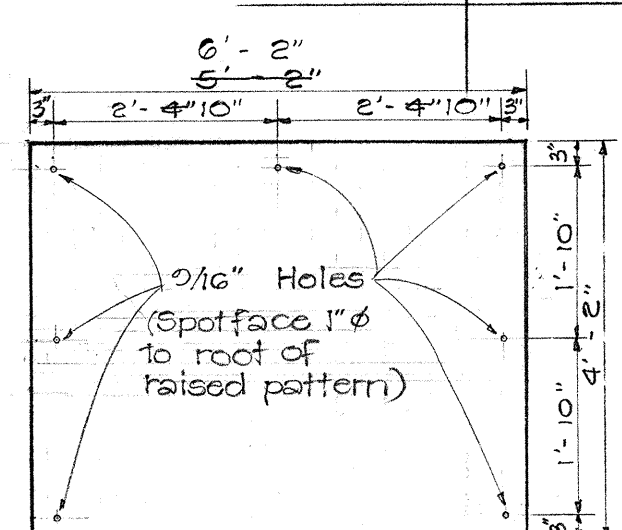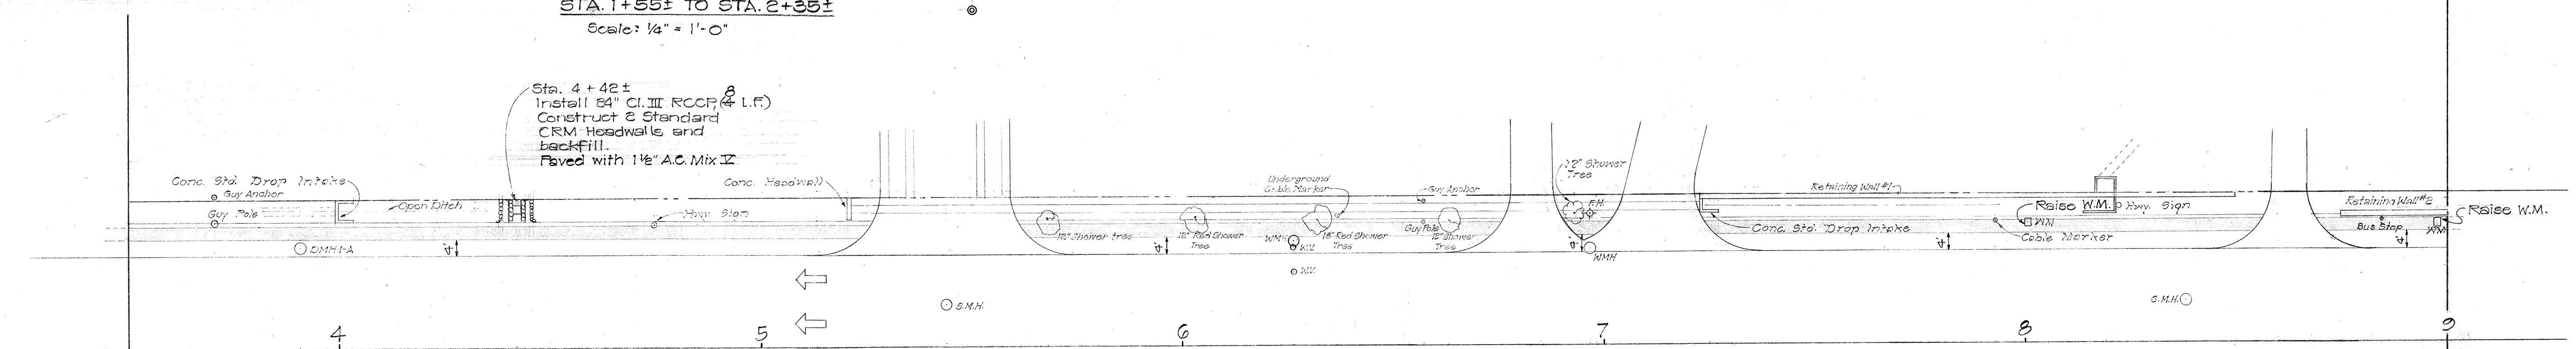

PLAN

DETAIL


CHECKER PLATE COVER FOR C.D.I

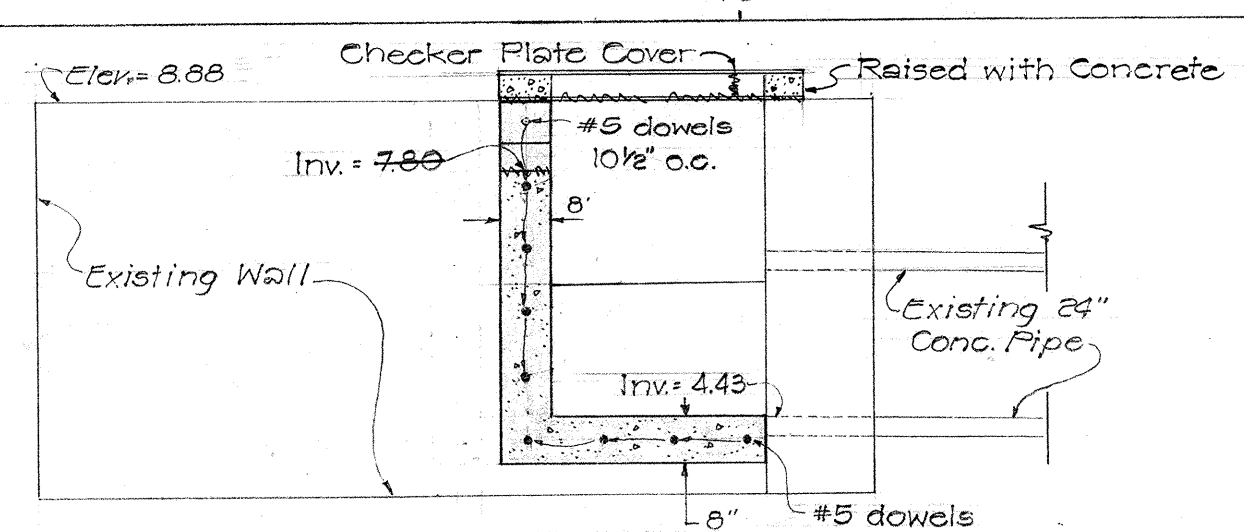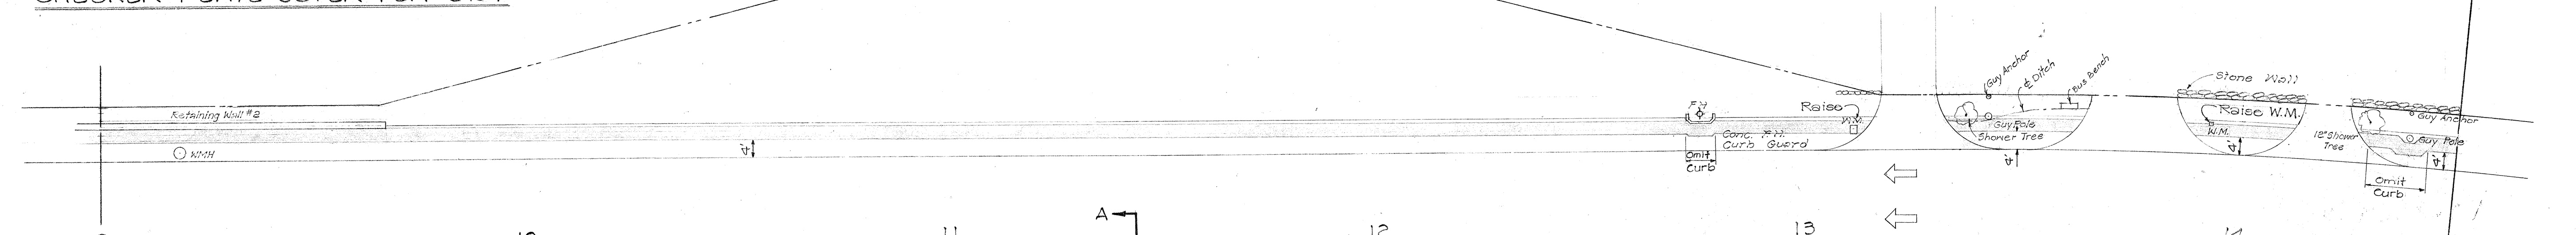

SECTION "A-A"


Scale: 3/8" = 1'-0"

NOTE: Drill 2" deep hole into existing wall. Place 16" long #5 dowels and grout.

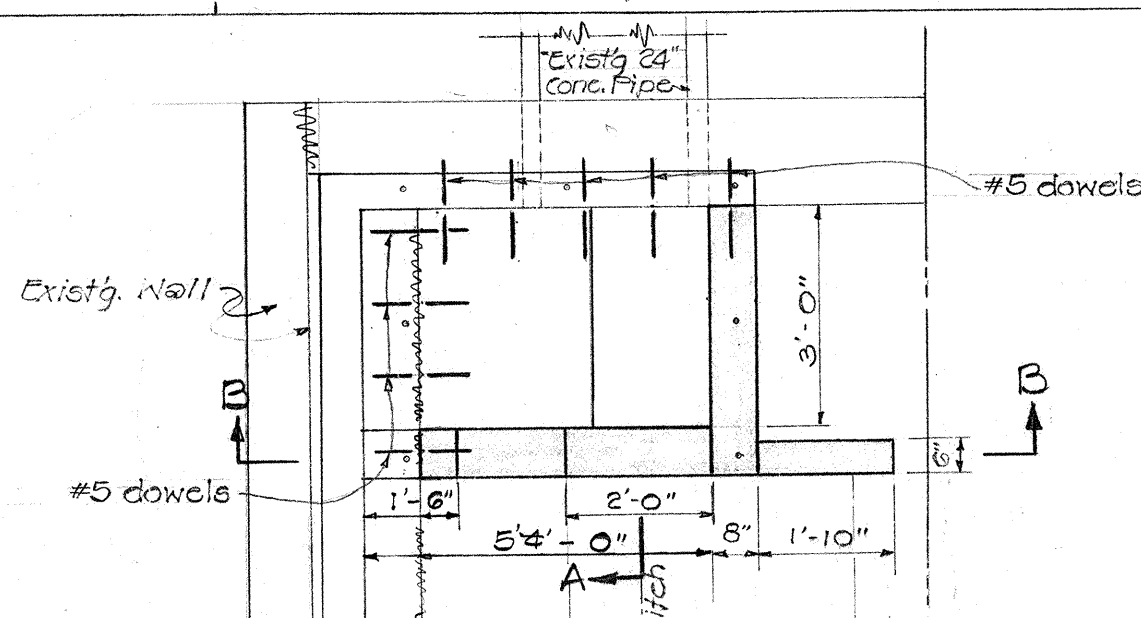

PLAN - SPECIAL C.D.I.

Scale: 3/8" = 1'-0"

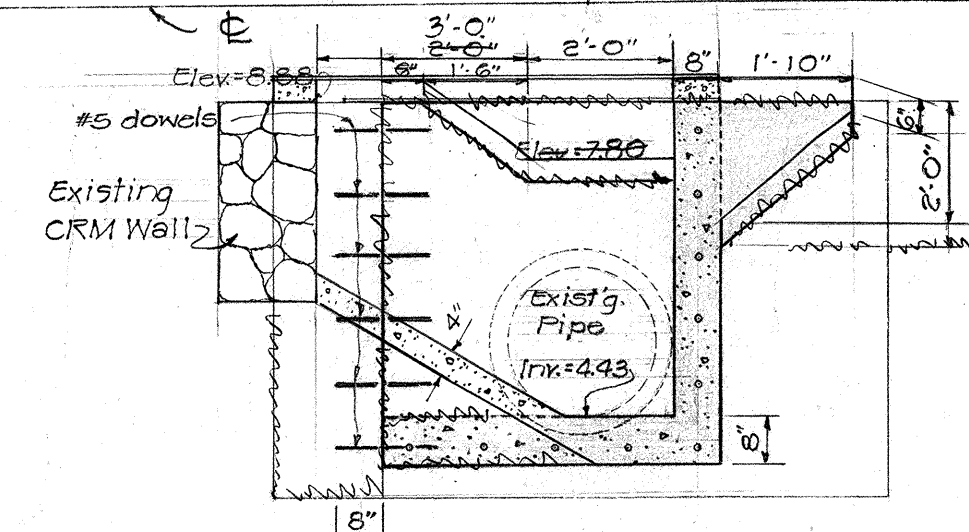

SECTION "B-B"

Scale: 3/8" = 1'-0"

STATE OF HAWAII
DEPARTMENT OF TRANSPORTATION
HIGHWAYS DIVISION

PEDESTRIAN SAFETY WALKWAY
KALANIANA'OLE HIGHWAY
STA. 0+00 to STA. 14+50
PROJECT No. C-72-01-65
Scale: As Noted
Oct. 1964
SHEET No. 1 OF 7 SHEETS

SURVEY PLOTTED BY	DATE
DRAWN BY	
TRACED BY	
CHECKED BY	
QUANTITIES BY	
CHECKED BY	
ORIGINAL PLAN	
NOTE BOOK	
No.	

STATE	PROJ. NO.	FISCAL YEAR	SHEET NO.	TOTAL SHEETS
HAW.	C-72-01-65	1964	3	2





ORIGINAL	DATE
PLAN	
NOTE BOOK	
DESIGNED BY	
CHECKED BY	
NO.	

STATE OF HAWAII
DEPARTMENT OF TRANSPORTATION
HIGHWAYS DIVISION

PEDESTRIAN SAFETY WALKWAY
KALANIANA'OLE HIGHWAY
STA. 14+50 to STA. 31+25
PROJECT NO. C-72-01-65

Scale: 1" = 20' Oct. 1964
SHEET No. 2 OF 7 SHEETS

STATE	PROJ. NO.	FISCAL YEAR	SHEET NO.	TOTAL SHEETS
HAW.	C-72-01-65	1964	4	2


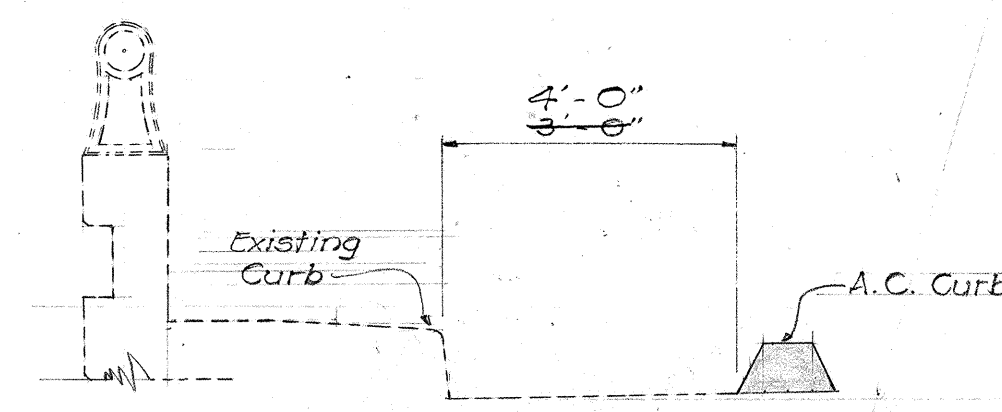
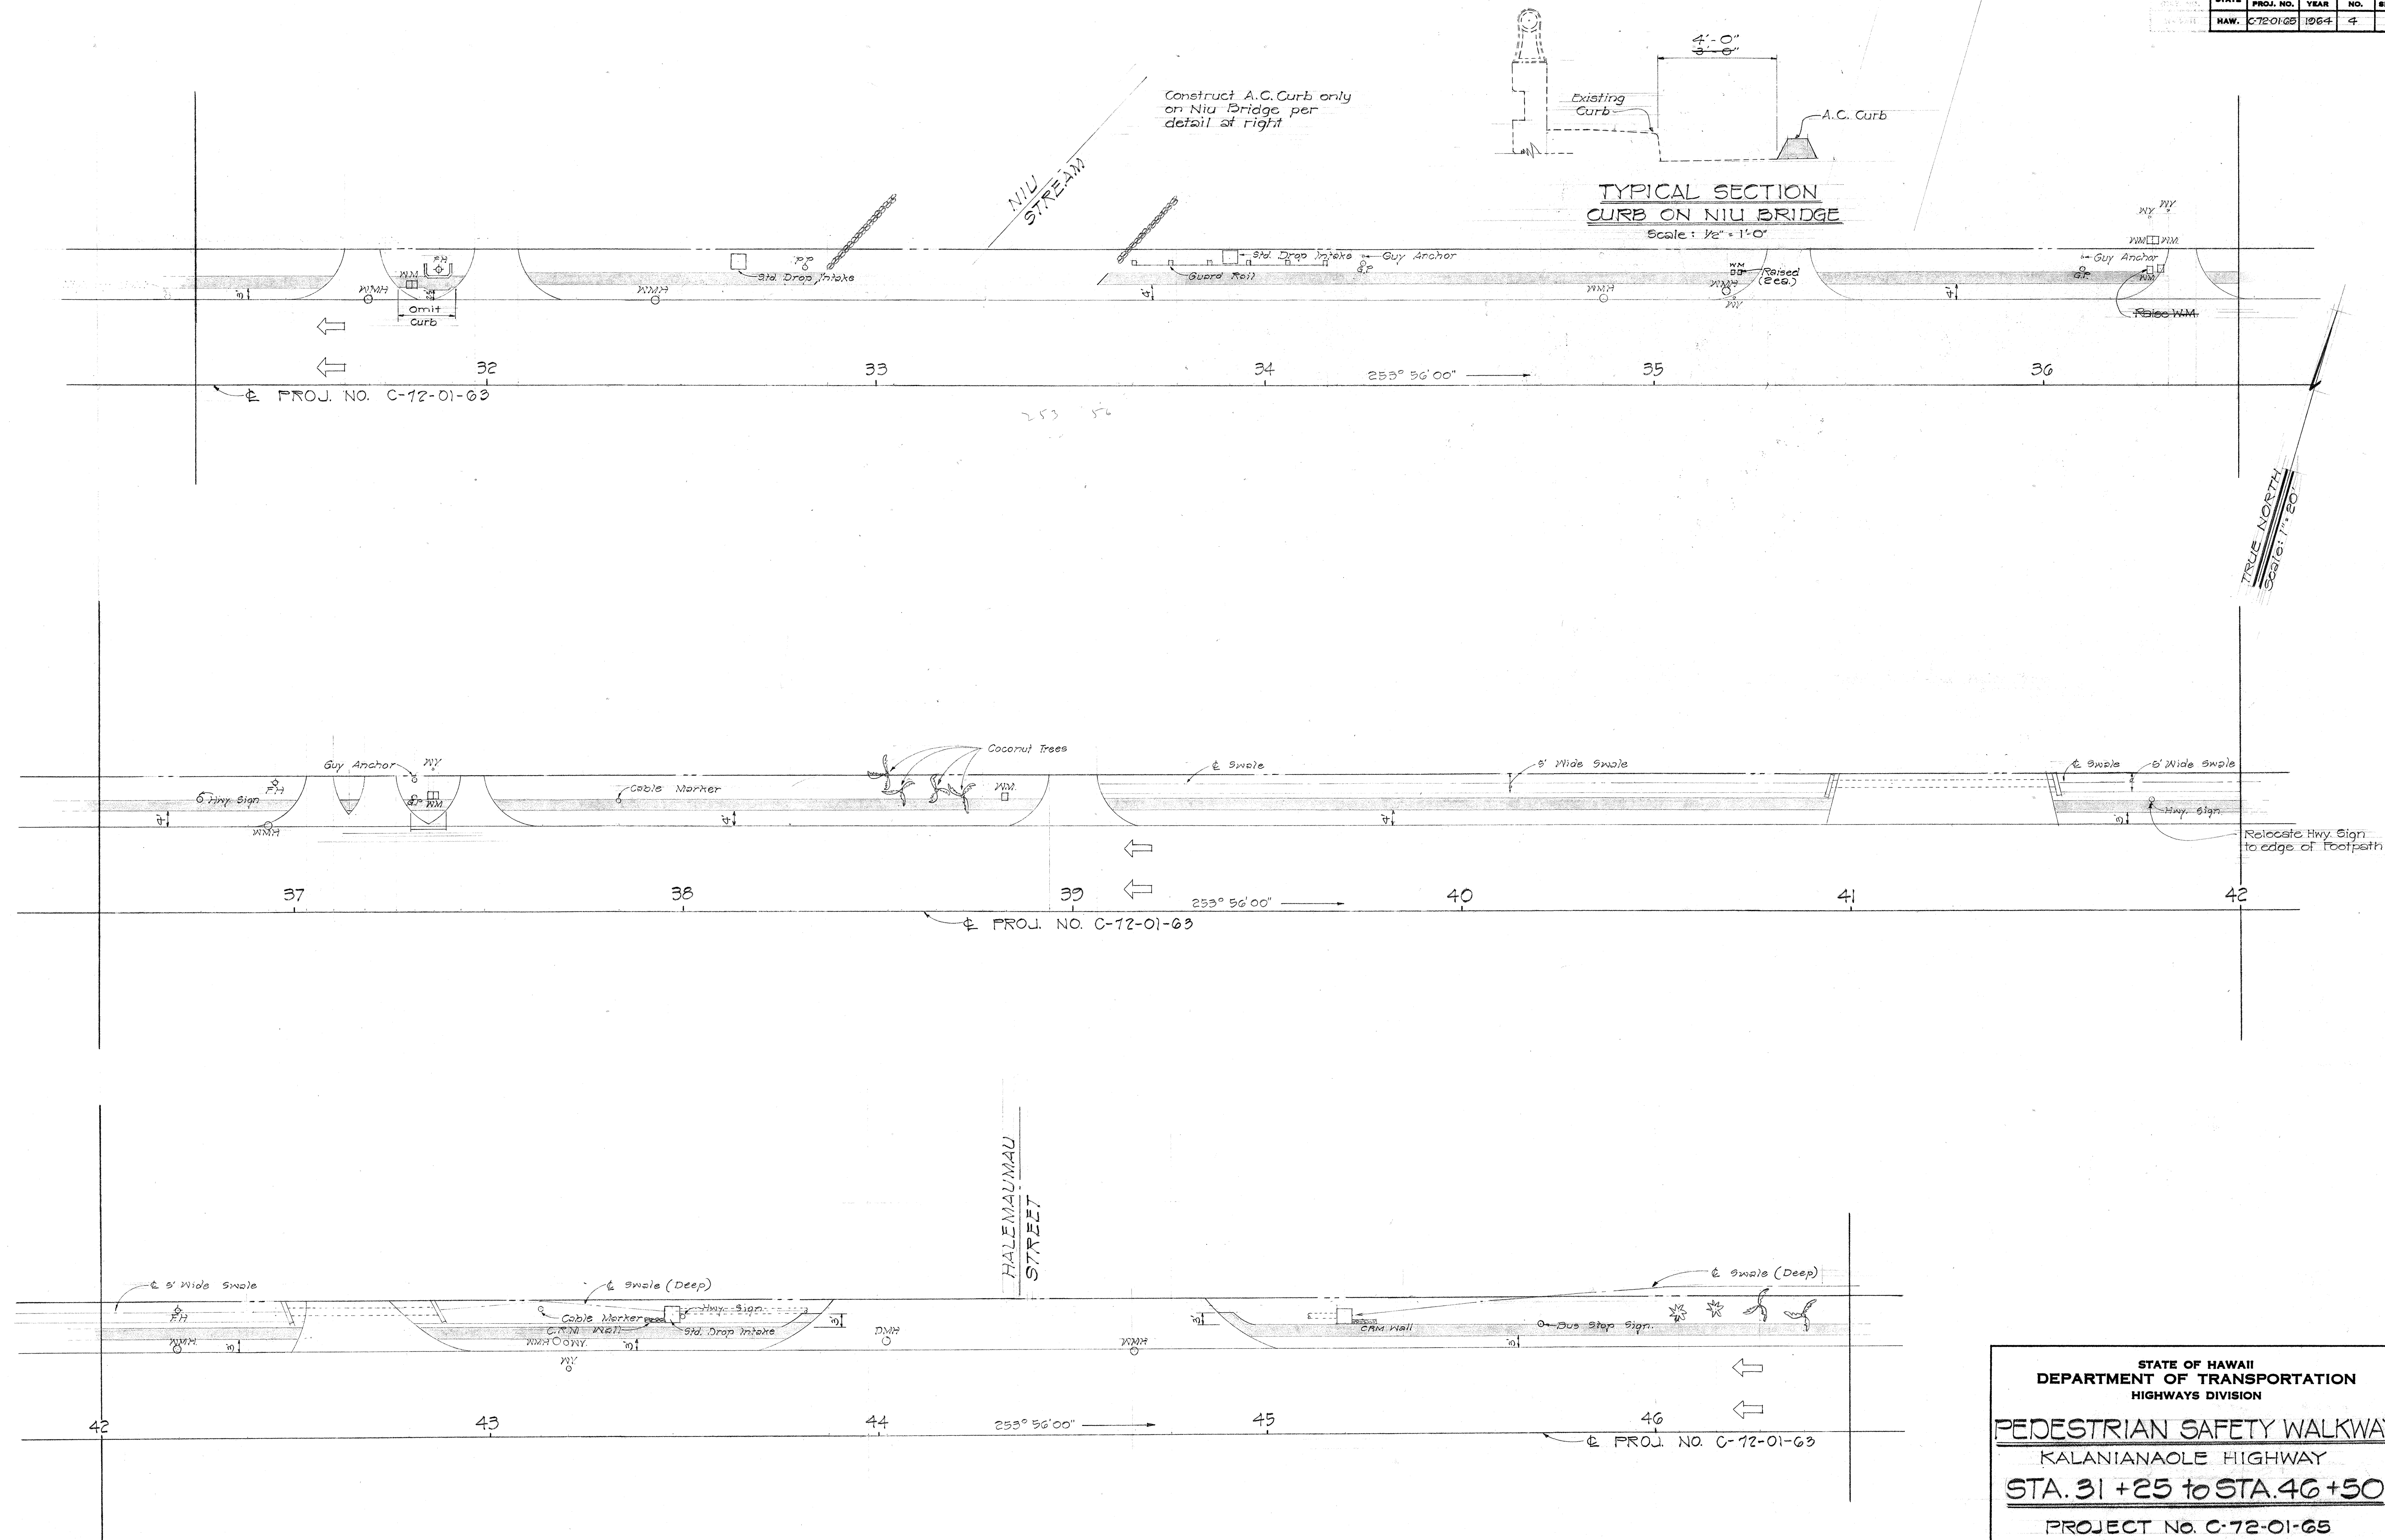


ORIGINAL PLAN	DATE
DESIGNED BY	
TRACED BY	
NOTE BOOK	
QUANTITIES BY	
CHECKED BY	
No.	

STATE OF HAWAII
DEPARTMENT OF TRANSPORTATION
HIGHWAYS DIVISION

PEDESTRIAN SAFETY WALKWAY
KALANIANAʻOLE HIGHWAY
STA. 31+25 to STA. 46+50
PROJECT NO. C-72-01-65
Scale: 1" = 20' Oct. 1964
SHEET No. 3 OF 7 SHEETS

STATE	PROJ. NO.	FISCAL YEAR	SHEET NO.	TOTAL SHEETS
HAW.	C-72-01-G3	1964	5	8

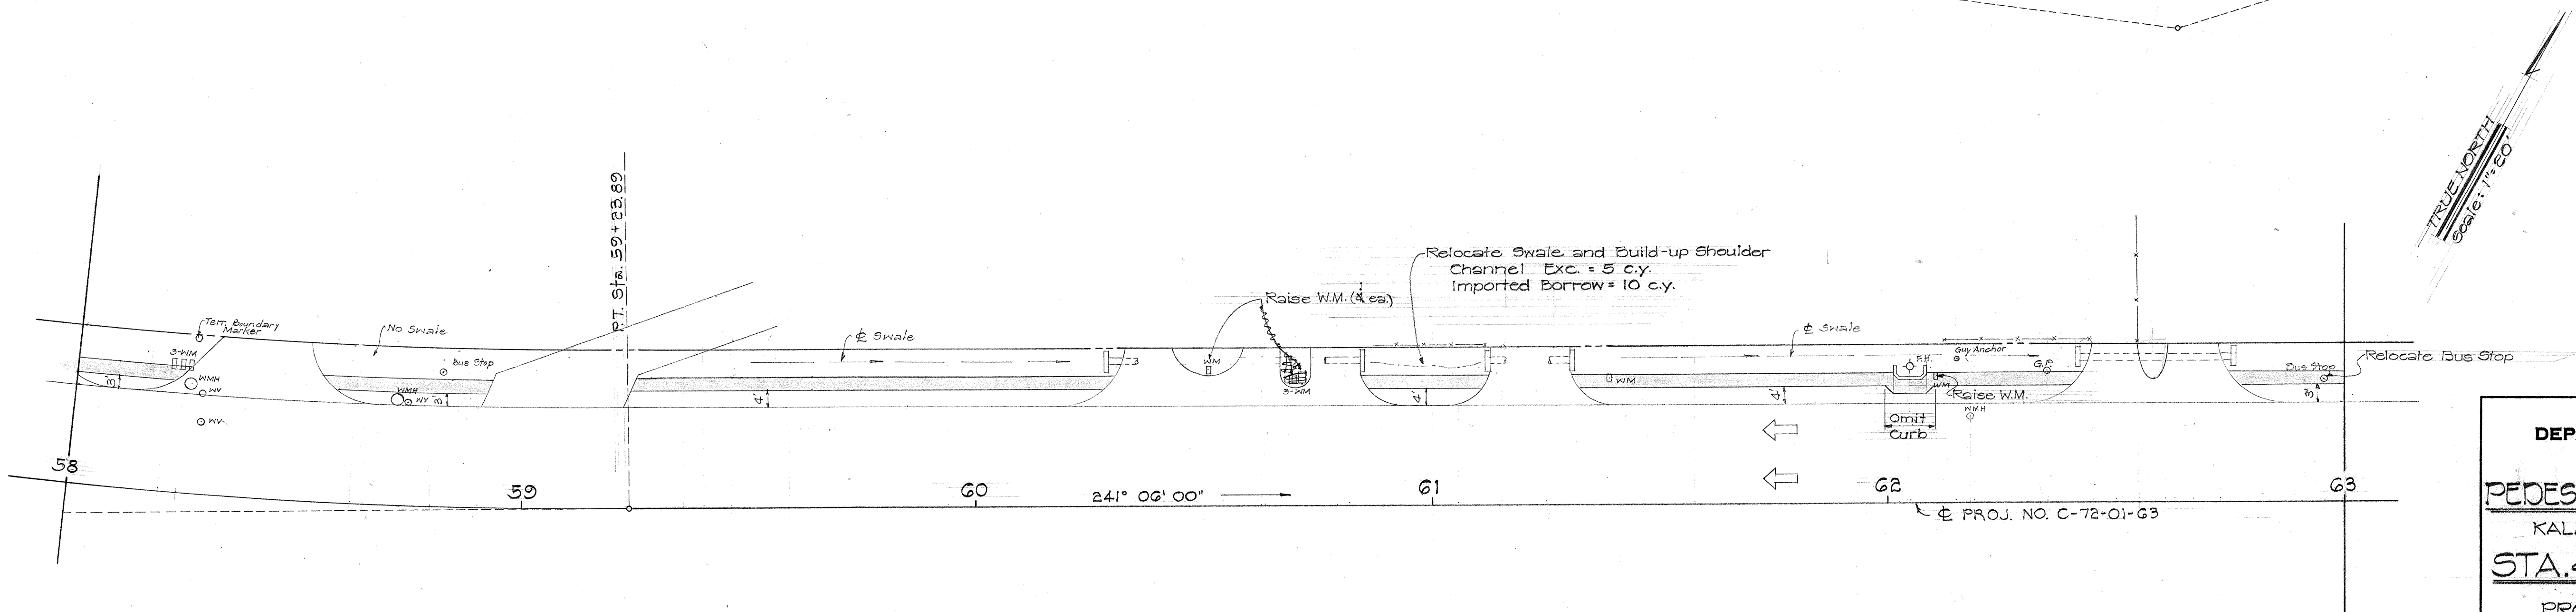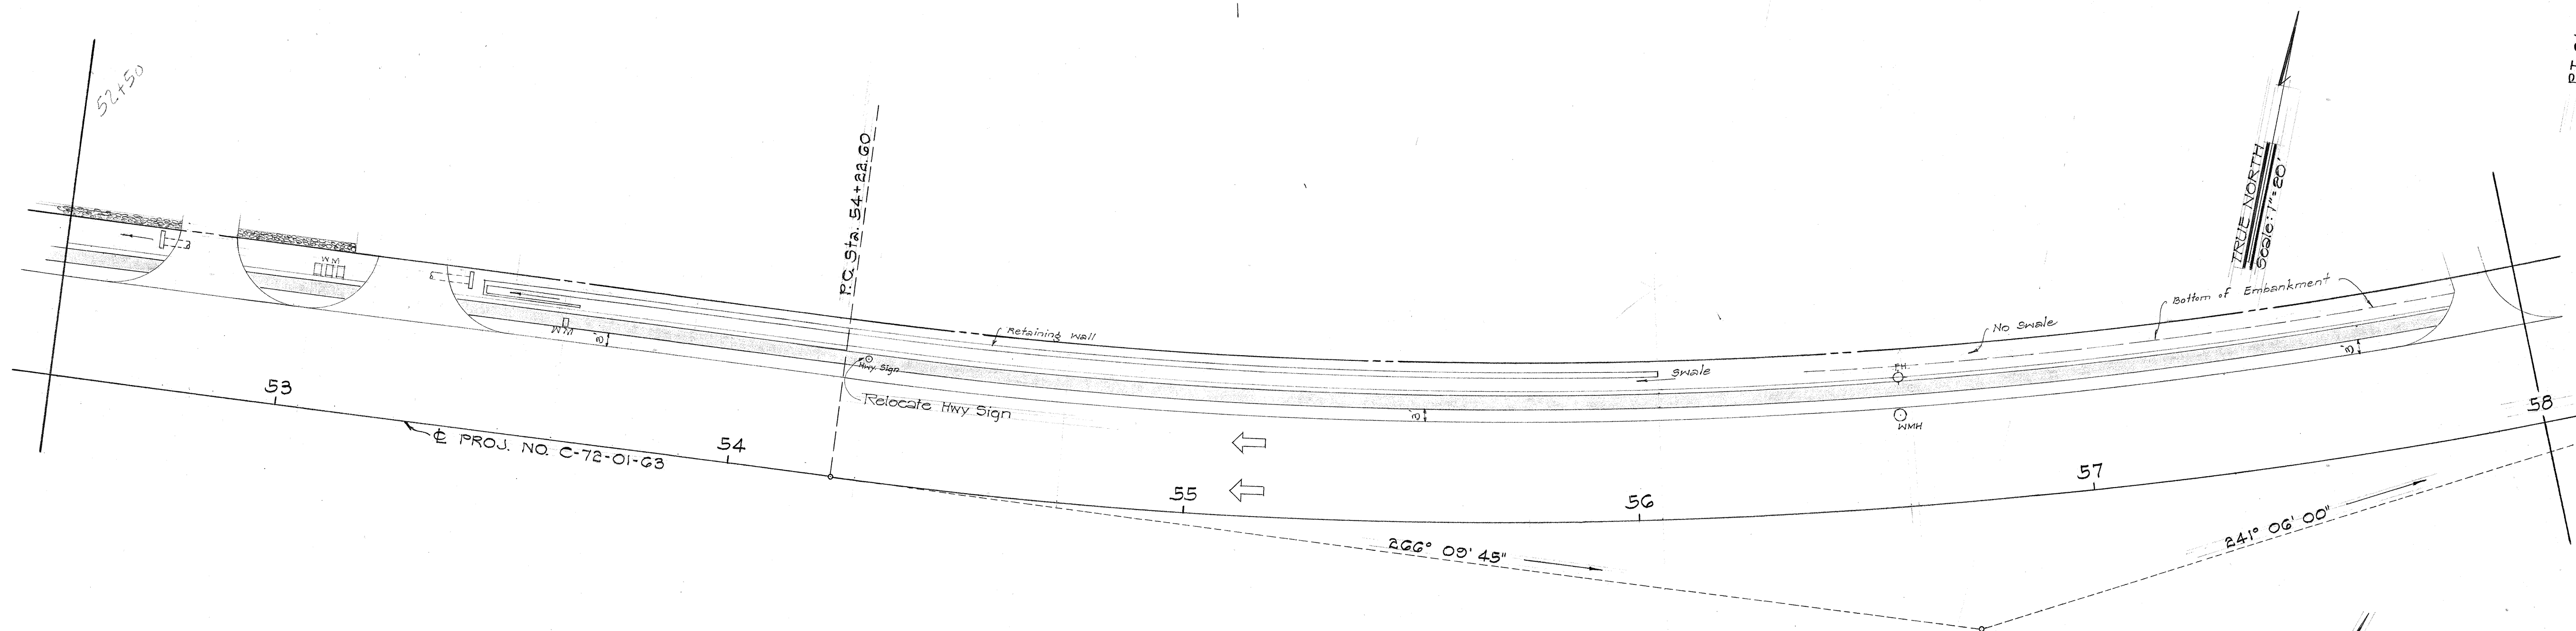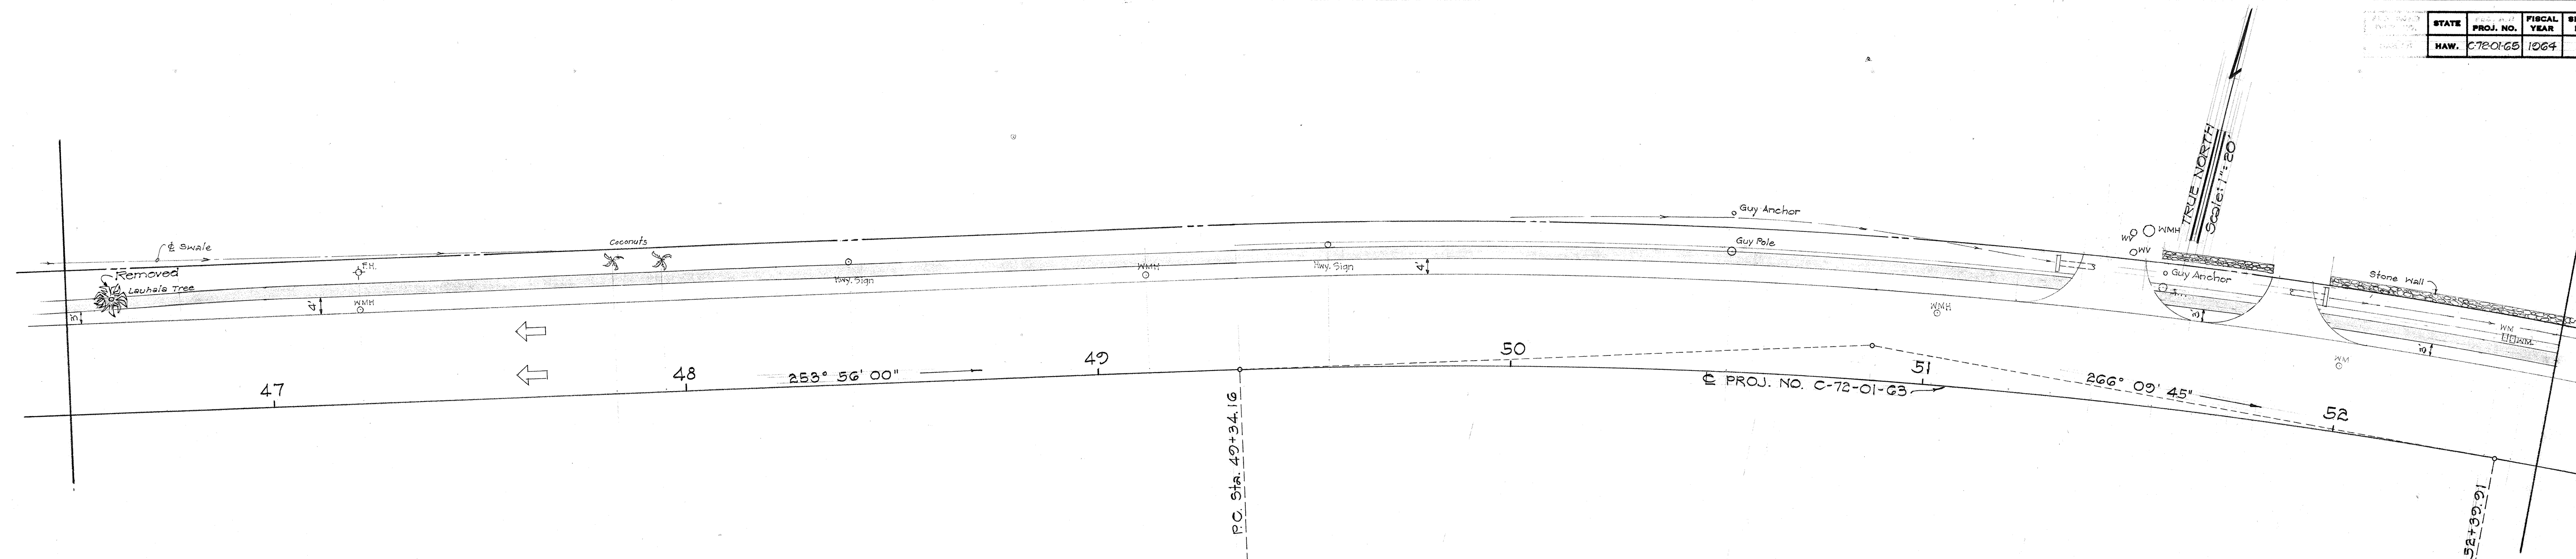

ORIGINAL PLAN	DATE
DRAWN BY	
DESIGNED BY	
NOTED BY	
CHECKED BY	
No.	

STATE OF HAWAII
DEPARTMENT OF TRANSPORTATION
HIGHWAYS DIVISION

PEDESTRIAN SAFETY WALKWAY
KALANIANA'OLE HIGHWAY
STA. 43+50 to STA. 63+00
PROJECT No. C-72-01-G3
Scale: 1" = 20' Oct. 1965
SHEET No. 4 OF 7 SHEETS

ORIGINAL PLAN	SURVEY PLOTTED BY.....		DATE.....	
	DRAWN BY.....		at.....	
NOTE BOOK	TRACED BY.....		at.....	
	DESIGNED BY.....		at.....	
	QUANTITIES BY.....		at.....	
No.....	CHECKED BY.....			

STATE OF HAWAII
DEPARTMENT OF TRANSPORTATION
HIGHWAYS DIVISION




PEDESTRIAN SAFETY WALKWAY
KALANIANA'OLE HIGHWAY
STA. 63+00 to STA. 78+00

PROJ. No. C-72-01-65

Scale: 1" = 20' Oct. 1964

SHEET No. 5 OF 7 SHEETS

STATE	PROJ. NO.	FISCAL YEAR	SHEET NO.	TOTAL SHEETS
HAW.	C-72-01-63	1964	7	9

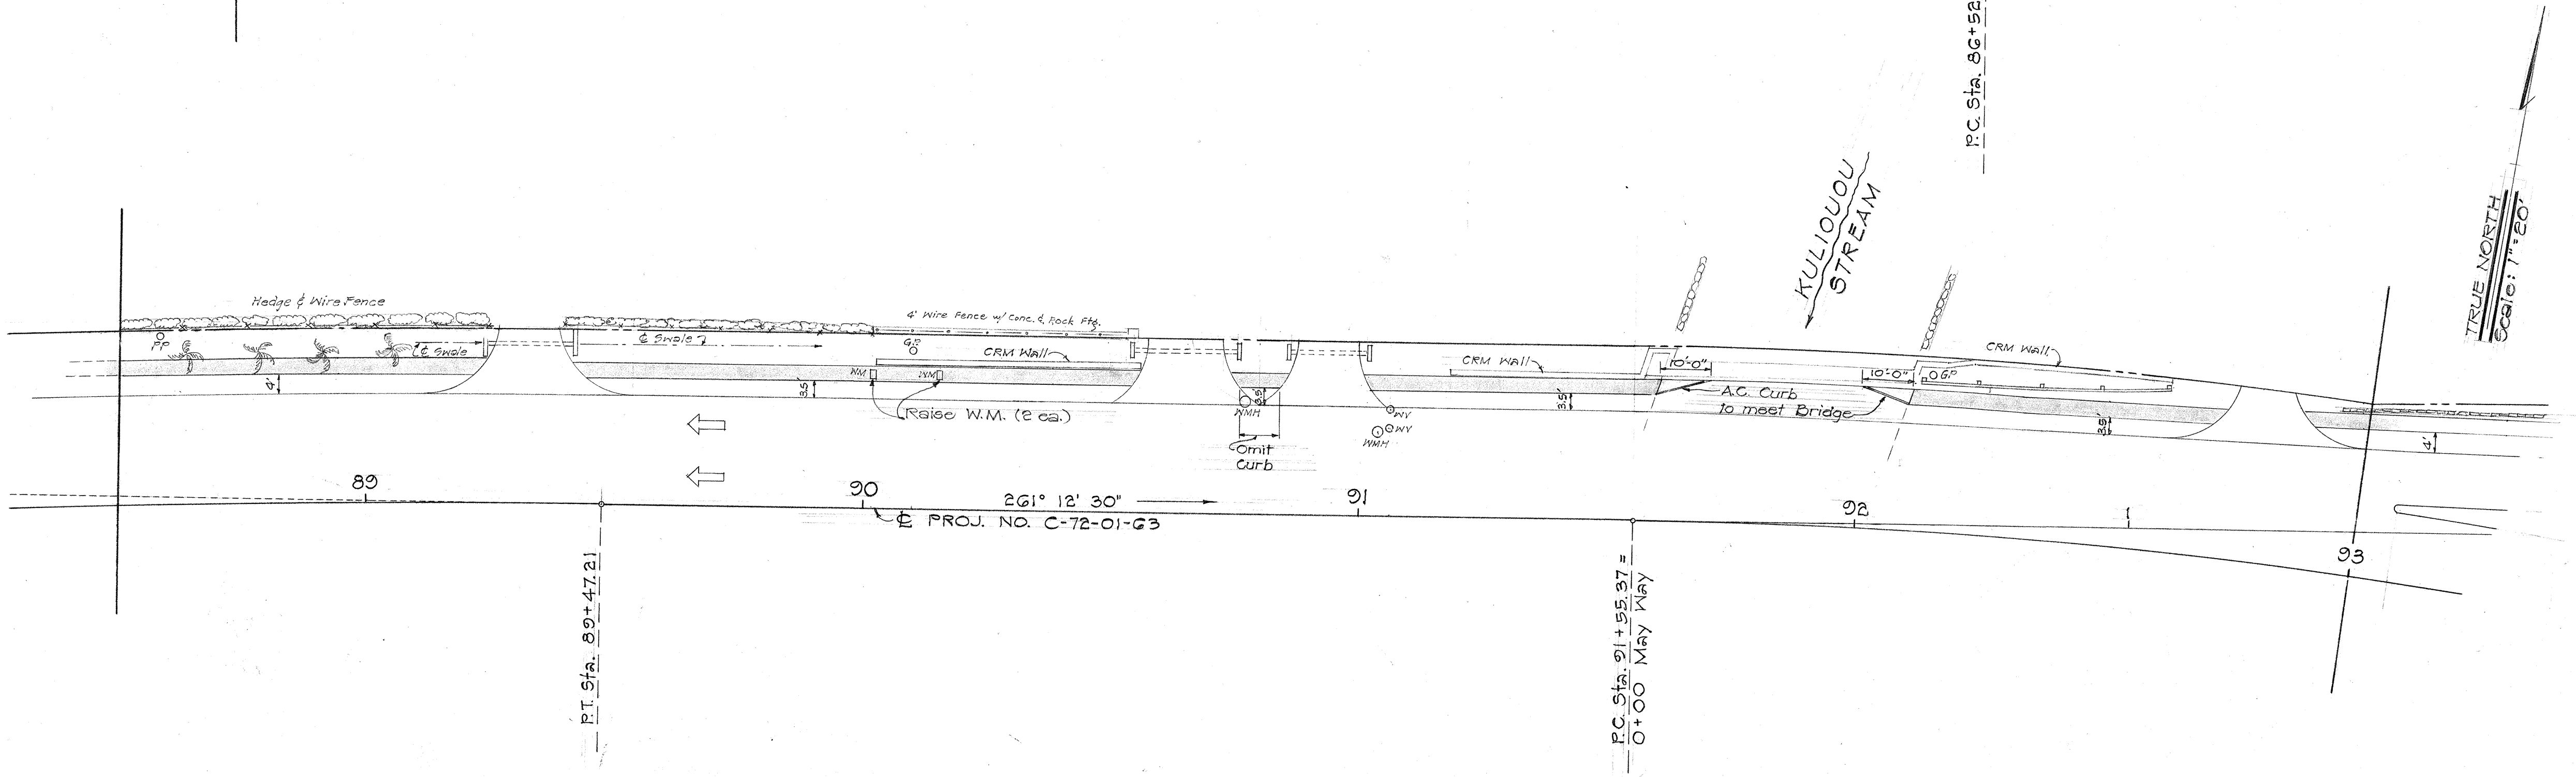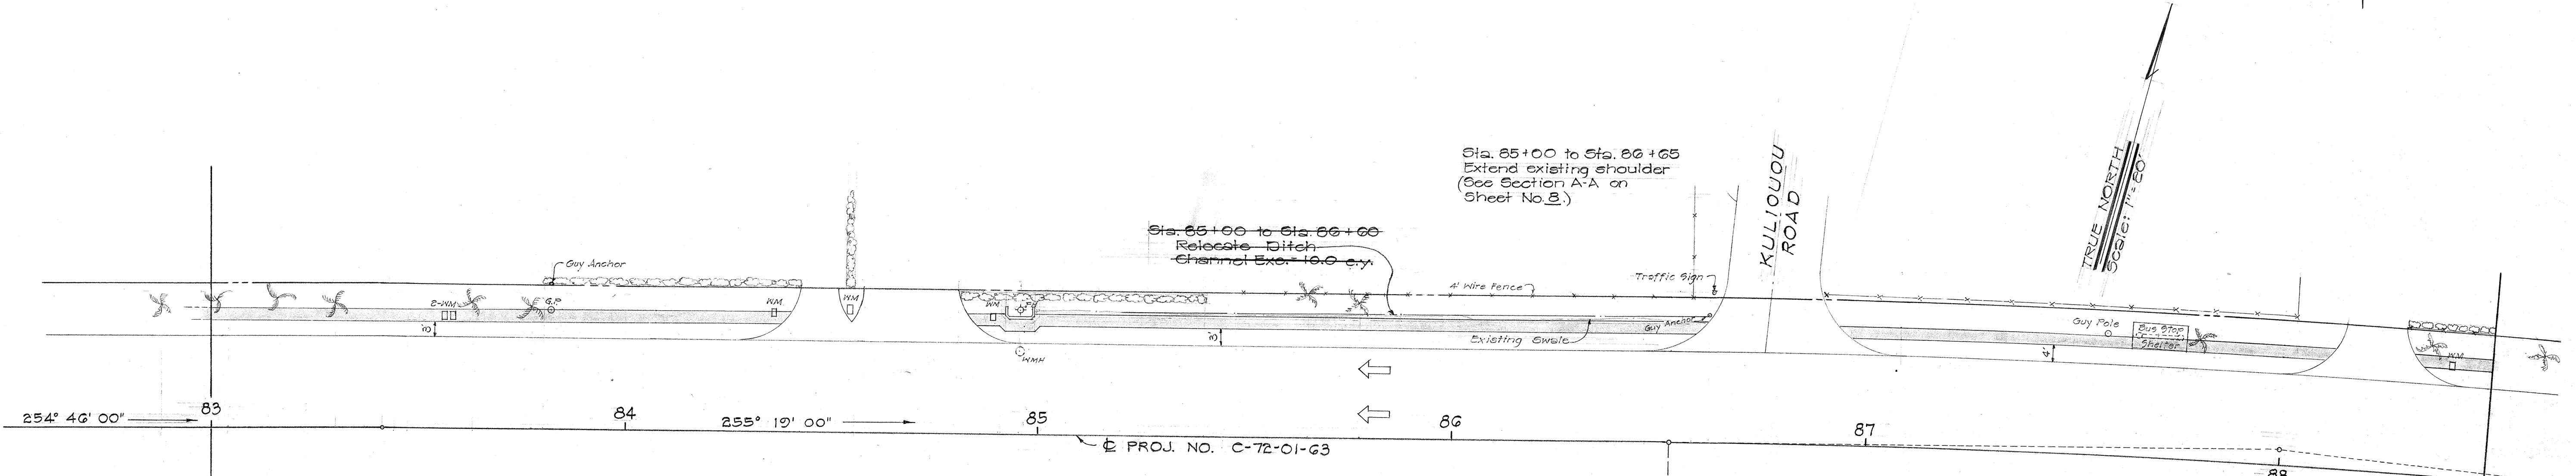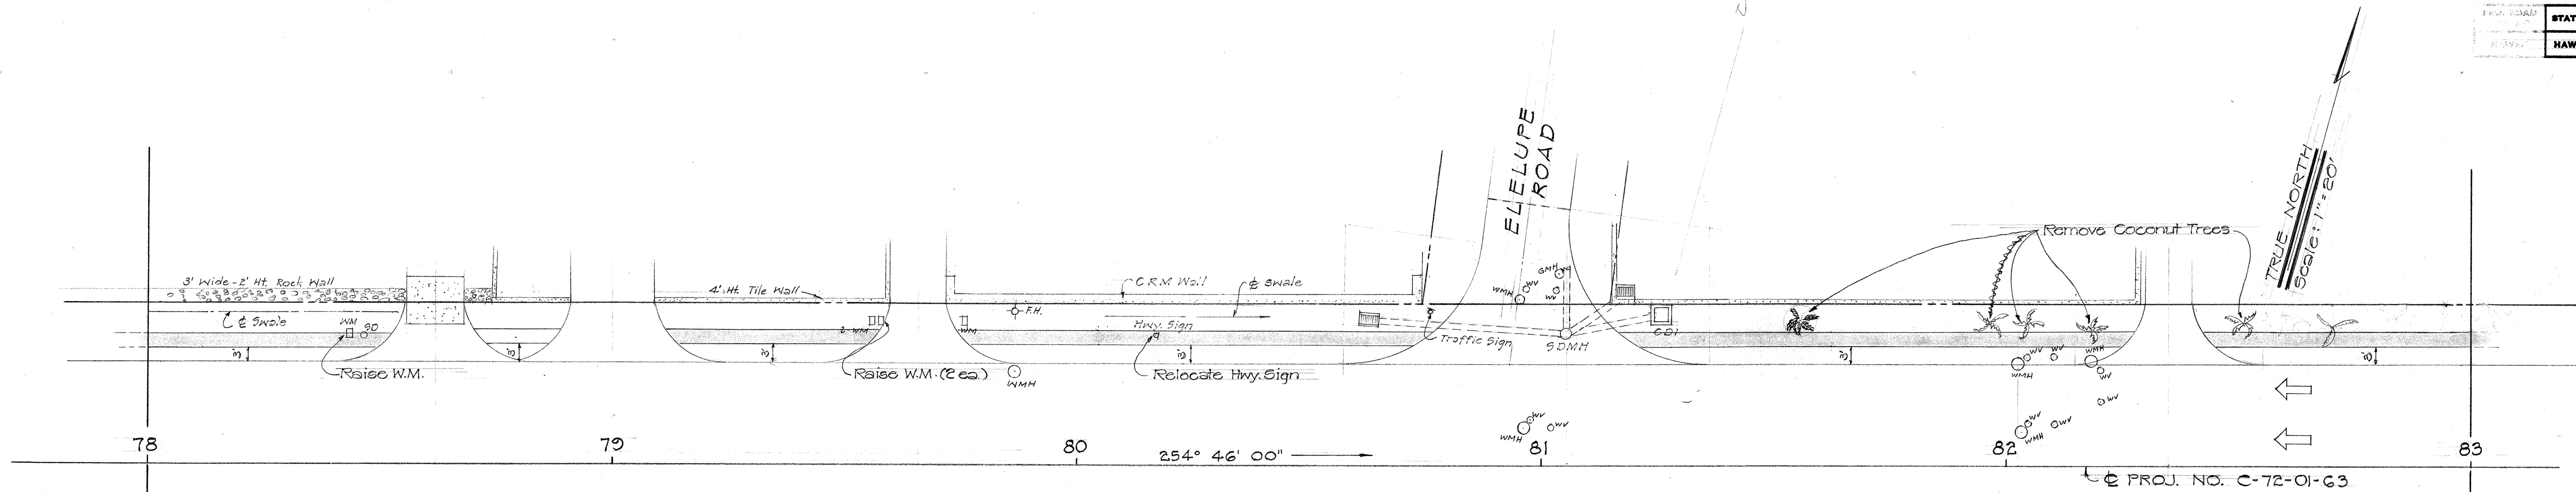


DATE	BY
DESIGNED BY	
CHECKED BY	
NO.	

STATE OF HAWAII
DEPARTMENT OF TRANSPORTATION
HIGHWAYS DIVISION

PEDESTRIAN SAFETY WALKWAY
KALANIANA'OLE HIGHWAY
STA. 78+00 to STA. 93+00
PROJECT NO. C-72-01-63
Scale: 1" = 20' Oct. 1964
SHEET No. 6 OF 7 SHEETS

STATE	PROJ. NO.	FISCAL YEAR	SHEET NO.	TOTAL SHEETS
HAW.	C-72-01-63	1964	8	9

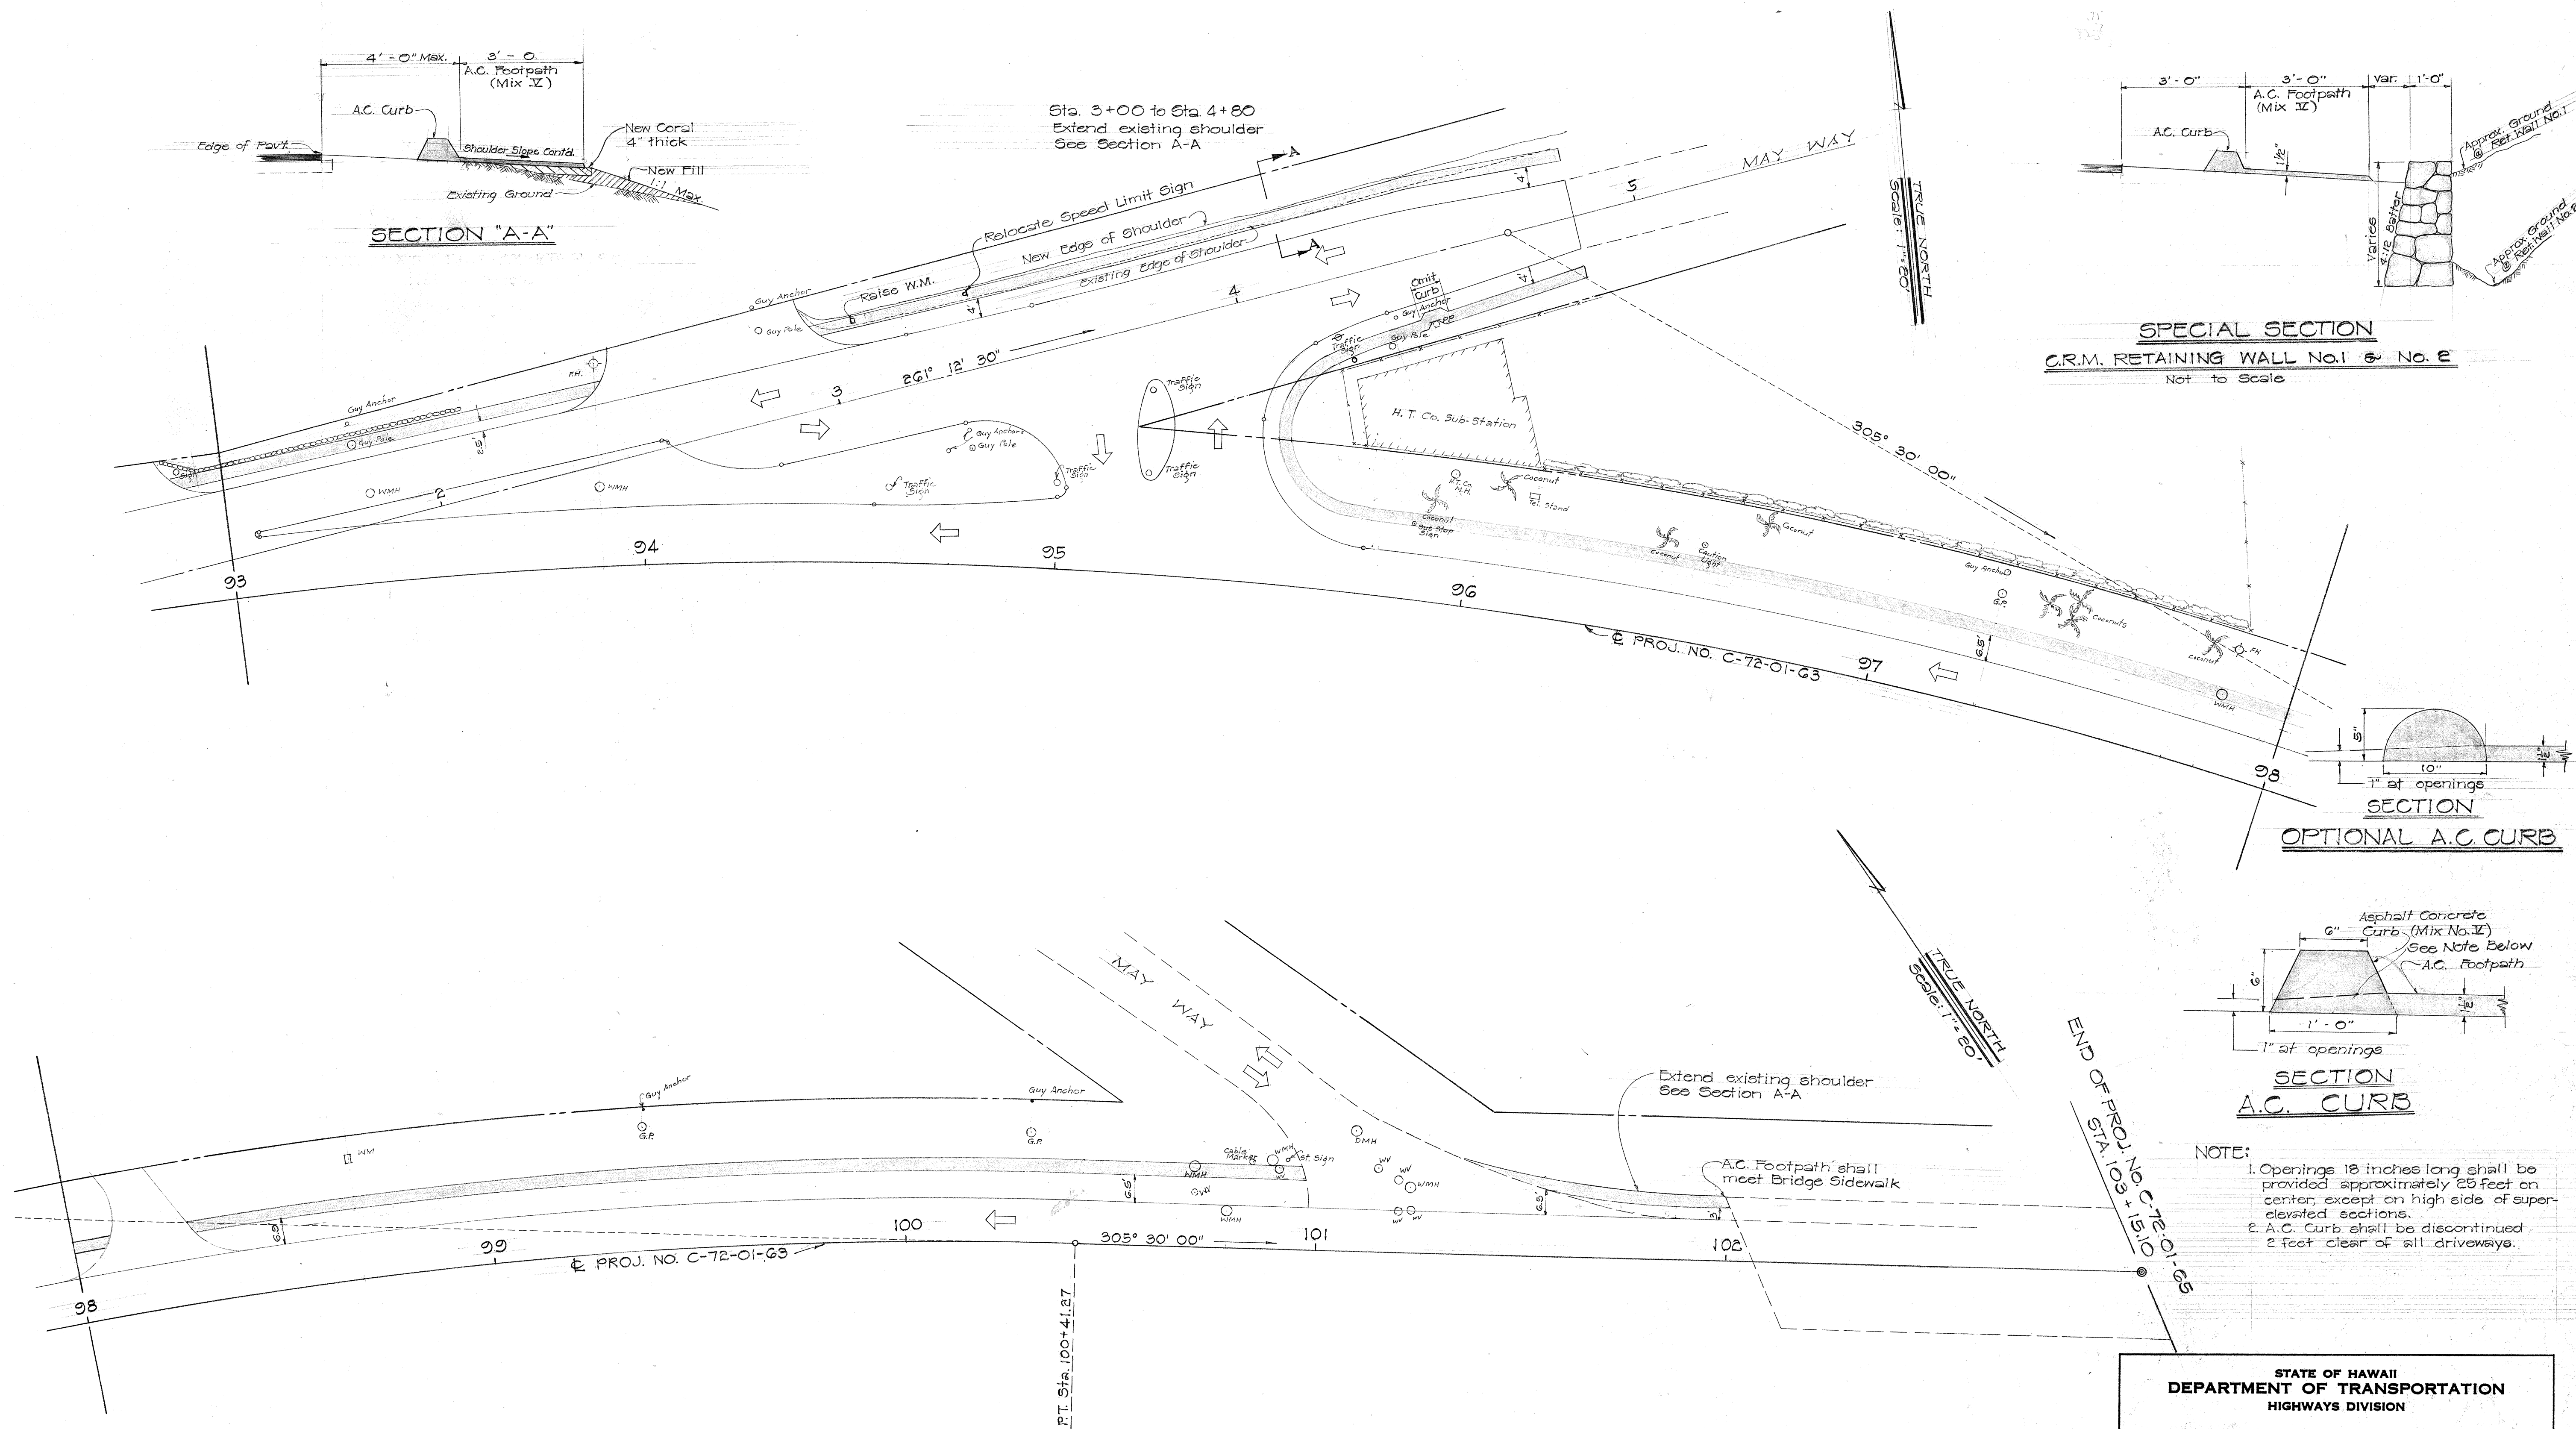

ORIGINAL PLAN	SURVEY PLOTTED BY	DATE
NOTE BOOK	DRAWN BY	
NO.	DESIGNED BY	
	QUANTITIES BY	
	CHECKED BY	

STATE OF HAWAII
DEPARTMENT OF TRANSPORTATION
HIGHWAYS DIVISION

PEDESTRIAN SAFETY WALKWAY
KALANIANAʻOLE HIGHWAY
STA. 93+00 to STA. 103+15.10
PROJECT No. C-72-01-63
Scale: As Noted Oct. 1964
SHEET No. 7 OF 7 SHEETS