



INDEX TO DRAWINGS	
SHEET NO.	DESCRIPTION
1	TITLE SHEET
2-8	PLAN AND PROFILE
9	BRIDGE DETAILS

STATE OF HAWAII
DEPARTMENT OF TRANSPORTATION
HIGHWAYS DIVISION
HONOLULU, HAWAII
"AS BUILT"
PLANS OF

CONSTRUCTION OF A
PEDESTRIAN SAFETY WALKWAY
ALONG KALANIANA'OLE HIGHWAY
KIRKWOOD STREET TO MAY WAY
PROJECT NO. C-72-01-65
DISTRICT OF HONOLULU
ISLAND OF OAHU

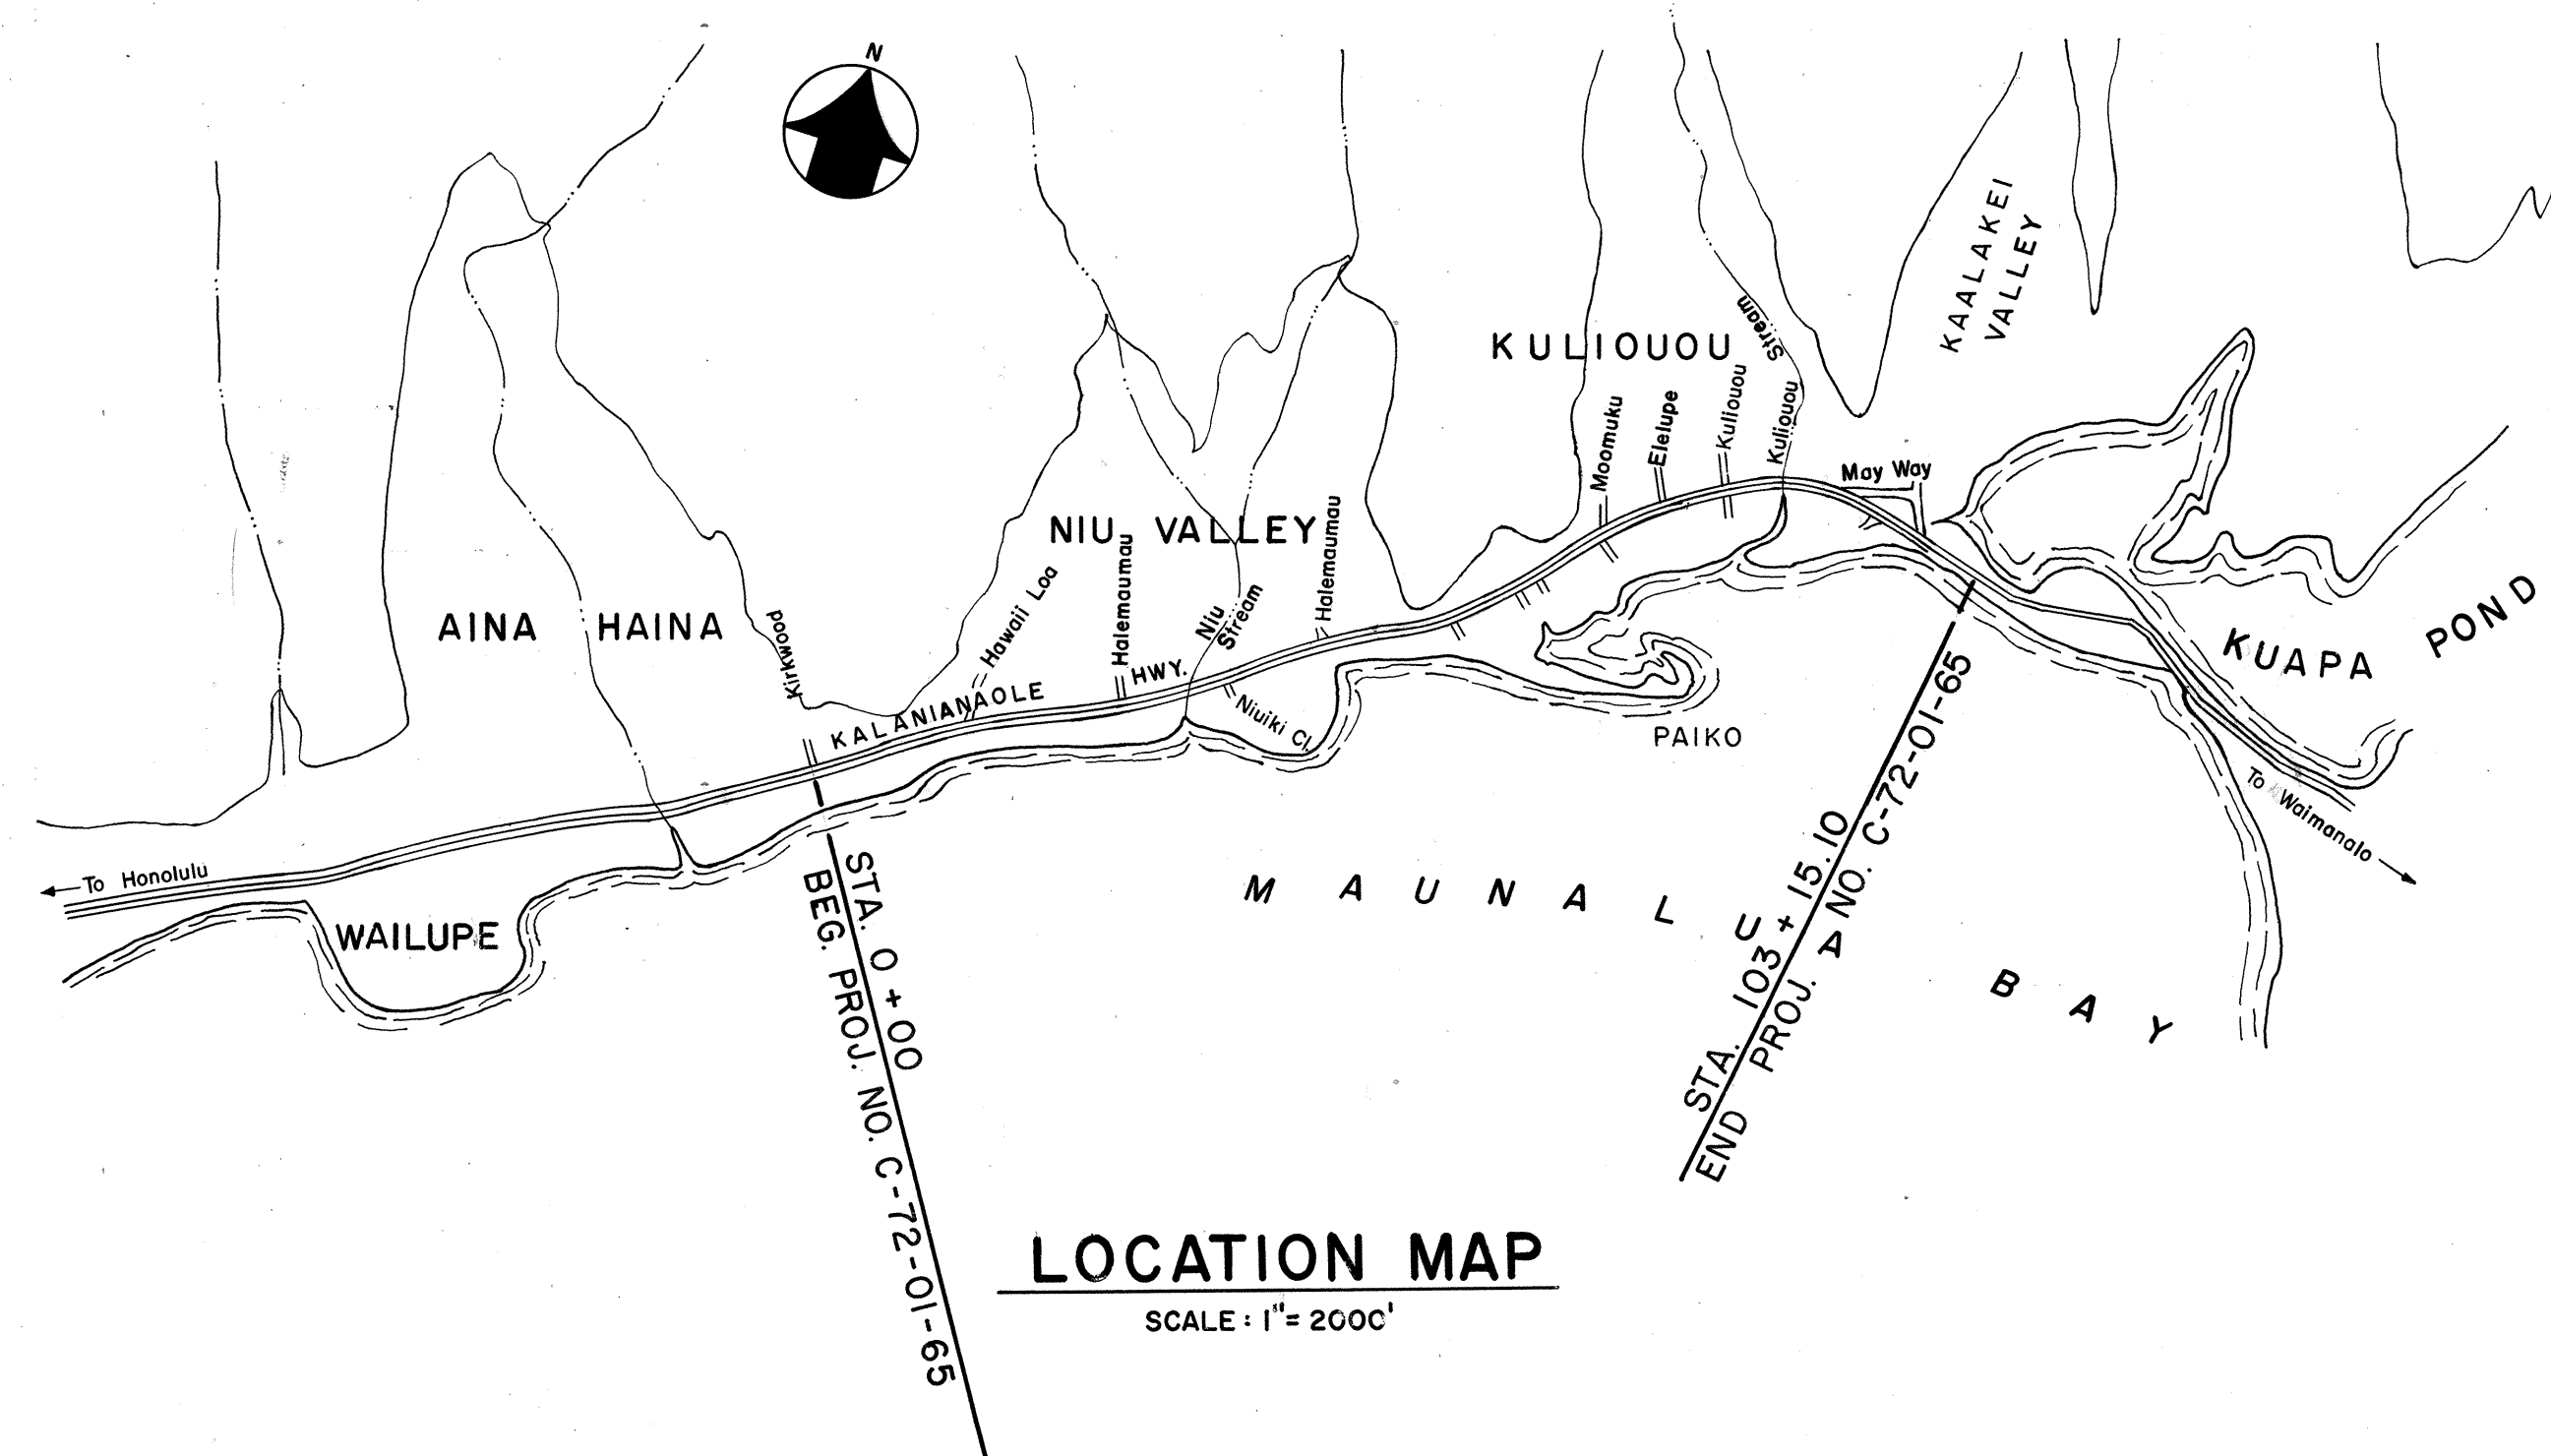


GROSS LENGTH OF PROJECT1.954 MILES
BRIDGES0.246 MILES
NET LENGTH OF PROJECT1.708 MILES

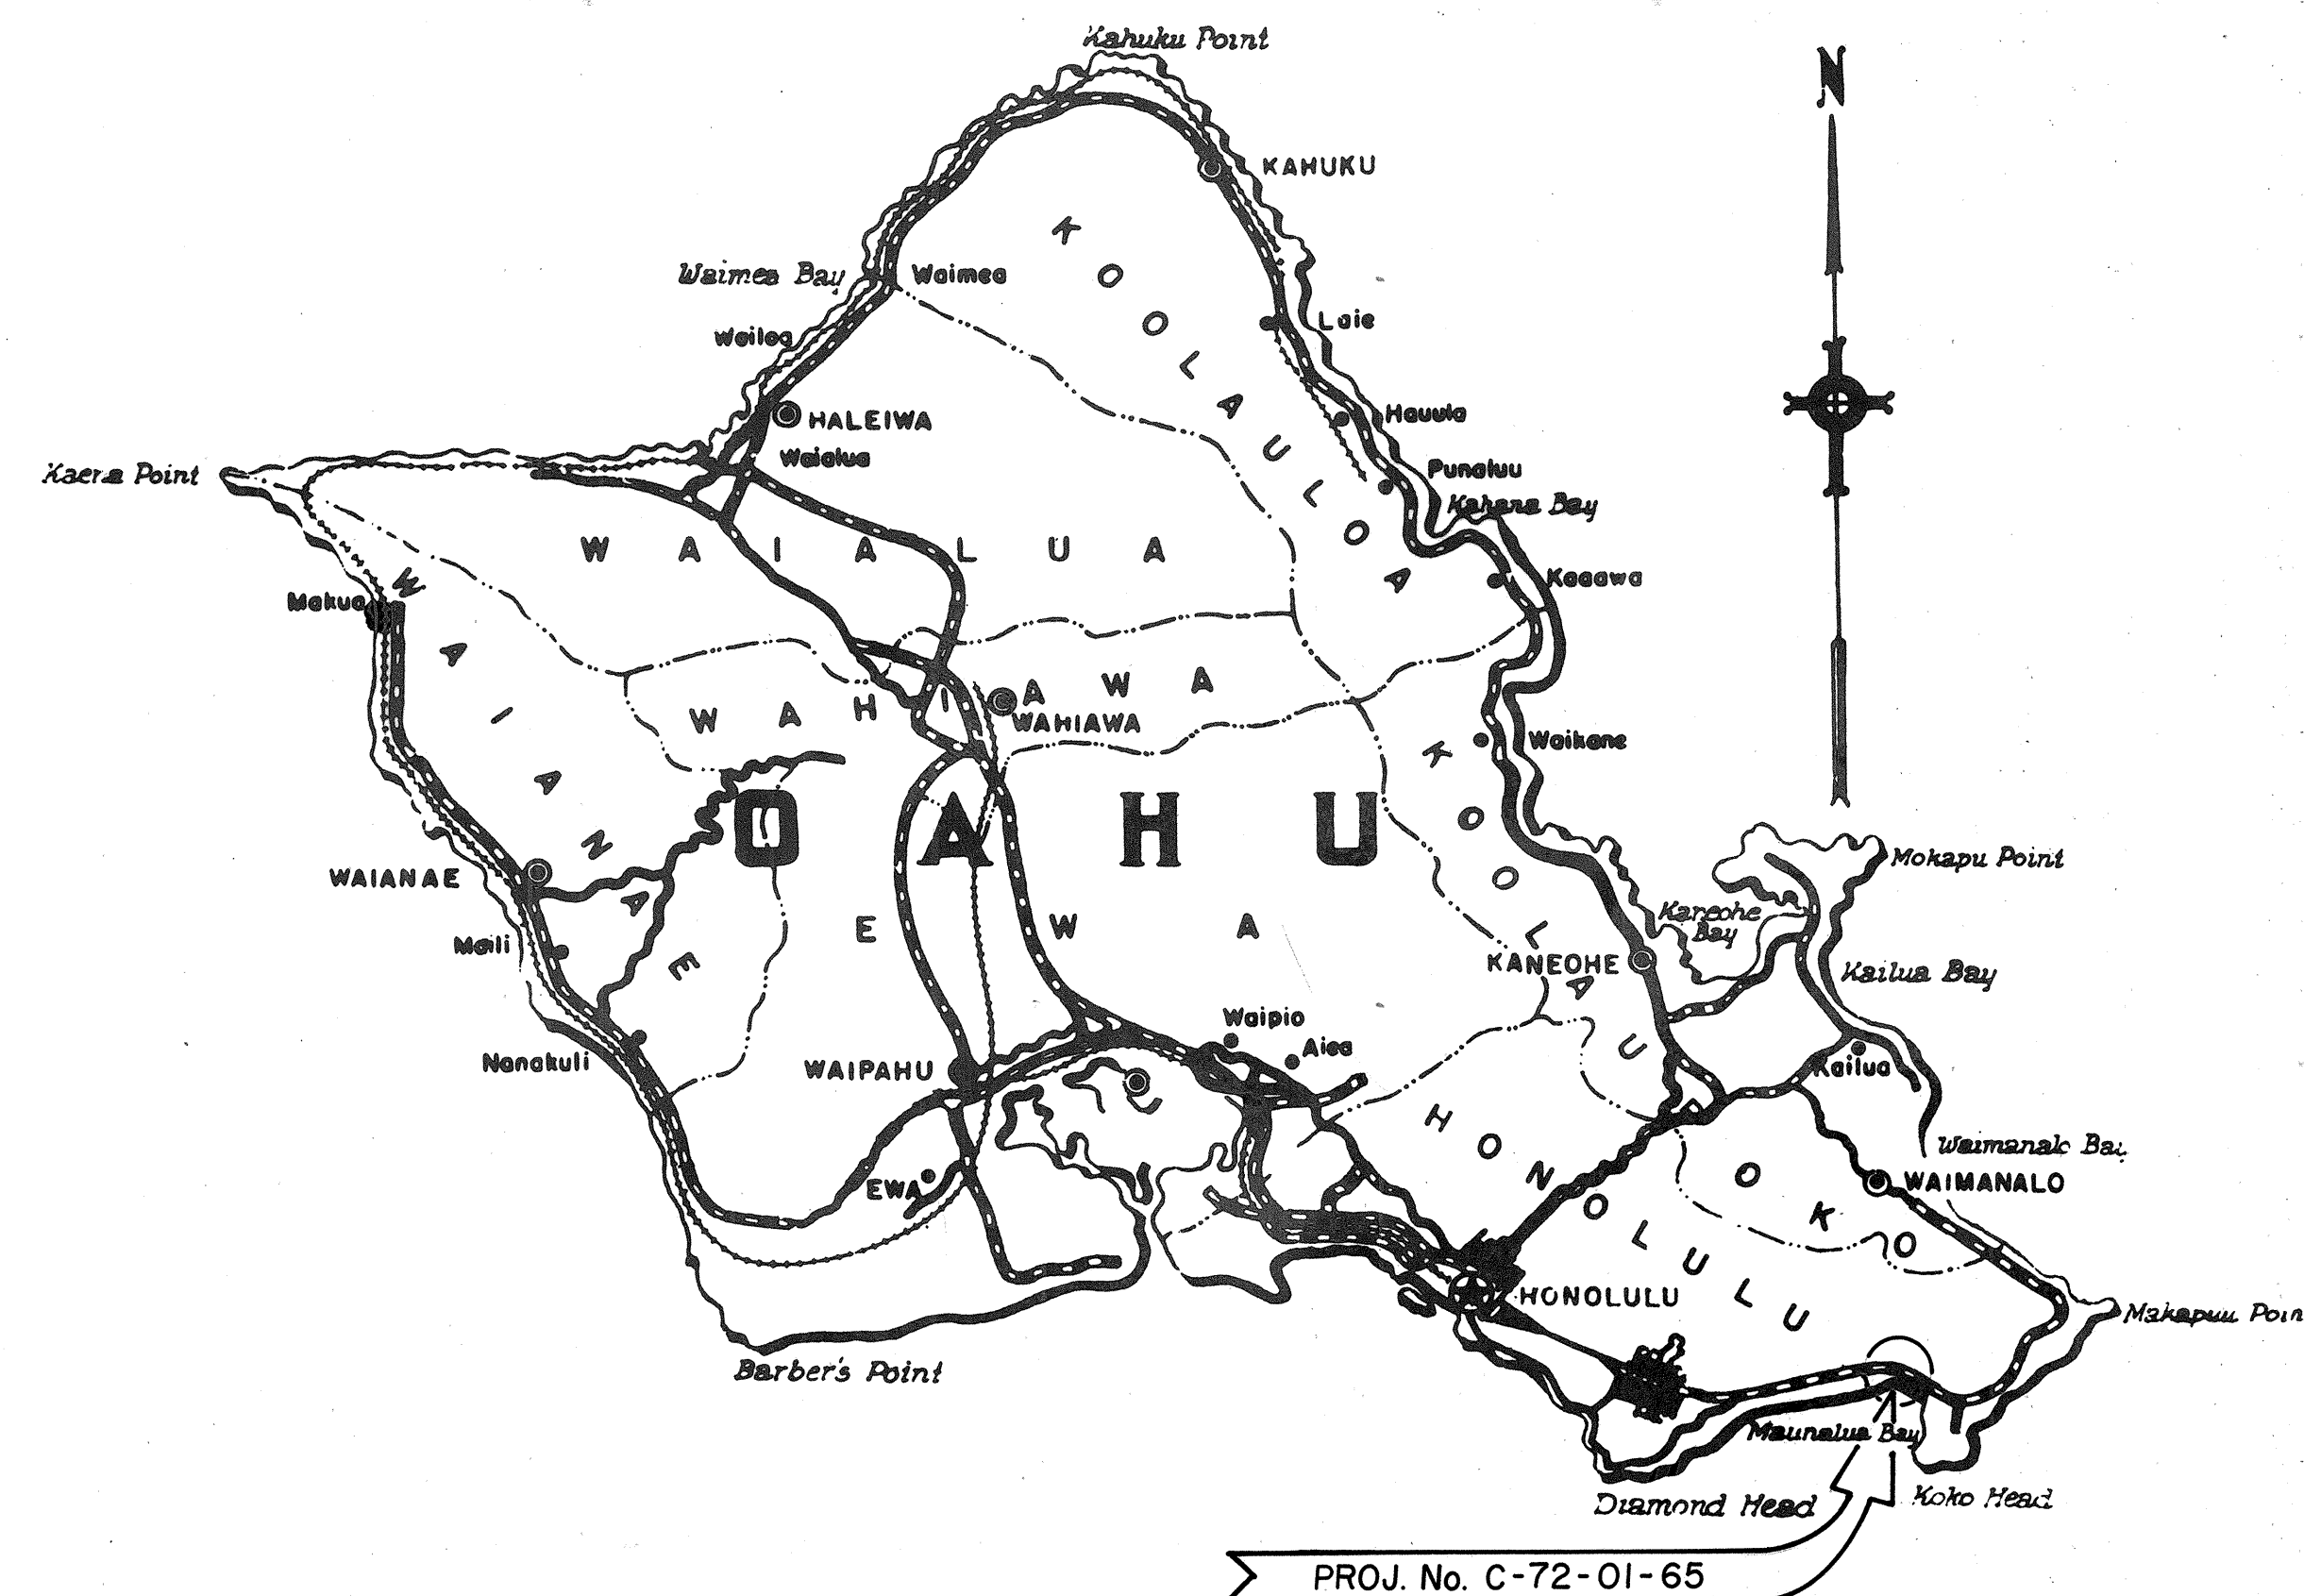


Federal Aid Projects Previously Constructed Or Under Construction

NOTE:
ALL CHANGES MADE DURING CONSTRUCTION
HAVE BEEN NOTED ON THESE TRACINGS IN
RED AND CHECKED BY:


PROJECT ENGINEER

27 Feb 67
DATE

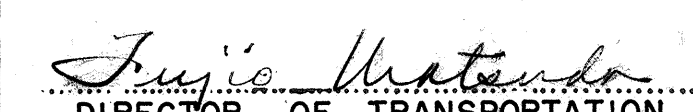APPROVED:

DIRECTOR OF TRANSPORTATION

DATE 12 Nov 64

DATE	
SURVEY PLOTTED BY	
DESIGNED BY	
DRAWN BY	
CHECKED BY	
NOTE BOOK	
No.	