

INDEX TO DRAWINGS	
SHT. NO.	DESCRIPTION
I	TITLE SHEET

FED. ROAD DIST. NO.	STATE	PROJ. NO.	FISCAL YEAR	SHEET NO.	TOTAL SHEETS
HAWAII	HAW	C-72-01-66	1965	1	1

STATE OF HAWAII

DEPARTMENT OF TRANSPORTATION

HIGHWAYS DIVISION

HONOLULU, HAWAII

"AS BUILT"


RESURFACING OF A PORTION OF KALANIANA'OLE HIGHWAY

(AINAKOA AVENUE TO KIRKWOOD PLACE)

PROJECT NO. C-72-01-66

DISTRICT OF HONOLULU

ISLAND OF OAHU

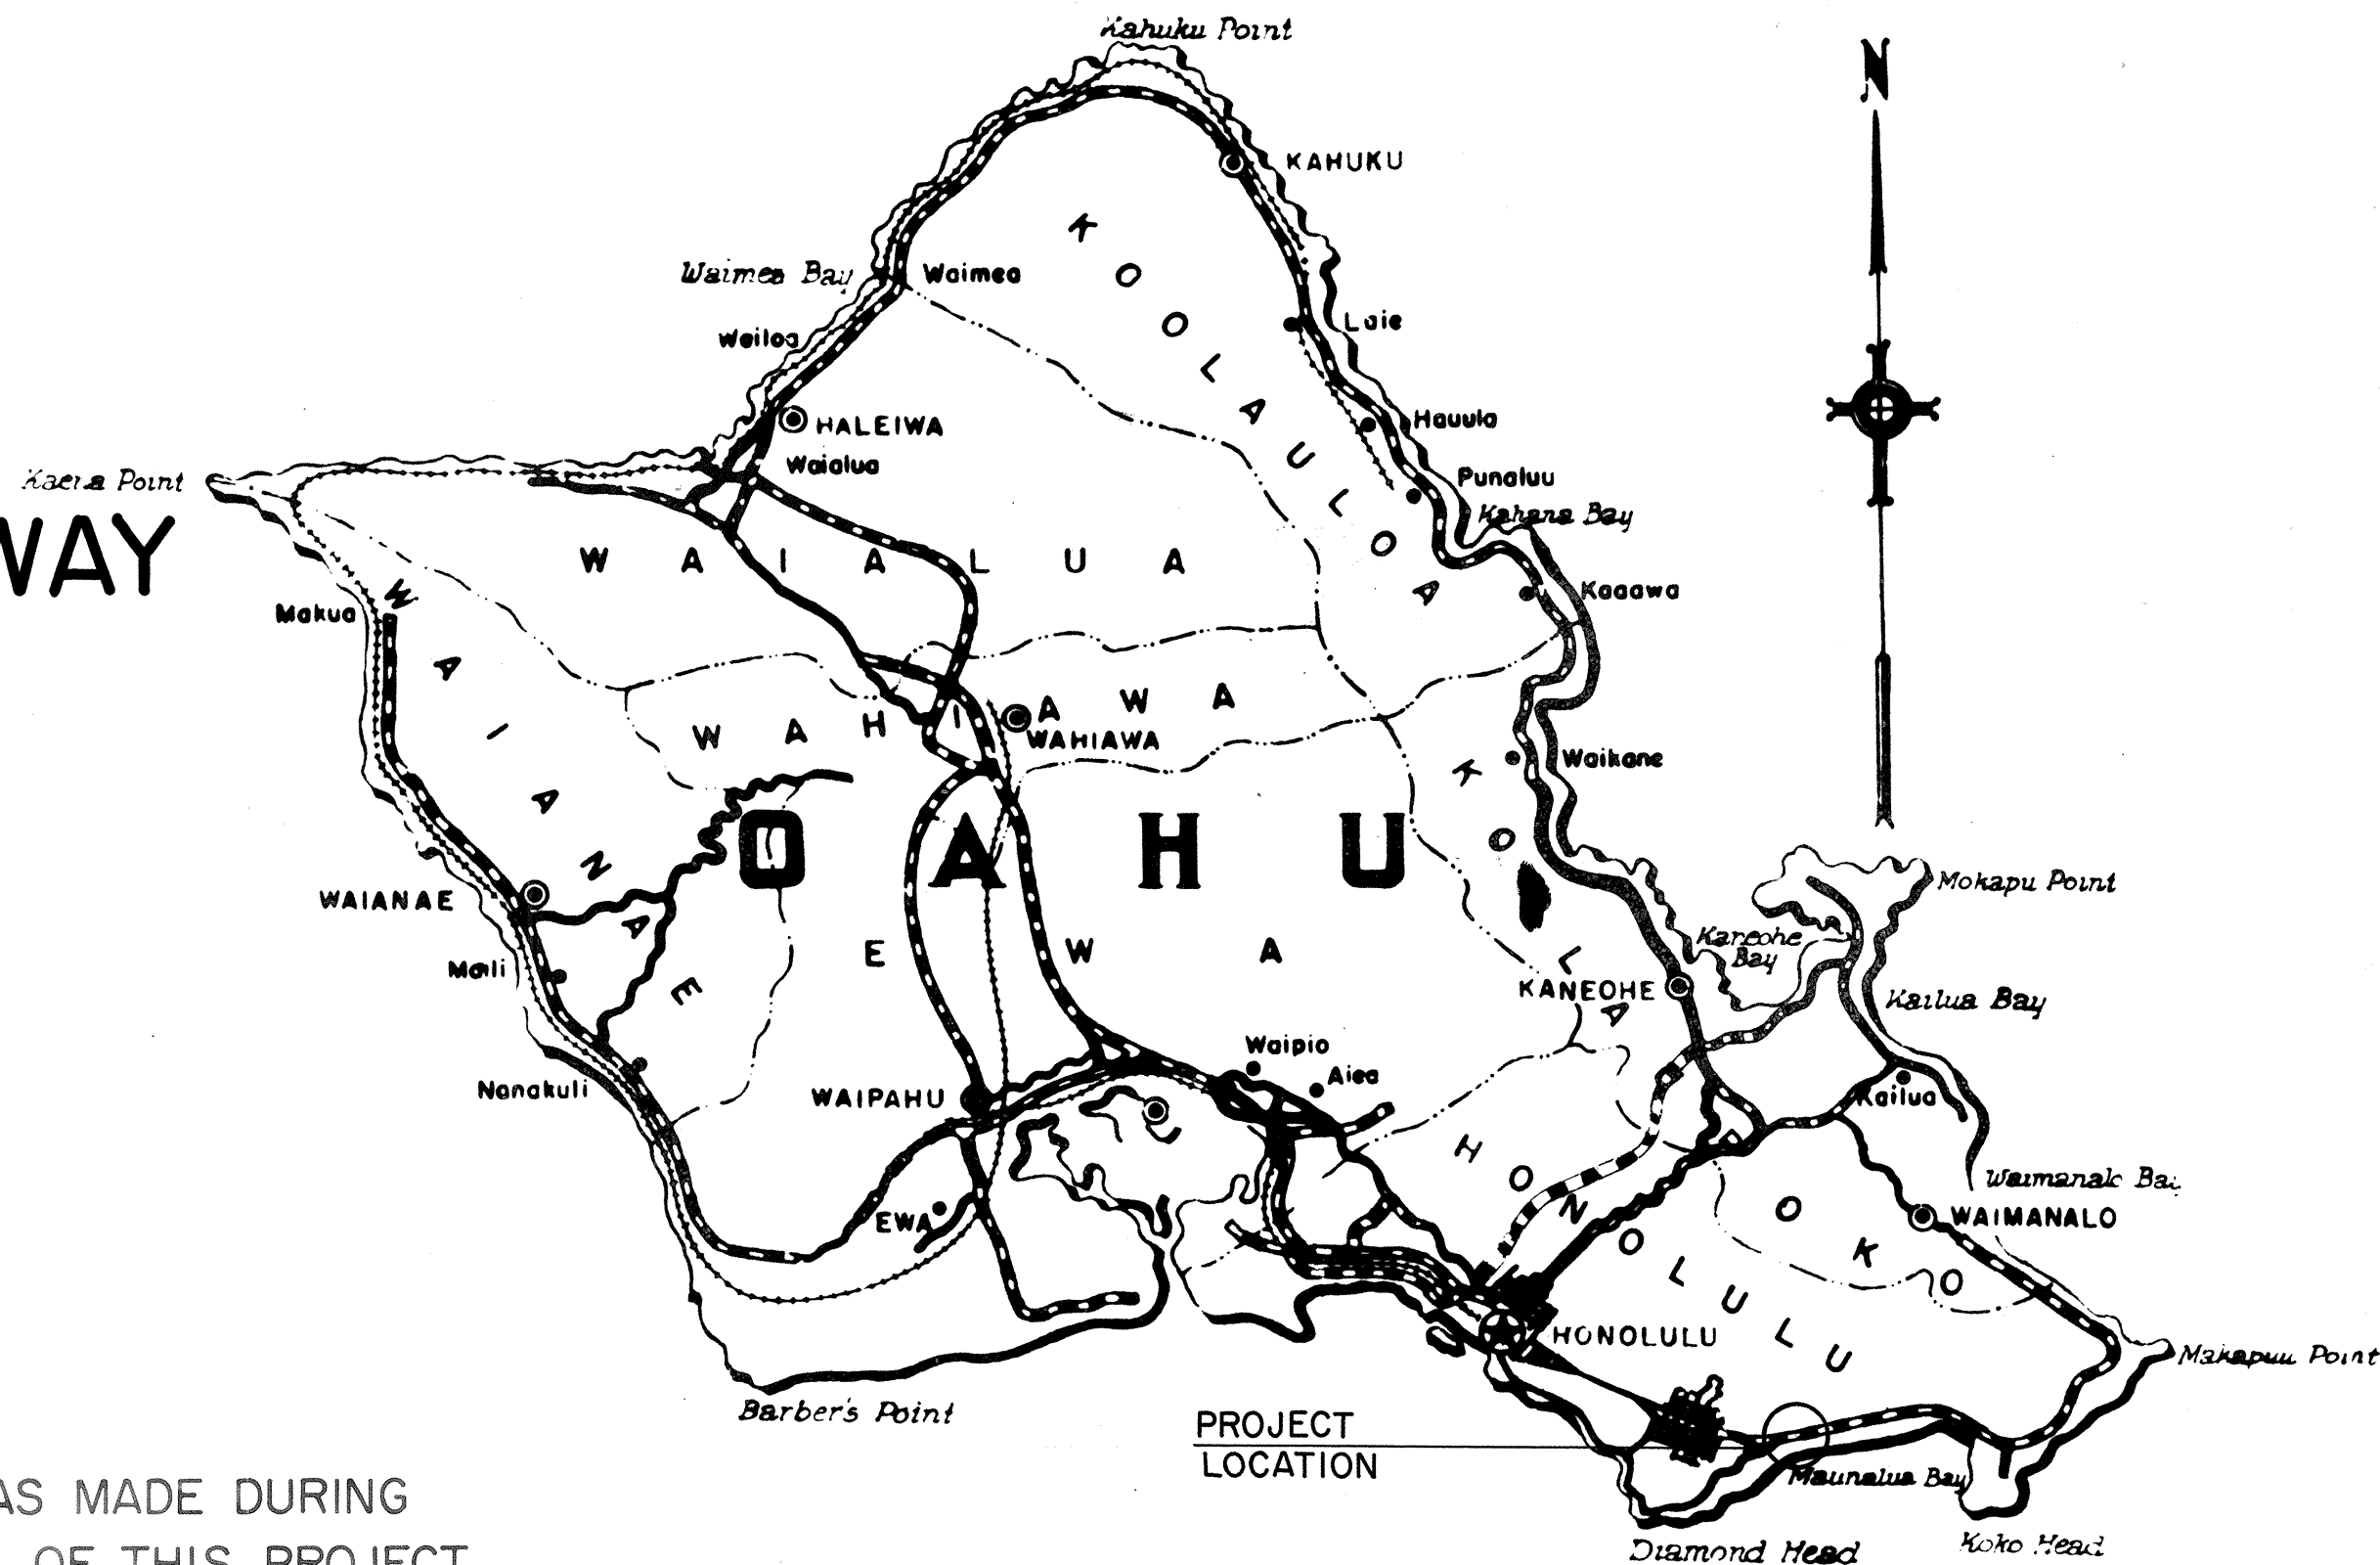

NO CHANGE WAS MADE DURING
CONSTRUCTION OF THIS PROJECT.

R. T. Samuels


11-10-81

for

RESIDENT ENGINEER

DATE

Federal Aid Projects Previously Constructed Or Under Construction

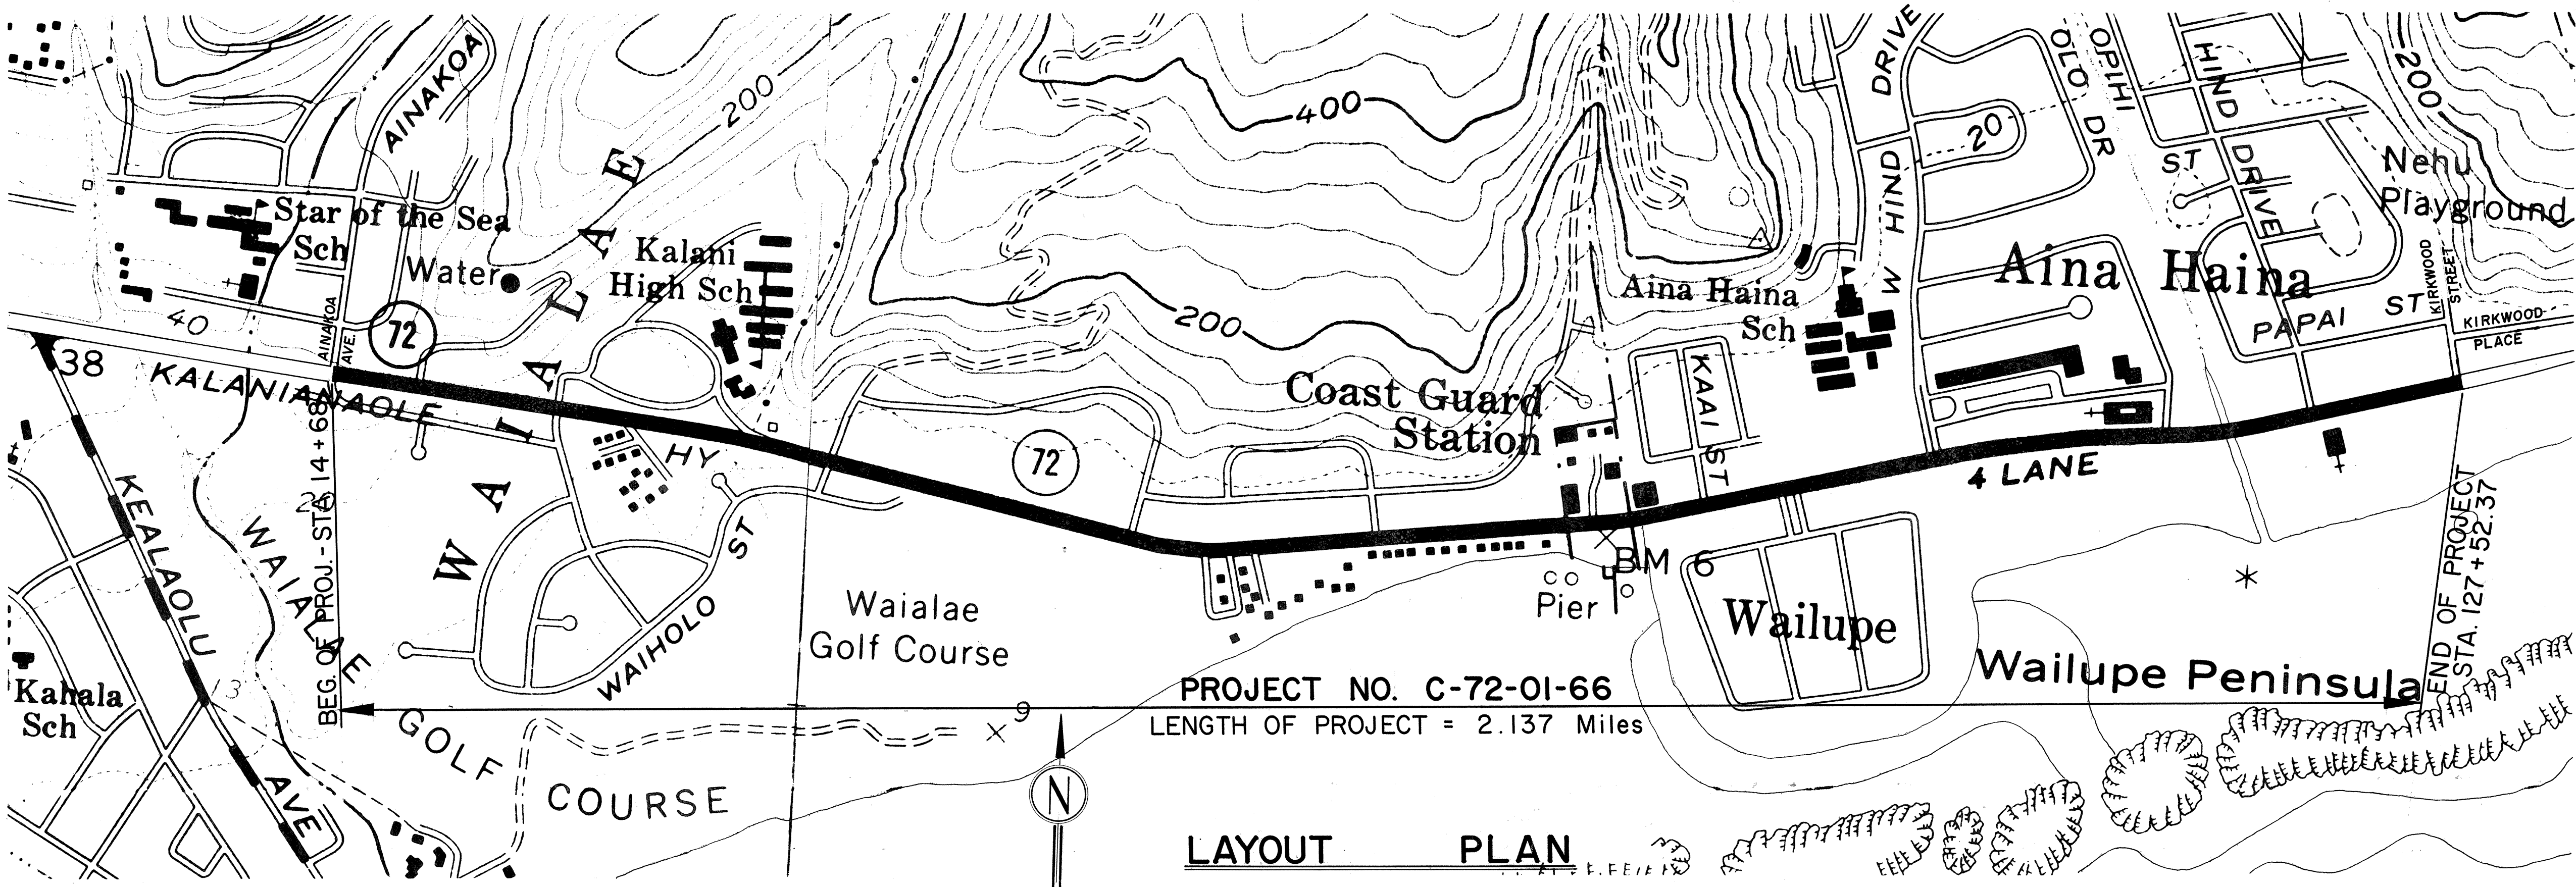

- GENERAL NOTES:**
- Resurfaced Pavement thickness are as follows:

INBOUND LANES	WIDTH	THICKNESS
Sta. 14+68 to Sta. 127+52.37	24'	1"
OUTBOUND LANES	24'	1"
 - Existing Pavement shall be broomed off and tack coated before laying Asphalt Concrete.
 - Pot holes, cracks and crevices in the existing pavement shall be cleaned and paved with A.C. Mix No. 2 as ordered by the Engineer. No compensation will be made to the Contractor for this work other than the actual quantity of the material incorporated into the work and for which an item is listed in the proposal.
 - All existing Centerline Monuments shall be exposed after resurfacing. Payments to be incidental to Asphalt Concrete Pavement.
 - After paving, the Contractor shall locate all the existing manholes in a manner satisfactory to the Engineer. Payments to be incidental to Asphalt Concrete Pavement. However, the utility companies may adjust their manhole frames and covers in the pavement area. The contractor shall contact all applicable utility companies prior to beginning paving operations.
 - Smooth riding connections shall be provided at the beginning and end of the project.
 - The edge of pavement shall be feathered to conform with the existing pavement.
 - Resurfacing during peak traffic hours, 6:30 a.m. to 8:00 a.m. and 4:30 p.m. to 6:00 p.m. (Monday through Friday) will not be permitted and all four-lanes of Kalaniana'ole Highway shall be kept open to traffic. At all other times, resurfacing shall be limited to one lane each in the inbound and outbound lanes.

DATE	
SURVEY PLOTTED BY	
DESIGNED BY	
TRACED BY	
QUANTITIES BY	
CHECKED BY	

APPROVED:

DATE

Kaipo K. Kanao

DIRECTOR OF TRANSPORTATION