

INDEX TO DRAWINGS	
SHEET NO.	DESCRIPTION
1	TITLE SHEET
2-4	TYPICAL ROAD SECTIONS
5-11	PLAN & PROFILE
12	CONNECTION AT STA. 45 + 22.06
13-16	MISC. & STANDARD RDWY. DETAILS
17-26	DRAINAGE DETAILS
27-30	WATER SYSTEM
31-39	TRAFFIC & DETOUR SIGNS
40-58	CROSS SECTIONS

STATE OF HAWAII

DEPARTMENT OF TRANSPORTATION

HIGHWAYS DIVISION

HONOLULU, HAWAII

"AS BUILT"

PLANS OF

KALANIANA'OLE HIGHWAY

KAILUA JUNCTION TOWARDS WAIMANALO

(C & C CORPORATION YARD TO SADDLE CITY)

FEDERAL AID PROJECT NO. F-072-I(15)

DISTRICT OF KOOLAUPOKO

ISLAND OF OAHU

NOTE:  
ALL CHANGES MADE DURING  
CONSTRUCTION HAVE BEEN  
NOTED ON THESE TRACINGS  
IN RED AND CHECKED BY:




*George E. Kawai*  
PROJECT ENGINEER  
7/17/68  
DATE

SCALES:  
PLAN & PROFILE.....HOR.....1"= 50'  
VER.....1"= 10'  
  
CROSS SECTION.....1"= 20'

LAYOUT PLAN

NET LENGTH OF ROADWAY..... 1.648 Mi.  
BRIDGES OVER 20'-0" SPAN..... 0.000 Mi.

GROSS LENGTH OF PROJECT..... 1.648 Mi.

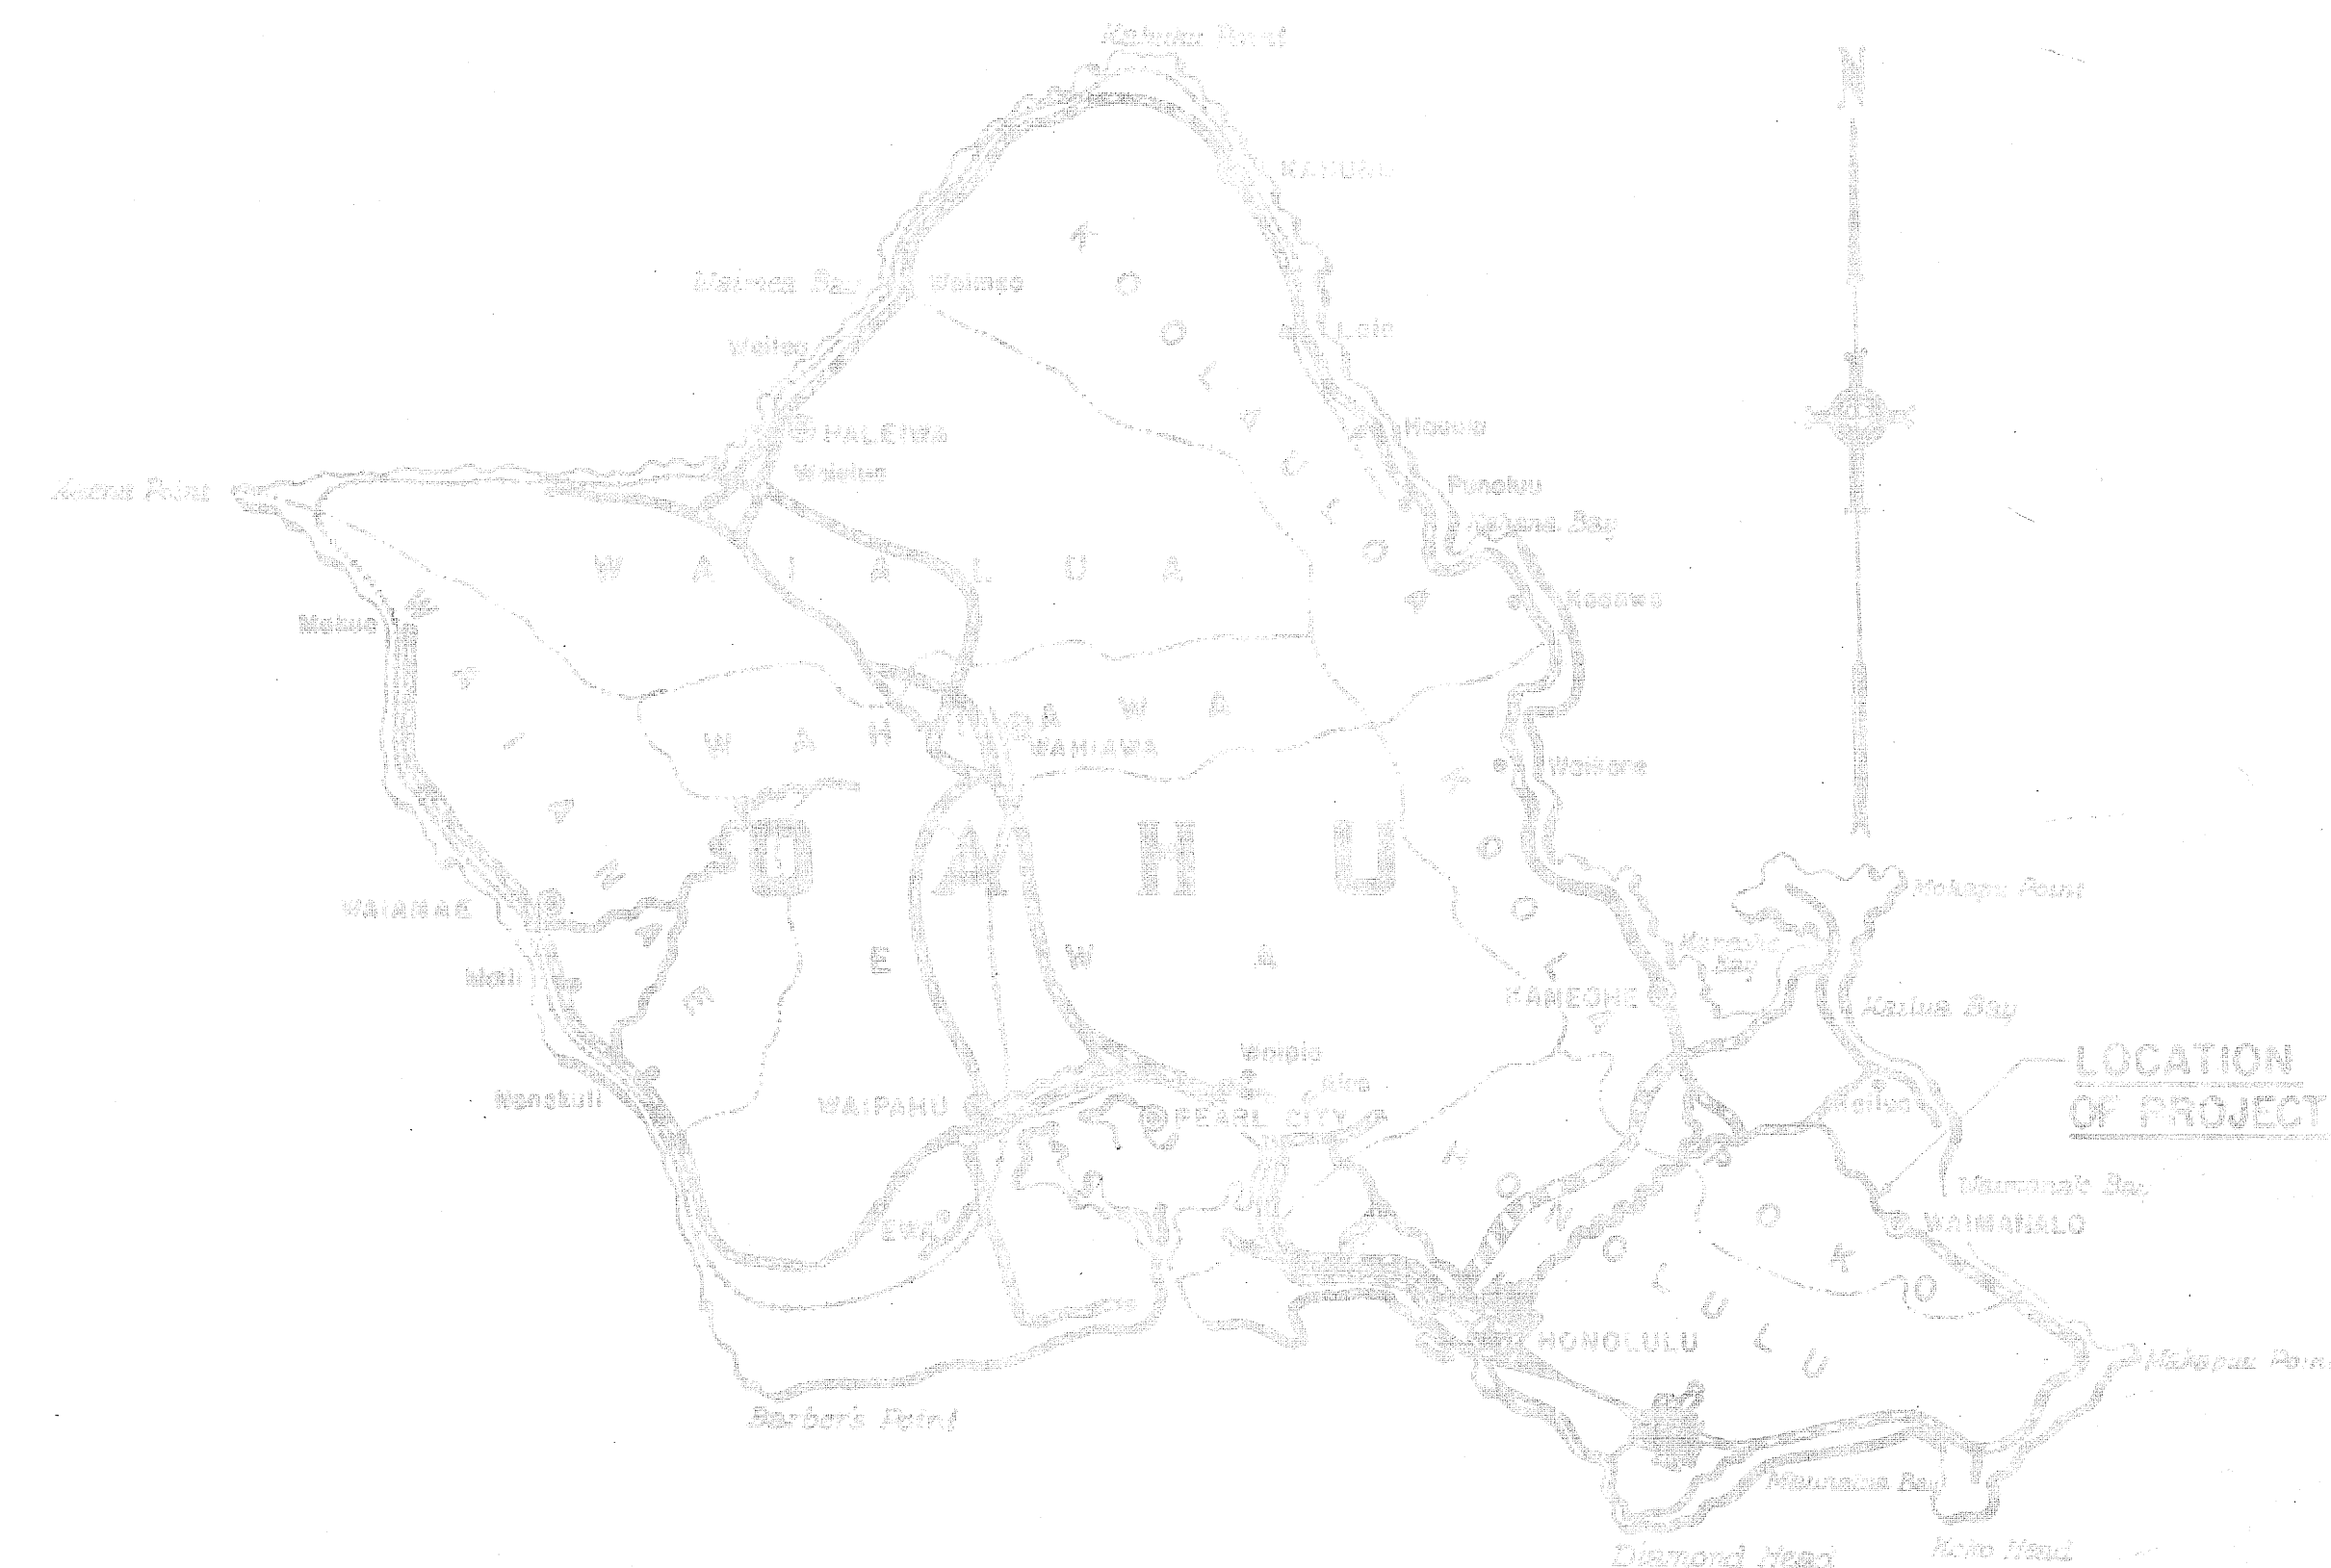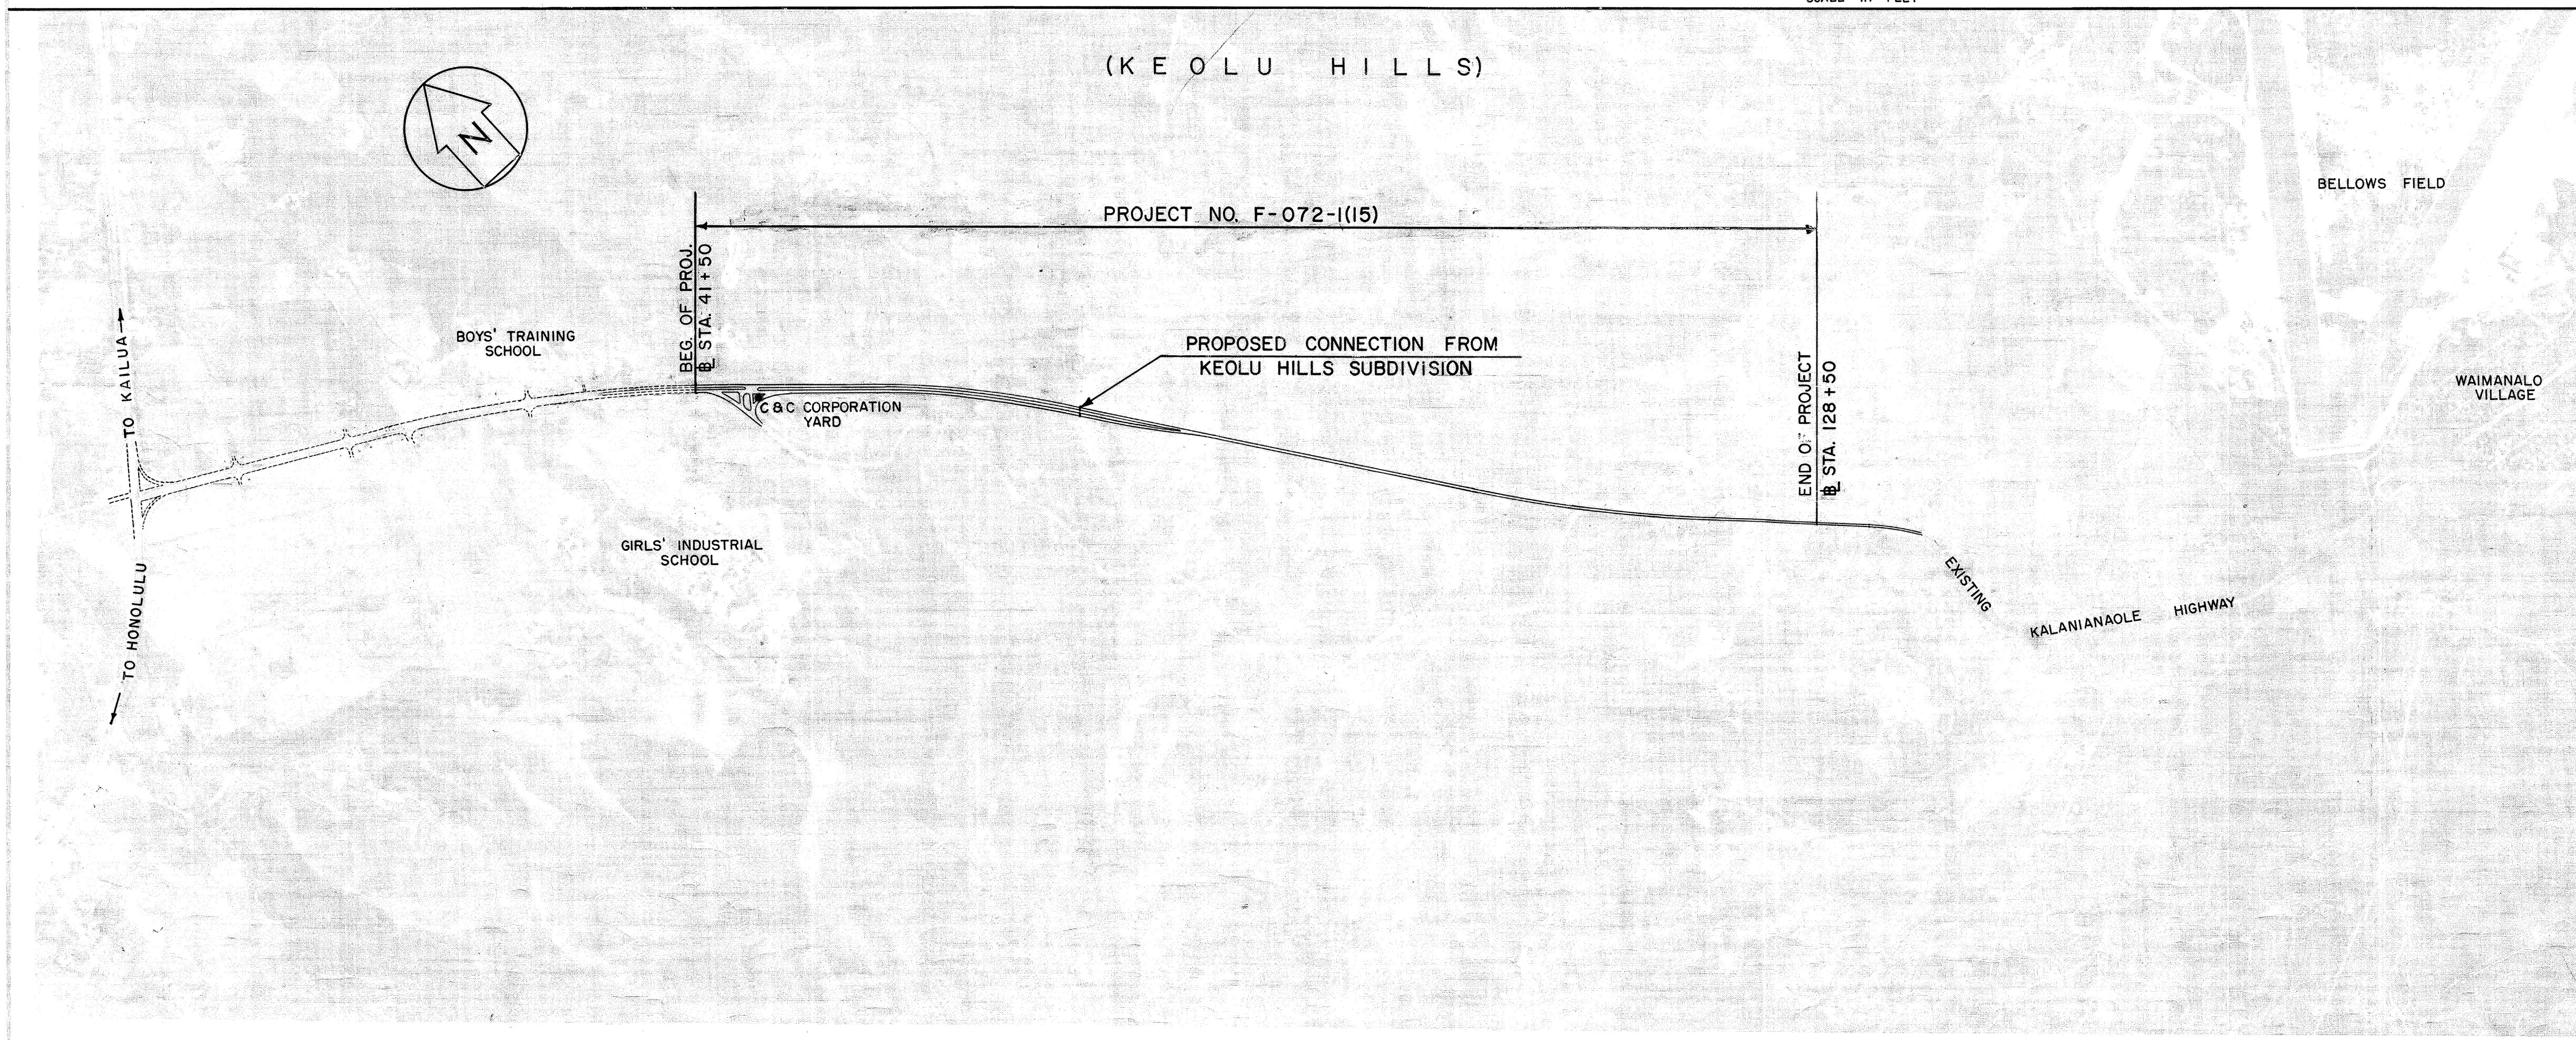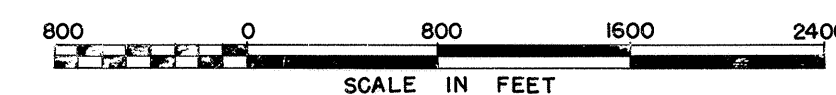

Federal Aid Projects Previously Constructed Or Under Construction

DESIGN CLASSIFICATION

ADT (1965) ..... 6,200  
DESIGN ADT (1985) ..... 39,200  
DHV ..... 11 %  
D ..... 75/25  
T ..... 3 %  
V ..... 60 MPH.

APPROVED..... DATE 4-4-66  
*John M. Sullivan*  
DIRECTOR OF TRANSPORTATION

DEPARTMENT OF COMMERCE  
BUREAU OF PUBLIC ROADS  
APPROVED  
*John M. Sullivan* 5-23-66  
DIVISION ENGINEER DATE

DESIGNED BY	DATE
TRACED IN	Apr. 1966
NOTED BY	Apr. 1966
CHECKED BY	