



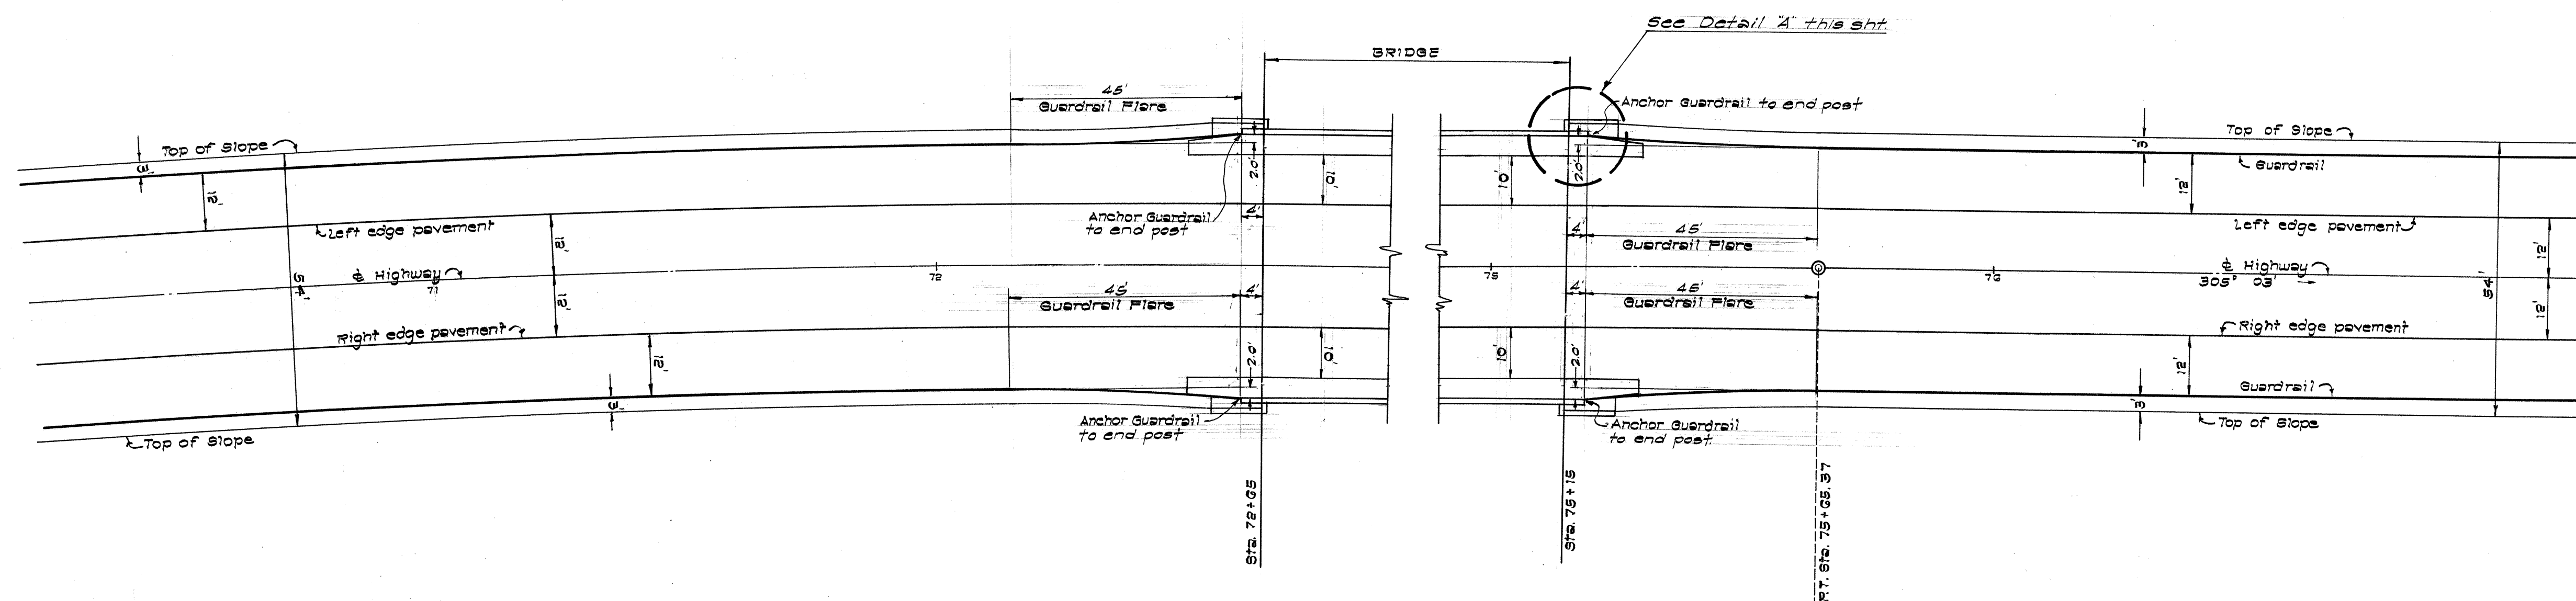


GUARDRAIL FLARE DETAILS @ BRIDGE

Scale: 1" = 20'

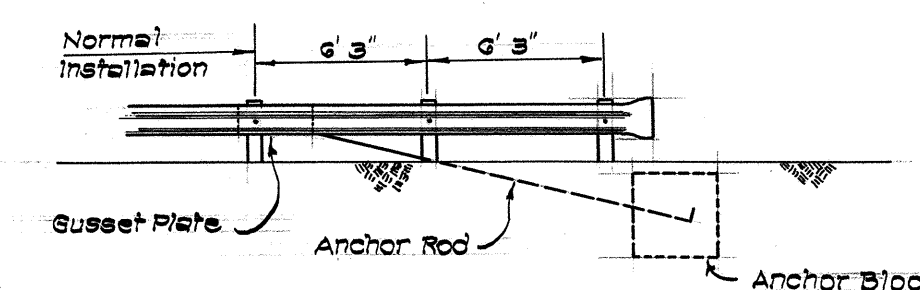


**ELEVATION
GUARDRAIL ANCHOR DETAIL**

Not to Scale

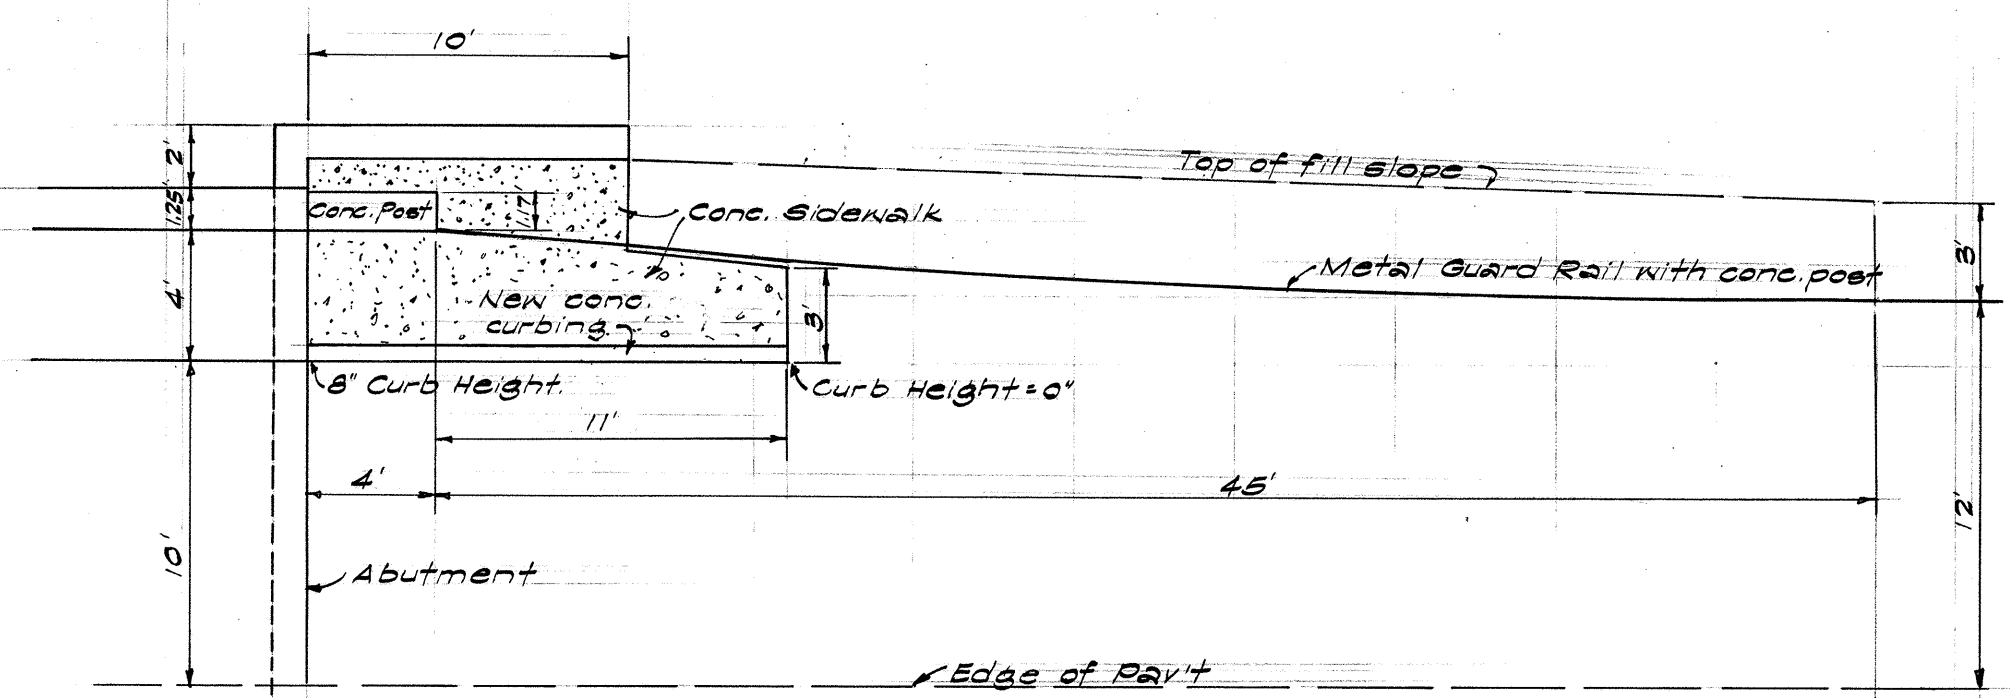


DETAIL A

Scale: 1" = 10'

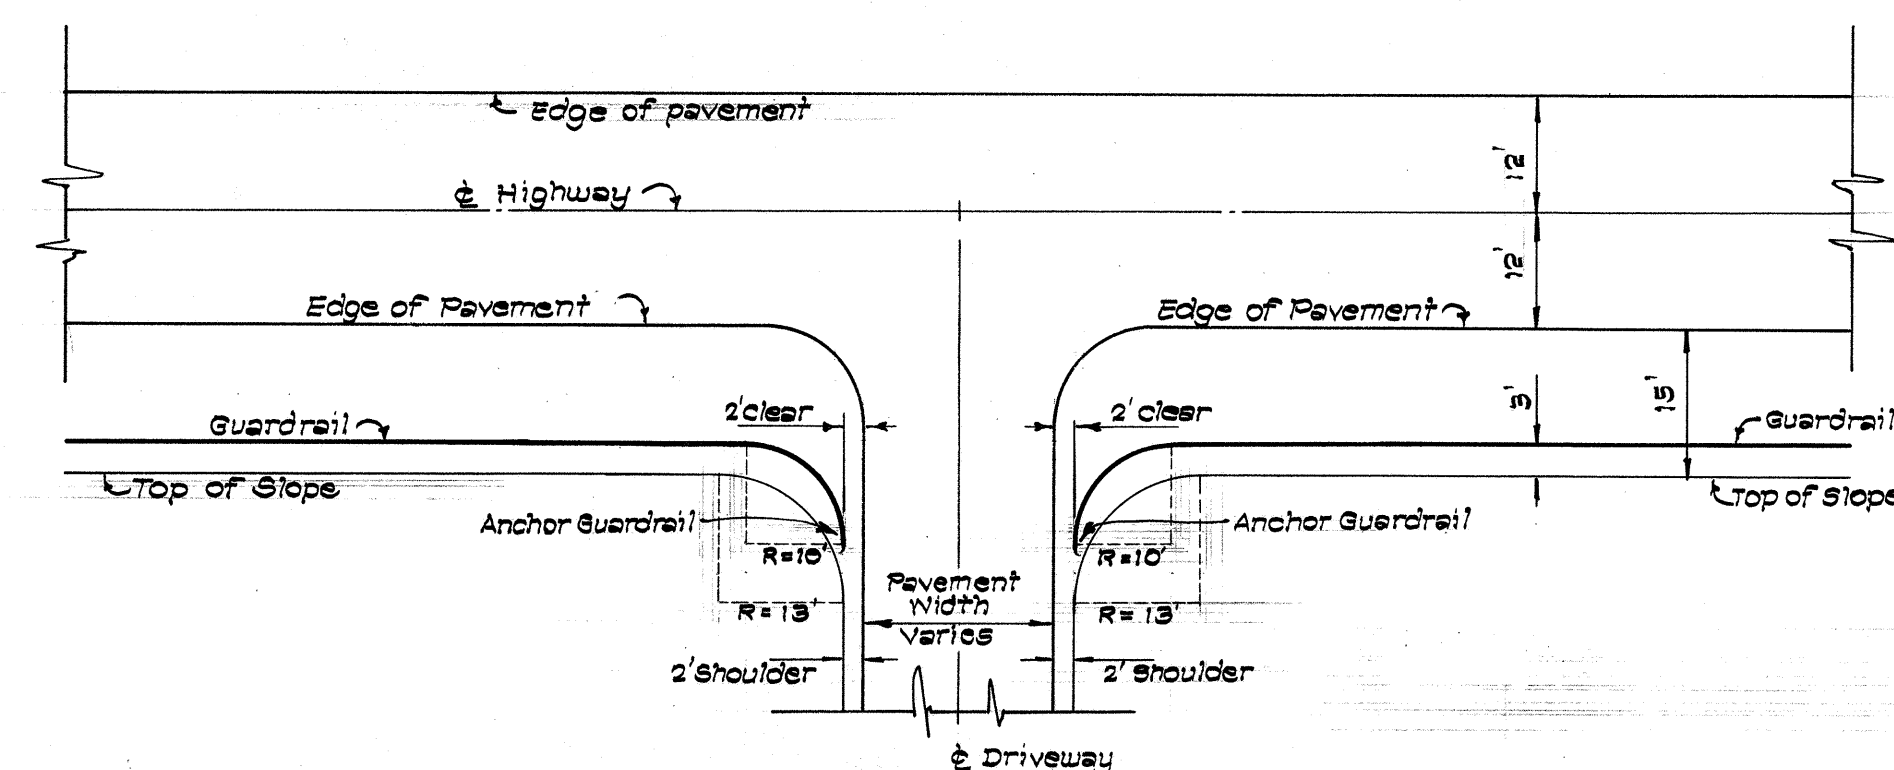


TYPICAL GUARDRAIL CURVES @ DRIVEWAYS

Scale: 1" = 20'

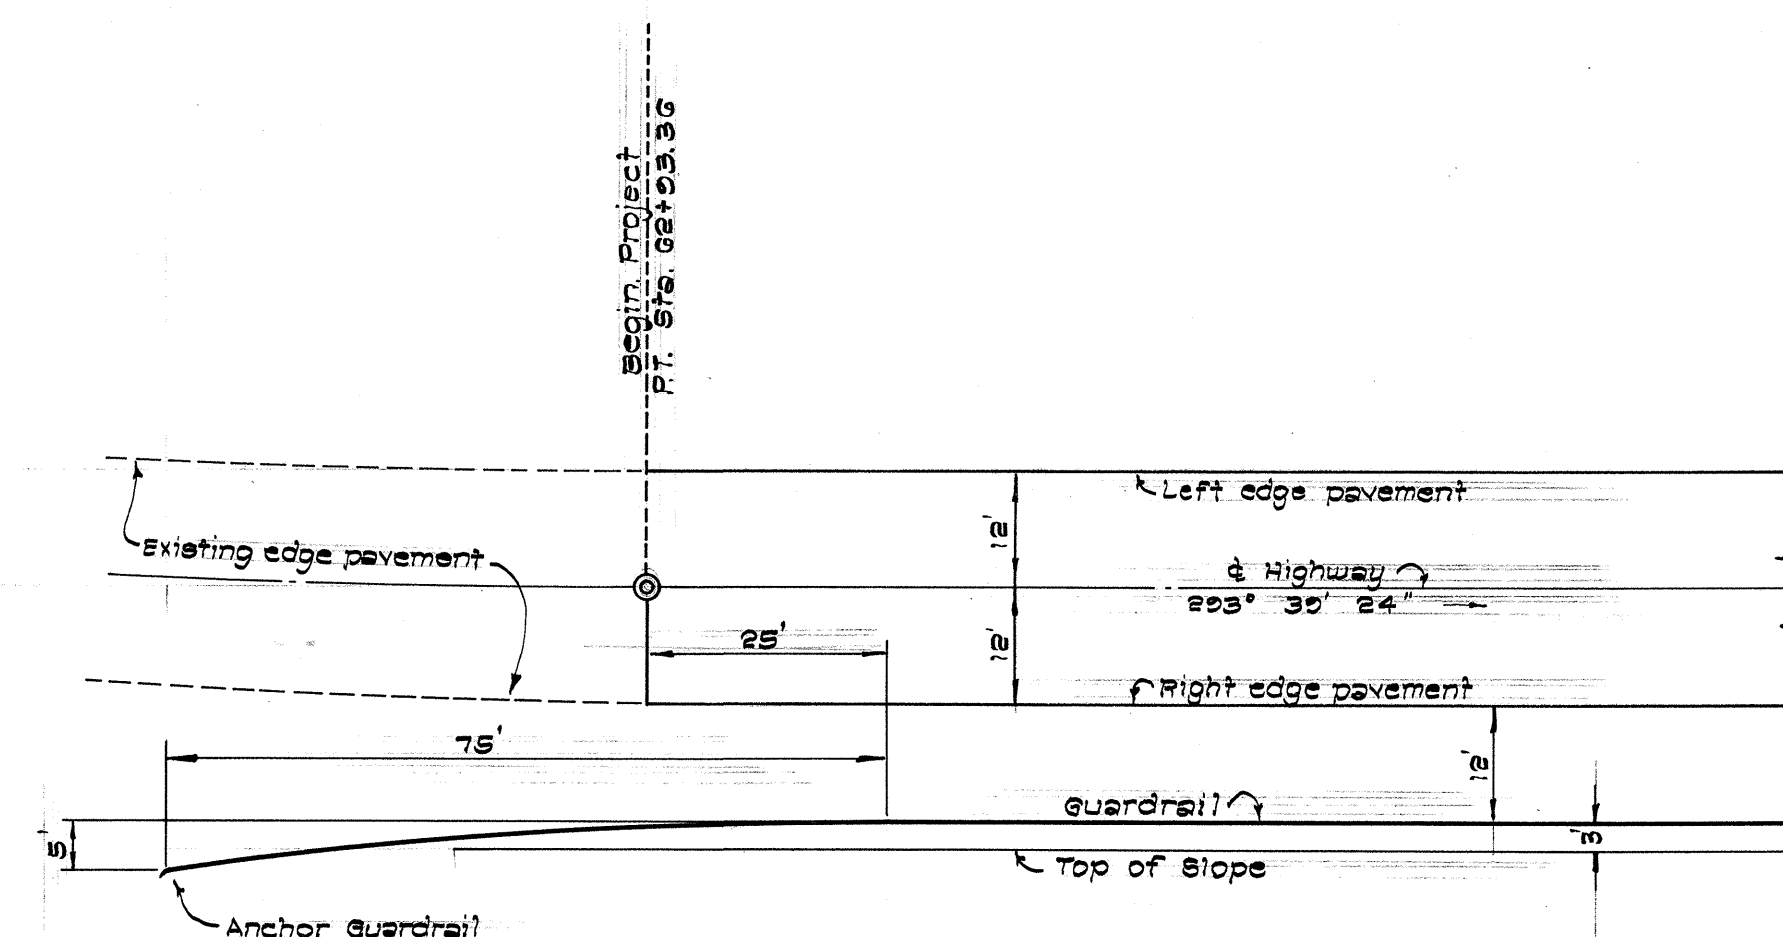

GUARDRAIL FLARE @ BEGIN PROJECT

Scale: 1" = 20'

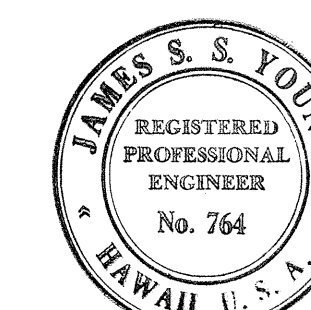

THIS WORK WAS PREPARED BY ME
OR UNDER MY SUPERVISION

J. Young 8/31/67

REVISION	DATE	BRIEF	BY	APPR'D
STATE OF HAWAII DEPARTMENT OF TRANSPORTATION HIGHWAYS DIVISION PROJECT NO. 72C-02-68 HAWAII-KAI MARINA BRIDGE & CHANNEL MAUNALUA, OAHU, HAWAII. GUARDRAIL FLARE DETAILS				
DRAWN BY: J. Horio		ENGINEER: J. Young		
APPROVED BY:				
DIRECTOR, DIV. OF ENGINEERING	DATE	DEPUTY TRAFFIC ENGINEER DEPT. OF TRAFFIC	DATE	
FILE	POCKET	FOLDER	NO.	