
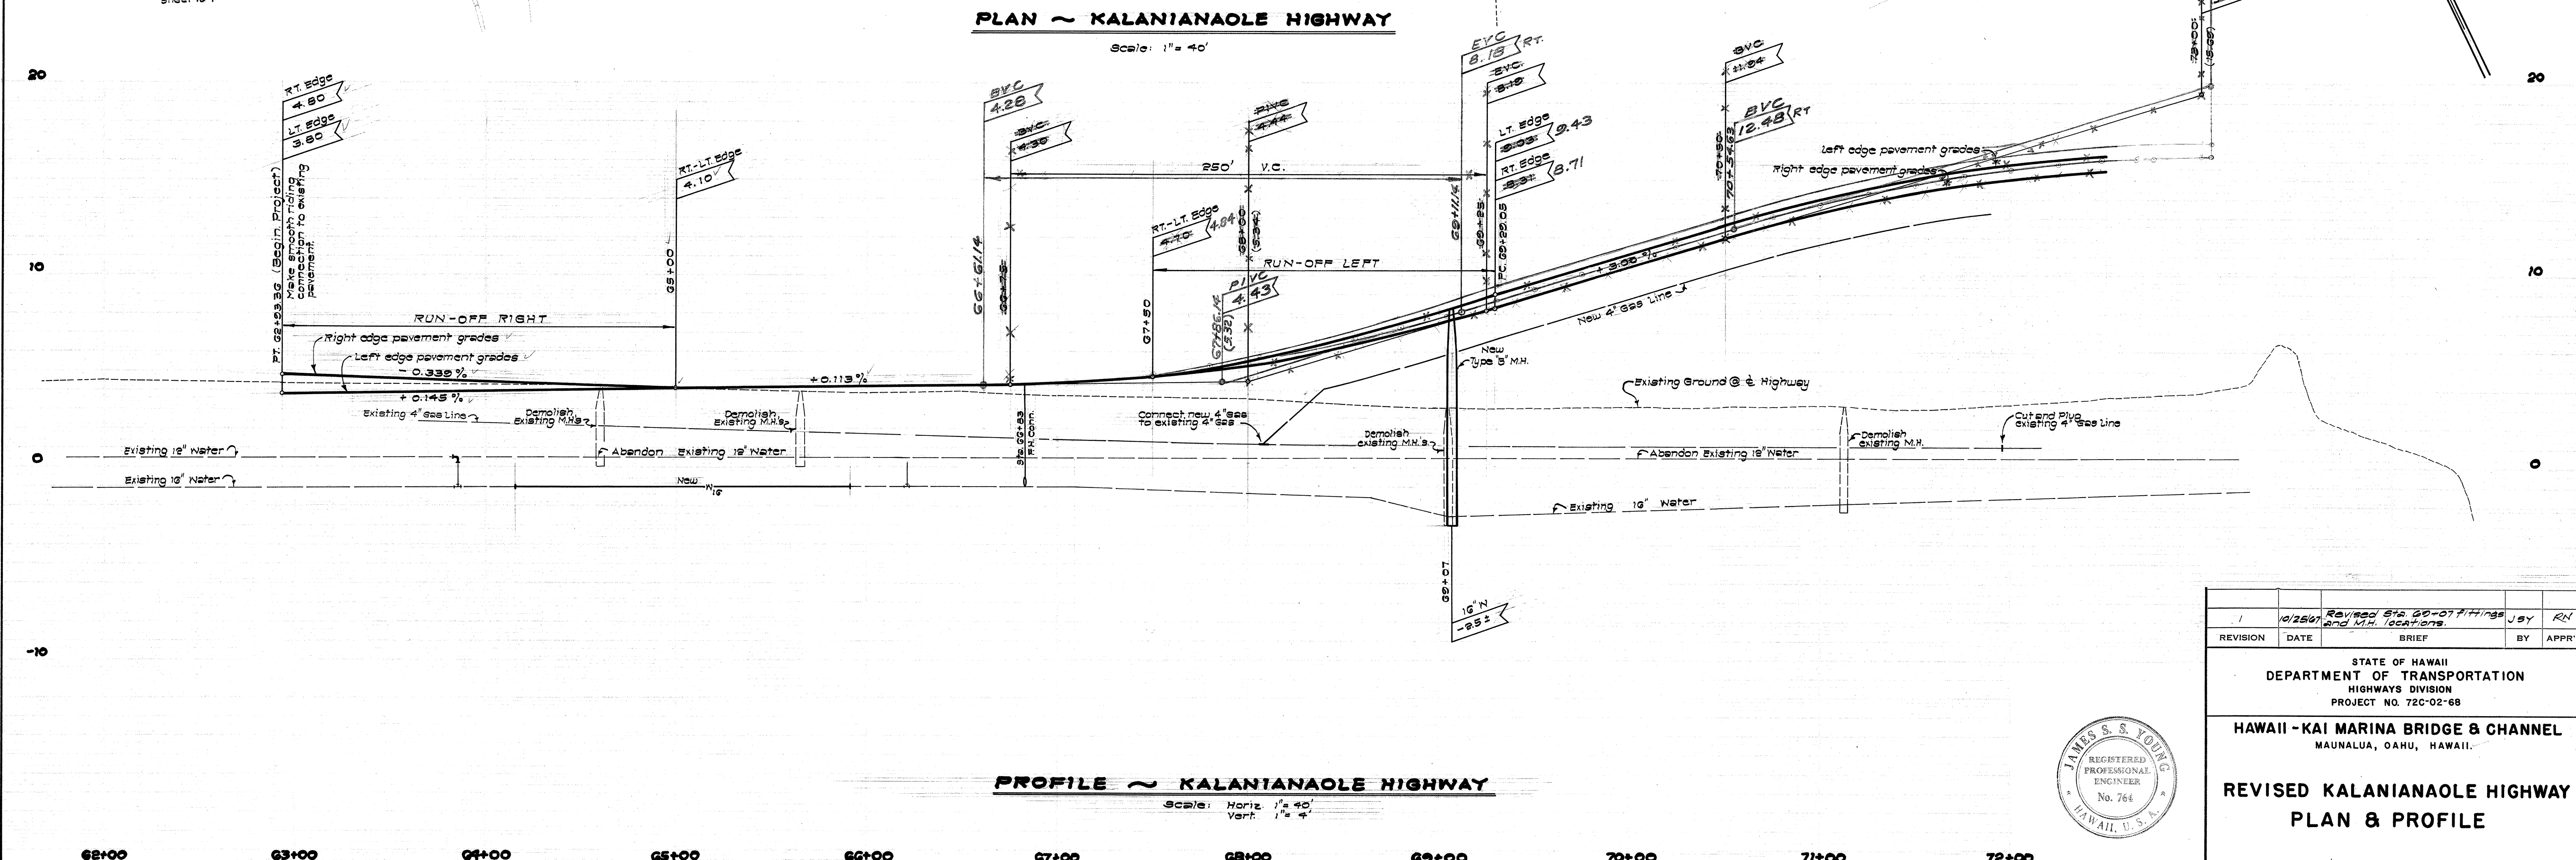


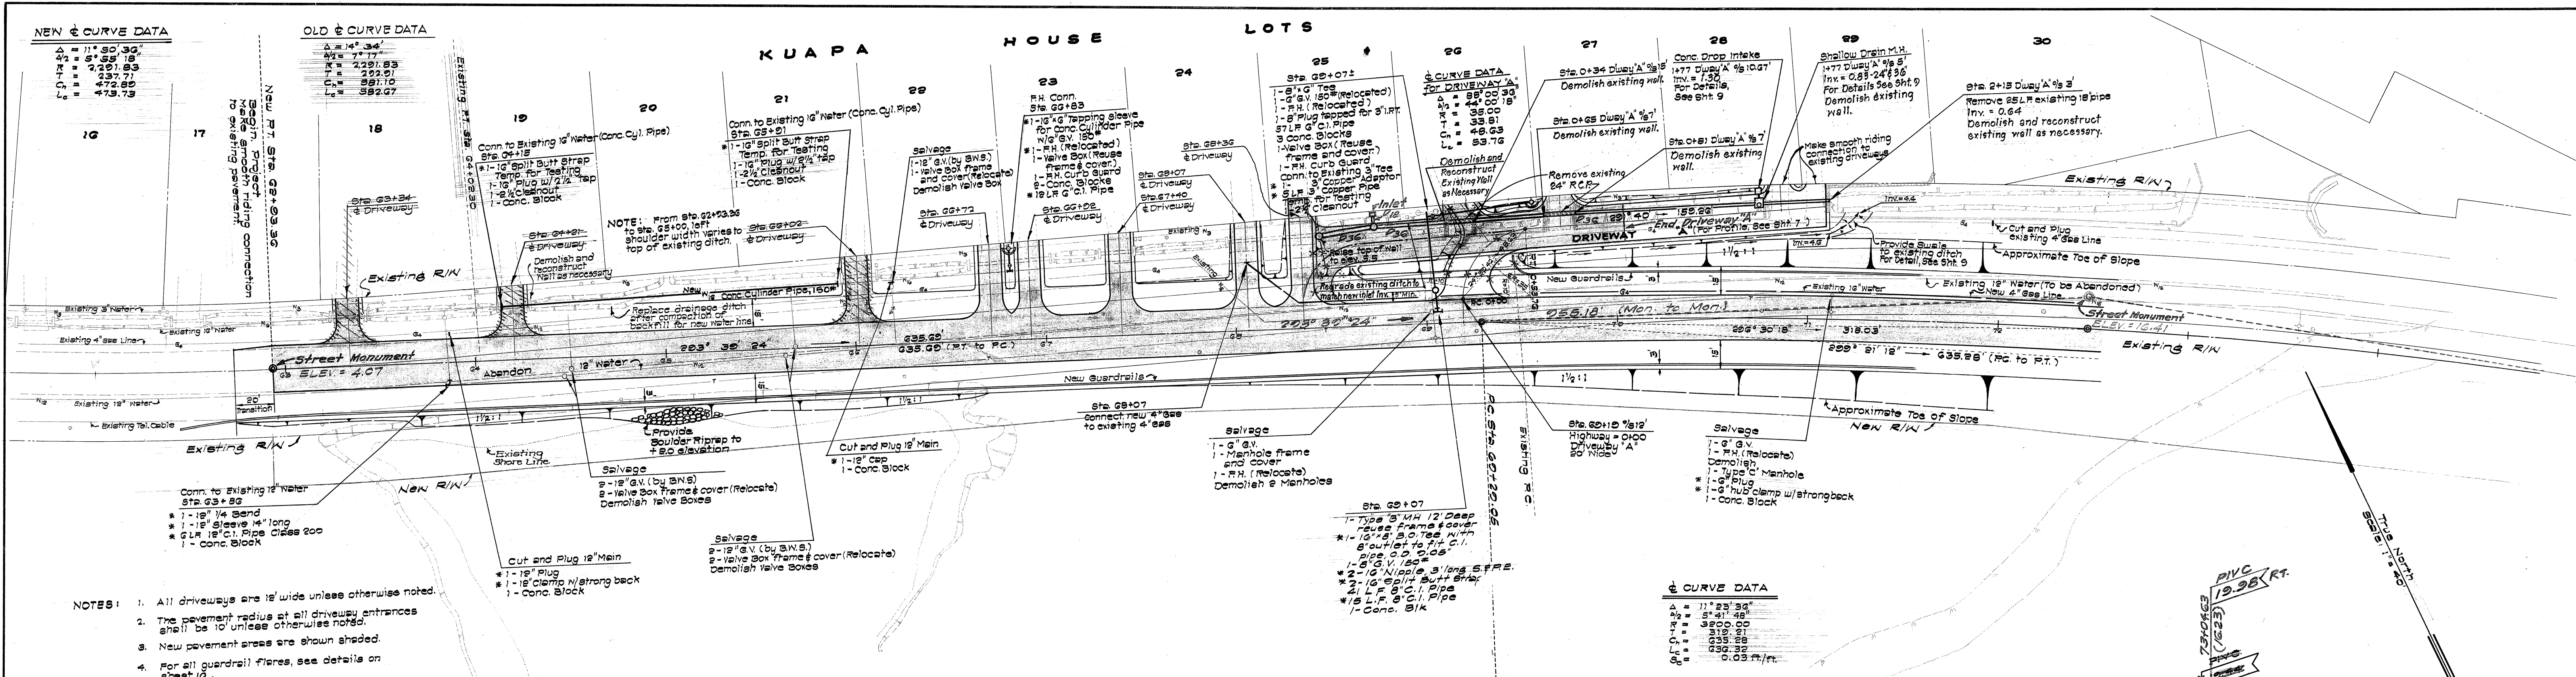

REVISION	DATE	BY	APPROVED
1	10/25/67	Rev. 10-27-67	J. Young

STATE OF HAWAII
DEPARTMENT OF TRANSPORTATION
PROJECT NO. 72C-02-68

HAWAII - KAI MARINA BRIDGE & CHANNEL
MAUNALUA, OAHU, HAWAII.

REVISED KALANIANA'OLE HIGHWAY
PLAN & PROFILE

DRAWN BY: J. Horio ENGINEER: J. Young

APPROVED BY: *[Signature]* 8/31/67

THIS WORK WAS PREPARED BY ME OR UNDER MY SUPERVISION

REVISOR: J. Young DATE: 8/31/67

FILE POCKET FOLDER NO.

REVISED IN ACCORDANCE WITH CONSTRUCTION RECORDS

SHEET 4 OF 31 SHEETS

"As-Built" profile corrected July 23, 1969

