



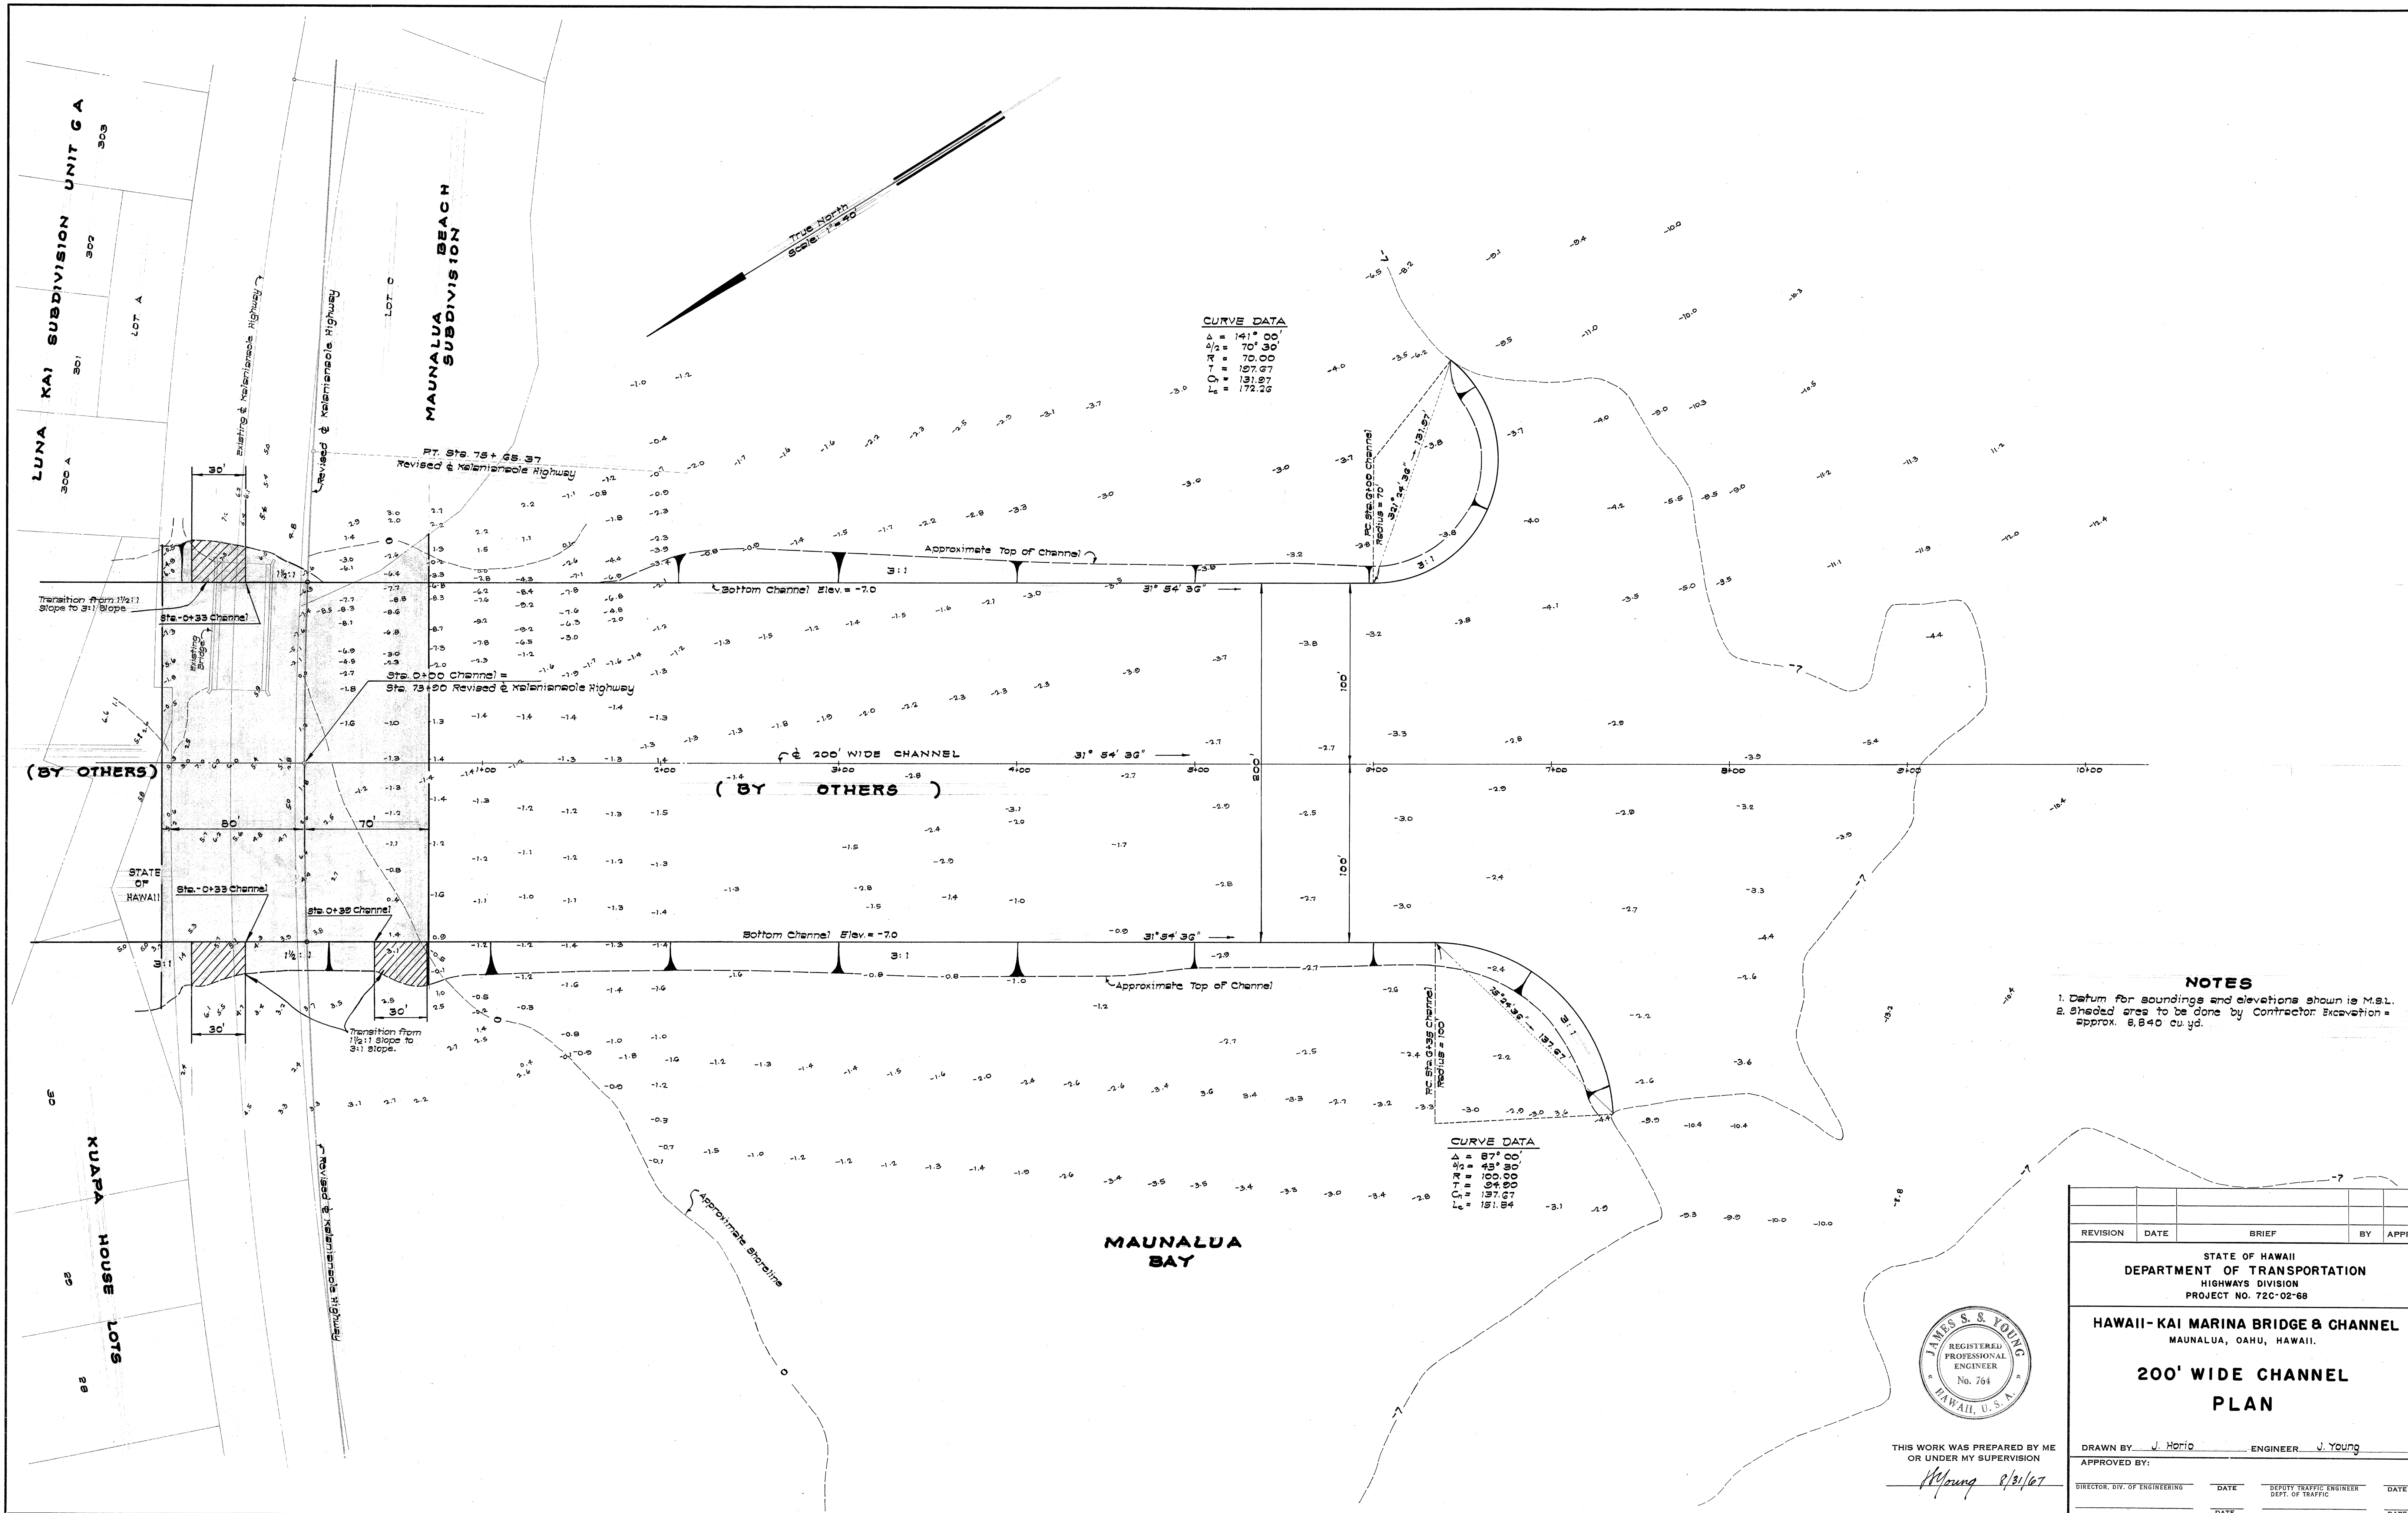

CURVE DATA
Δ = 141° 00'
Δ/2 = 70° 30'
R = 70.00
T = 127.87
C = 131.87
L = 172.26

CURVE DATA
Δ = 87° 00'
Δ/2 = 43° 30'
R = 100.00
T = 64.28
C = 137.87
L = 151.84

NOTES
1. Datum for soundings and elevations shown is M.S.L.
2. Shaded area to be done by Contractor Excavation = approx. 5,840 cu. yd.

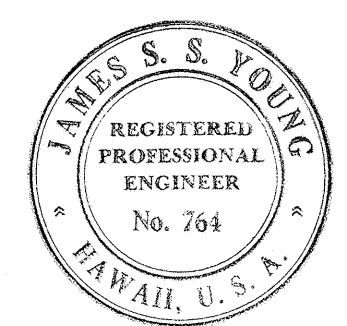

THIS WORK WAS PREPARED BY ME
OR UNDER MY SUPERVISION
W. Young 8/31/67

REVISION	DATE	BRIEF	BY	APPR'D
STATE OF HAWAII DEPARTMENT OF TRANSPORTATION HIGHWAYS DIVISION PROJECT NO. 72C-02-68				
HAWAII-KAI MARINA BRIDGE & CHANNEL MAUNALUA, OAHU, HAWAII.				
200' WIDE CHANNEL PLAN				
DRAWN BY: J. Young		ENGINEER: J. Young		
APPROVED BY:				
DIRECTOR, DIV. OF ENGINEERING	DATE	DEPUTY TRAFFIC ENGINEER DEPT. OF TRAFFIC	DATE	DATE
FILE	POCKET	FOLDER	NO.	

REVISED IN ACCORDANCE WITH CONSTRUCTION RECORDS

SHEET 6 OF 3 SHEETS

00-A-5-2