

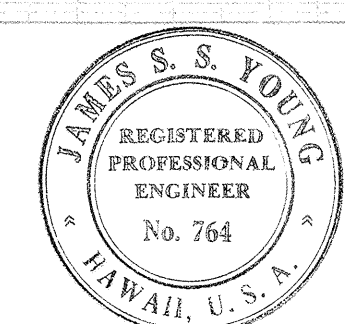
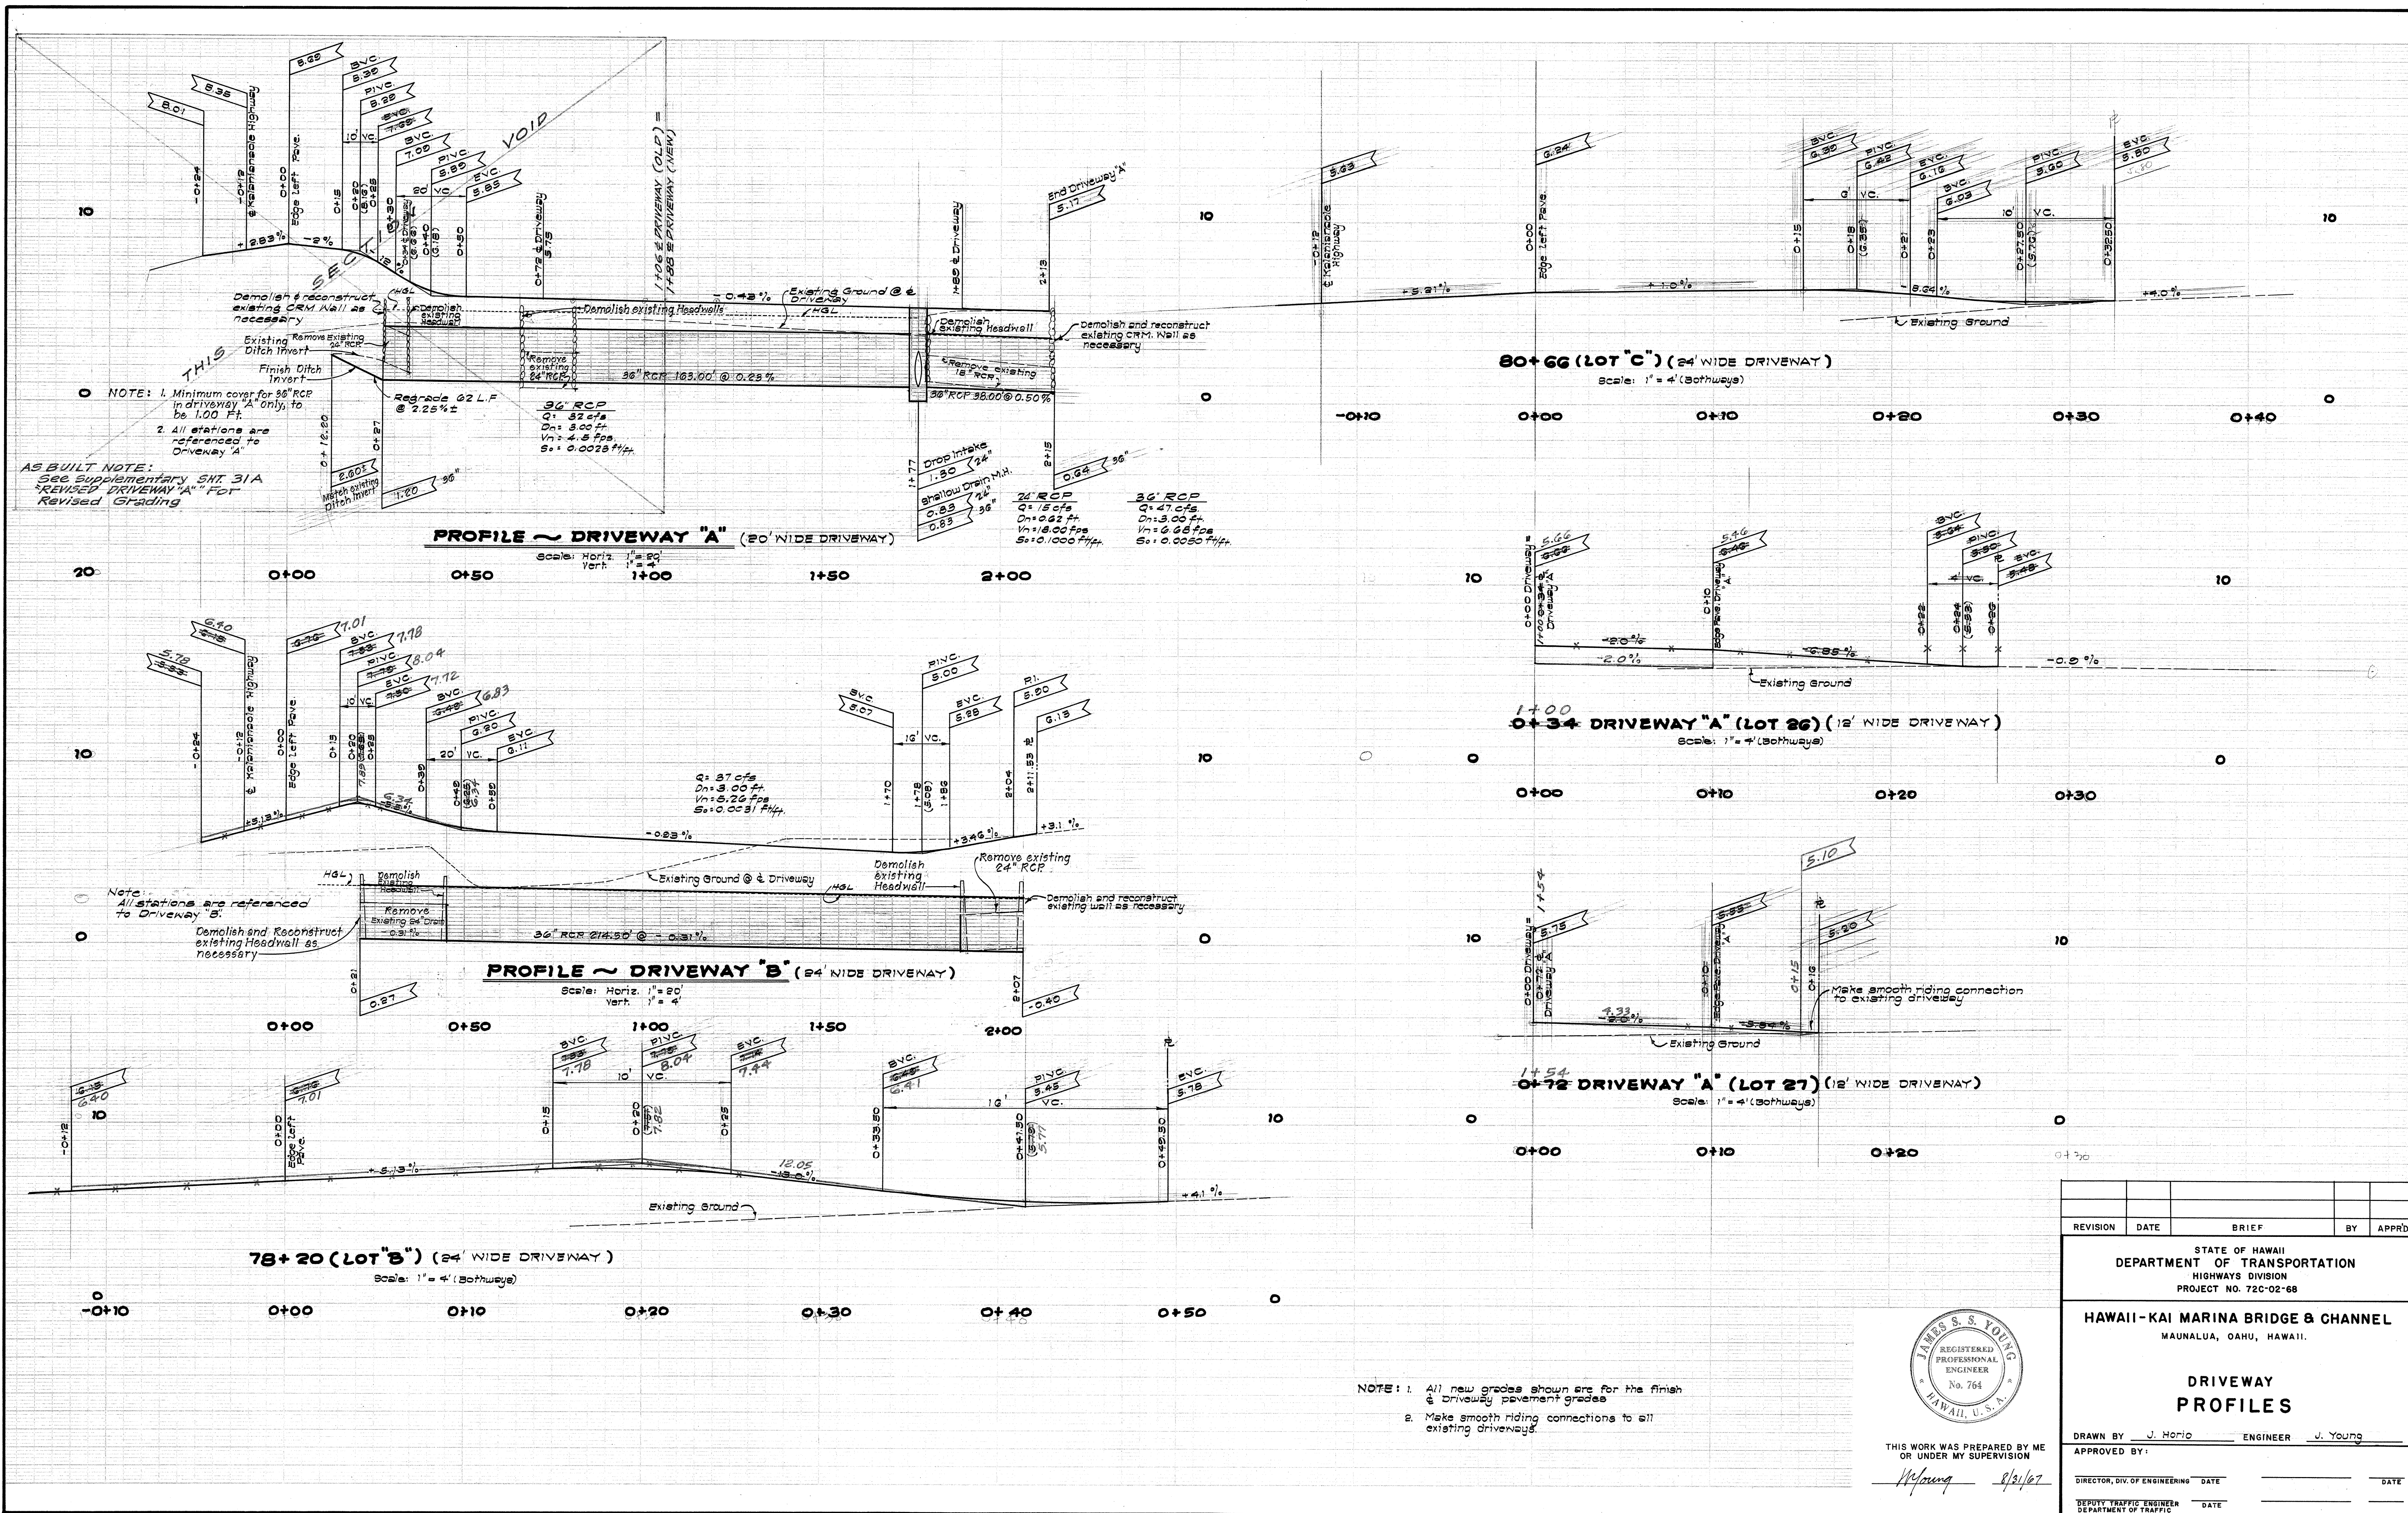


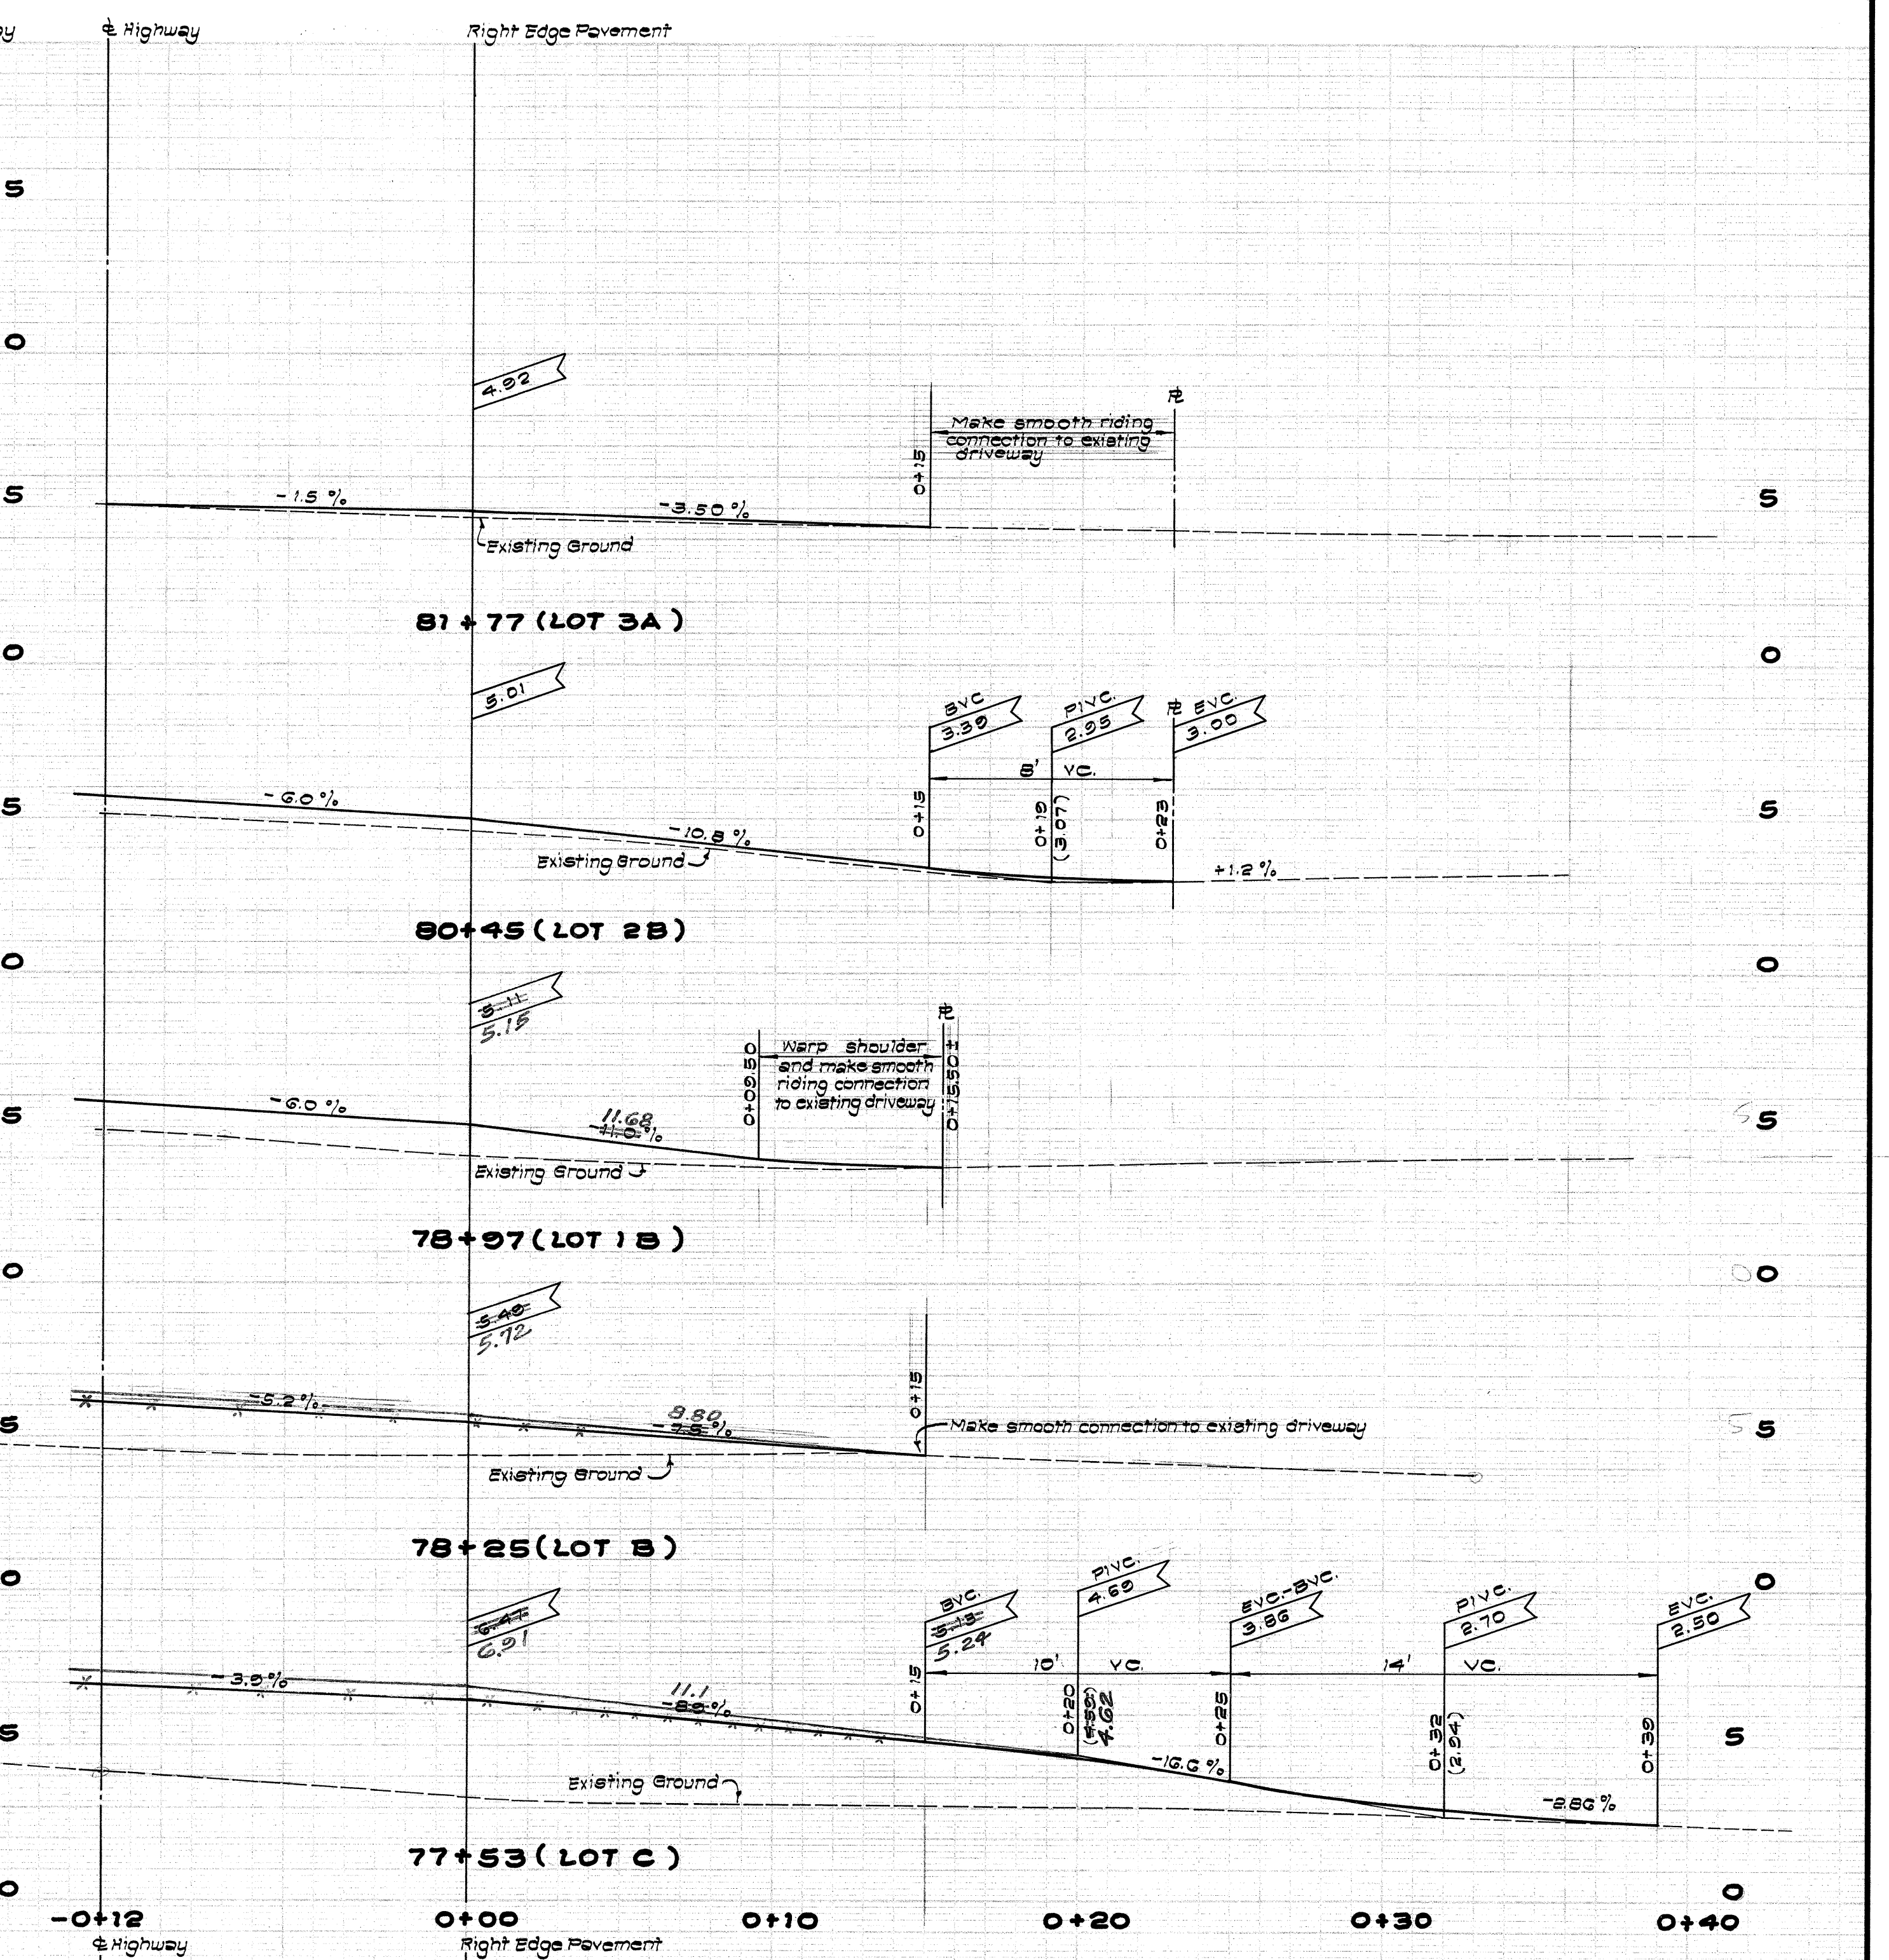

THIS WORK WAS PREPARED BY ME OR UNDER MY SUPERVISION
 J. Young 8/21/67

REVISION	DATE	BRIEF	BY	APPRD.
STATE OF HAWAII DEPARTMENT OF TRANSPORTATION HIGHWAYS DIVISION PROJECT NO. 72C-02-68 HAWAII-KAI MARINA BRIDGE & CHANNEL MAUNALUA, OAHU, HAWAII.				
DRIVEWAY PROFILES				
DRAWN BY J. Horie		ENGINEER J. Young		
APPROVED BY:				
DIRECTOR, DIV. OF ENGINEERING		DATE	DATE	
DEPUTY TRAFFIC ENGINEER		DATE	DATE	
FILE	POCKET	FOLDER	NO.	

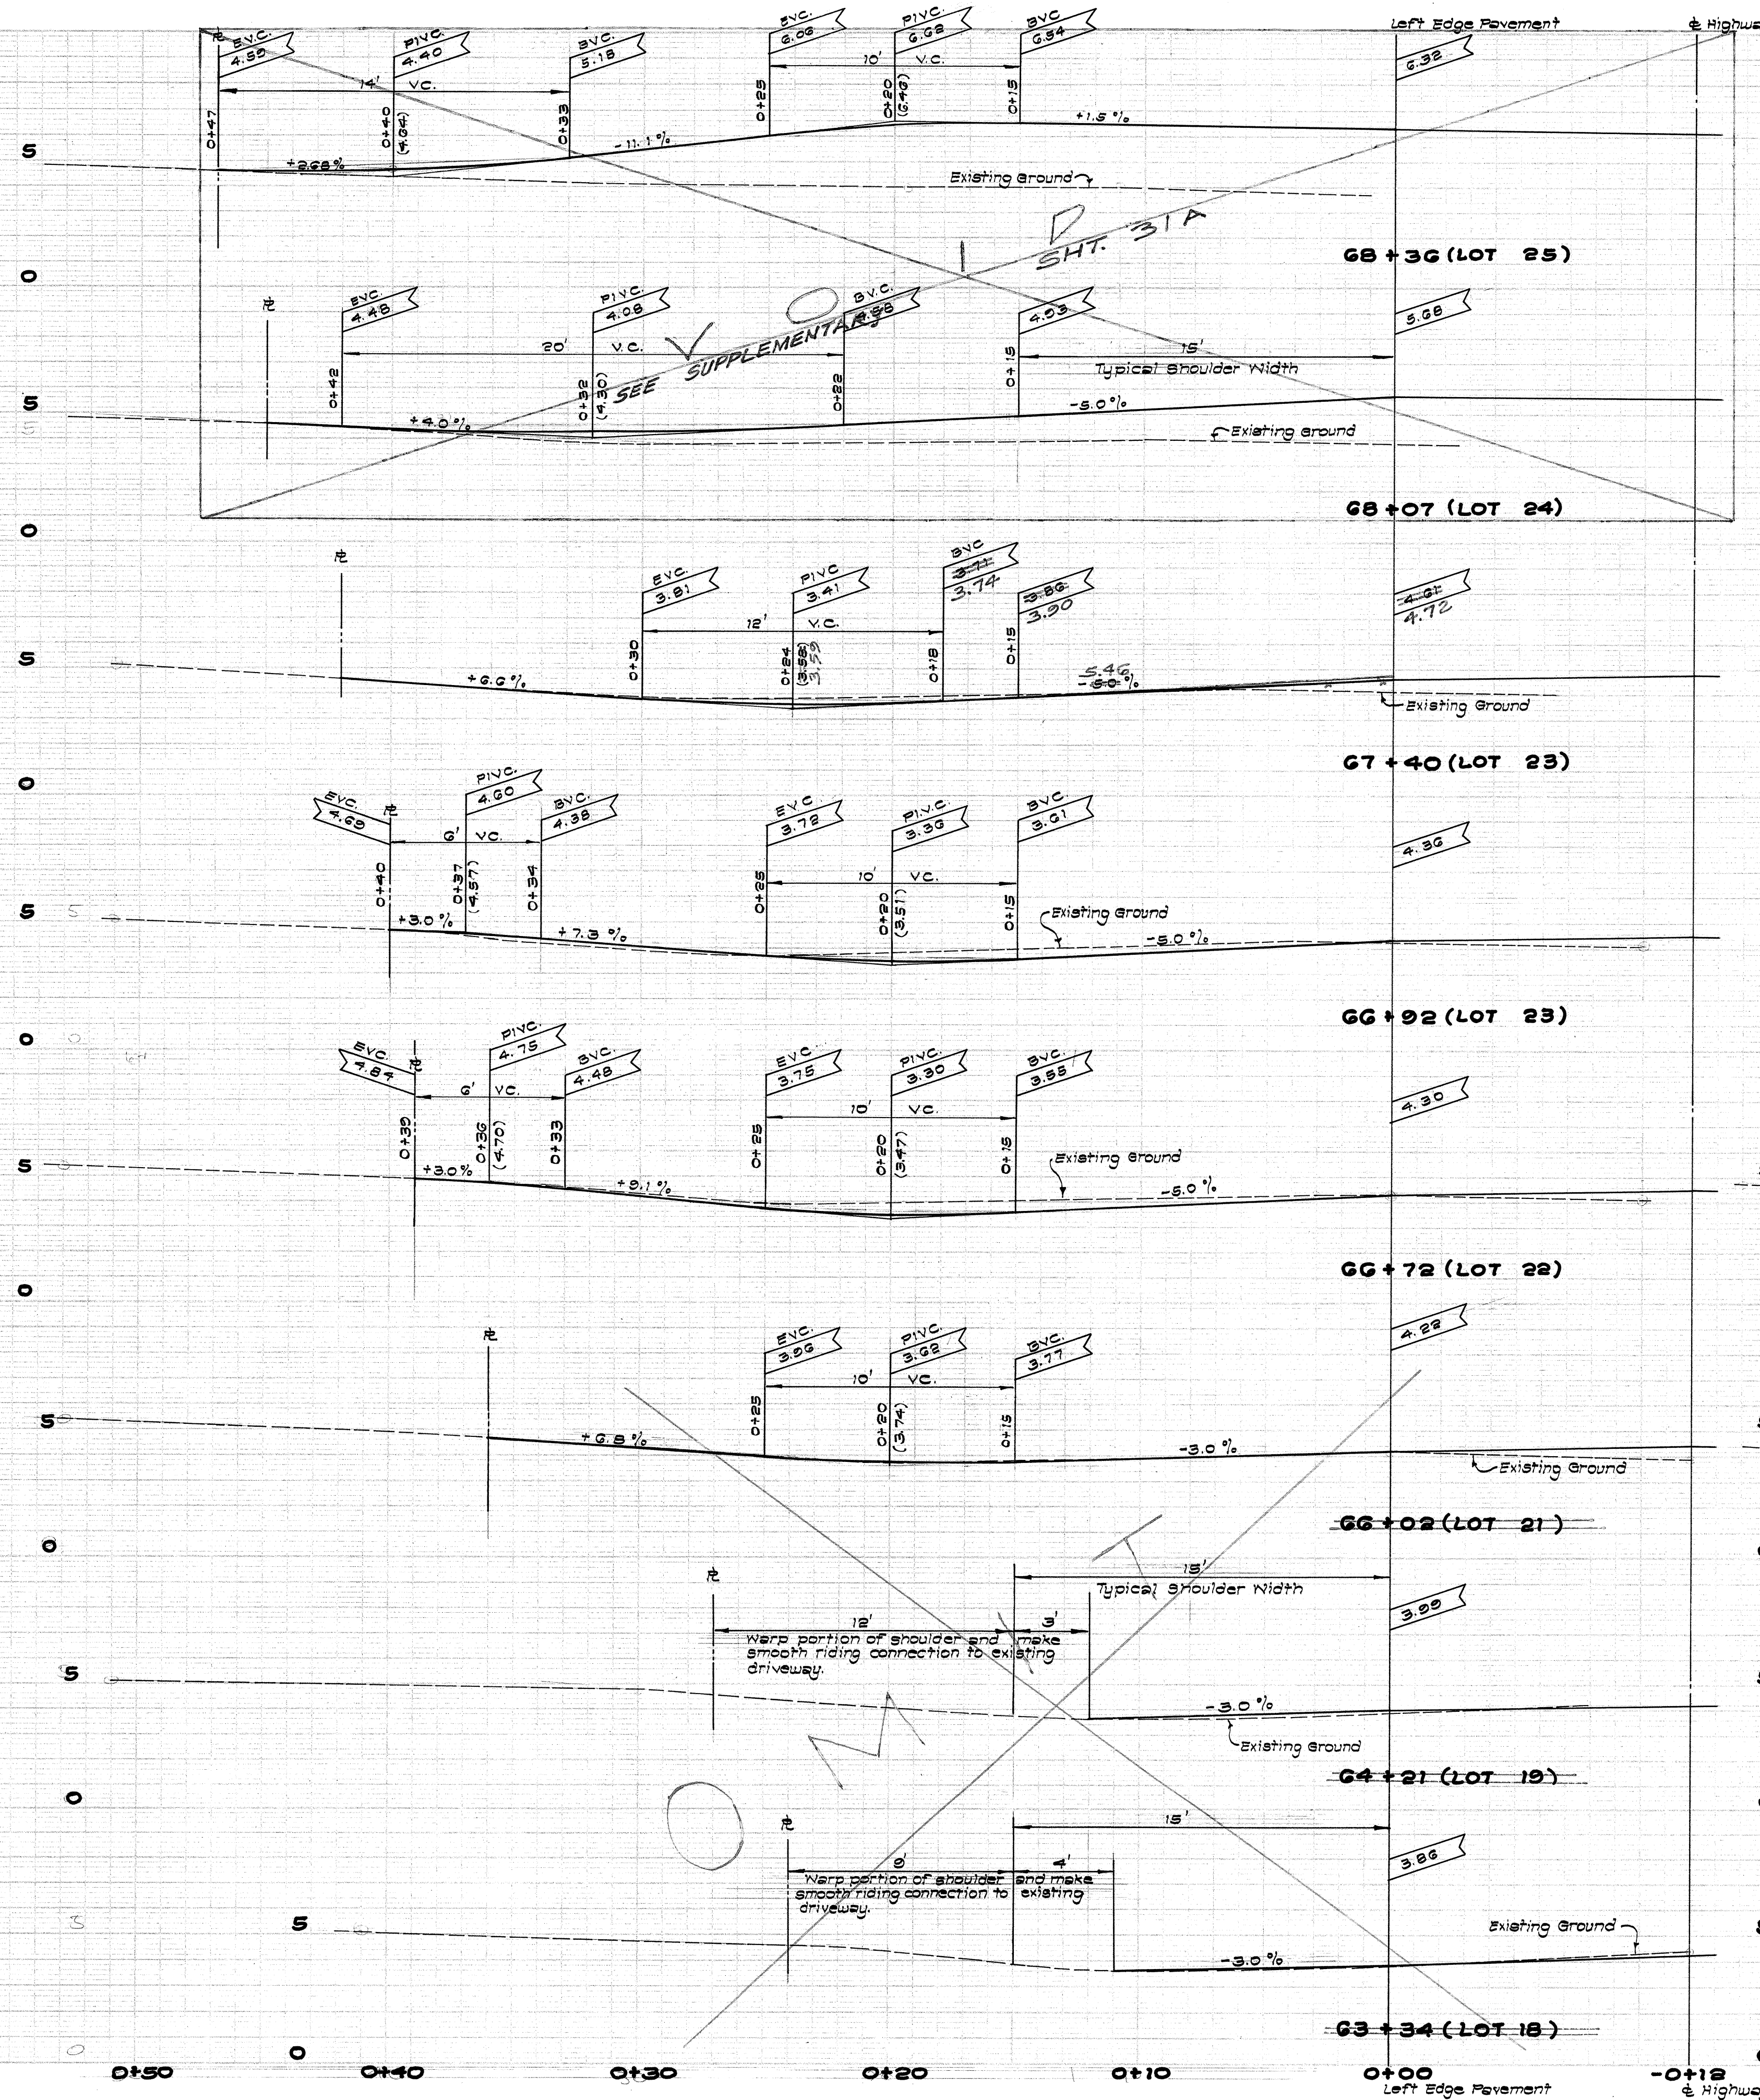

- NOTE: 1. All driveways shown are 12 feet wide.
2. All new grades shown are the finish & driveway pavement grades.
3. Make smooth riding connections to all existing driveways.



THIS WORK WAS PREPARED BY ME OR UNDER MY SUPERVISION

REVISION	DATE	BRIEF	BY	APPR'D
STATE OF HAWAII DEPARTMENT OF TRANSPORTATION HIGHWAYS DIVISION PROJECT NO. 72C-02-68				
HAWAII - KAI MARINA BRIDGE & CHANNEL MAUNALUA, OAHU, HAWAII.				
12' WIDE DRIVEWAY PROFILES				
DRAWN BY J. Horio		ENGINEER J. Young		
APPROVED BY:				
DIRECTOR DIV. OF ENGINEERING	DATE	DATE		
DEPUTY TRAFFIC ENGINEER	DATE	DATE		
FILE	POCKET	FOLDER	NO.	