



REVISED IN ACCORDANCE WITH CONSTRUCTION RECORDS

SHEET 22 OF 31 SHEETS


REVISION	DATE	BRIEF	BY	APPR'D
STATE OF HAWAII DEPARTMENT OF TRANSPORTATION HIGHWAYS DIVISION PROJECT NO. 72C-02-68				
HAWAII-KAI MARINA BRIDGE & CHANNEL MAUNALUA, OAHU, HAWAII.				
WATER DETAILS				
DRAWN BY		ENGINEER		
APPROVED BY		DATE		
CHIEF, ENR. DIVISION, S.W.S.		7/2/67		
FILE	POCKET	FOLDER	NO.	

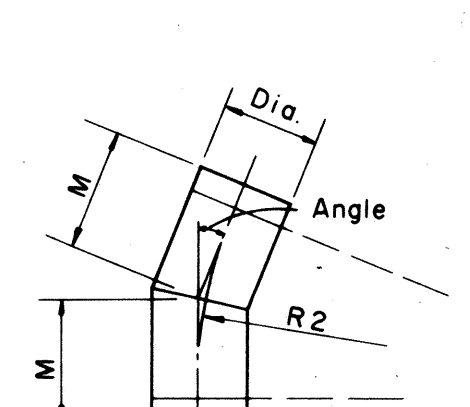


**2 PIECE ELBOW**  
0° to 22 1/2° Inclusive

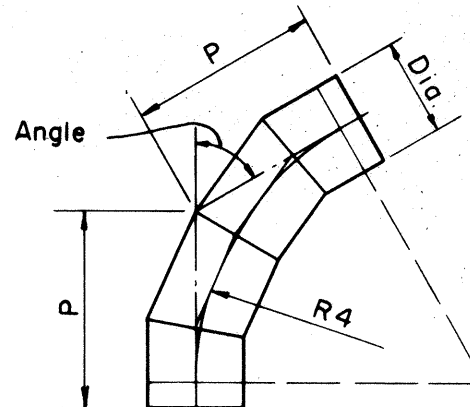


**4 PIECE ELBOW**  
Over 45° to 67 1/2° Inclusive

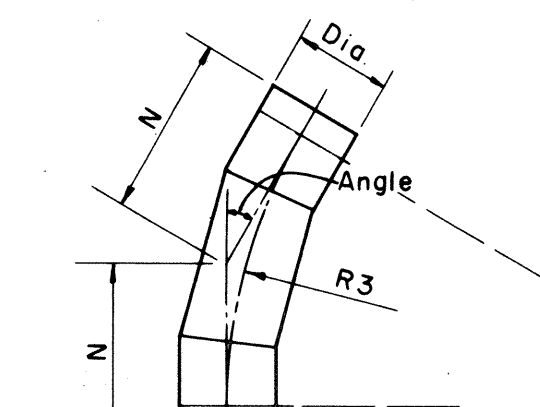


**3 PIECE ELBOW**  
Over 22 1/2° to 45° Inclusive

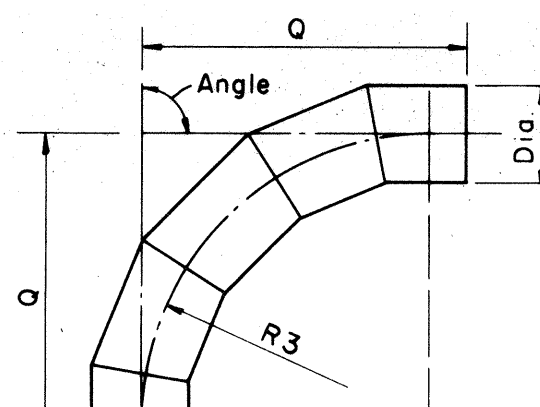


**5 PIECE ELBOW**  
Over 67 1/2° to 90° Inclusive

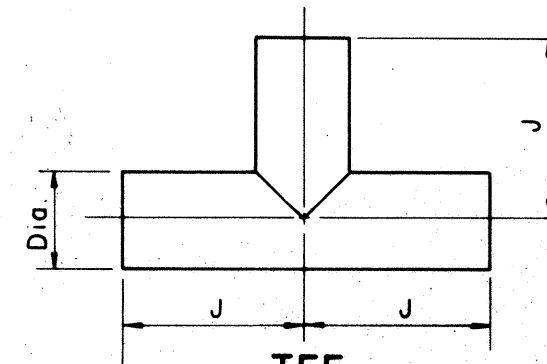

**TEE**

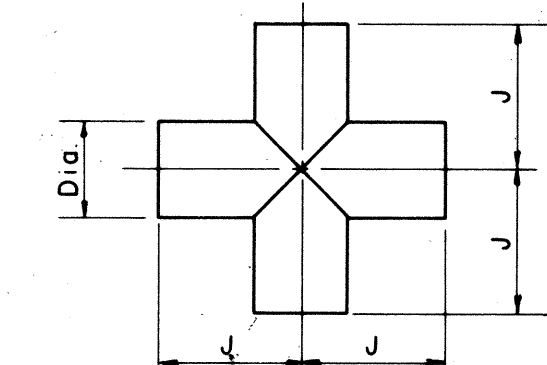


**CROSS**

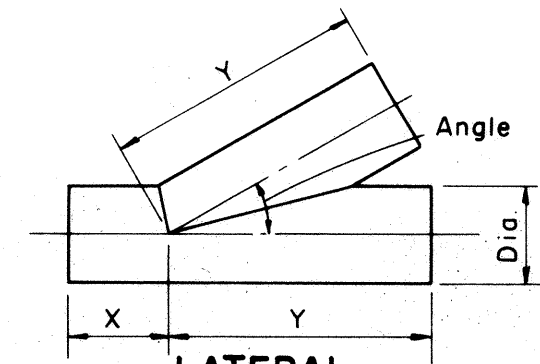

**LATERAL**

30° Minimum - 75° Maximum

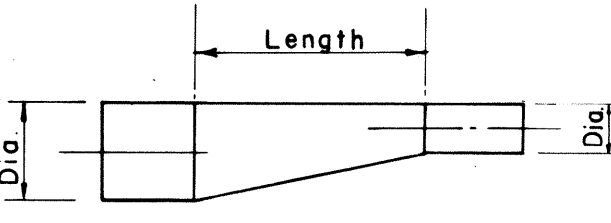

**REDUCER**


STANDARD FITTING DIMENSIONS														
DIAMETER	TEE		CROSS (Both Ways)	LATERAL (30° to 75°)	ELBOWS (Center to End)									
					2 Piece (up to 22 1/2°)		3 Piece (22 1/2° to 45°)		4 Piece (45° to 67 1/2°)		5 Piece (67 1/2° to 90°)			
	Run J+J	Outlet J+J			Run X+Y	Outlet Y	M	R2	N	R3	P	R4		
16"	34"	17"	34"	62"	52"	12"	60"	18"	44"	26"	39"	34"		
18"	36"	18"	36"	66"	56"	12"	60"	19"	47"	27"	41"	36"		
20"	38"	19"	38"	72"	60"	13"	65"	20"	49"	28"	42"	39"		
22"	40"	20"	40"	78"	66"	13"	65"	21"	51"	30"	45"	41"		
24"	42"	21"	42"	84"	72"	14"	70"	22"	54"	32"	48"	44"		
30"	60"	30"	60"	96"	84"	15"	75"	25"	61"	37"	51"	51"		
36"	66"	33"	66"	110"	96"	16"	80"	27"	66"	40"	60"	56"		

#### DIMENSIONS FOR ECCENTRIC REDUCER REDUCING SECTION


36" X 30" Eccentric Reducer - Length 66"  
30" X 24" Eccentric Reducer - Length 66"  
24" X 20" Eccentric Reducer - Length 26"  
20" X 16" Eccentric Reducer - Length 26"

#### NOTE:


All dimensions shown are laying lengths.  
All fittings and specials shall be fabricated independent from pipe sections and in accordance with the dimensions shown.  
All fittings and specials shall be all bell unless otherwise noted.  
All tees, wyes, crosses and reducers 16-inch in diameter and larger shall be reinforced with steel ribs or steel crotch plates welded continuously to the cylinder or by other methods to withstand the longitudinal crushing effect caused by the test pressure as called for in the plans.

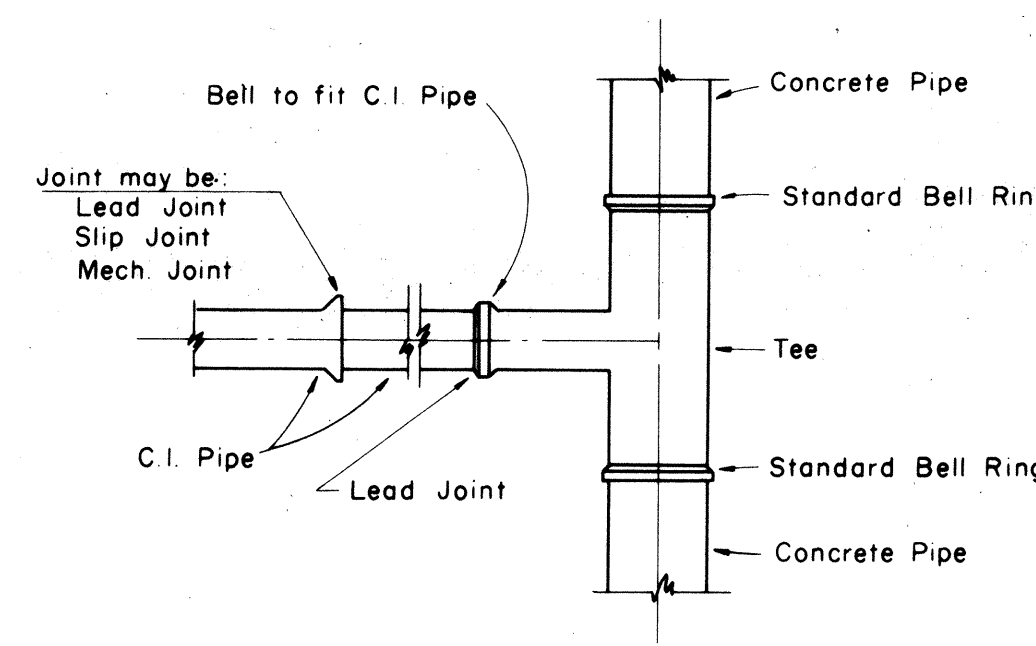


**TYPICAL CAST IRON PIPE CONNECTION TO CONCRETE CYLINDER PIPE**

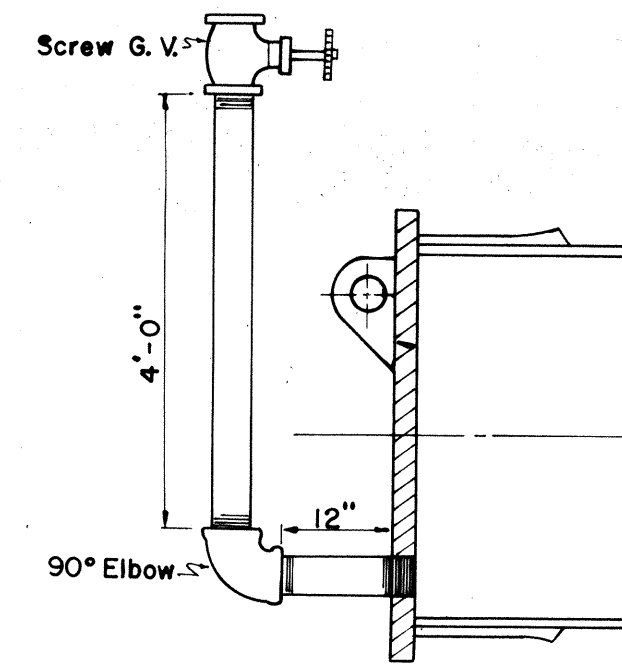

**TYPICAL SECTION OF TEMPORARY CLEANOUT**

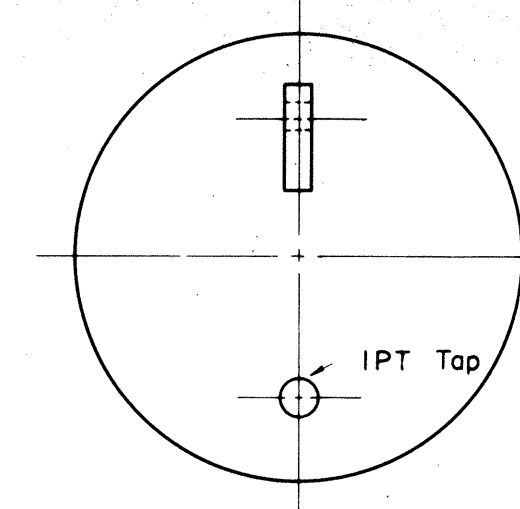


**PLAN OF STEEL PLATE**

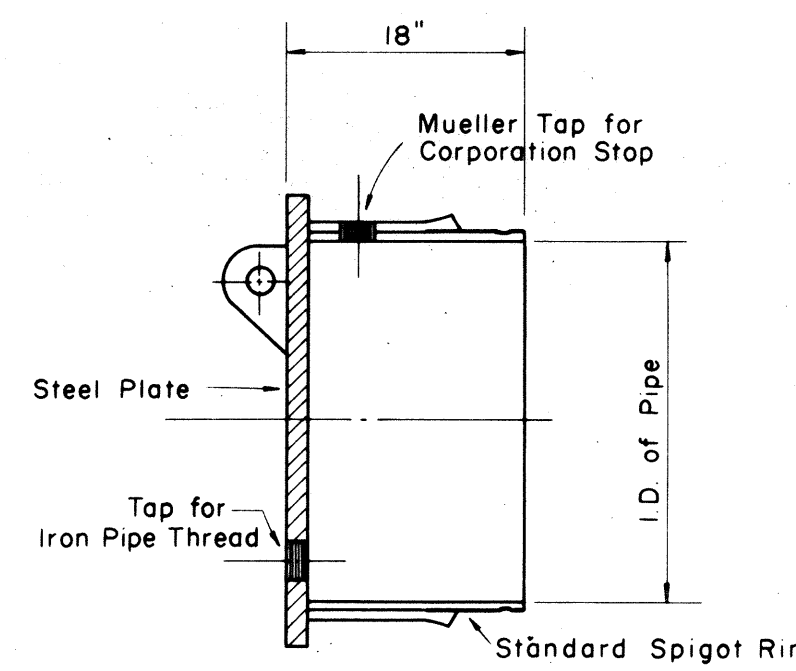


**SECTION**

**DETAIL OF PLUG**

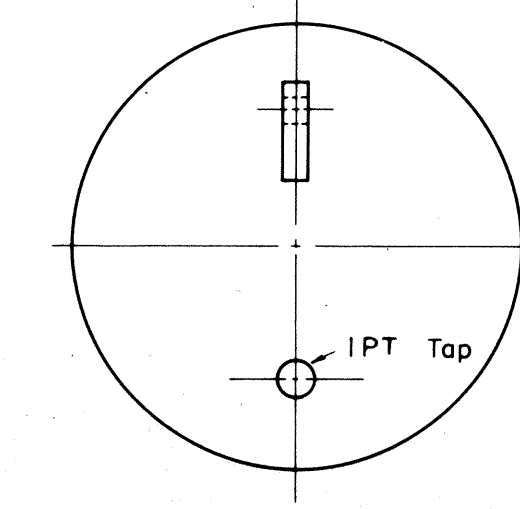


**PLAN OF STEEL PLATE**

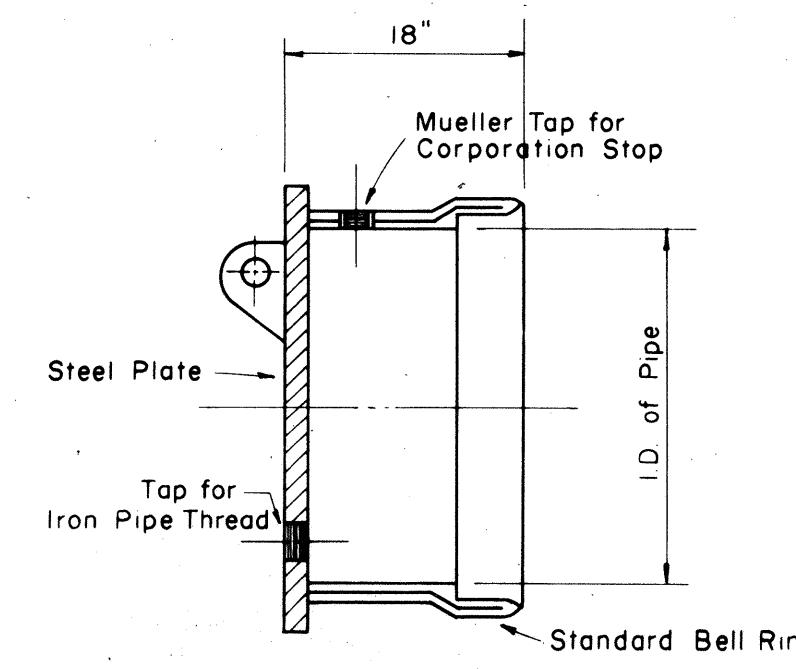


**SECTION**


**DETAIL OF CAP**

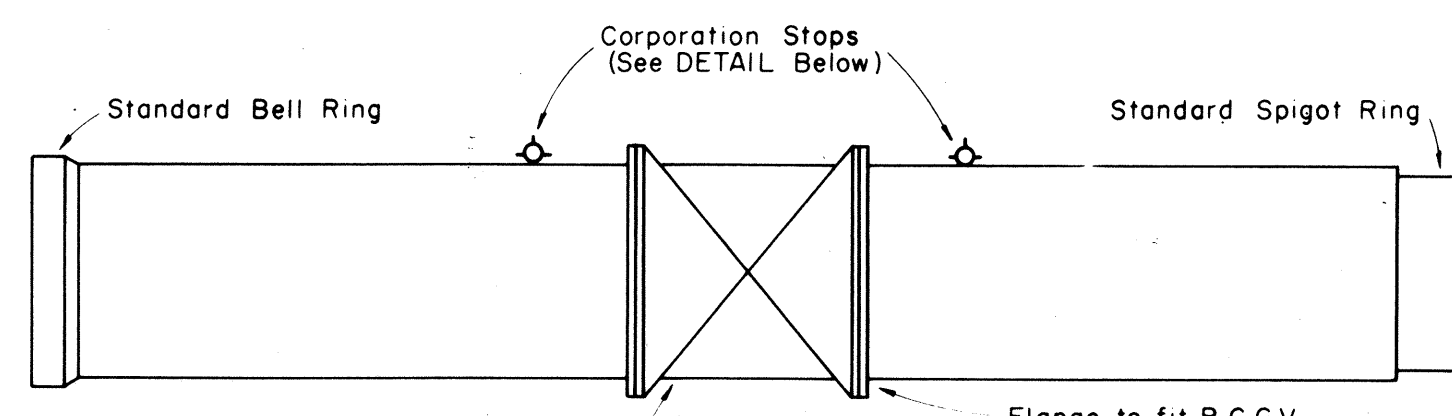


**ELEVATION**

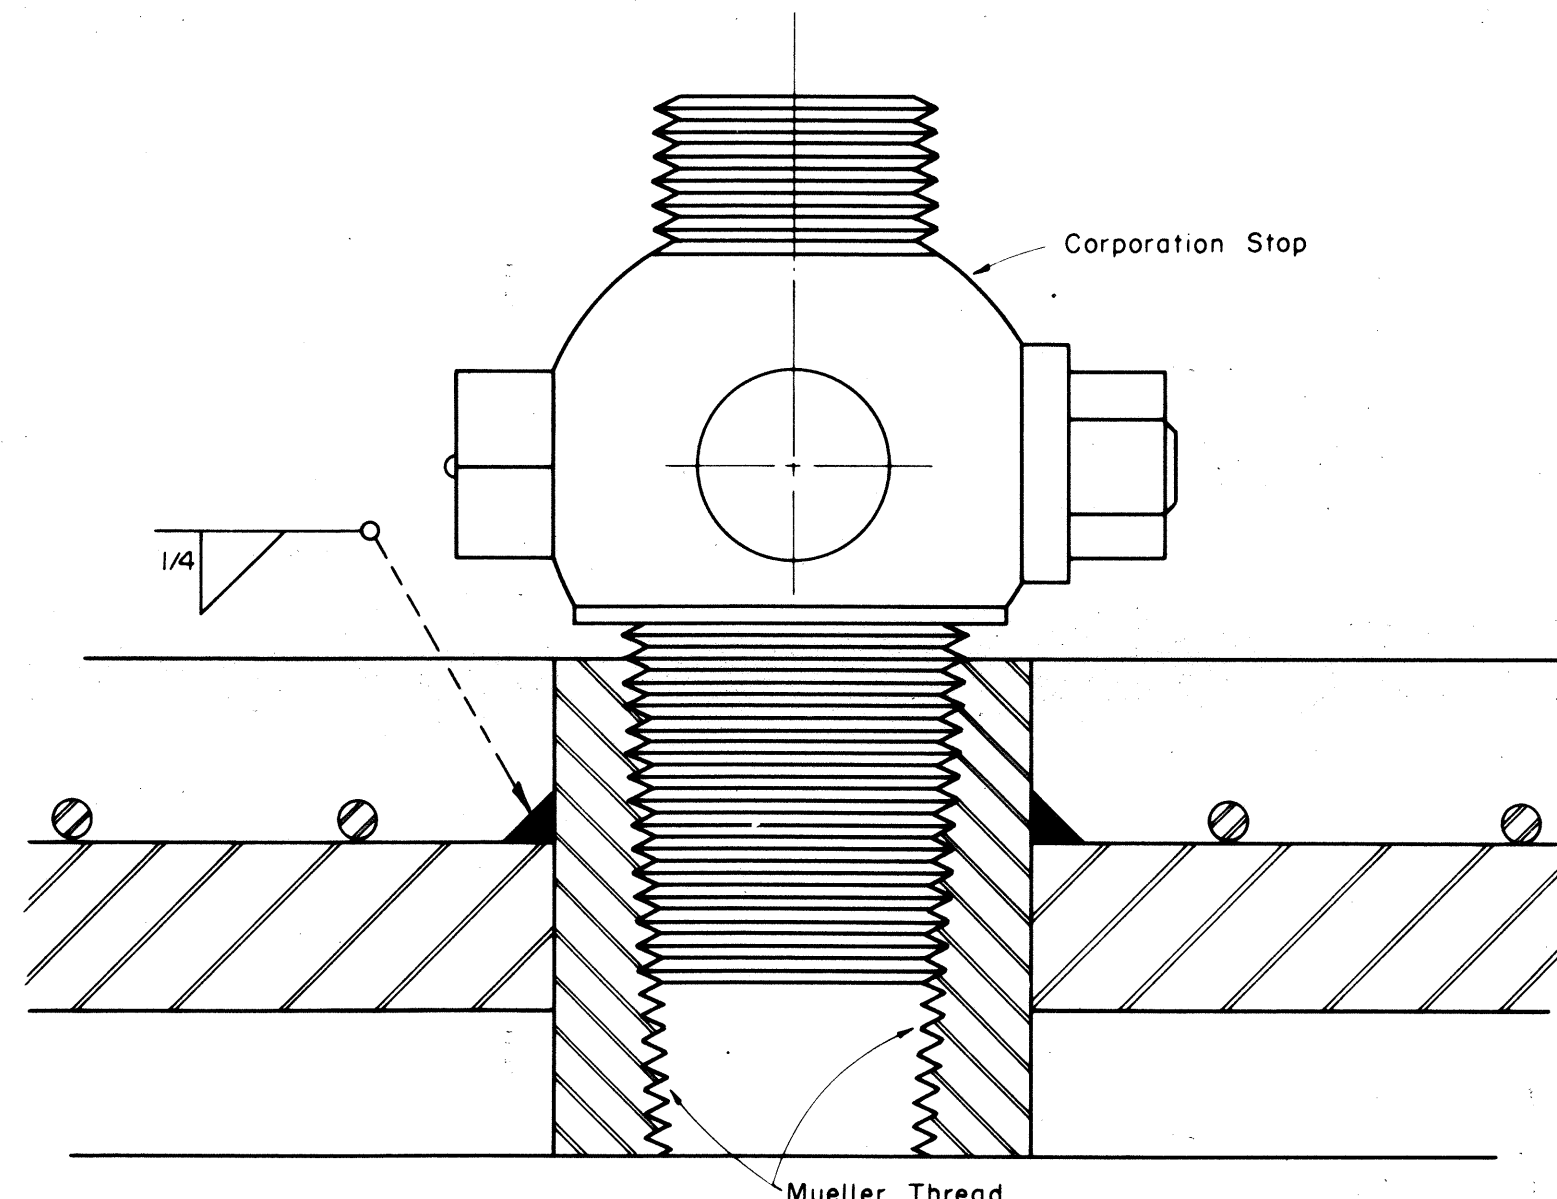

**TYPICAL SECTION THRU CONCRETE PIPE AT CORPORATION STOP**

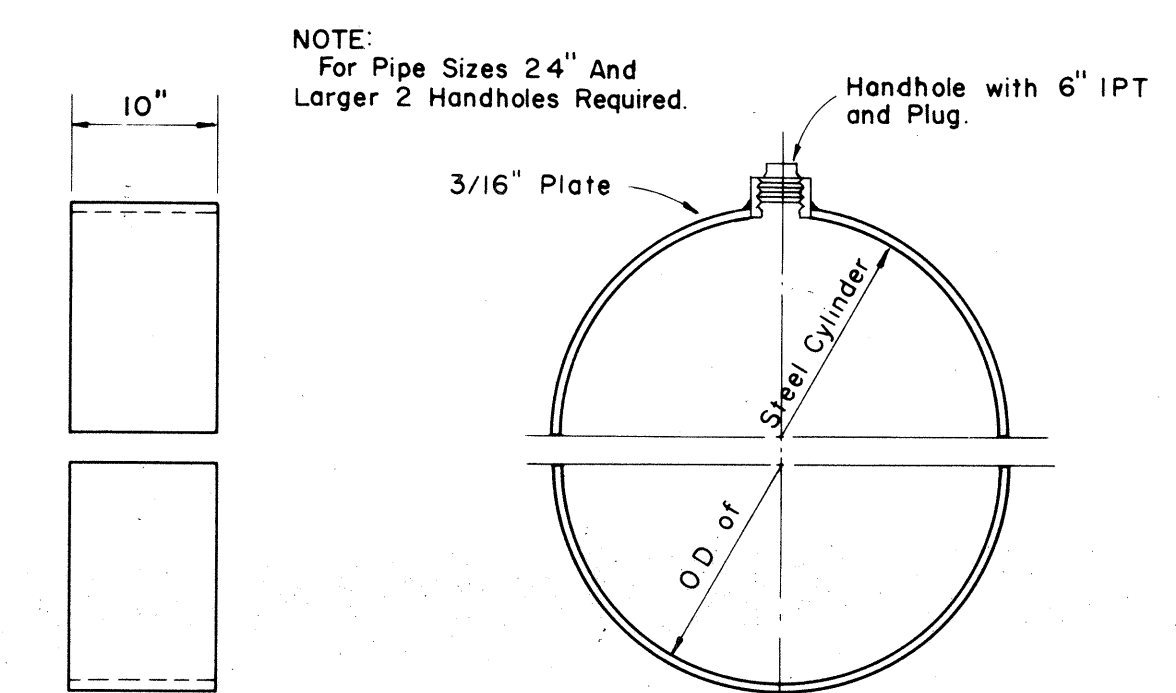


**DETAIL OF SPLIT BUTT STRAP**

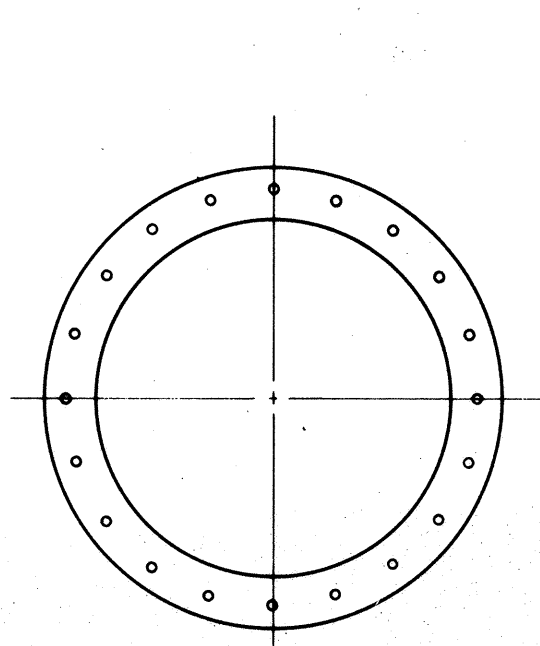


**FLANGE**

See Specs. for Flange Class

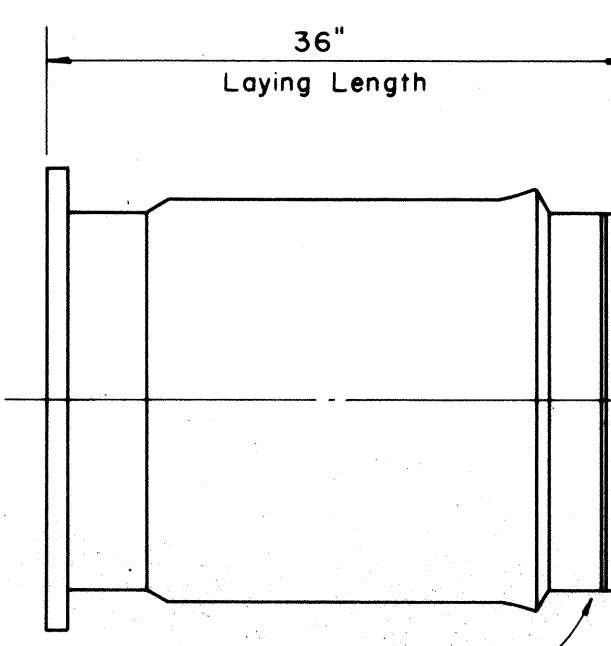


**Standard Spigot Ring**

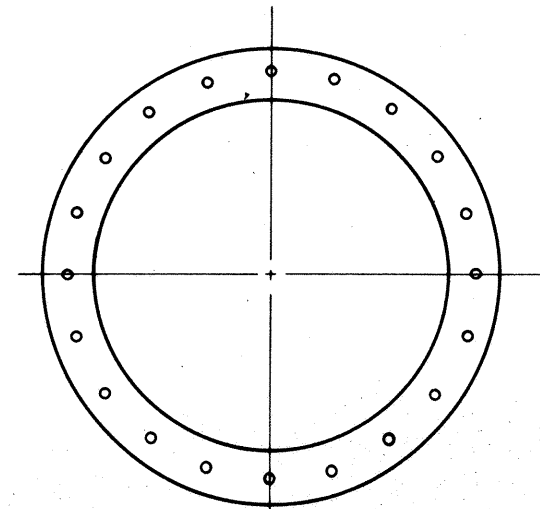


**FLANGE**


See Specs. for Flange Class

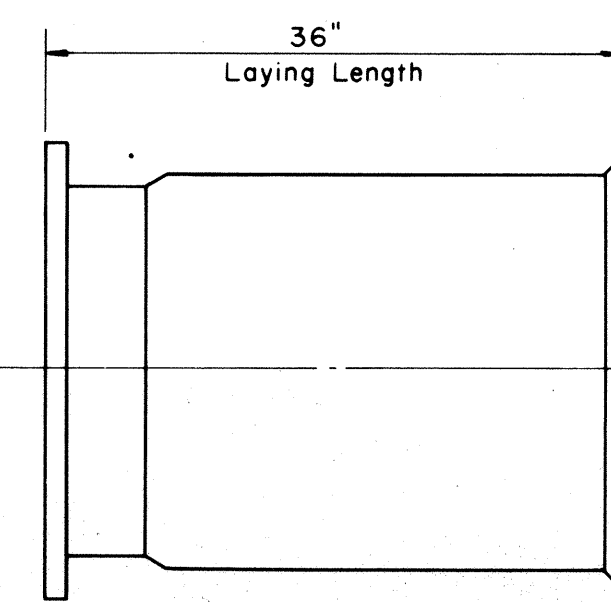


**Standard Bell Ring**

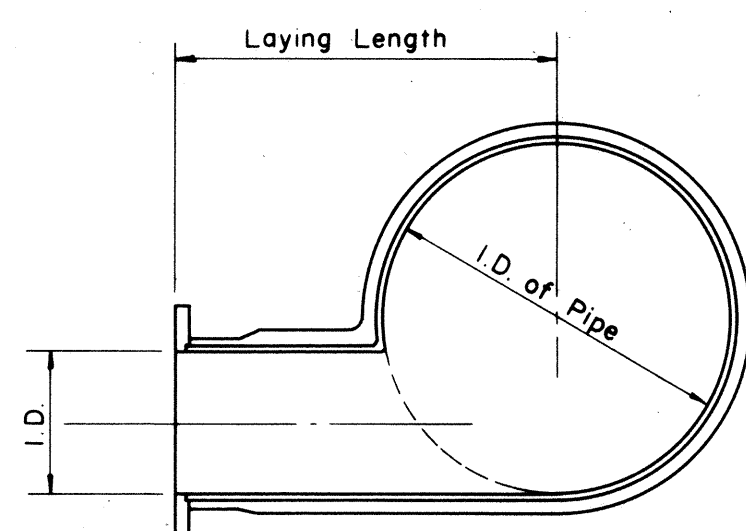

**SECTION**

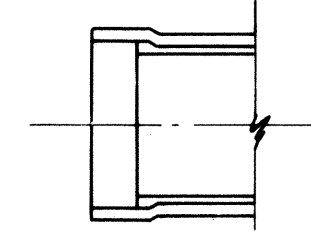

**BELL SECTION**

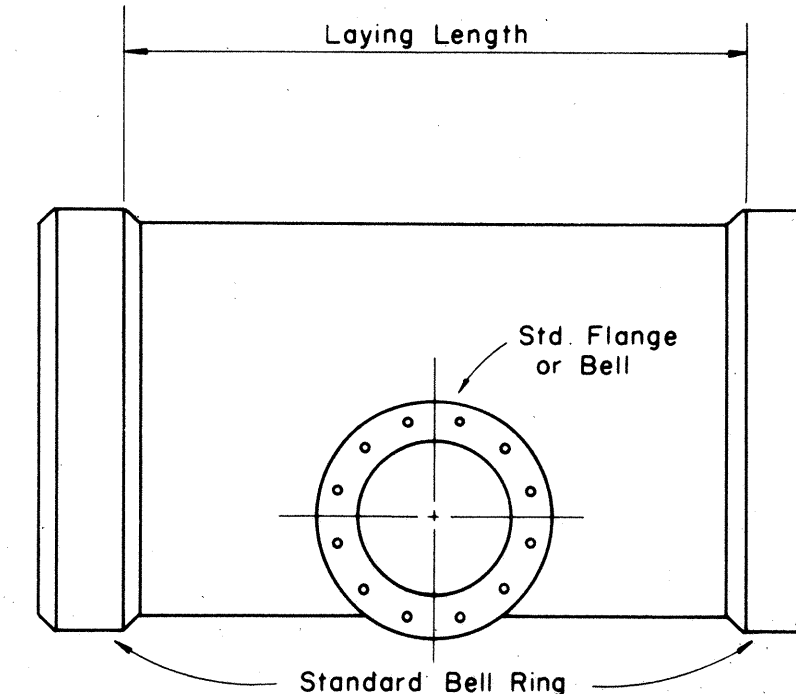

**TYPICAL DETAIL OF BLOW-OFF TEE**

**TYPICAL DETAIL OF ADAPTER**

REVISION	DATE	BRIEF	BY	APPR'D
STATE OF HAWAII DEPARTMENT OF TRANSPORTATION HIGHWAYS DIVISION PROJECT NO. 72C-02-68 <b>HAWAII - KAI MARINA BRIDGE &amp; CHANNEL</b> MAUNALUA, OAHU, HAWAII.				
<b>WATER DETAILS</b>				
DRAWN BY: <i>[Signature]</i>		ENGINEER: <i>[Signature]</i>		
APPROVED BY: <i>[Signature]</i>		DATE: 7/1/67		

THIS WORK WAS PREPARED BY ME OR UNDER MY SUPERVISION