

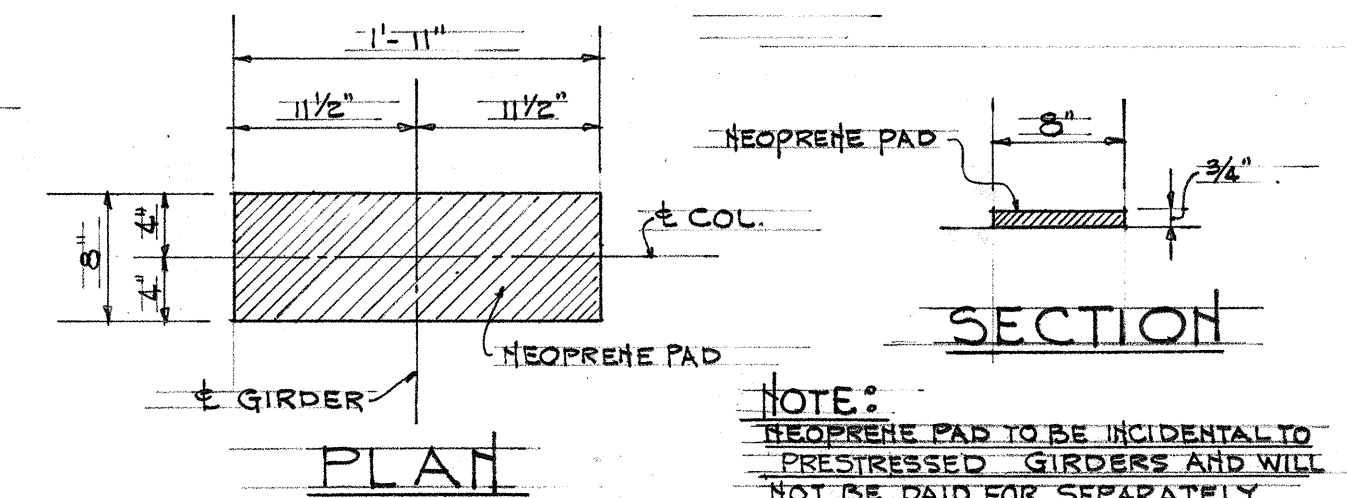
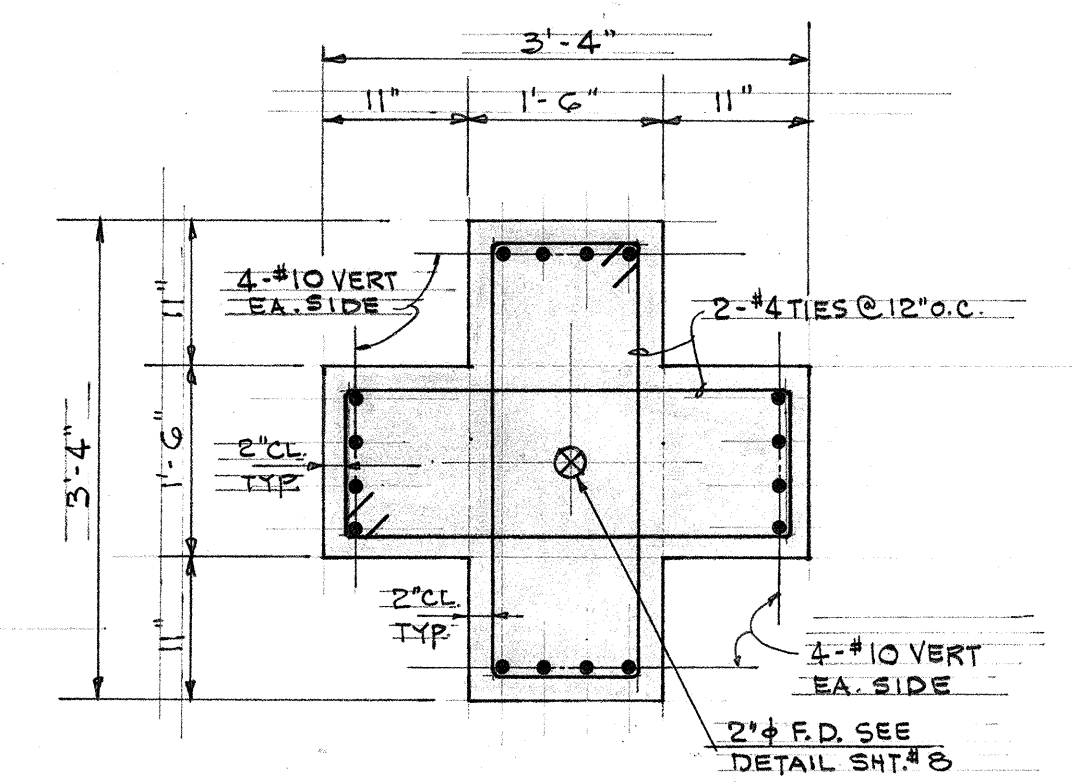
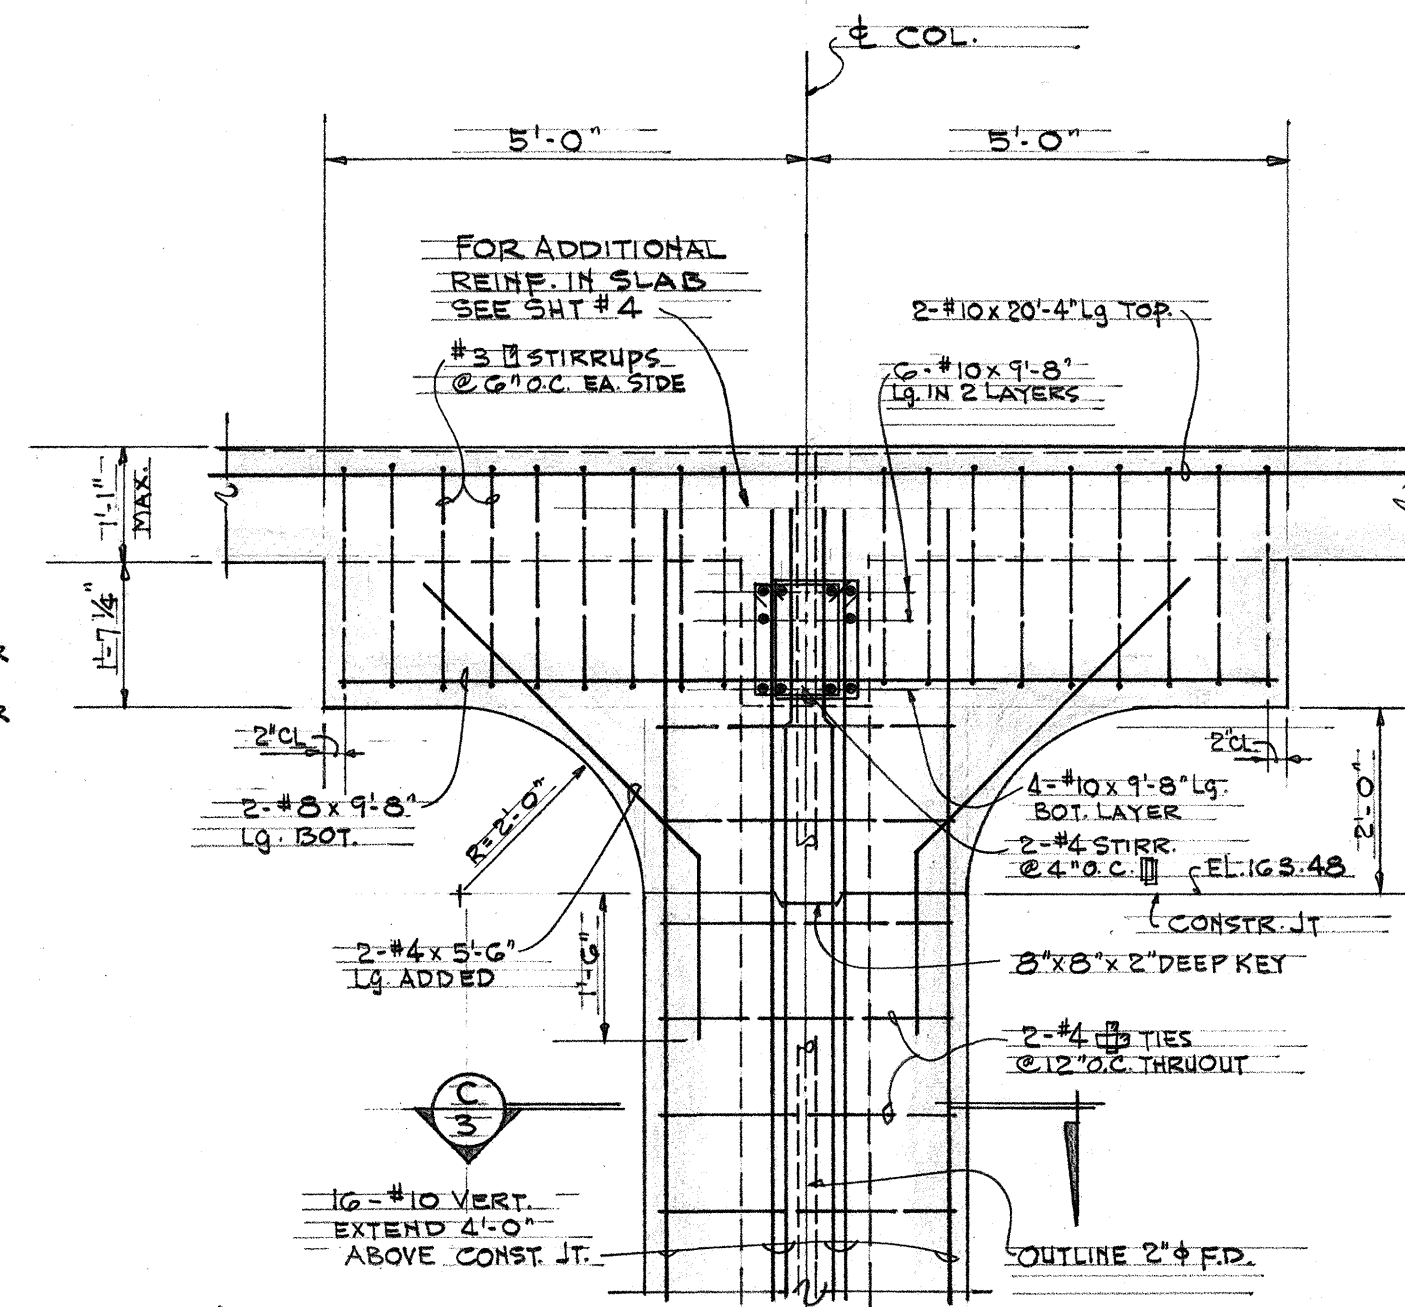
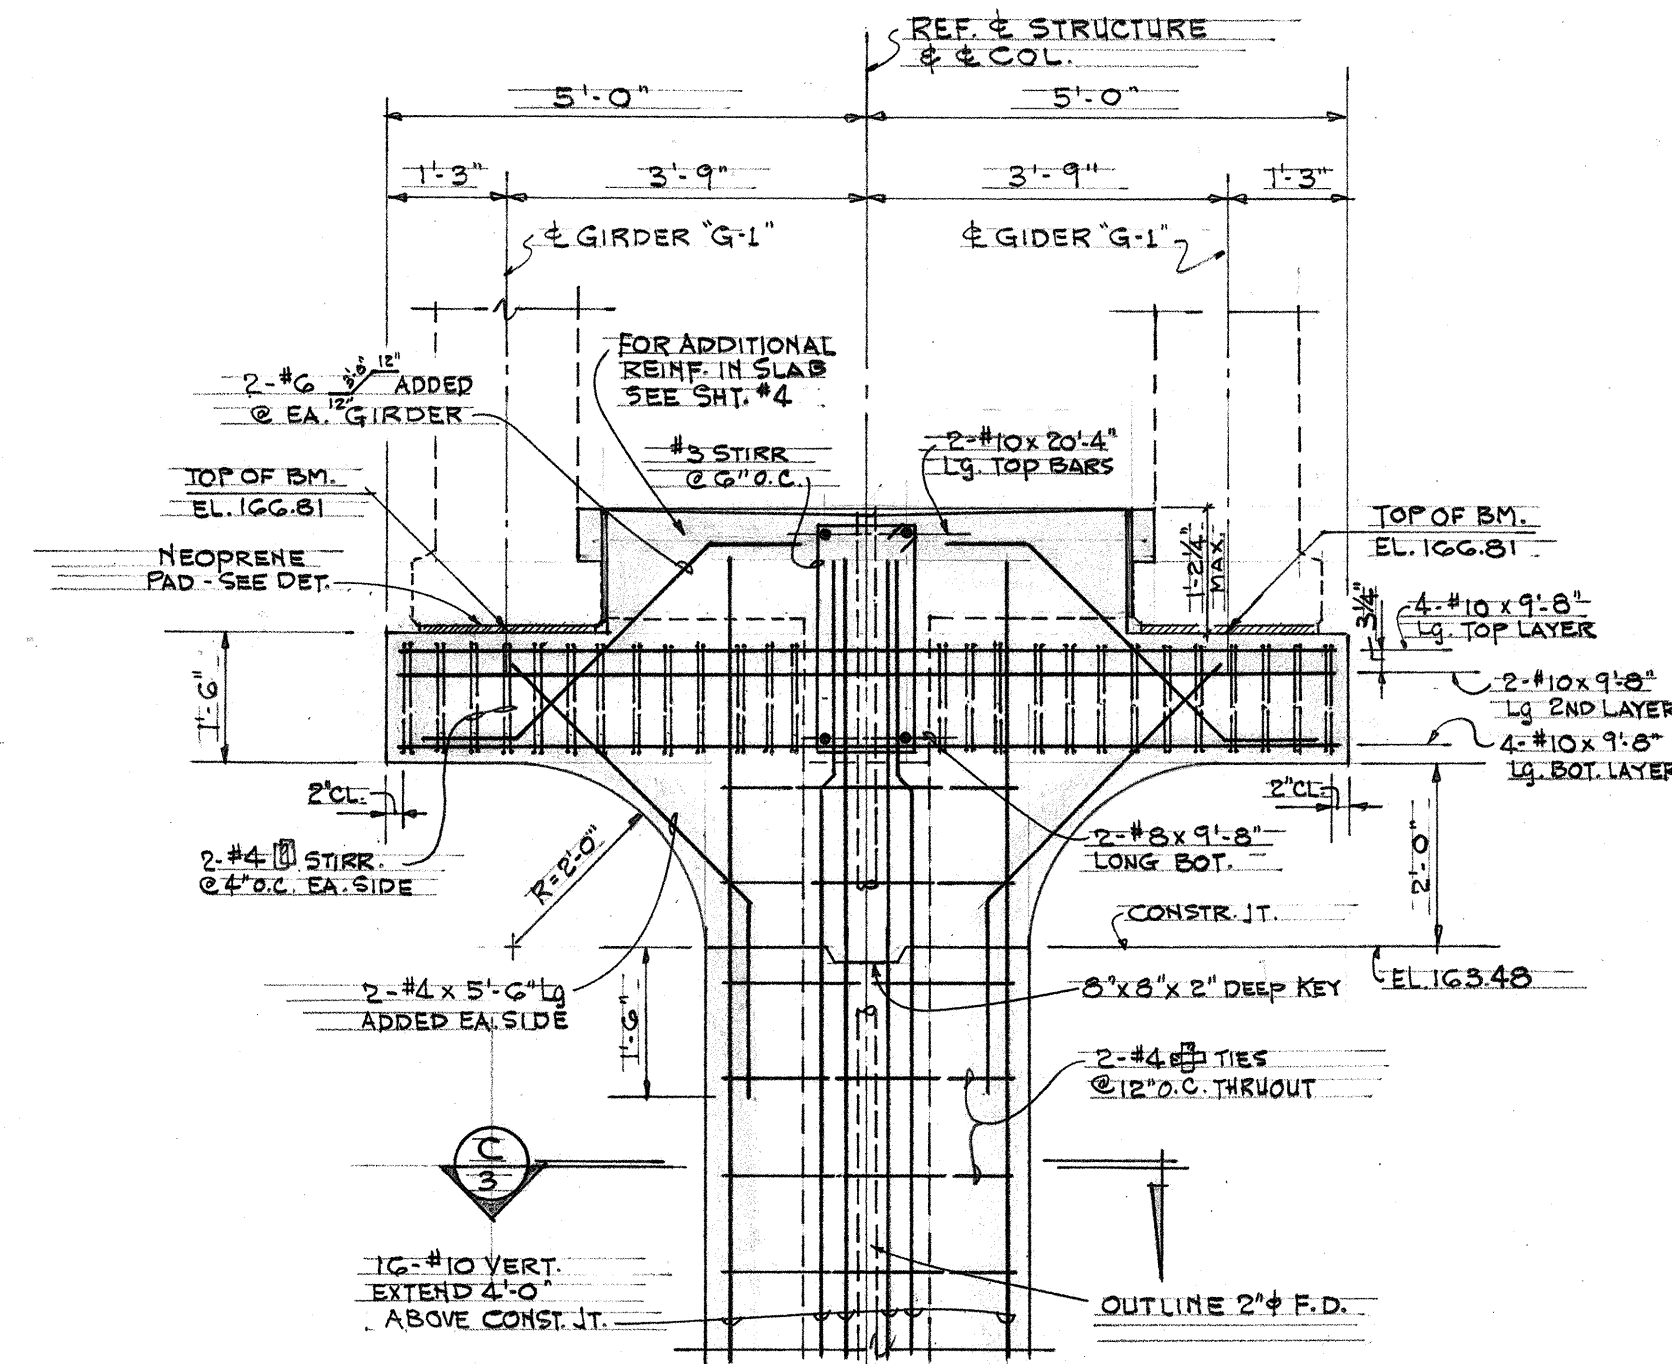
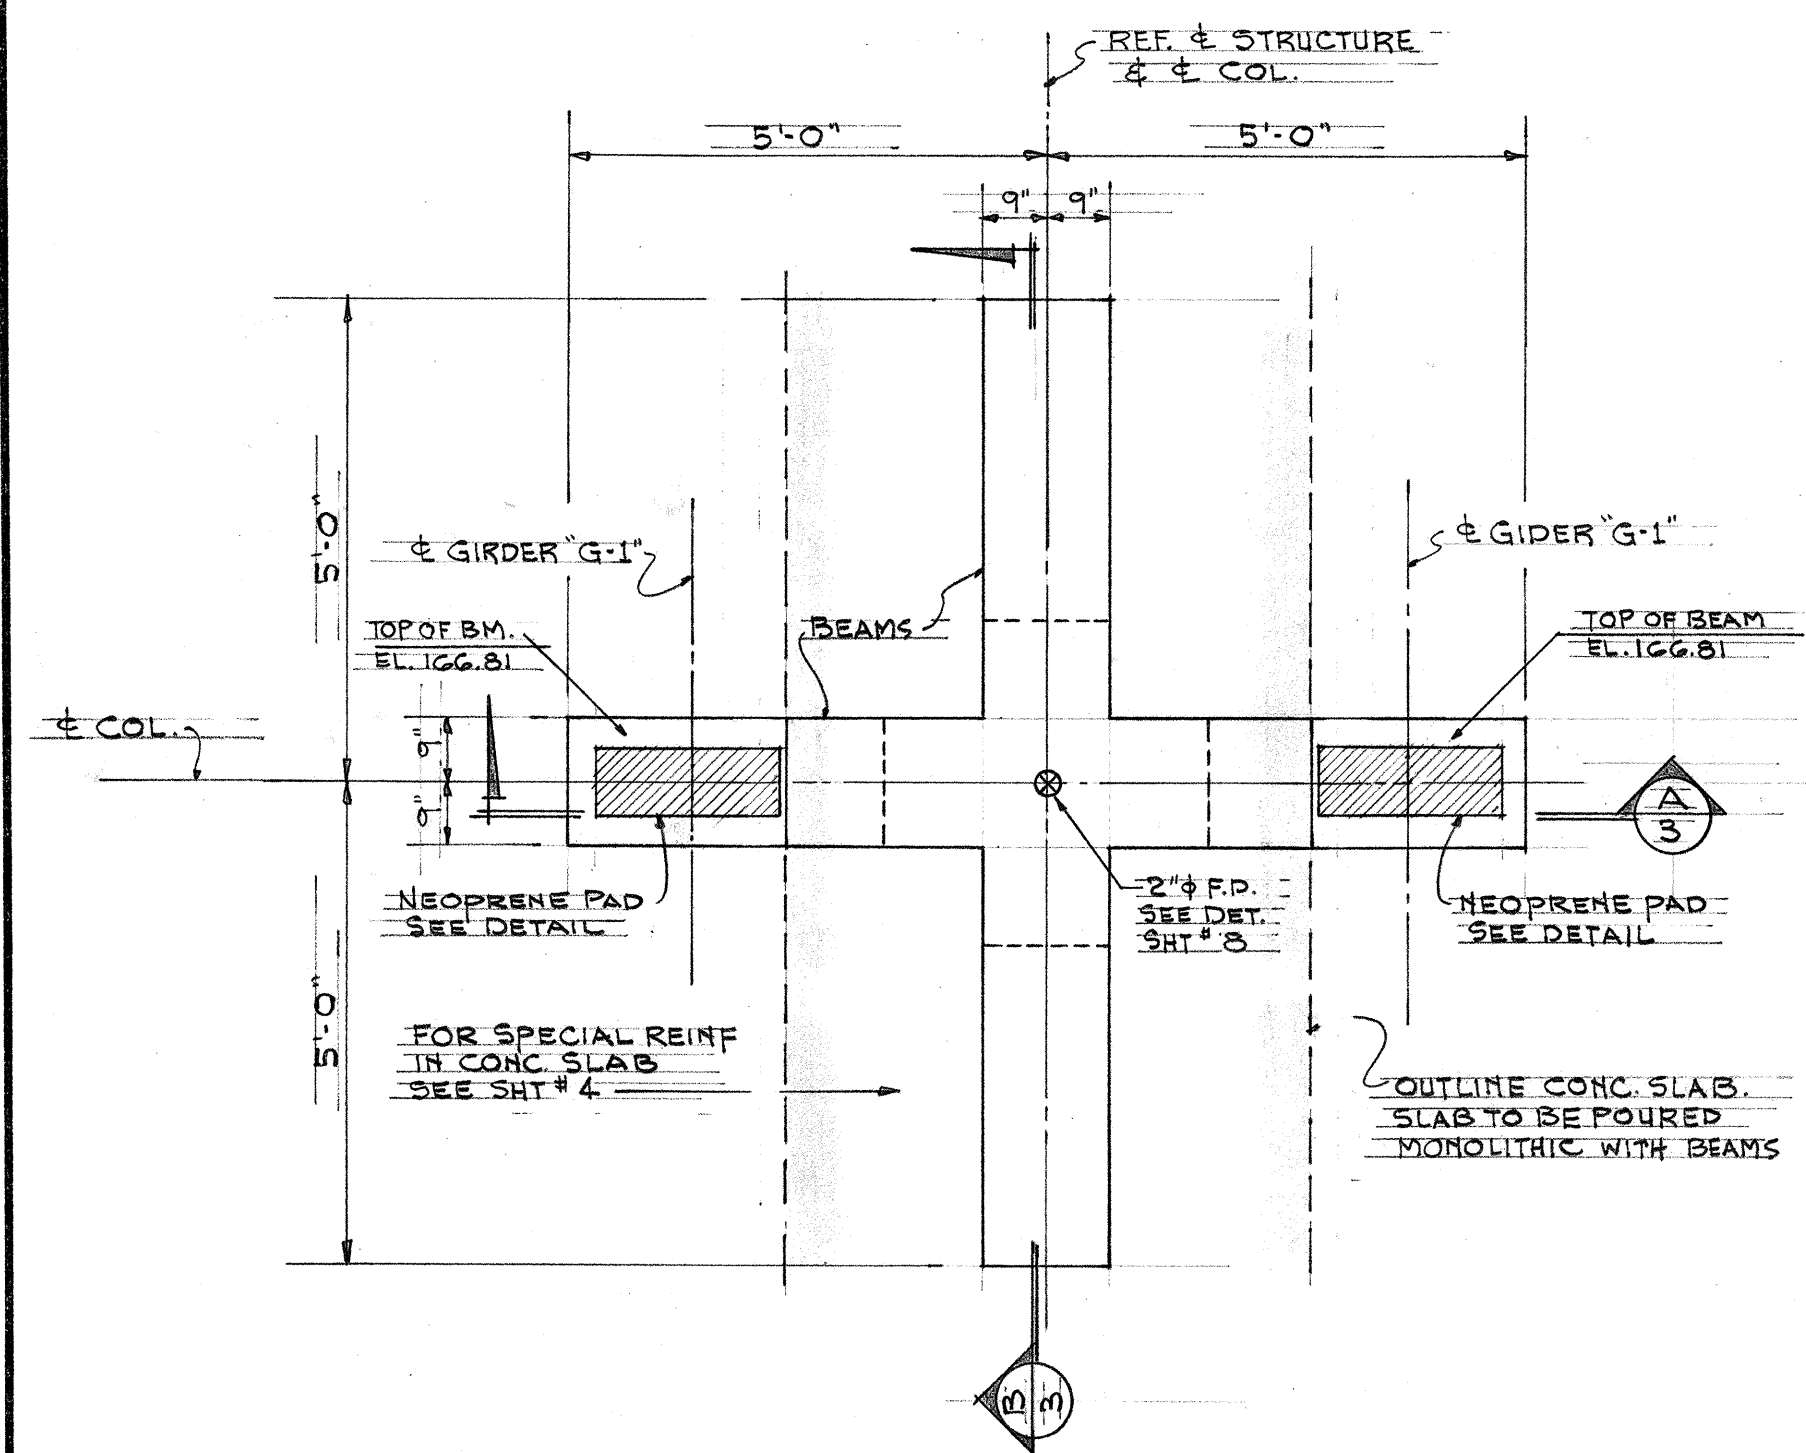
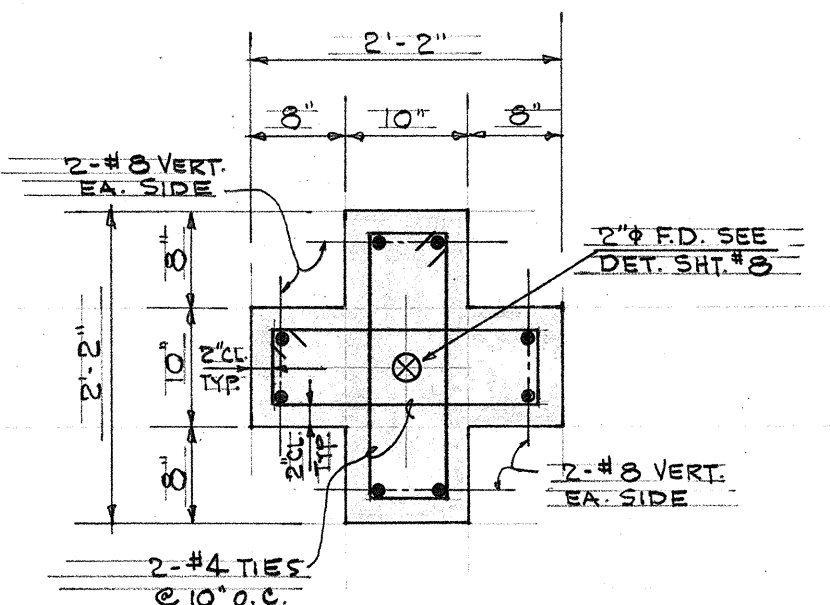
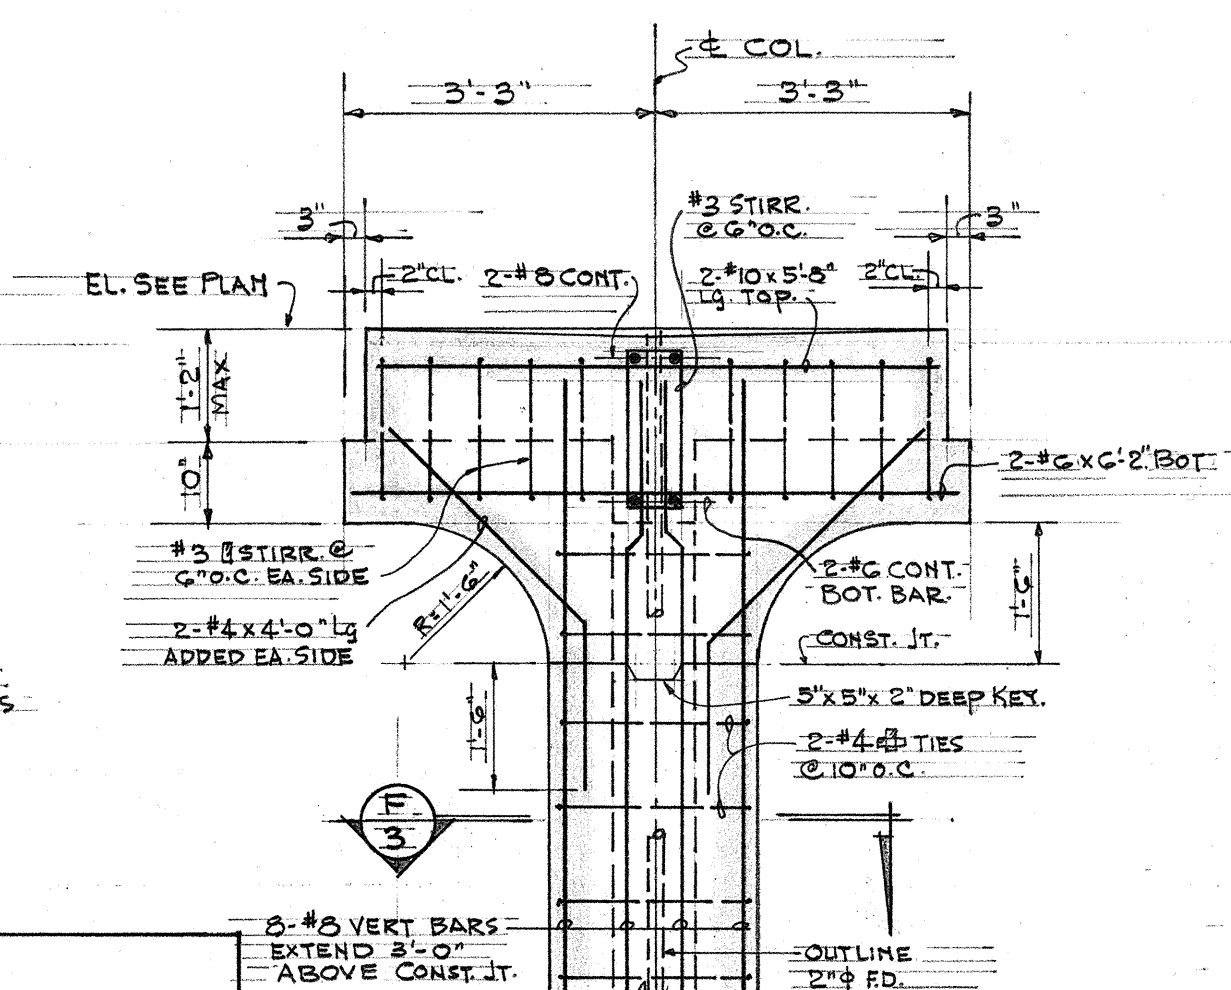


FED. ROAD DIST. NO.	STATE	FED. AID PROJ. NO.	FISCAL YEAR	SHEET NO.	TOTAL SHEETS
HAWAII	HAW.				

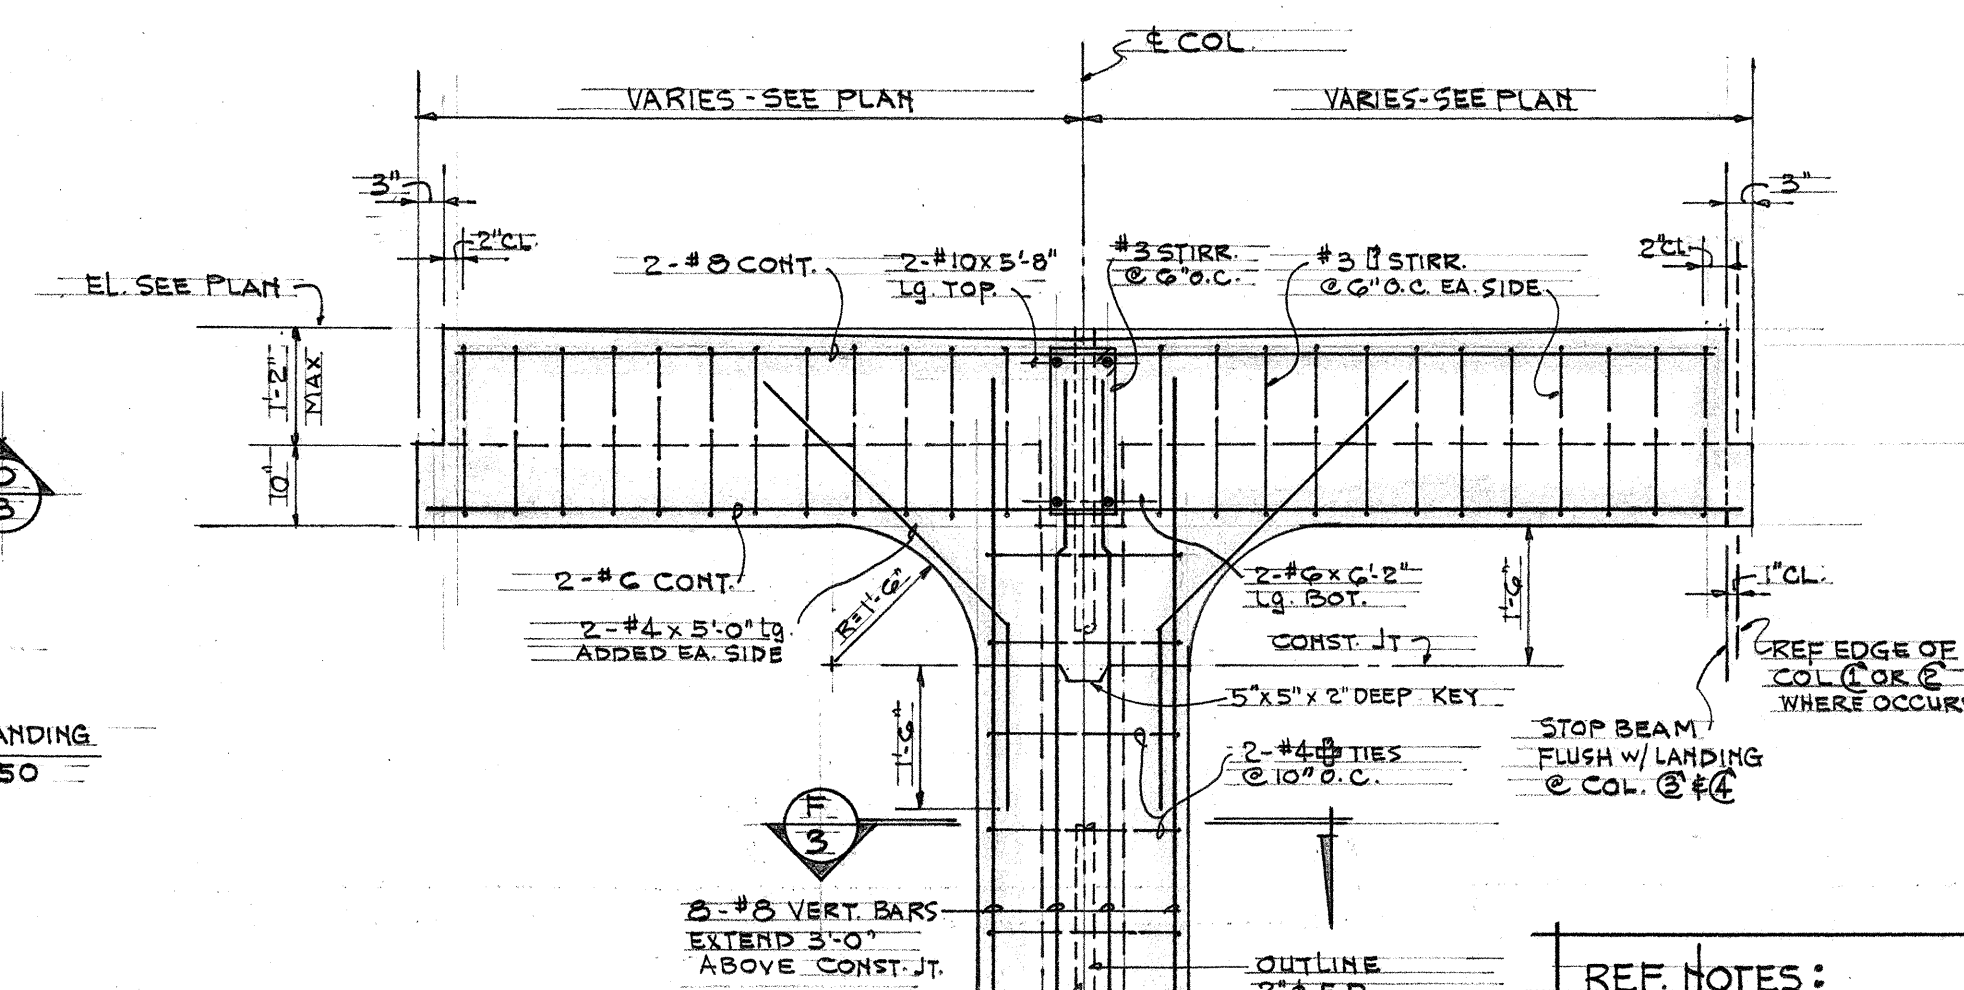

NOTE:
NEOPRENE PAD TO BE INCIDENTAL TO
PRESTRESSED GIRDERS AND WILL
NOT BE PAID FOR SEPARATELY.


TYPICAL COLUMNS (1) & (2) DETAILS SCALE AS NOTED

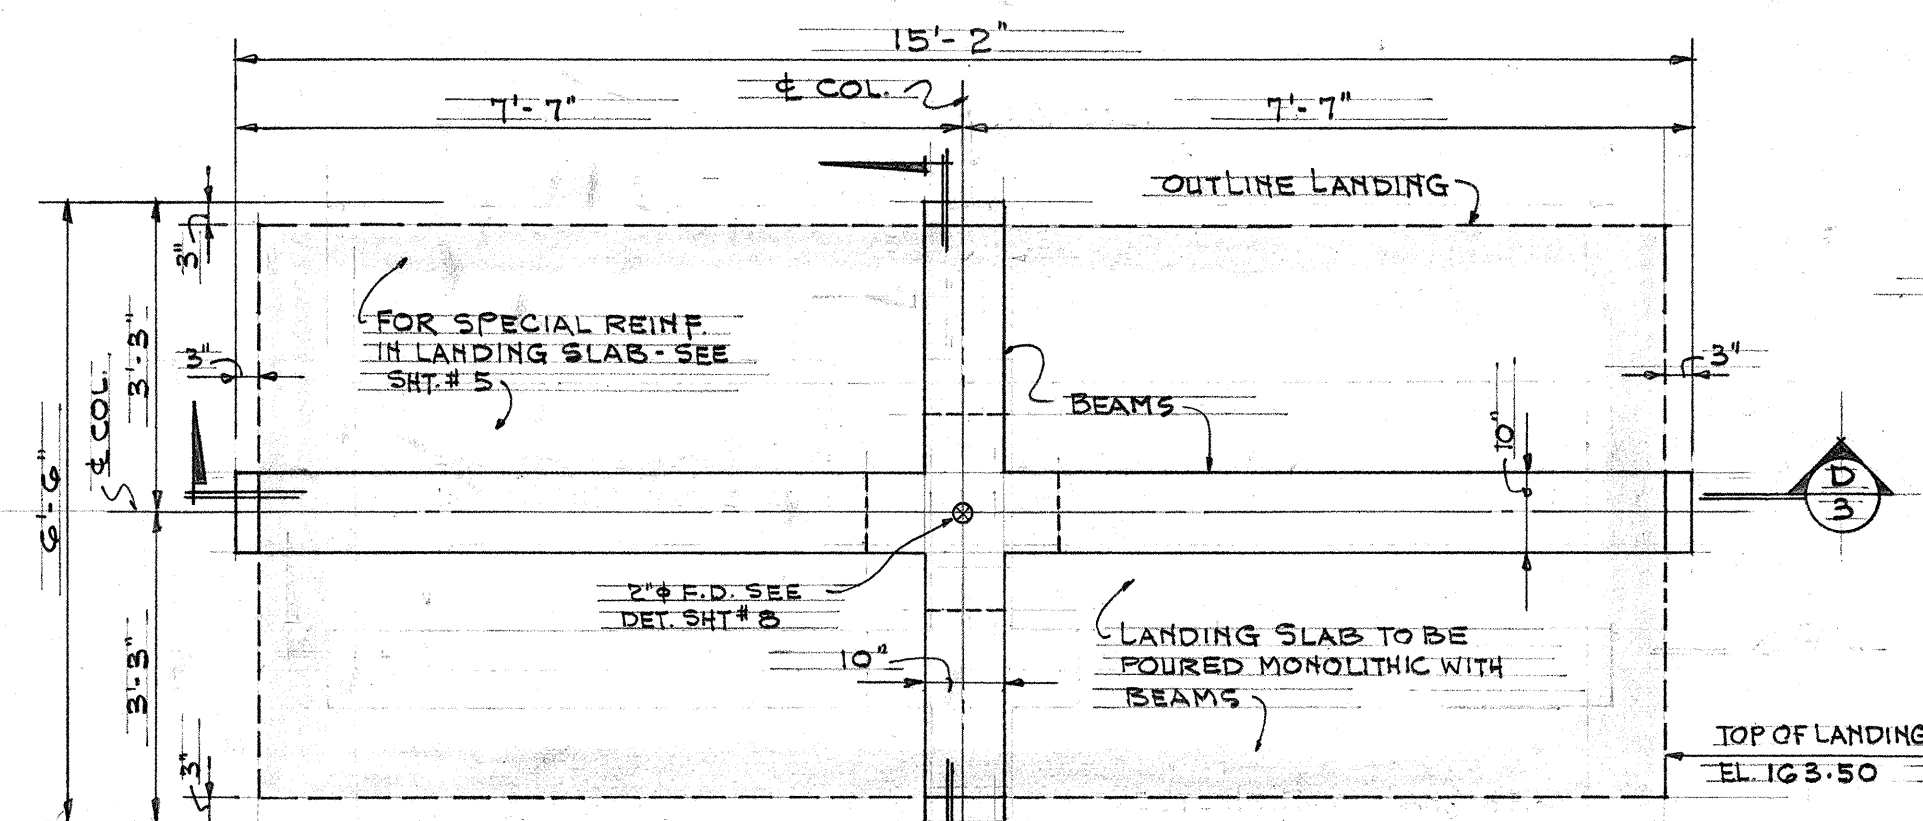


REF. NOTES:

- 1) FOR COL. FTGS. SEE SHT. #2
- 2) FOR ADDITIONAL REINF. & SLOPES
IN RAMPLANDING SEE SHT #5

TYPICAL COLUMNS ③ ④ ⑤ & ⑥ DETAILS SCALE AS NOTED

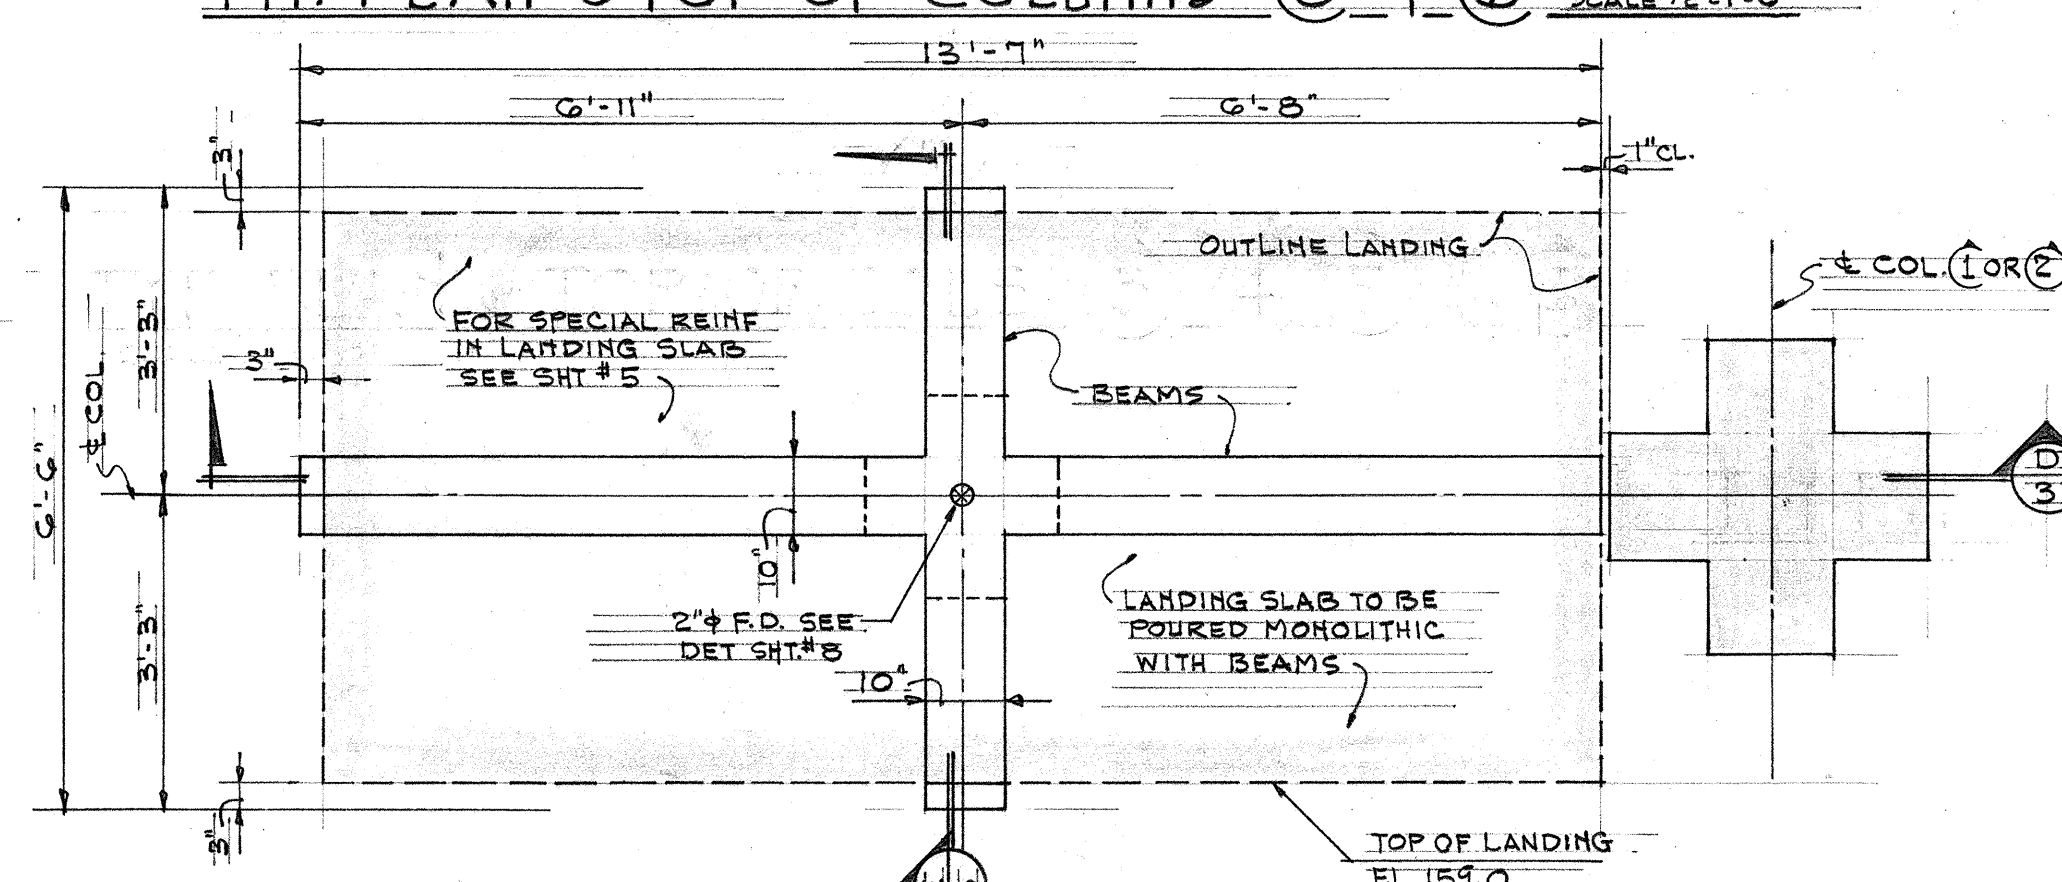

ORIGINAL PLAN	SURVEY PLOTTED BY _____	DATE _____
NOTE BOOK	DRAWN BY K.M.C.	" Nov 66
	TRACED BY K.M.C.	" "
	DESIGNED BY G.M. & P.L.	" "
	QUANTITIES BY K.M. & P.L.	" "
	CHECKED BY G.M.	" "
No. _____		

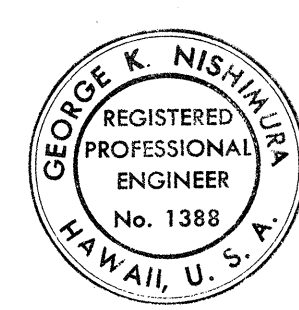

THIS WORK WAS PREPARED BY
ME OR UNDER MY SUPERVISION.

Shay, K. Vickerman

STATE OF HAWAII
DEPARTMENT OF TRANSPORTATION
HIGHWAYS DIVISION

PEDESTRIAN OVERPASS OVER KALANIANA'OLE HIGHWAY

AT ULUPII STREET
KAILUA, OAHU

PROJECT No. 72A-01-67

FEBRUARY, 1967

SHEET No. 3 OF 10 SHEETS