

DIST. NO.	STATE	PROJ. NO.	FISCAL YEAR	SHEET NO.	TOTAL SHEETS
HAWAII	HAW	SD 65-301	1967	6	8
		UNIT 1			

Paved Area: 9956.0 S.F.
 Coral Unit Base: 197.7 C.Y.
 Roadway Exc: 213.2 C.Y.
 Completed 12/12/67

WAIAWA ROAD -
 PEARL CITY (BOB'S BAKERY) ⑥
 2,704 L.F. 2489.0 L.F.

⑤ LEHUA AVENUE
 425 L.F. 365.6 L.F.

Paved Area: 1443.0 S.F.
 Coral Unit Base: 22.5 C.Y.
 Roadway Exc: 14.2 C.Y.
 Completed 12/6/67

KAMEHAMEHA HIGHWAY
 AIEA KAI PLACE - McGREW PT. ④
 800 L.F. 673.4 L.F.


PEARL HARBOR EAST LOCH
 Paved Area: 2639.1 S.F.
 Coral Unit Base: 11.6 C.Y.
 Roadway Exc: 27.1 C.Y.
 Completed 12/24/67

③ HALE ST. MARBLEHEAD DRIVE
 TOWARD MOANALUA ROAD
 800 L.F. 807.1 L.F.

A.C. Roll: 786.1 ft.
 Paved Area: 2831.7 S.F.
 Coral Unit Base: 62.2 C.Y.
 Roadway Exc: 57.8 C.Y.
 Completed 12/13/67

A.C. Roll: 780.7 ft.
 Paved Area: 9270.8 S.F.
 Coral Unit Base: 146.6 C.Y.
 Roadway Exc: 142.6 C.Y.
 Completed 12/21/67

FARRINGTON HIGHWAY - AWAMOKU
 STREET TO NEW WAIPAHU INTER-
 MEDIATE SCHOOL PARKING LOT
 2290 L.F. 2410.2 L.F.

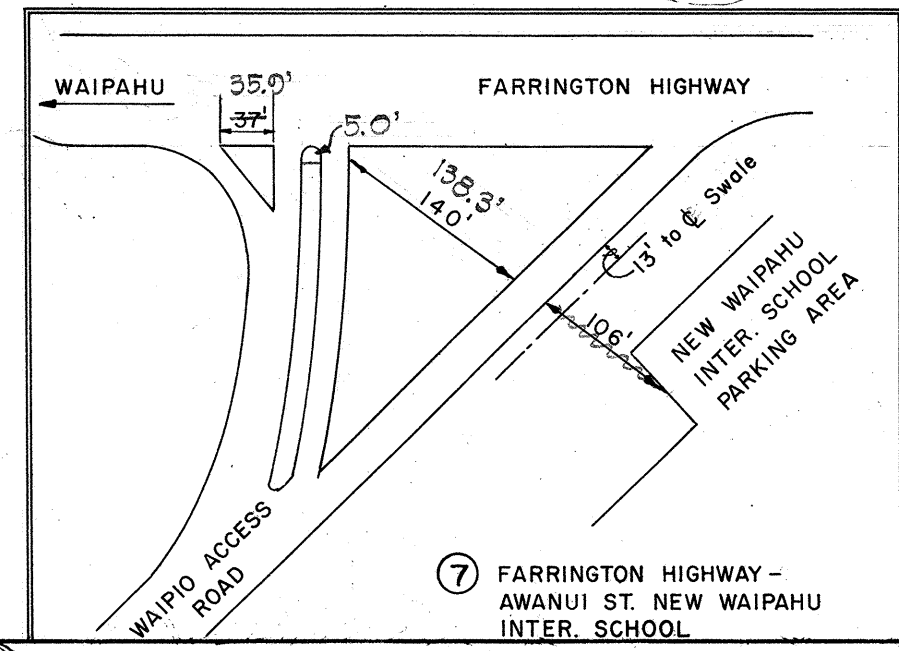

⑦ FARRINGTON HIGHWAY -
 AWAMOKU ST. NEW WAIPAHU
 INTER. SCHOOL

DD-D-8-2