


DIST. NO.	STATE	PROJ. NO.	FISCAL YEAR	SHEET NO.	TOTAL SHEETS
HAWAII	HAW	SD 65-301 UNIT I	1967	8	8

Rev. 9/21/67



PACIFIC

OCEAN

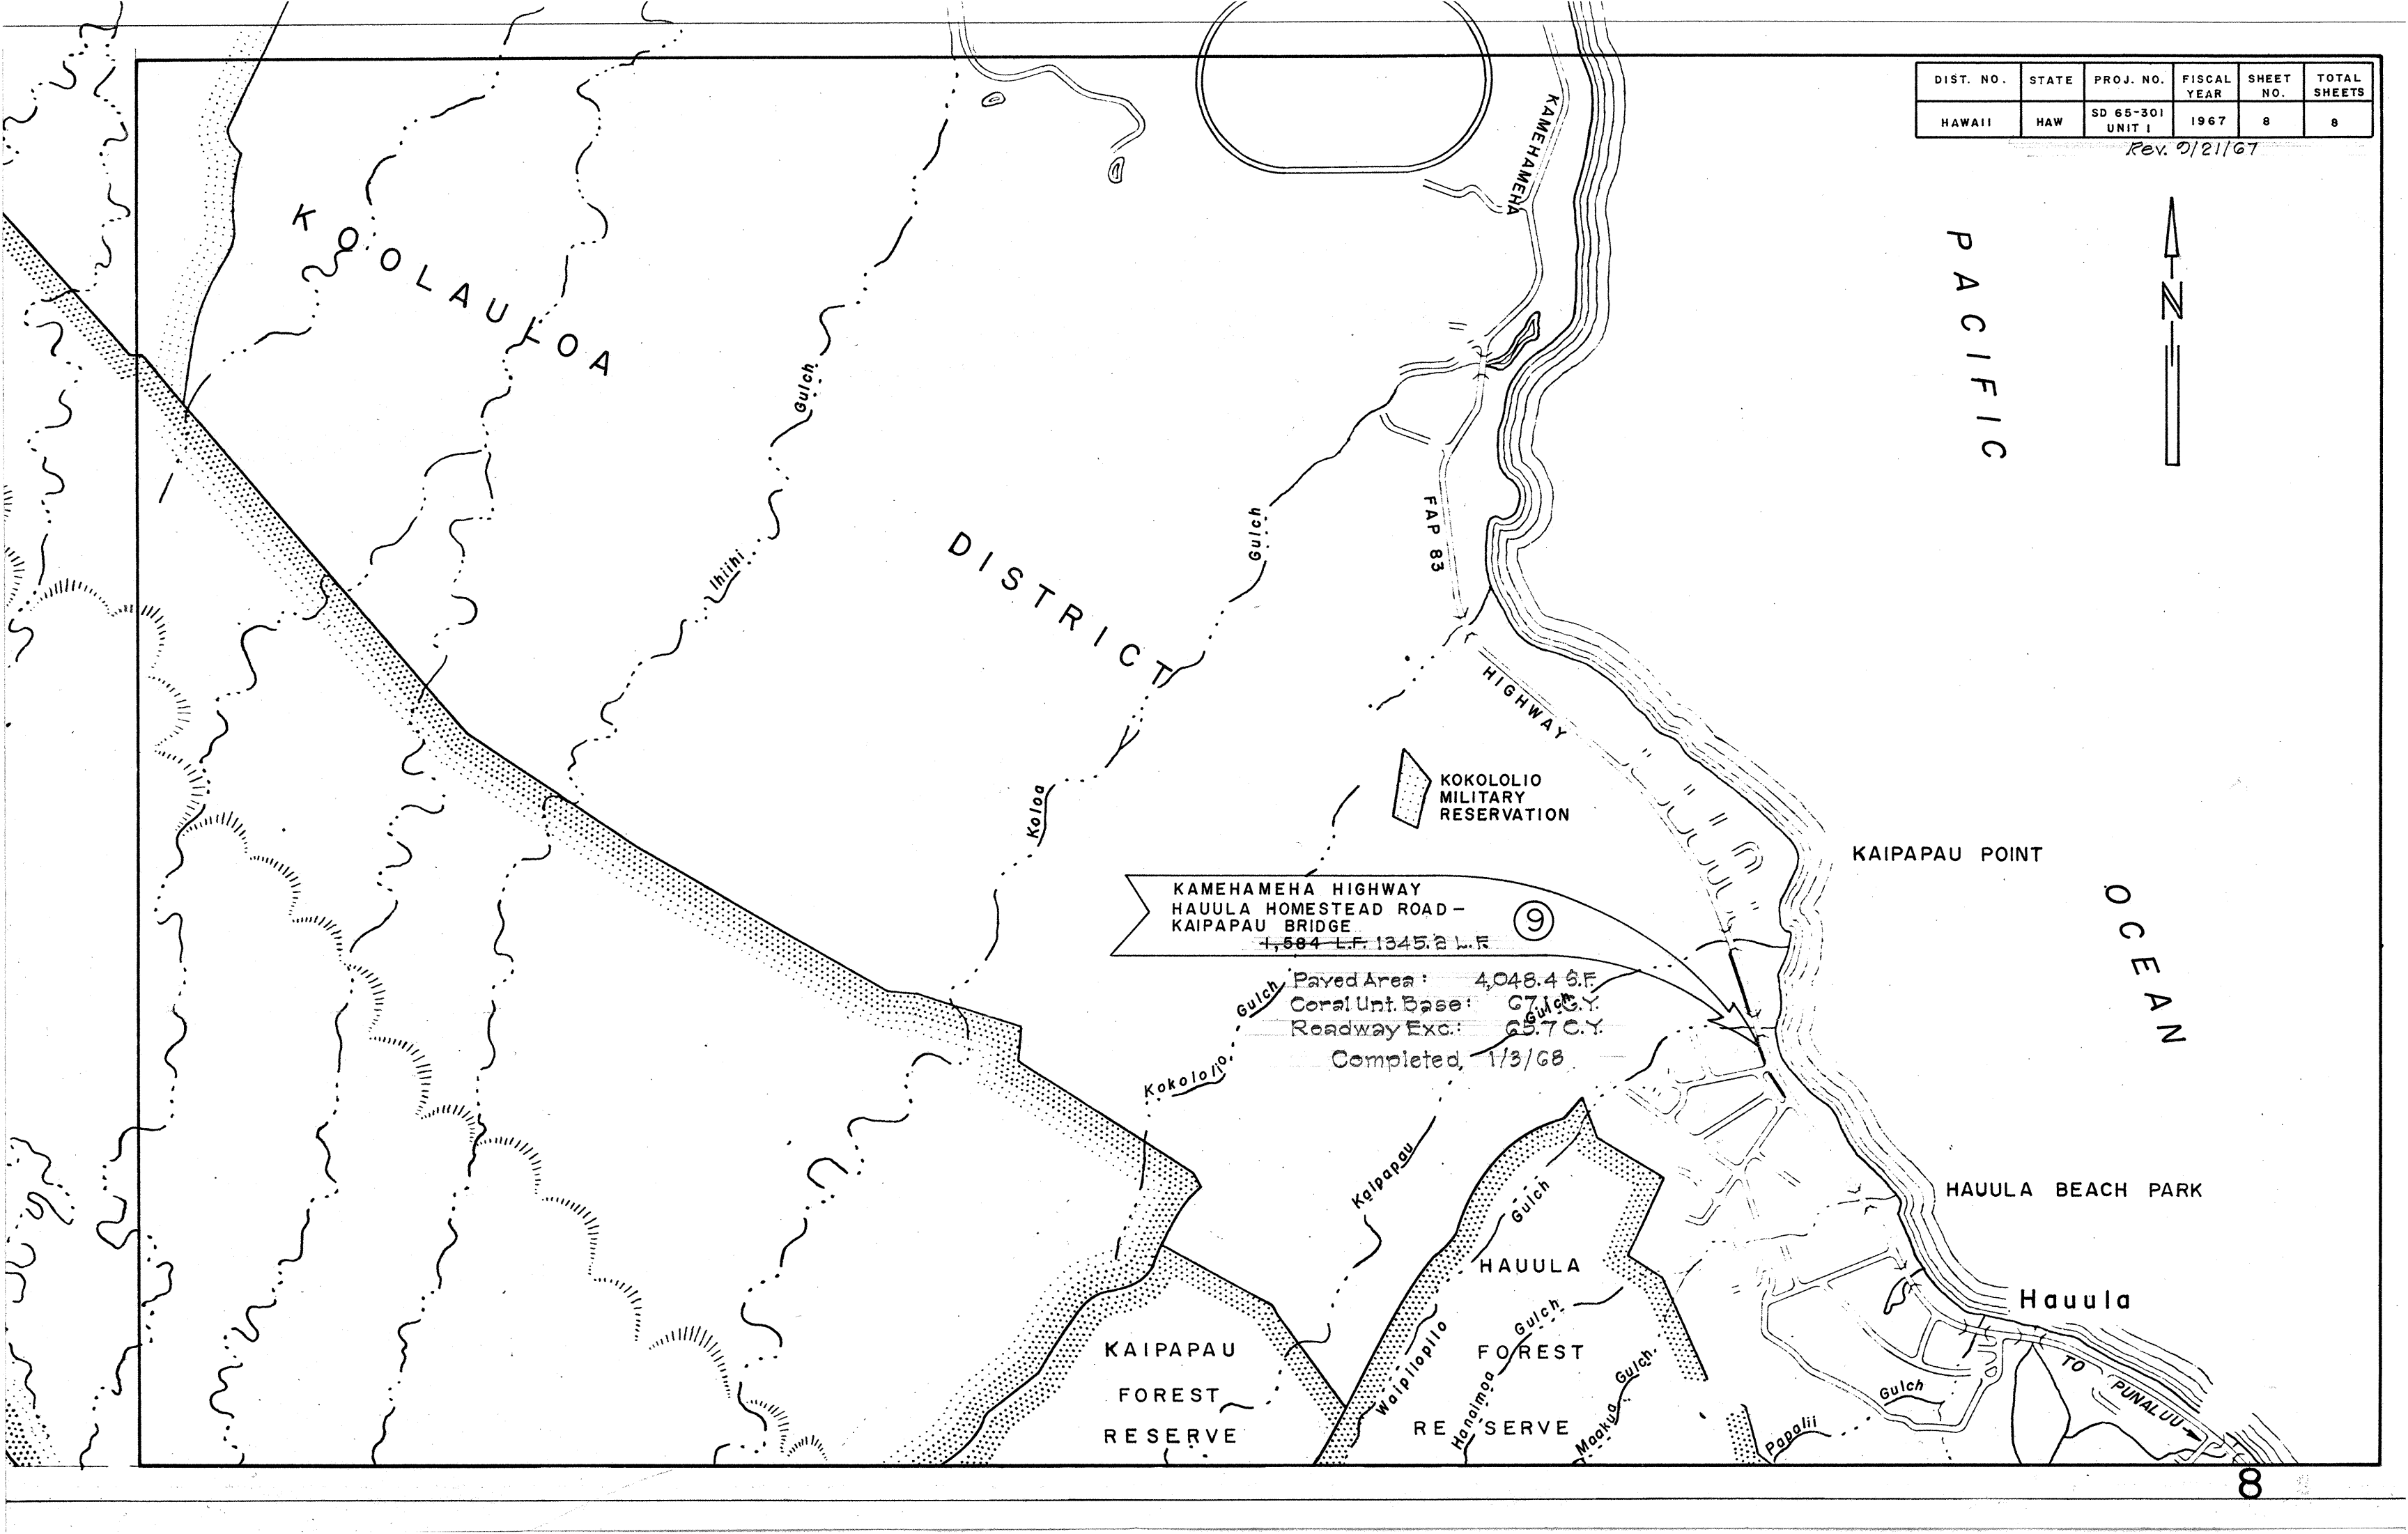

KAMEHAMEHA HIGHWAY
HAUULA HOMESTEAD ROAD -
KAIPAPAU BRIDGE
+584 L.F. 1345.2 L.F.

Paved Area: 4,048.4 S.F.
Coral Unt. Base: 671 C.Y.
Roadway Exc: 65.7 C.Y.
Completed: 1/3/68

KAIPAPAU
FOREST
RESERVE

HAUULA
FOREST
RESERVE

HAUULA BEACH PARK
Hauula

TO PUNALUU