


FED. ROAD DIST. NO.	STATE	PROJ. NO.	FISCAL YEAR	SHEET NO.	TOTAL SHEETS
HAWAII	HAW.	SD 65-301 UNIT 1	1967	4	8

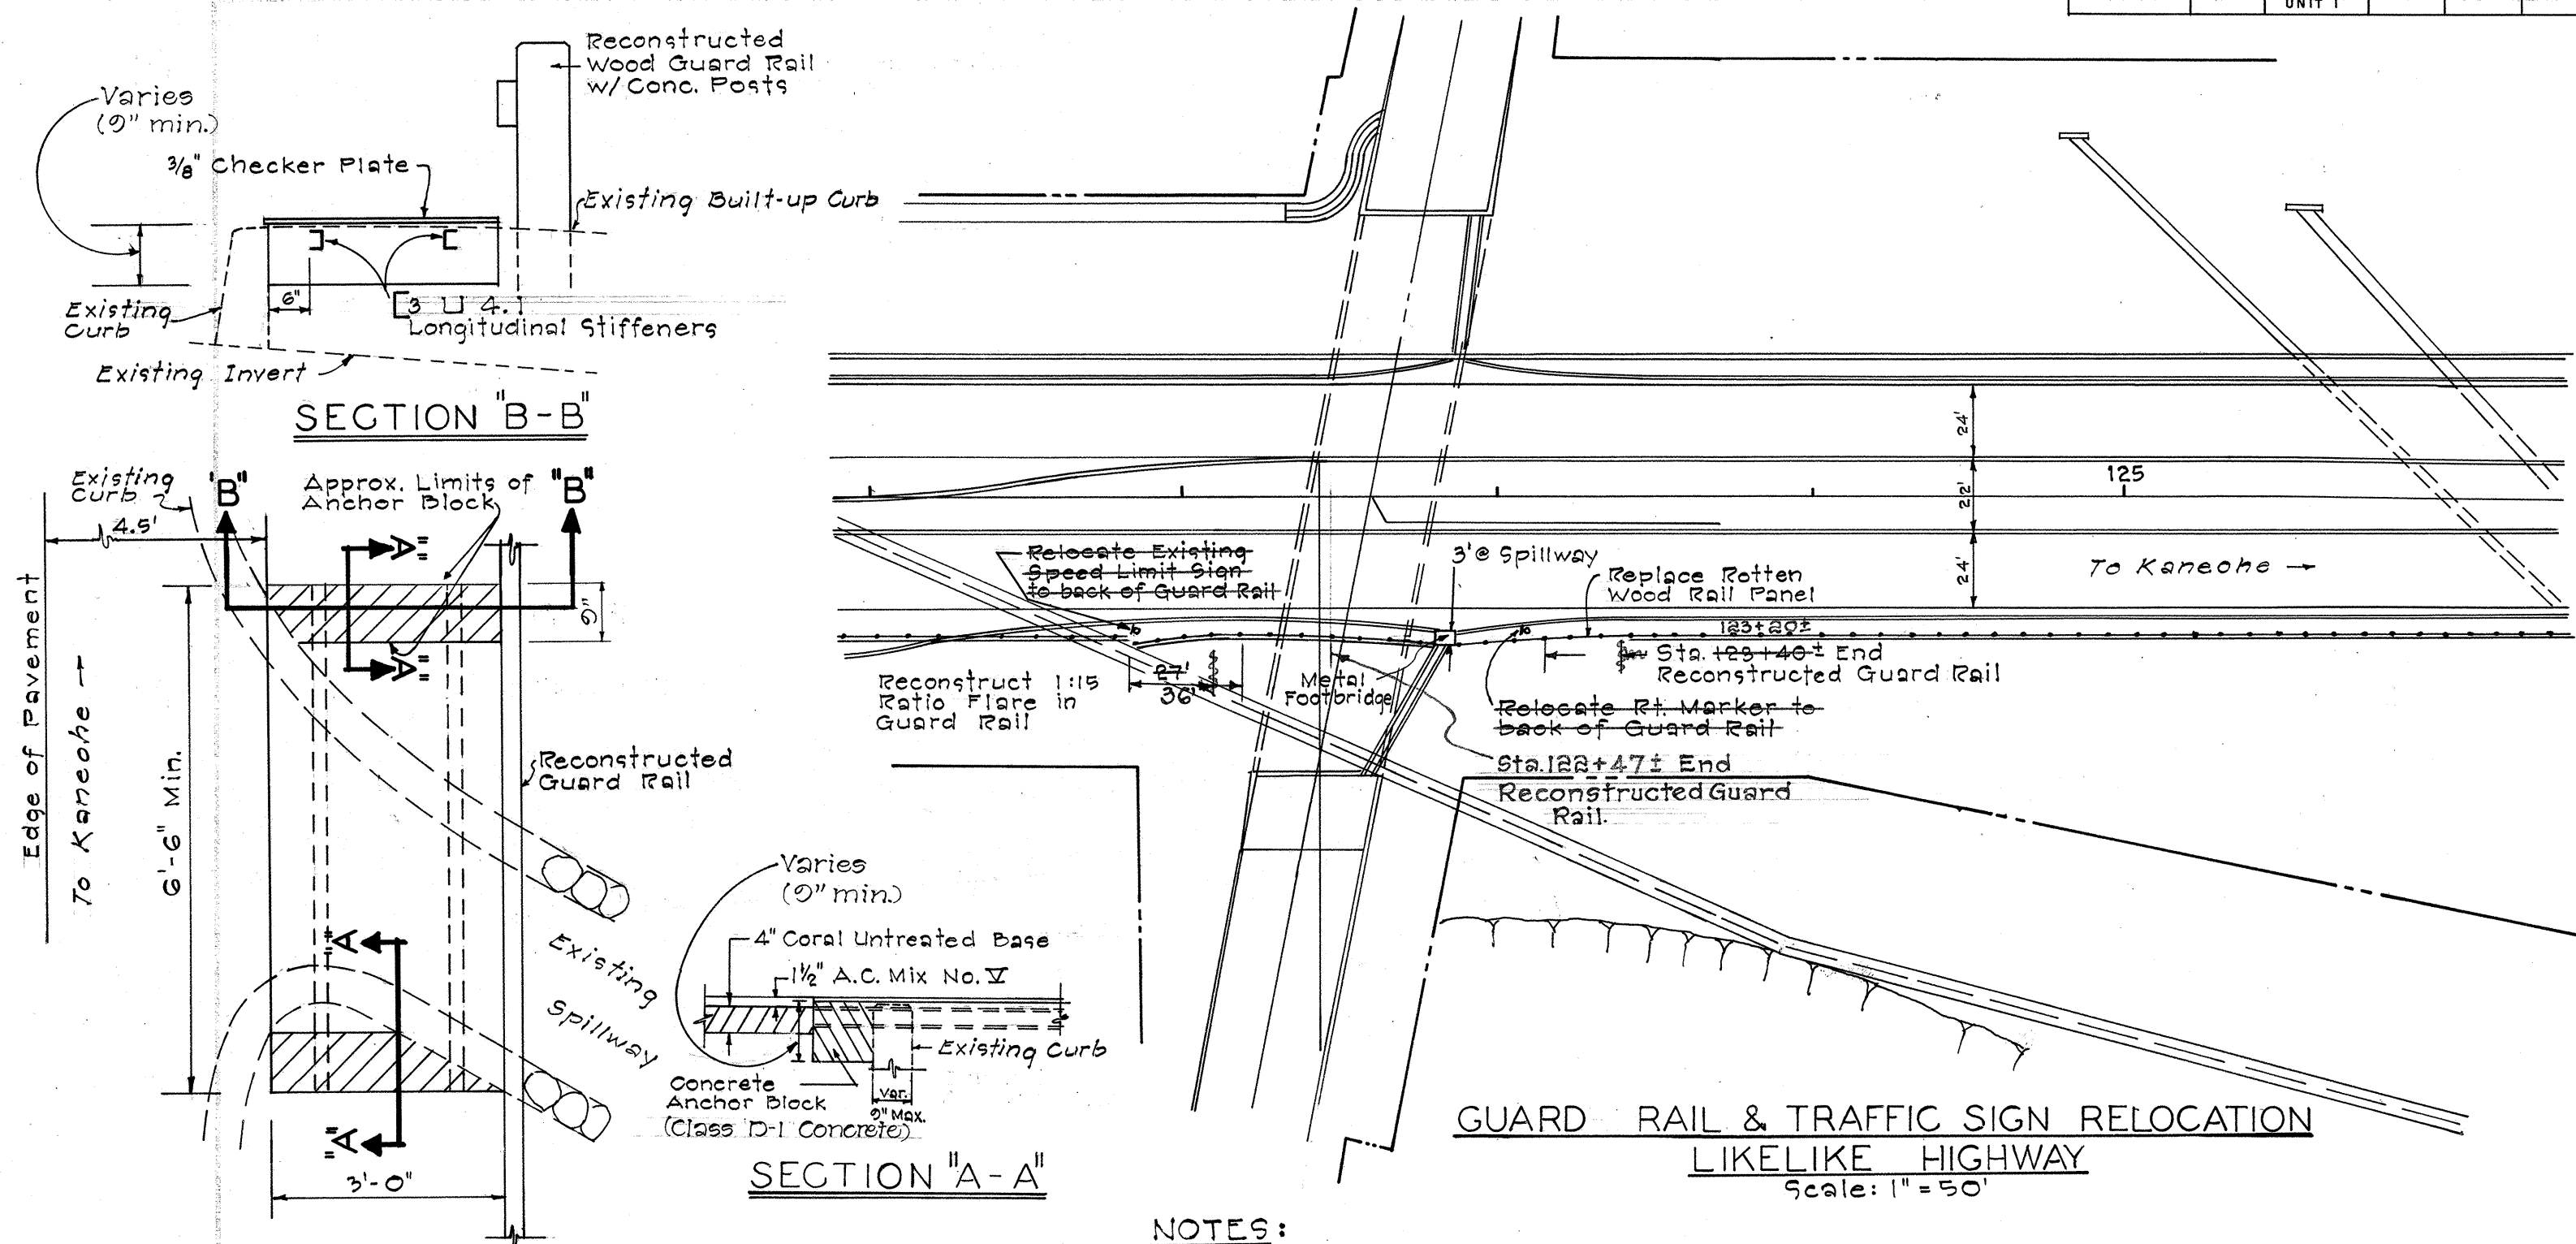

NOTES:

1. Existing Curb shall be broken into to clear channel stiffeners
2. Channels shall be welded to deckplate.
3. Channels shall be grouted or partially cast into the anchor blocks.
4. Exact length of deck plate to be determined in the field.
5. All Metal parts shall be painted with two (2) coats of zinc oxide-zinc dust paint.

FOOTBRIDGE OVER SPILLWAY INLET AT LIKELIKE
 HIGHWAY STA. 122+88 RT.