



FED. ROAD DIST. NO.	STATE	PROJ. NO.	FISCAL YEAR	SHEET NO.	TOTAL SHEETS
HAWAII	HAW.	SD 65-301 UNIT 1	1967	2	8


Rev. 9/21/67

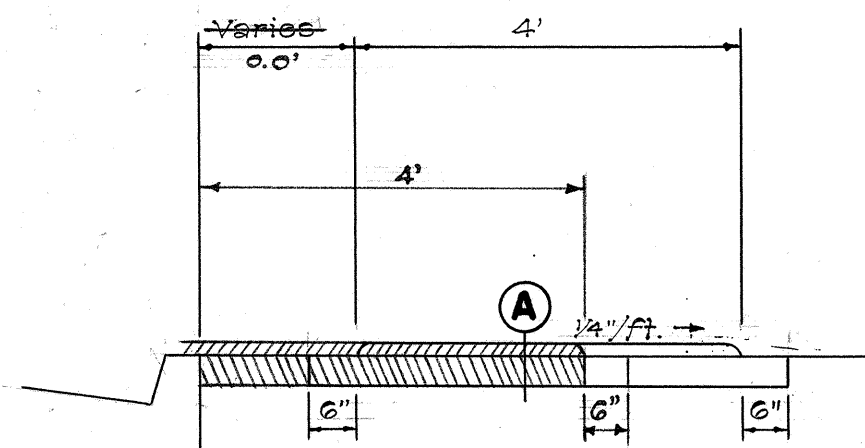


④ KAMEHAMEHA HIGHWAY
AIEA KAI PL. TO MCGREW PT. ACCESS RD.

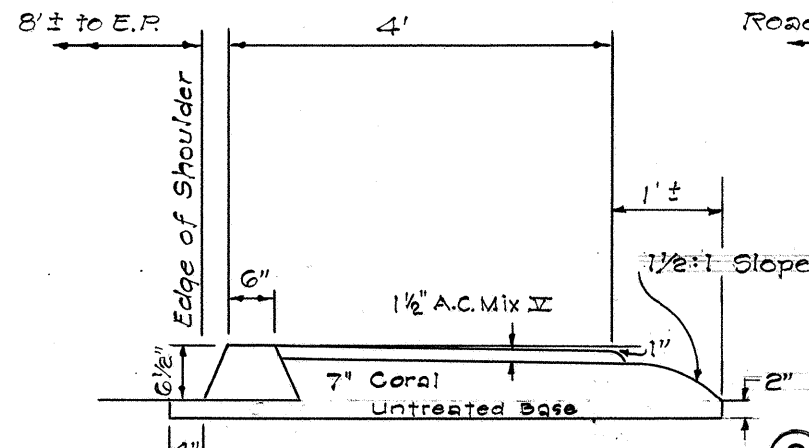


③ HALE STREET
MARBLEHEAD DRIVE
TOWARD MOANALUA ROAD

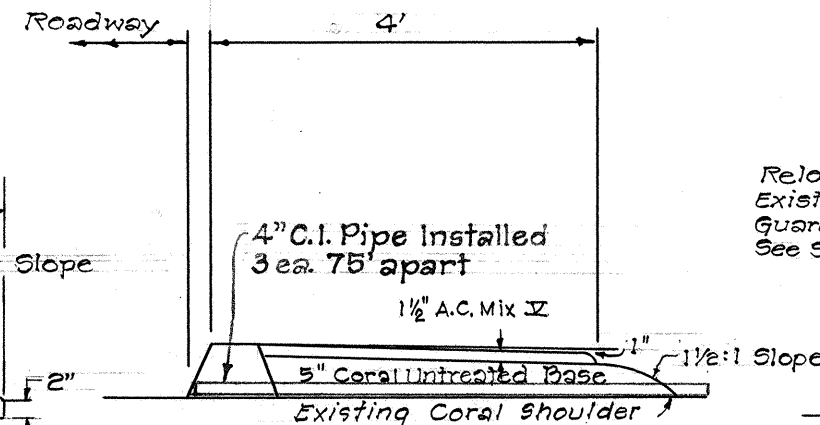


② KALANIANA'OLE HWY. (HAWAII KAI)
(LUNALILO HOME RD. TOWARD HONOLULU)
MAUKA

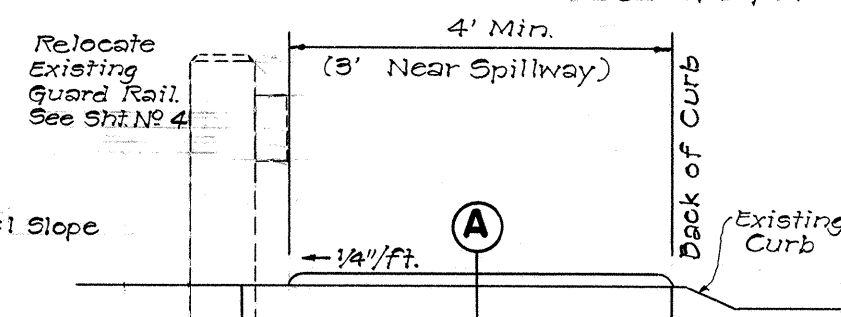


① LIKELIKE HIGHWAY
ANOI RD. TO KAM HWY.

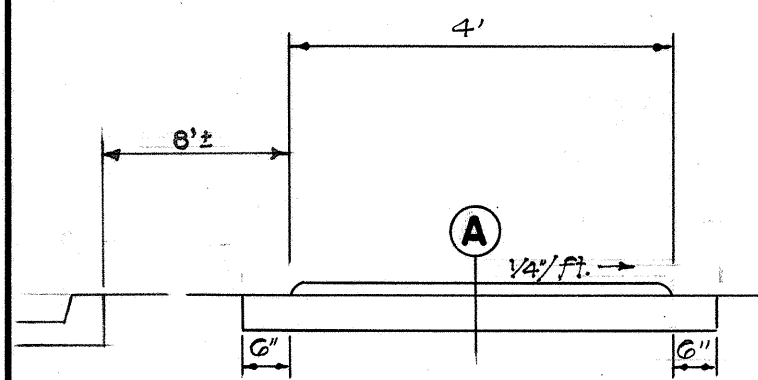


⑧ WILIKINA DRIVE
LAKEVIEW TO WILSON BR.

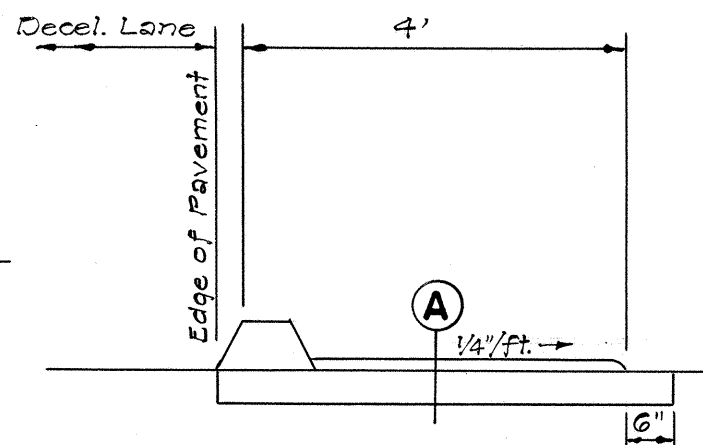


⑦ FARRINGTON HIGHWAY AT
DECELERATION LANE, WAIPIO ACCESS RD.

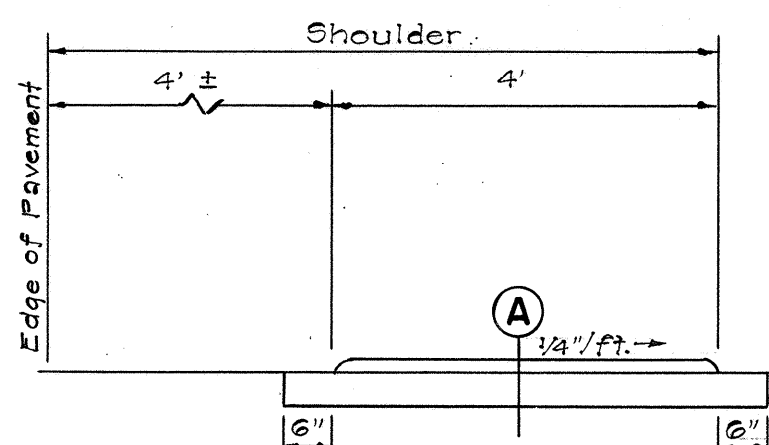


⑥ WAIAWA ROAD TO
NAVY WAREHOUSE AREA-UNCURBED AREA

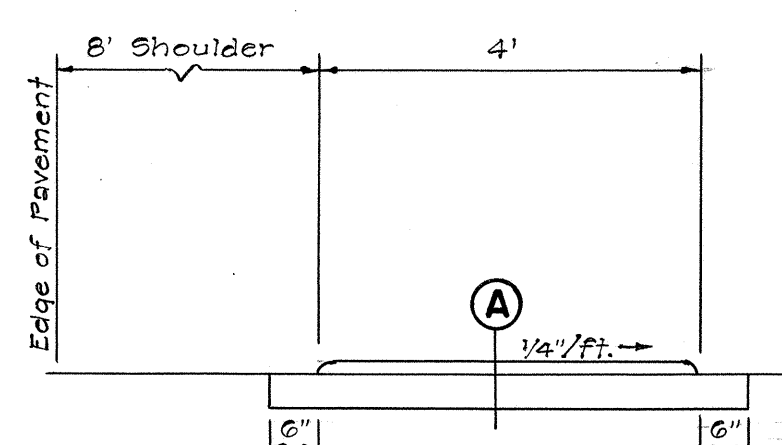


⑤ LEHUA AVENUE
PEARL CITY KAI SCHOOL - MAUKA
TO THIRD STREET

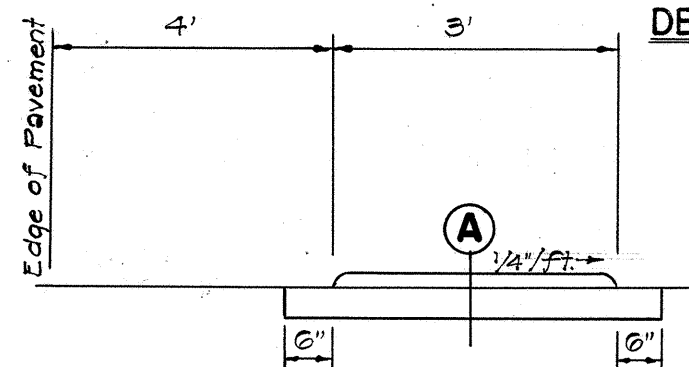


⑨ KAMEHAMEHA HIGHWAY
HAUULA HOMESTEAD ROAD
TO KAIPAPAU BRIDGE

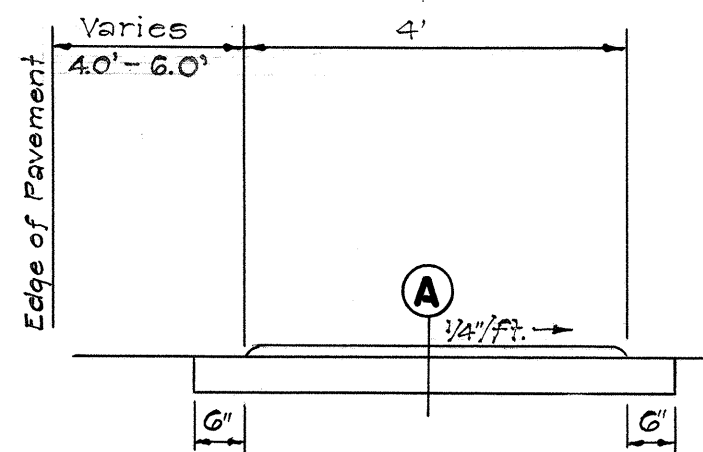

⑦ FARRINGTON HIGHWAY
AWAMOKU STREET TO NEW
WAIPAHU INTERMEDIATE
SCHOOL PARKING LOT

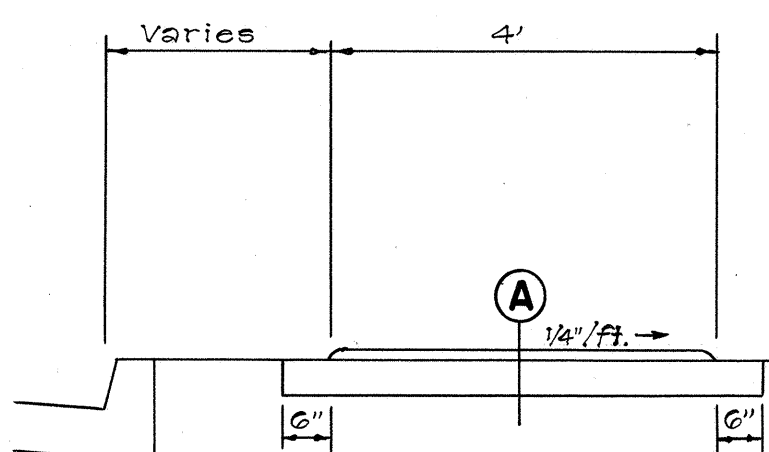

⑥ NAVY WAREHOUSE AREA
TO PEARL CITY - CURBED AREA

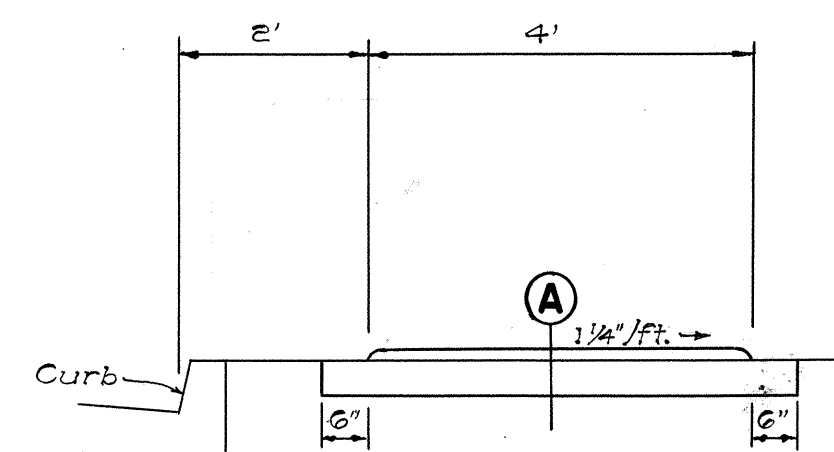

⑤ LEHUA AVENUE
AT CURBED SECTIONS
TYPICAL SECTIONS
NOT TO SCALE

