




FED. ROAD DIST. NO.	STATE	PROJ. NO.	FISCAL YEAR	SHEET NO.	TOTAL SHEETS
HAWAII	HAW.	72B-02-68	1968	8	13

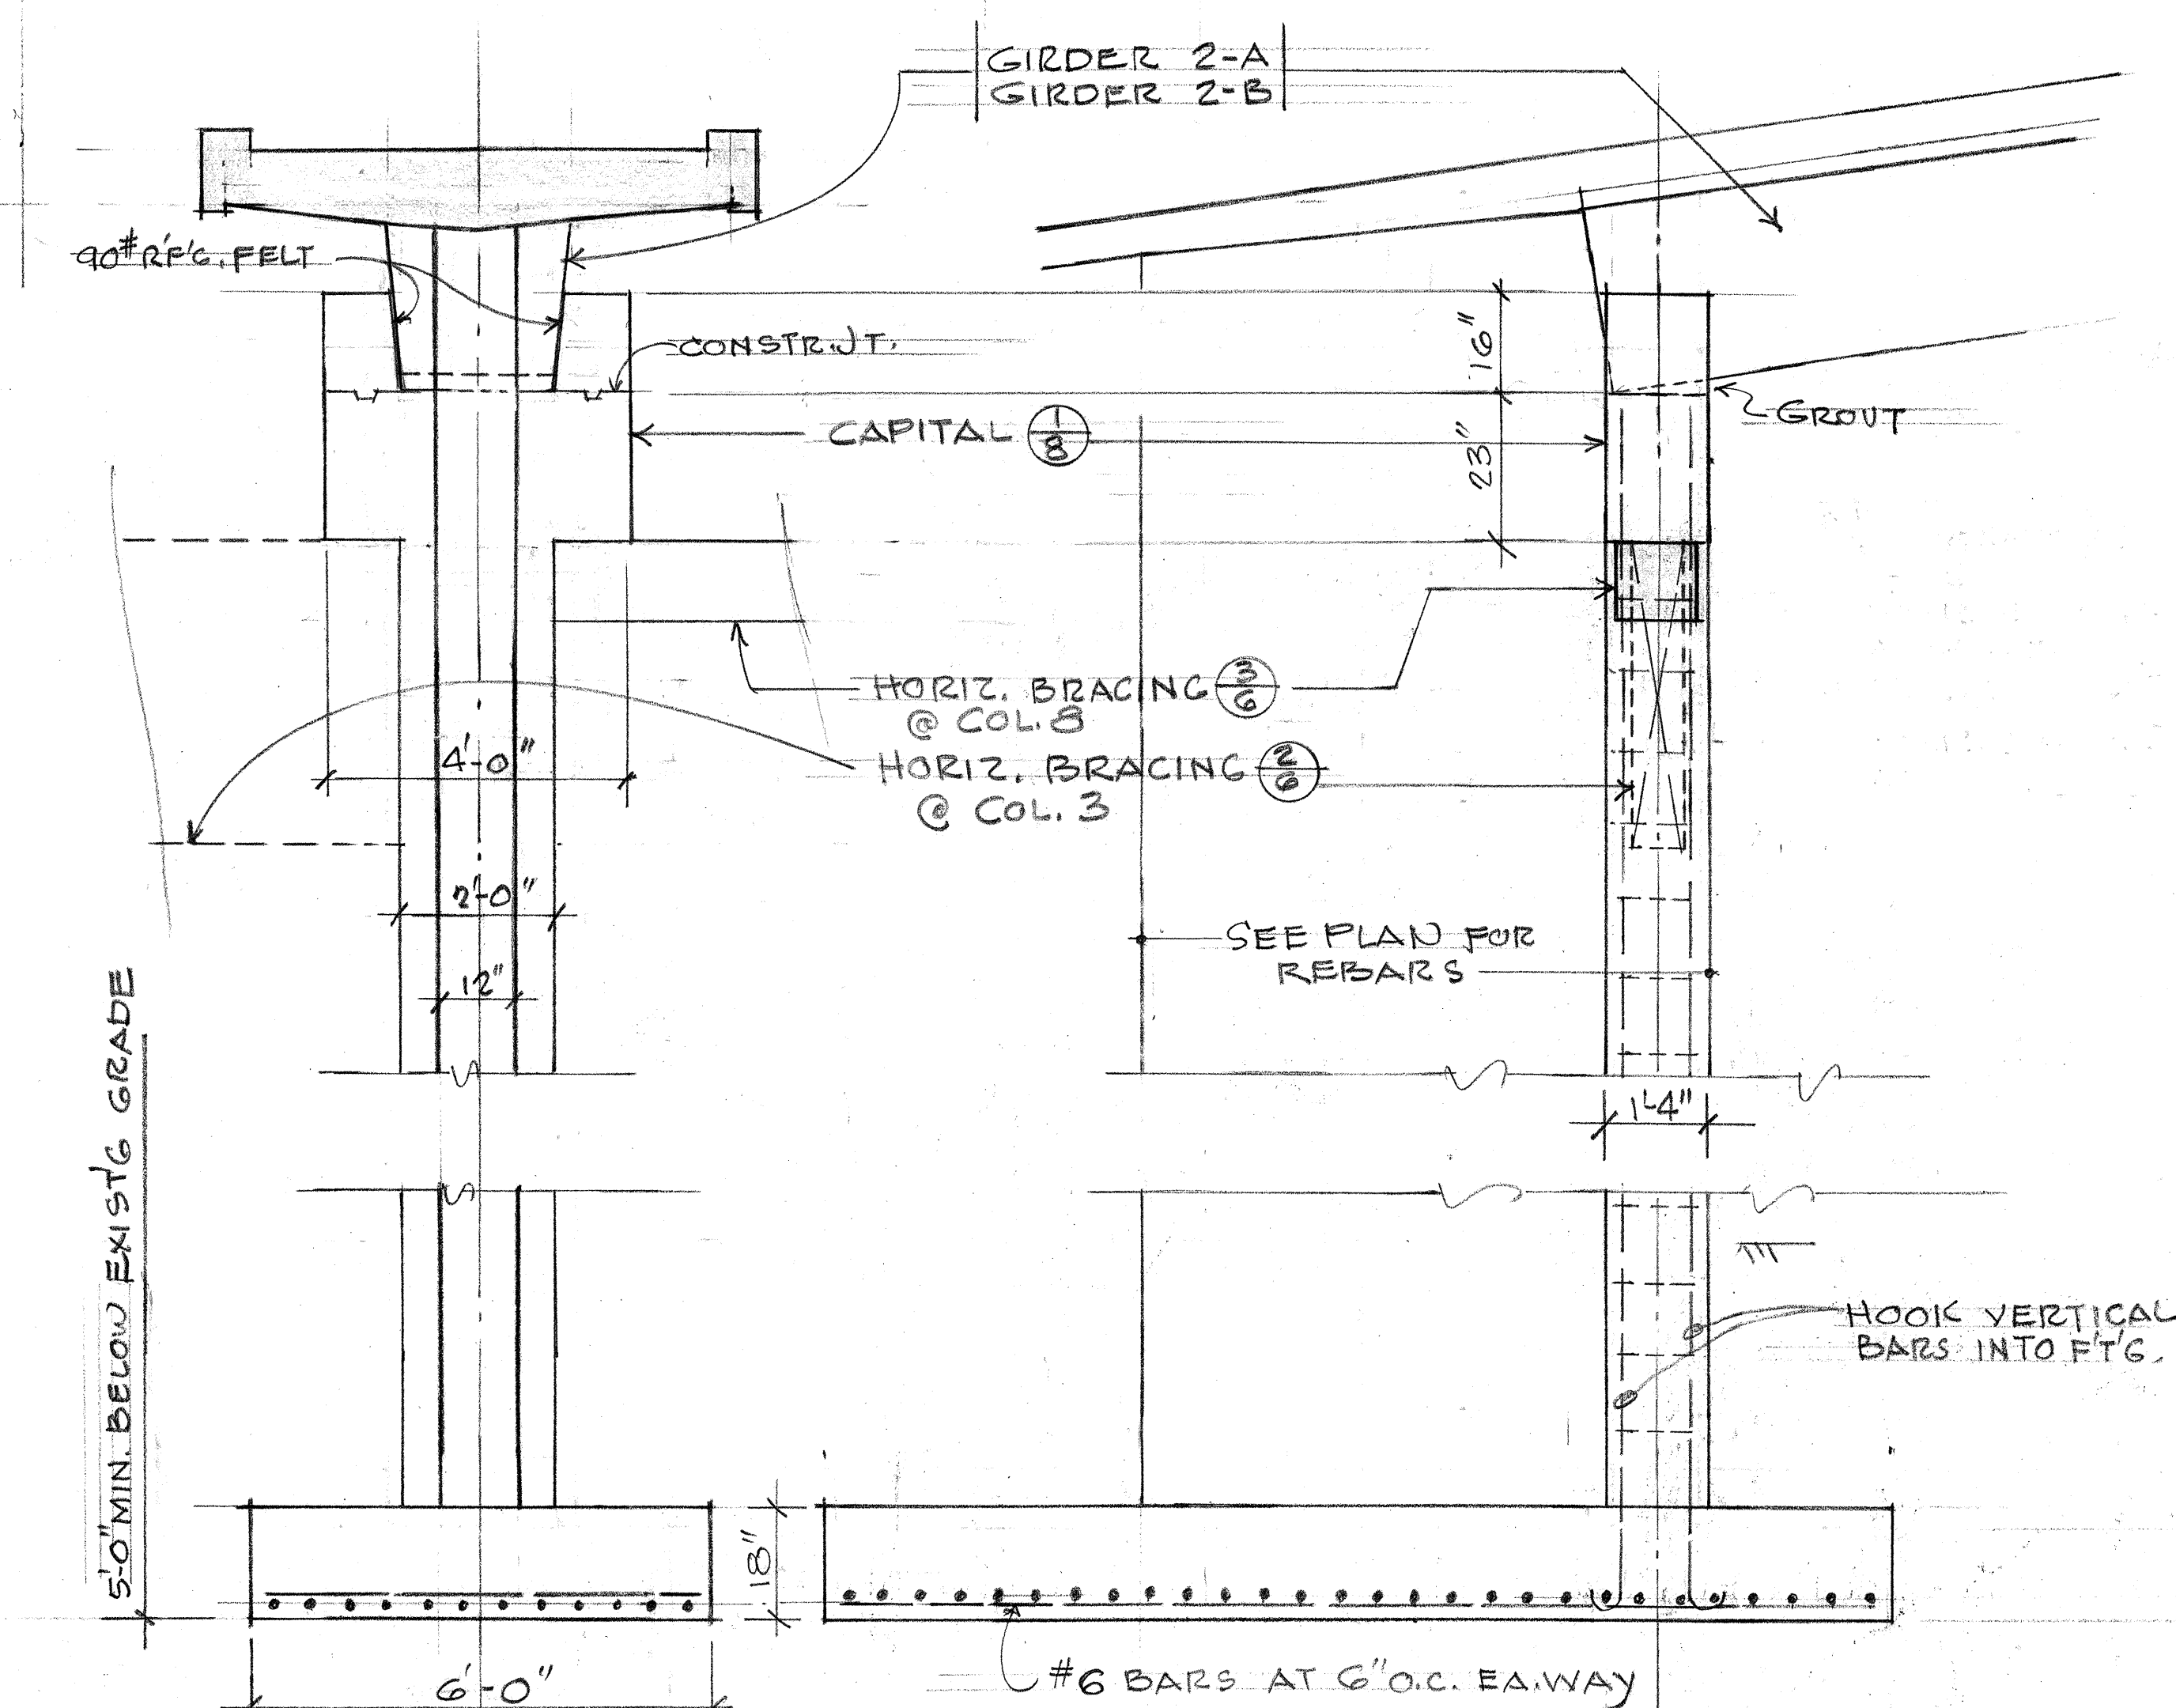


COLUMN & FOOTING
AT 3 & 8 SCALE: 1/2"=1'-0"

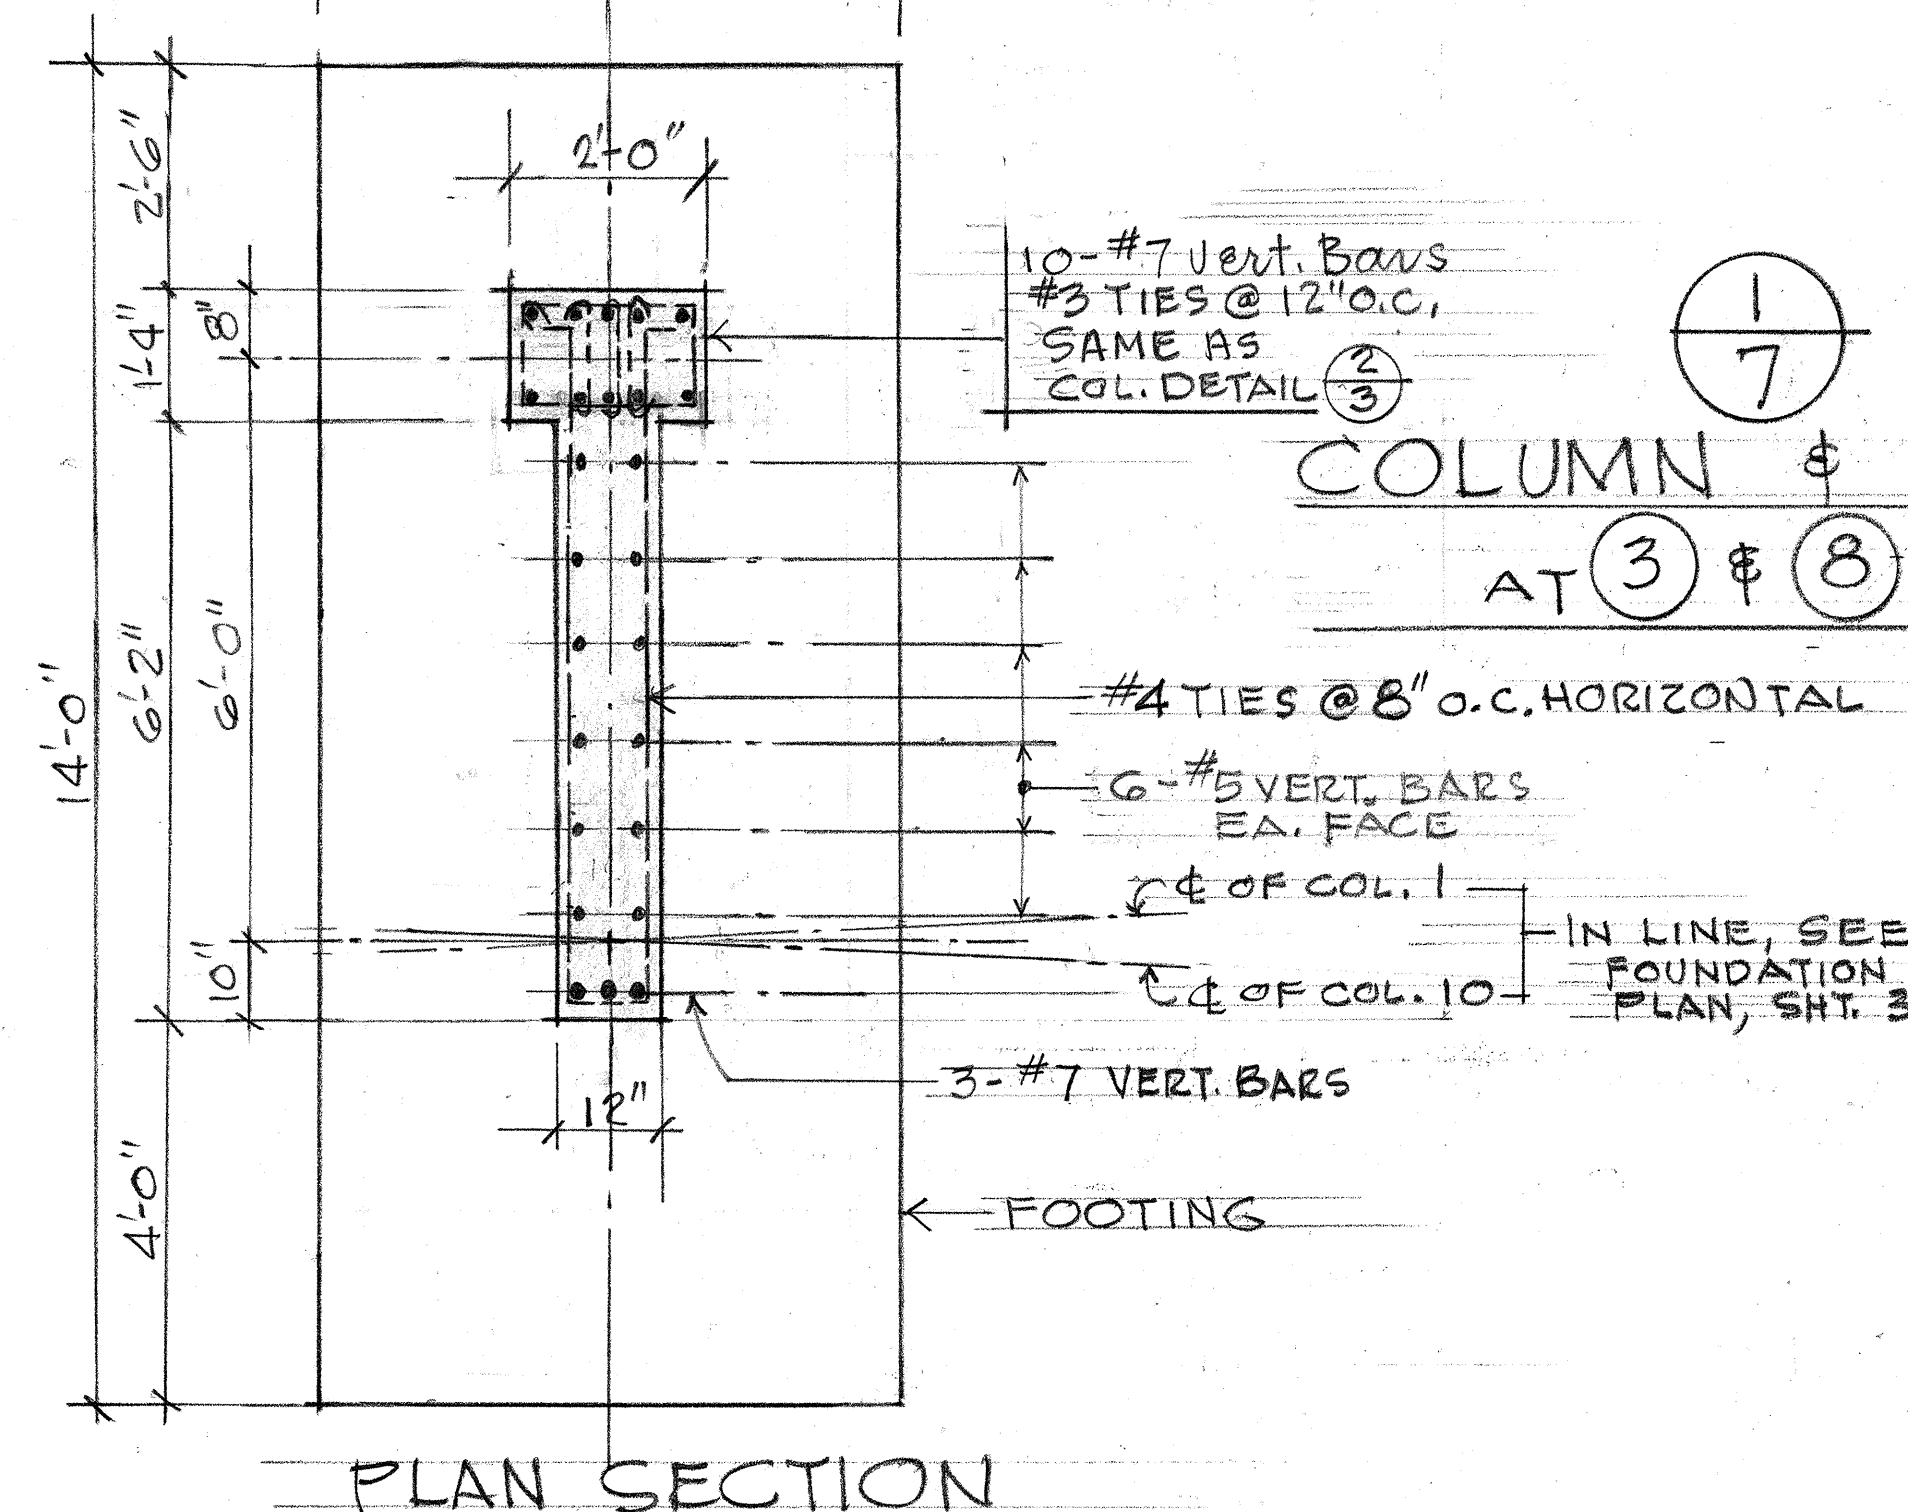

PLAN SECTION

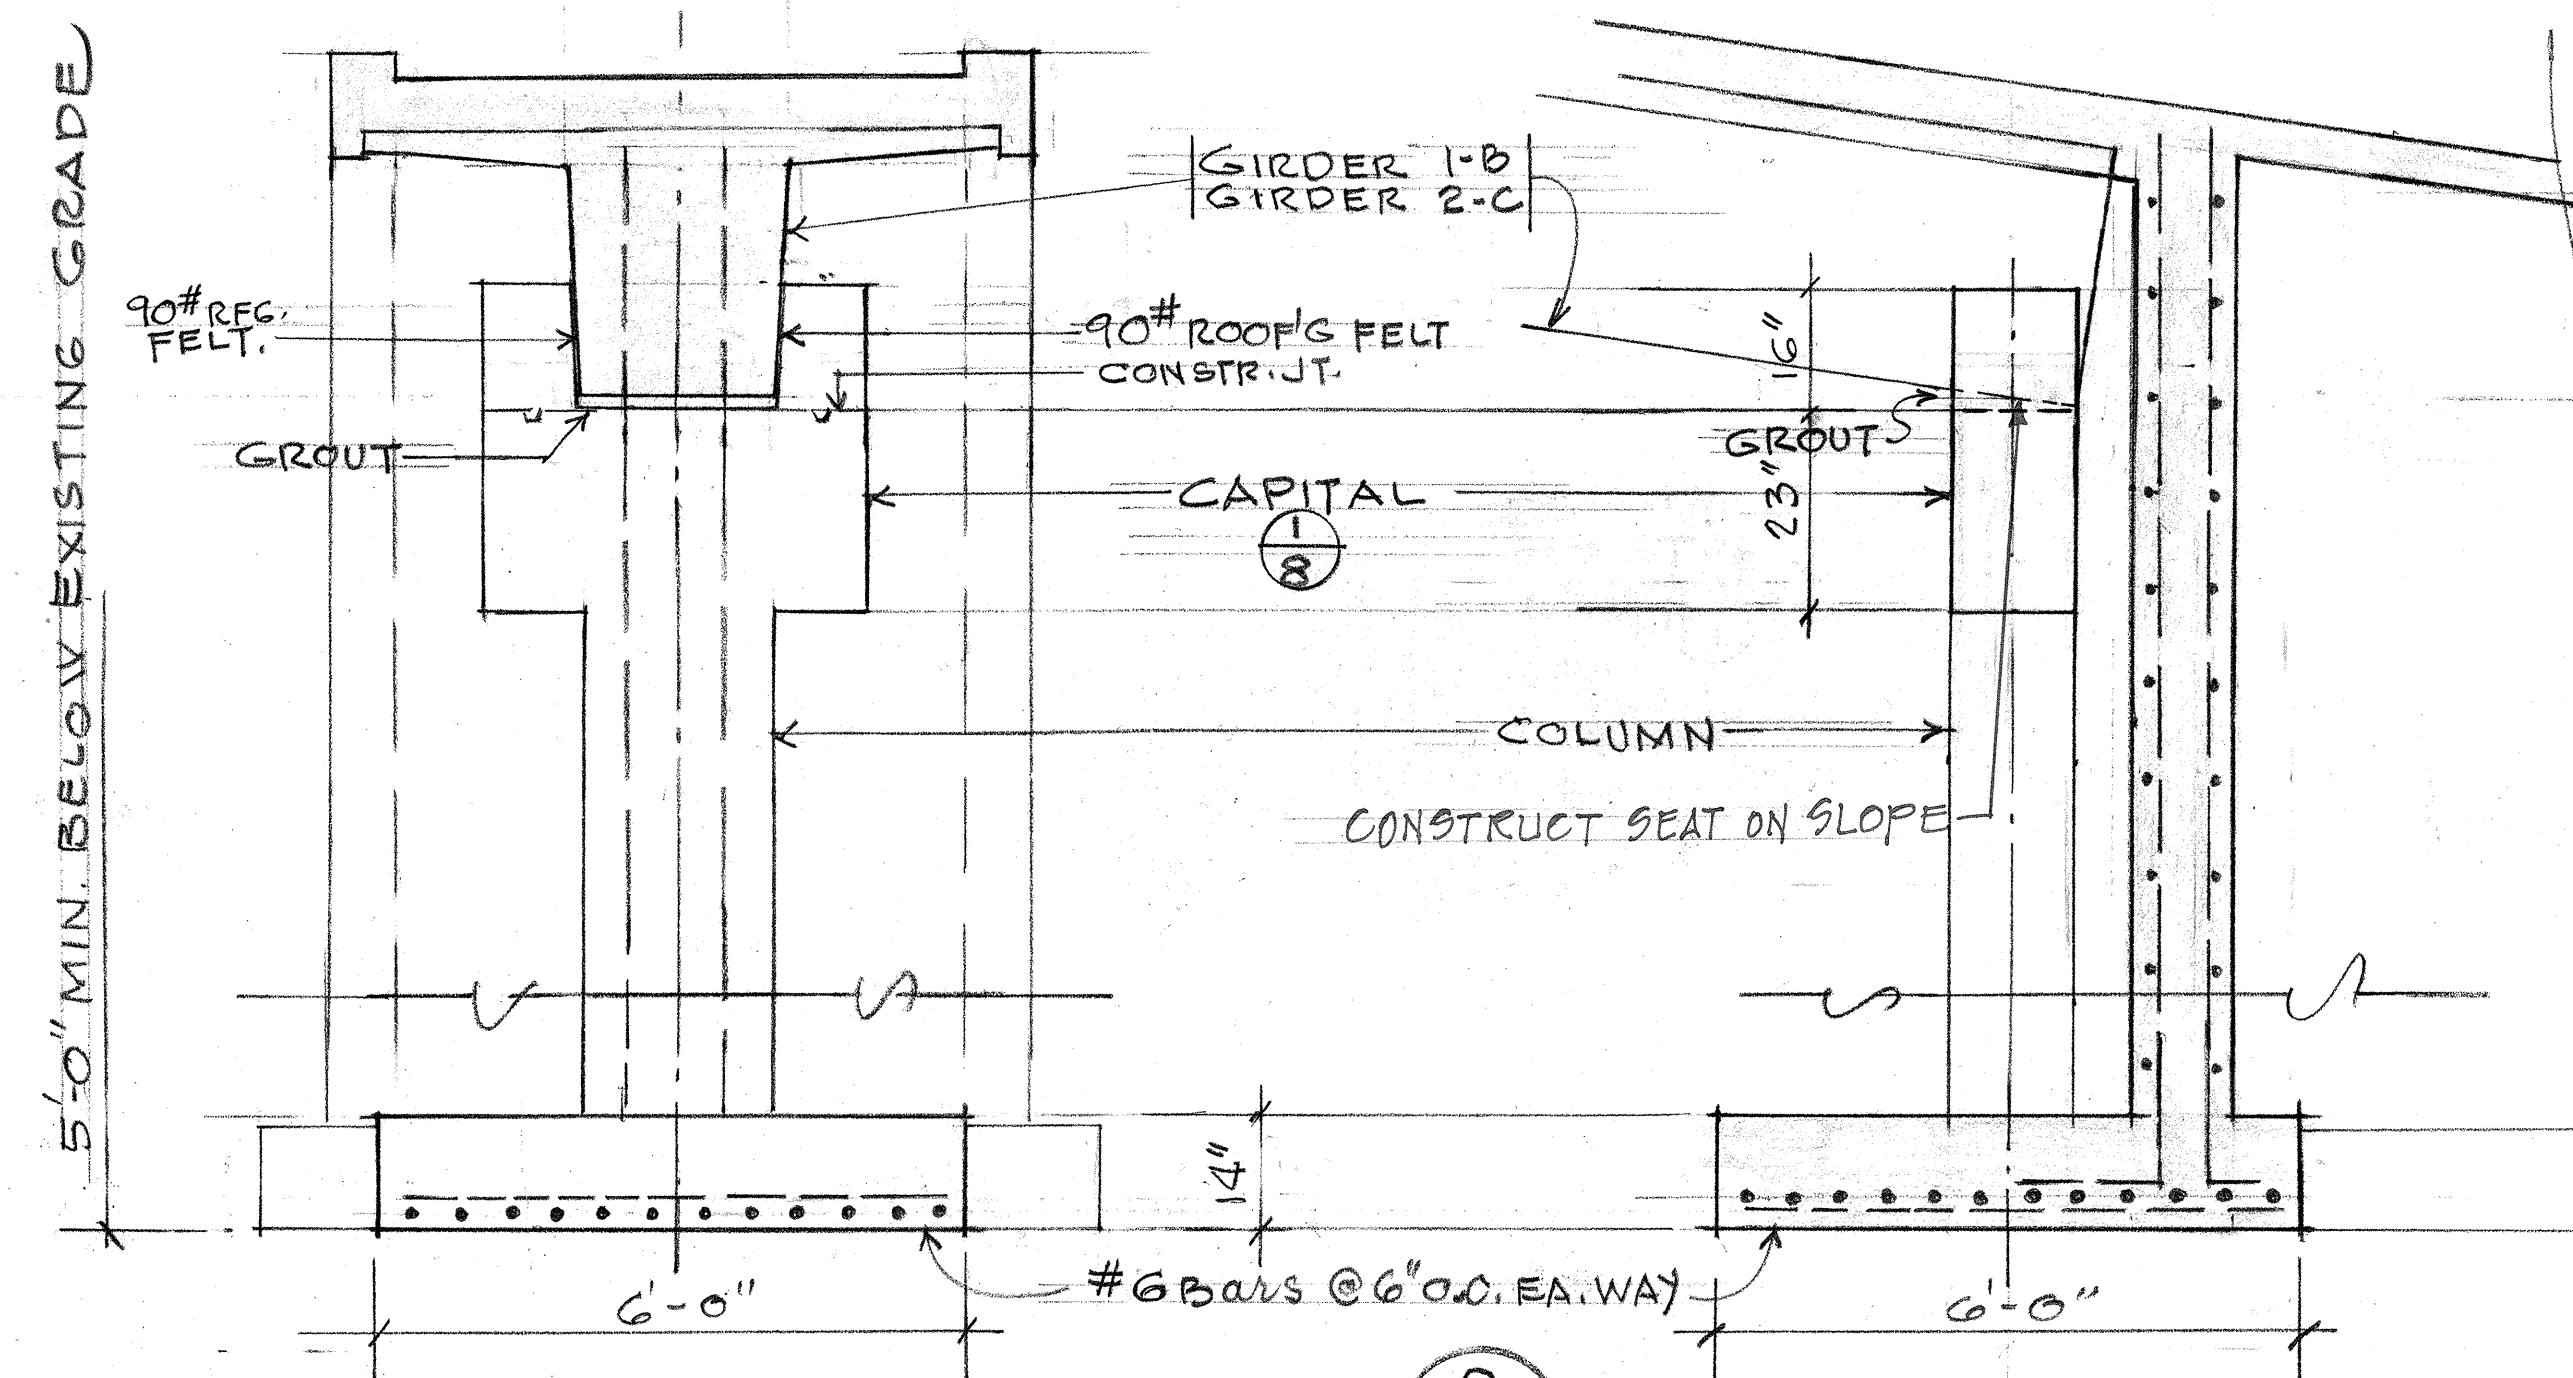


SECTION A-A
COLUMN & FOOTING
AT 11 & 12 SCALE: 1/2"=1'-0"
SEE 7 FOR REINFORCING

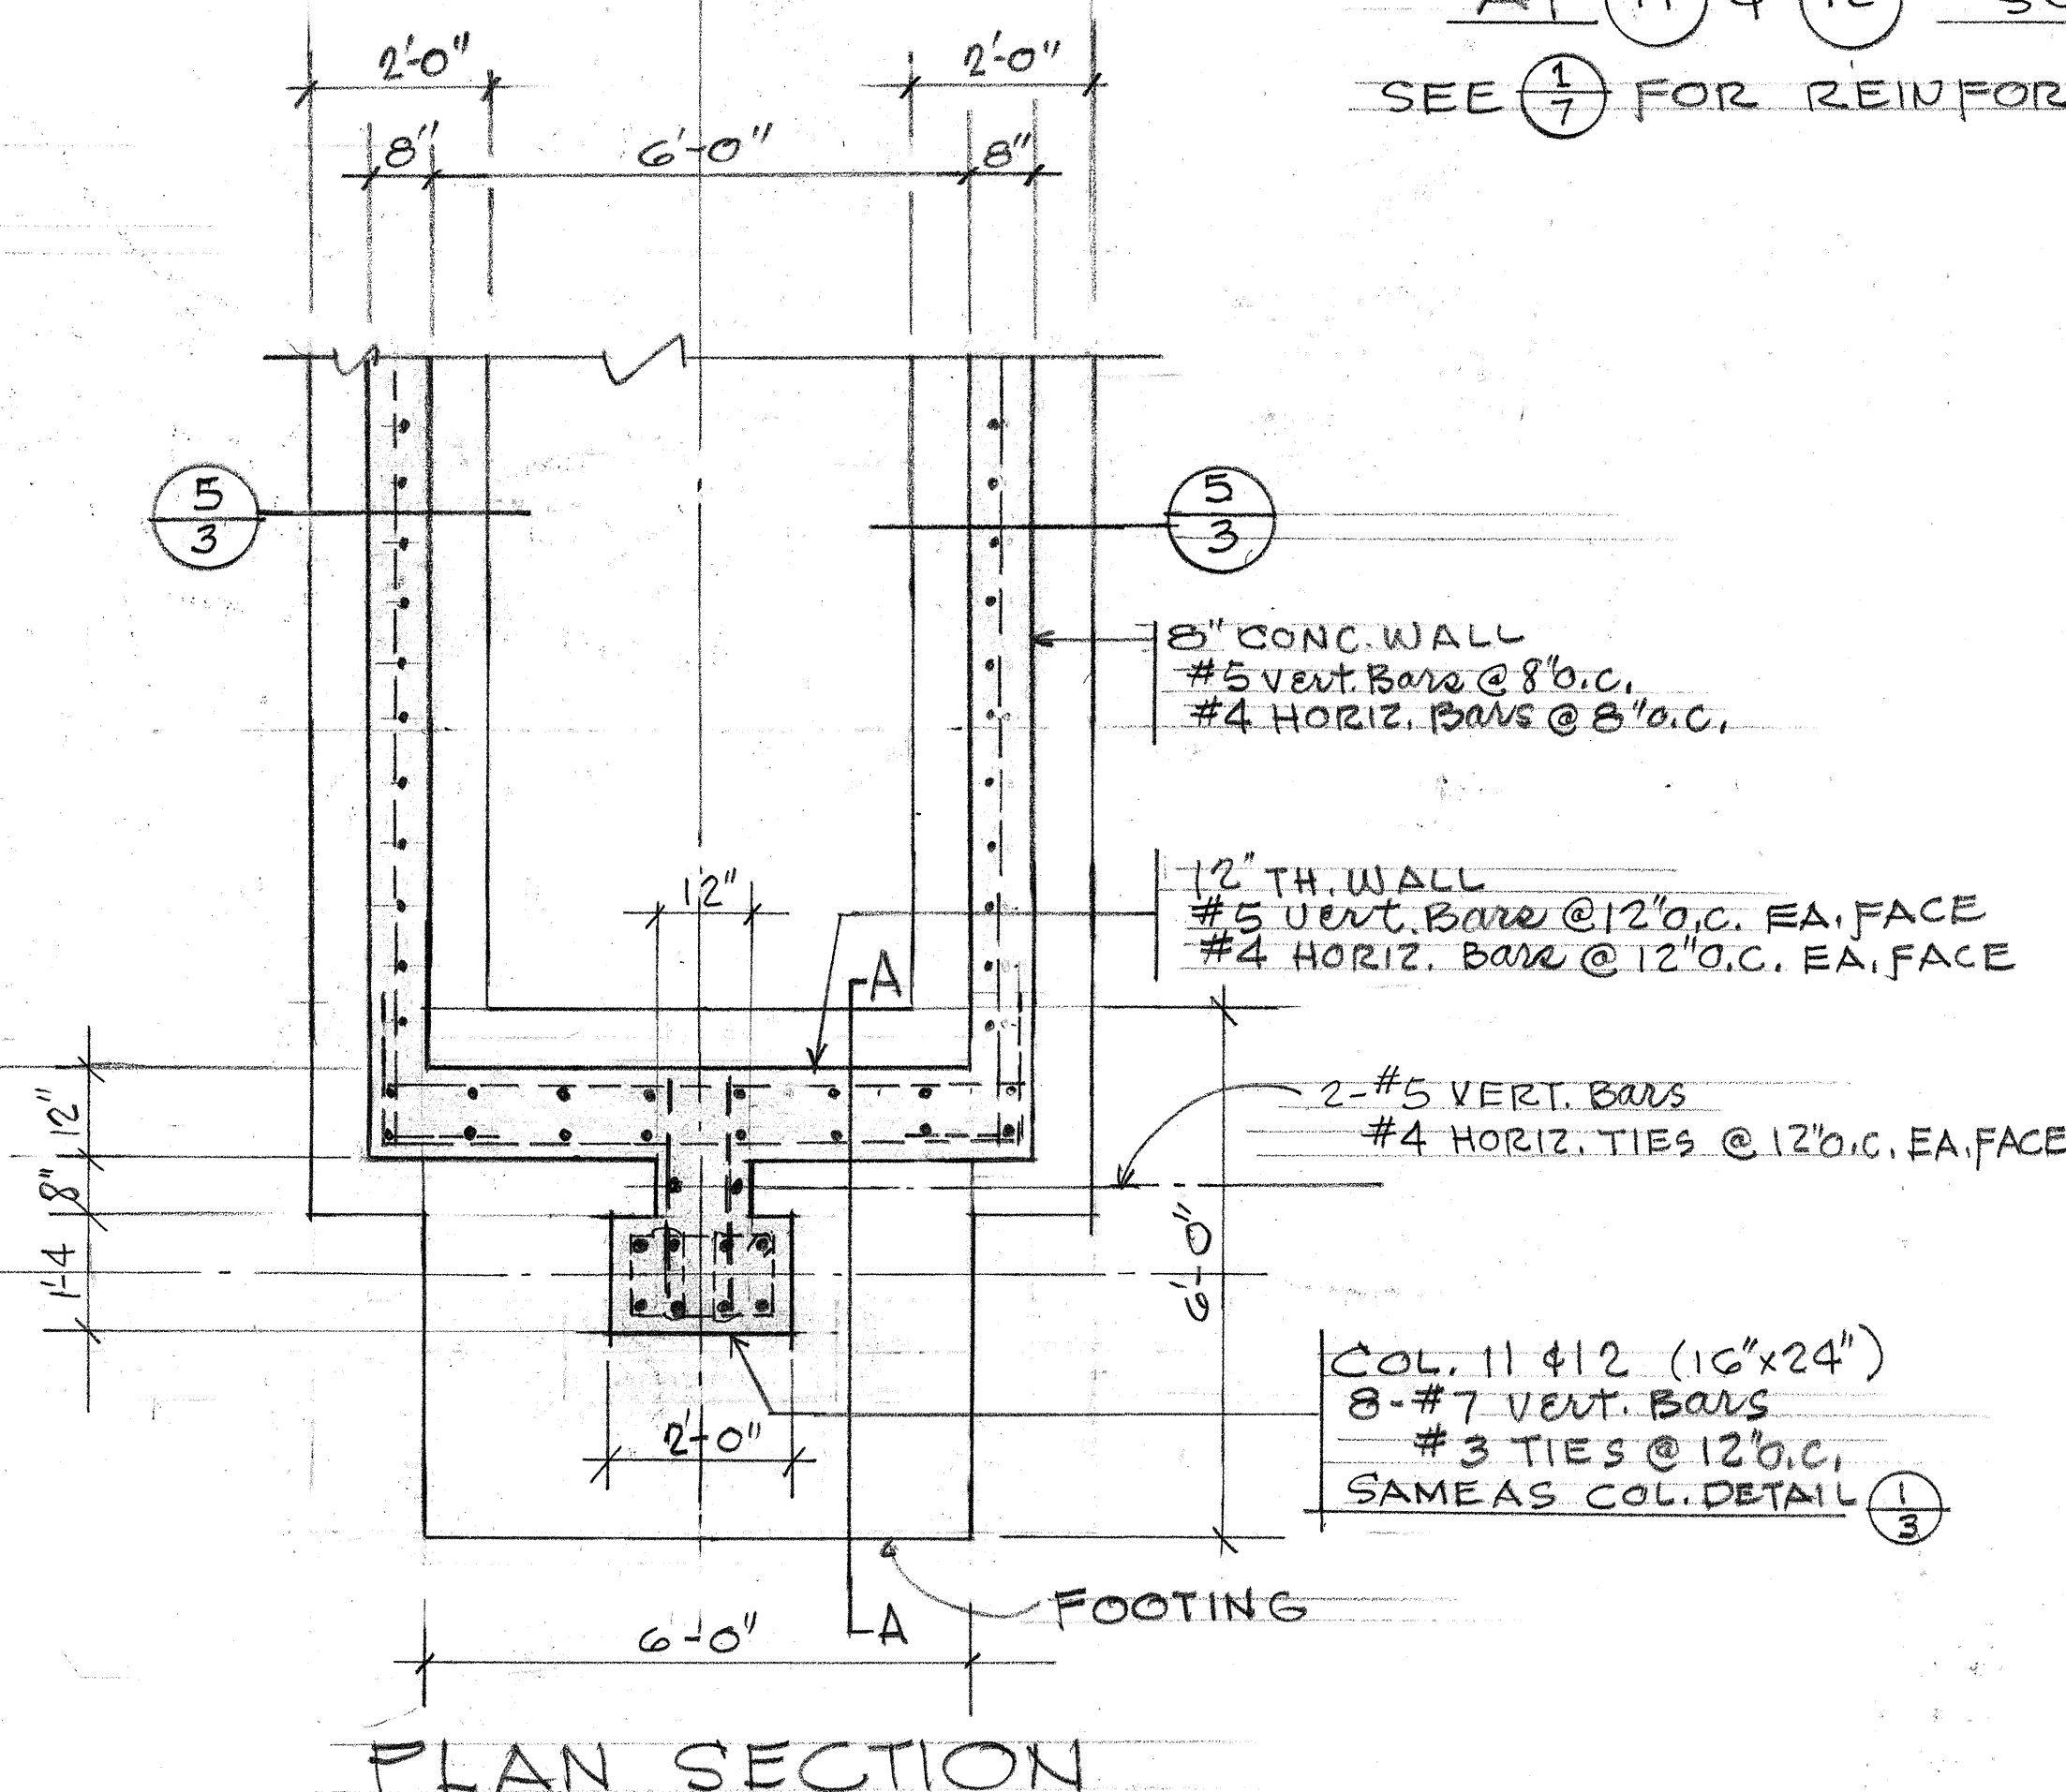

PLAN SECTION

NOTE:
BEARING AT DOWN-RAMP END OF GIRDER SHALL BE DIRECTLY ON GROUTED COLUMN SEAT; NEOPRENE BEARING PAD IS NOT REQUIRED.

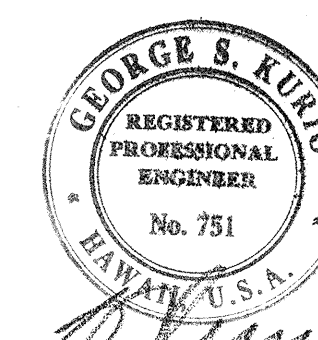

STATE OF HAWAII
DEPARTMENT OF TRANSPORTATION
HIGHWAYS DIVISION
PEDESTRIAN OVERPASS
PROJECT NO. 72B-02-68
KALANIANA'OLE HWY AT LUNALILO HOME RD.
HONOLULU OAHU
COLUMNS 3, 8, 11 & 12
SCALE: AS NOTED AUG 1968
SHEET No. 7 OF 11 SHEETS

DATE	_____
DESIGNED BY	_____
CHECKED BY	_____
NOTED BY	_____
QUANTITIES BY	_____
ORIGINAL PLAN	_____
NOTE BOOK	_____
NO.	_____