

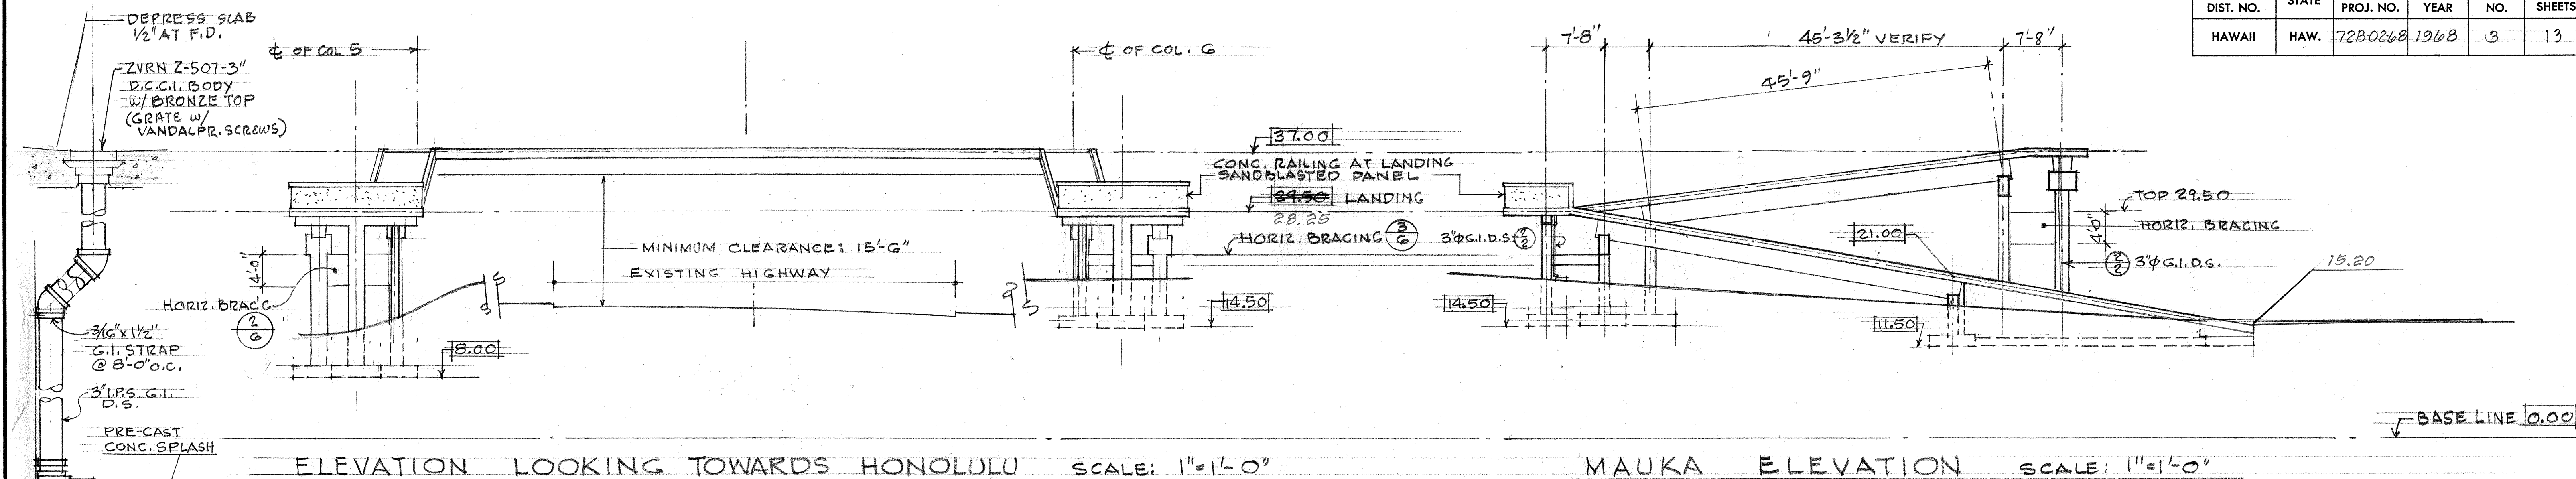
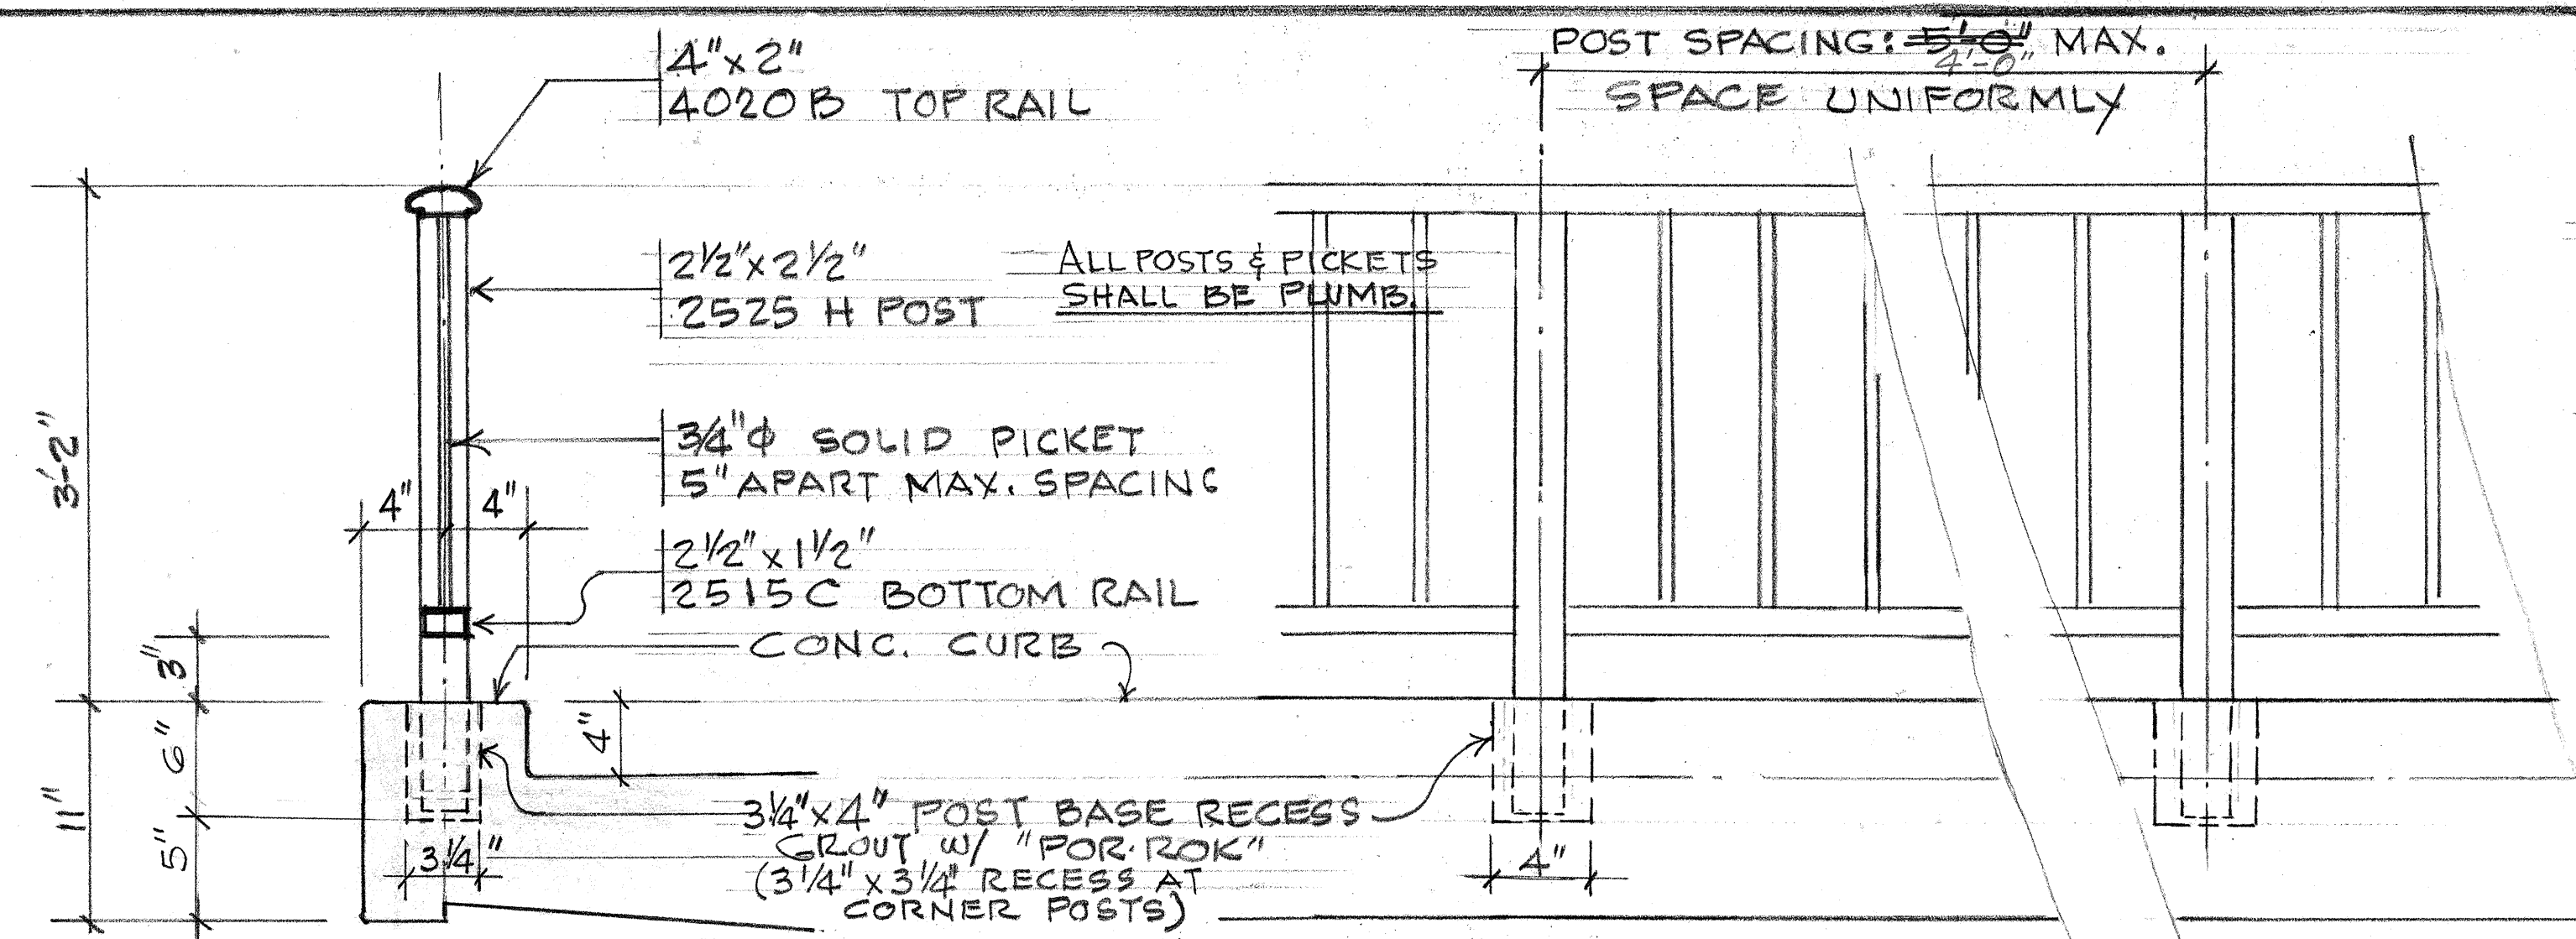


FED. ROAD DIST. NO.	STATE	PROJ. NO.	FISCAL YEAR	SHEET NO.	TOTAL SHEETS
HAWAII	HAW.	72B-02-68	1968	3	13

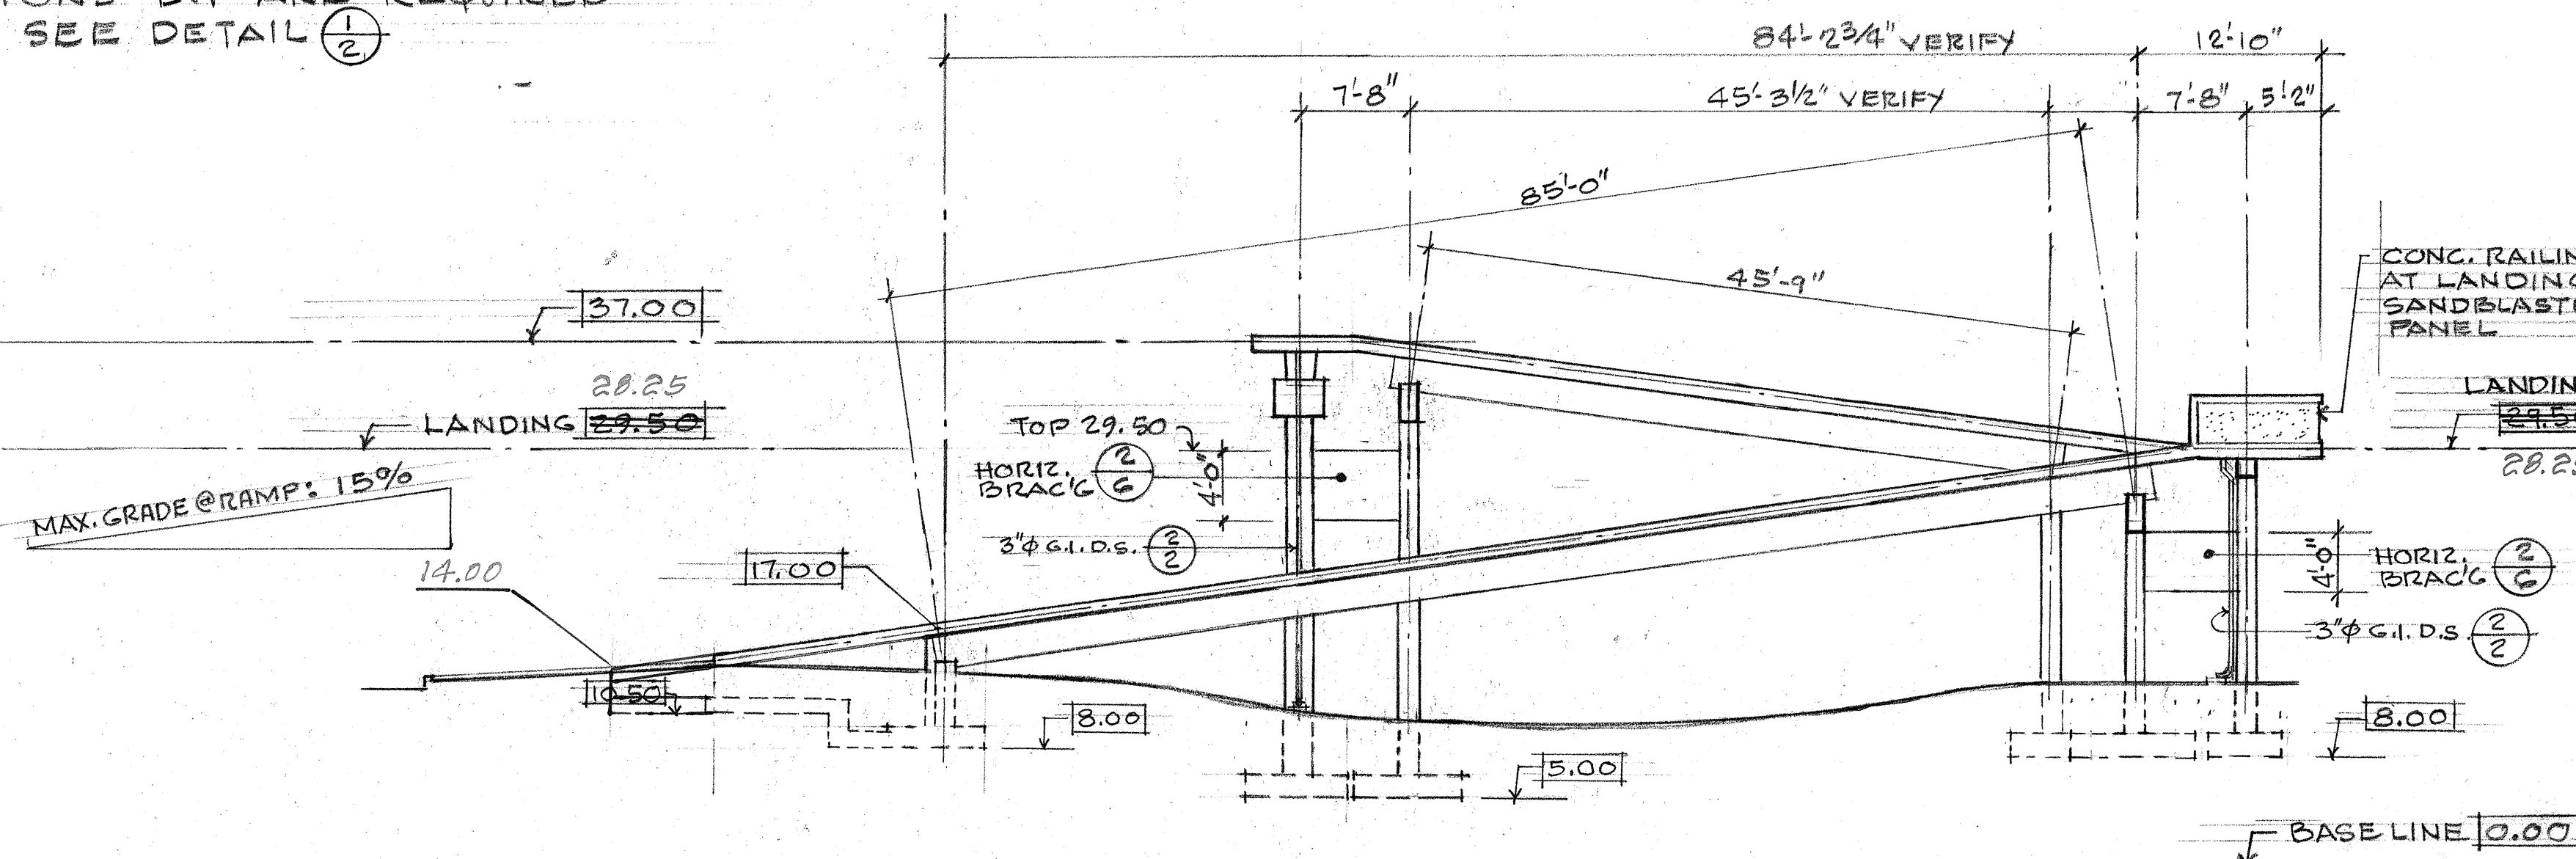

NOTES: • RAILINGS ARE NOT INDICATED ON THESE ELEVATIONS BUT ARE REQUIRED ON BOTH SIDES OF THE OVERPASS AND RAMPS. SEE DETAIL 1/2


FLOOR DRAIN & DOWNSPOUT
SCALE: 1/4"=1'-0"
NOTE: 4 FL. DR. W/ D.S. REQ'D

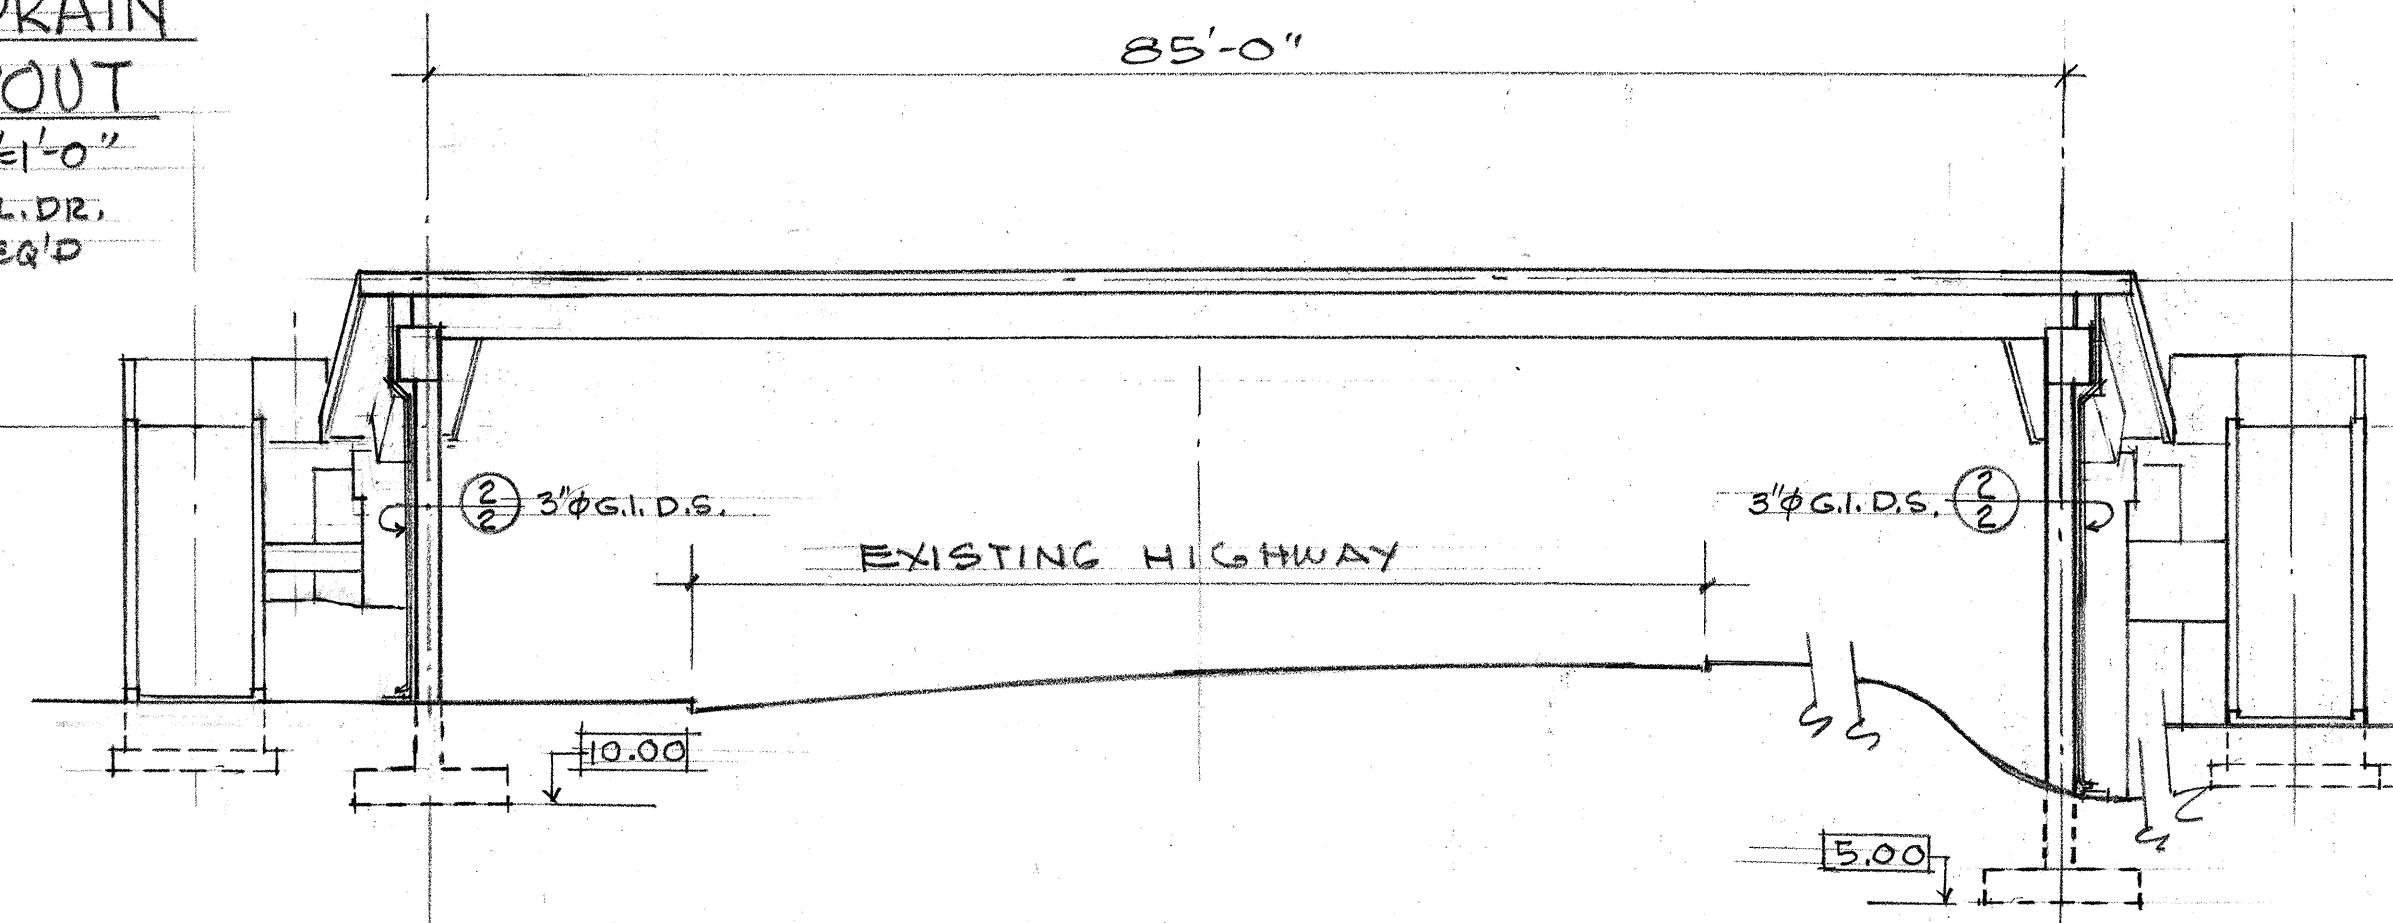

PLAN OF RAILING AT CORNER

- NOTES:
- ALL ALUMINUM COMPONENTS SHALL HAVE AN ANODIZED FINISH EQUAL TO ALCOA PURANODIC 312E - MEDIUM BRONZE, WITH MINIMUM COATING THICKNESS OF .0007 IN.
 - FURNISH COMPLETE SHOP DRAWINGS SHOWING ALL DETAILS OF CONSTRUCTION & LAYOUT OF POST SPACING. DO NOT FABRICATE WORK UNTIL THESE DRAWINGS HAVE BEEN APPROVED.

CONCRETE FINISHES
EXPOSED SUPERSTRUCTURE:
CLASS 1
DECK & WALKWAY
CLASS 3
PANEL AT RAILING
SANDBLAST

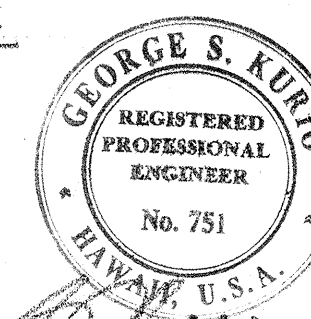

STATE OF HAWAII
DEPARTMENT OF TRANSPORTATION
HIGHWAYS DIVISION
PEDESTRIAN OVERPASS
PROJECT NO. 72B-02-68
KALANIANA'OLE HWY. AT LUALILO HOME RD.
HONOLULU OAHU
ELEVATIONS
SCALE: AS NOTED AUG. 1968
SHEET No. 2 OF 11 SHEETS

DATE	_____
DESIGNED BY	_____
TRACED BY	_____
NOTED BY	_____
CHECKED BY	_____
ORIGINAL PLAN	_____
NOTE BOOK	_____
QUANTITIES BY	_____
NO.	_____