

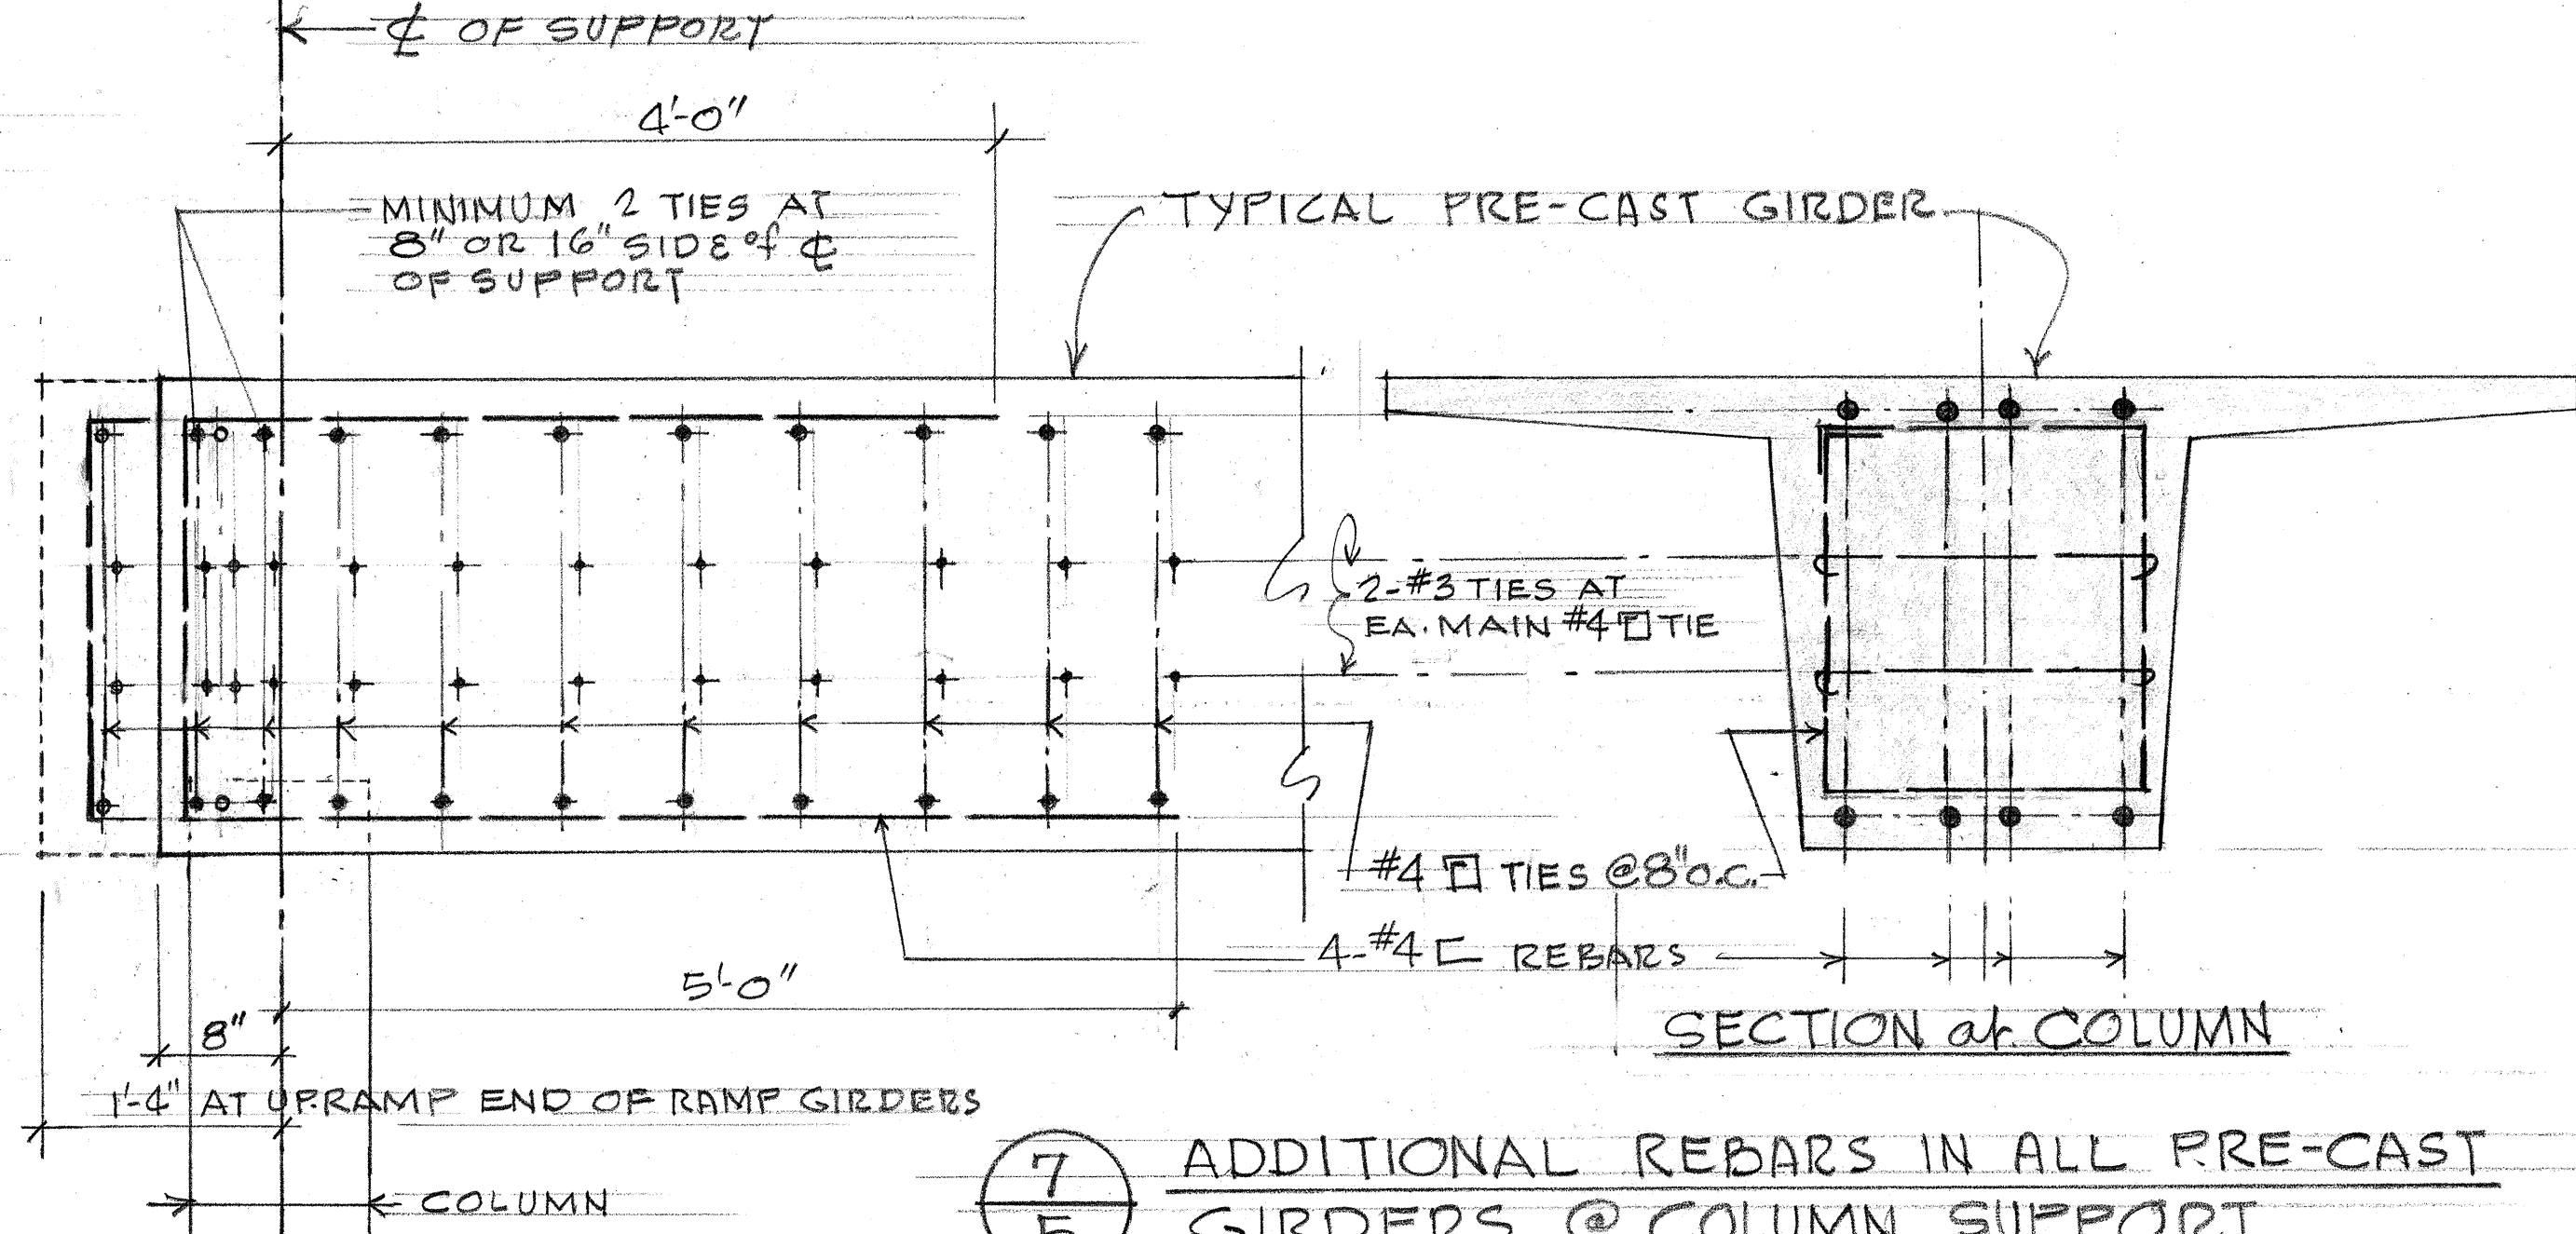
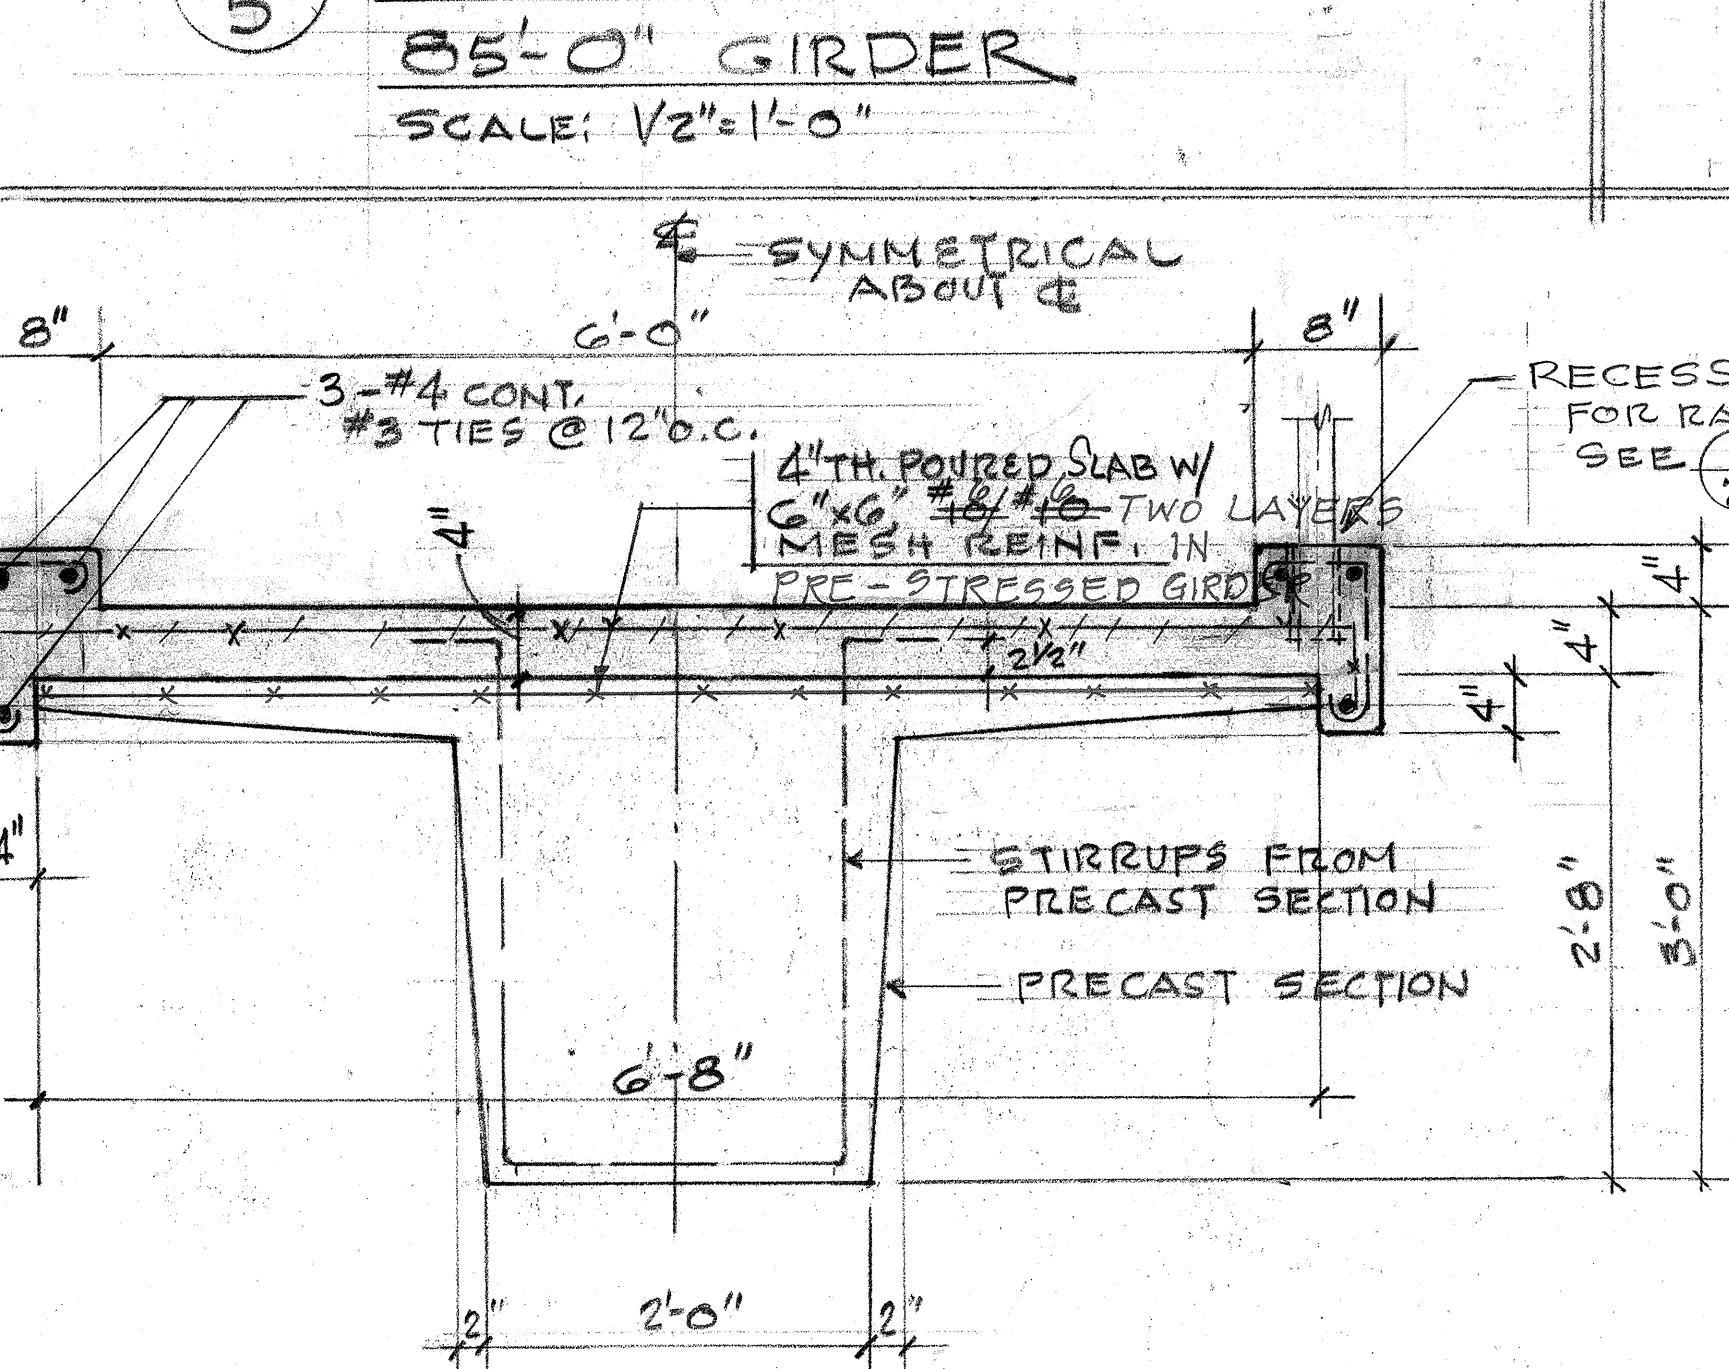
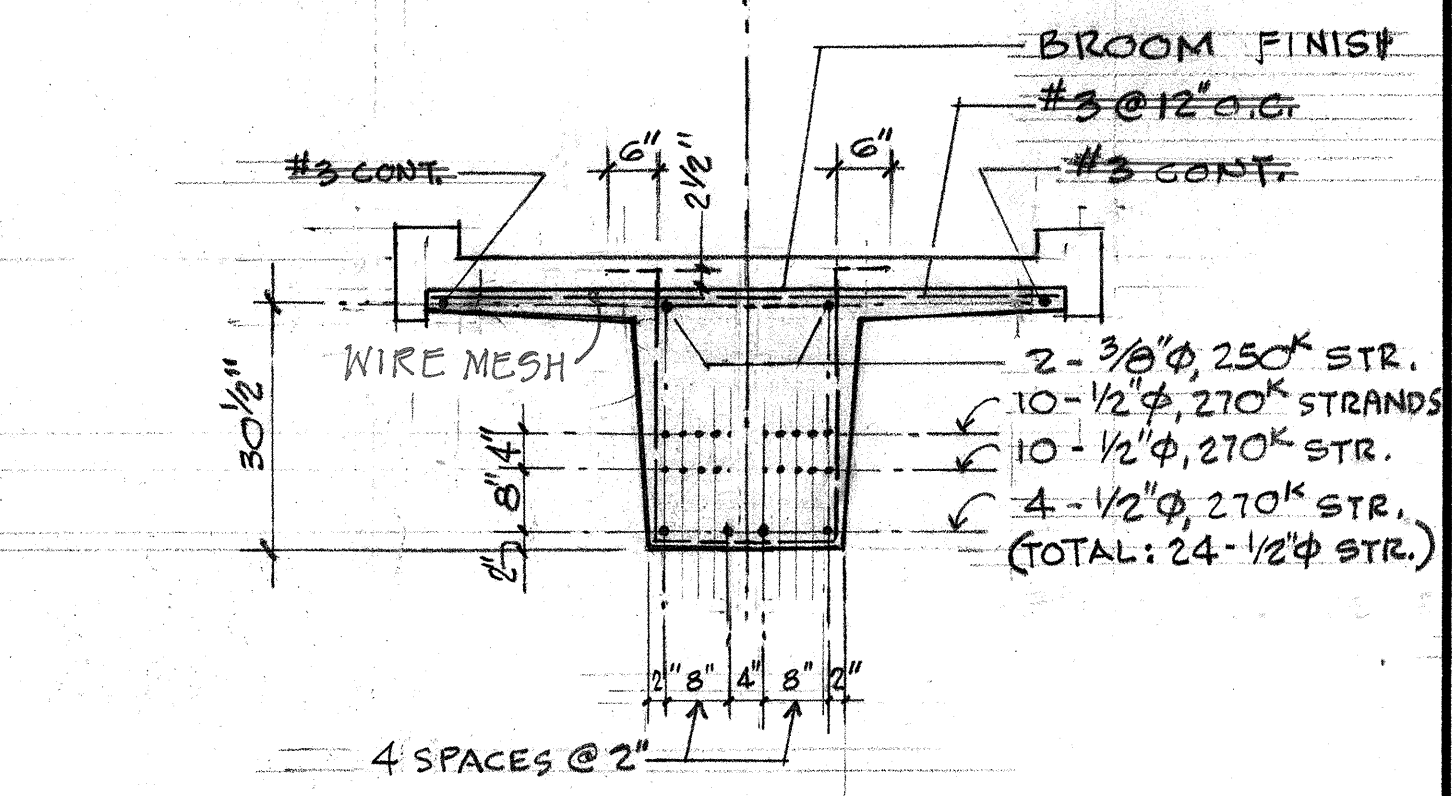
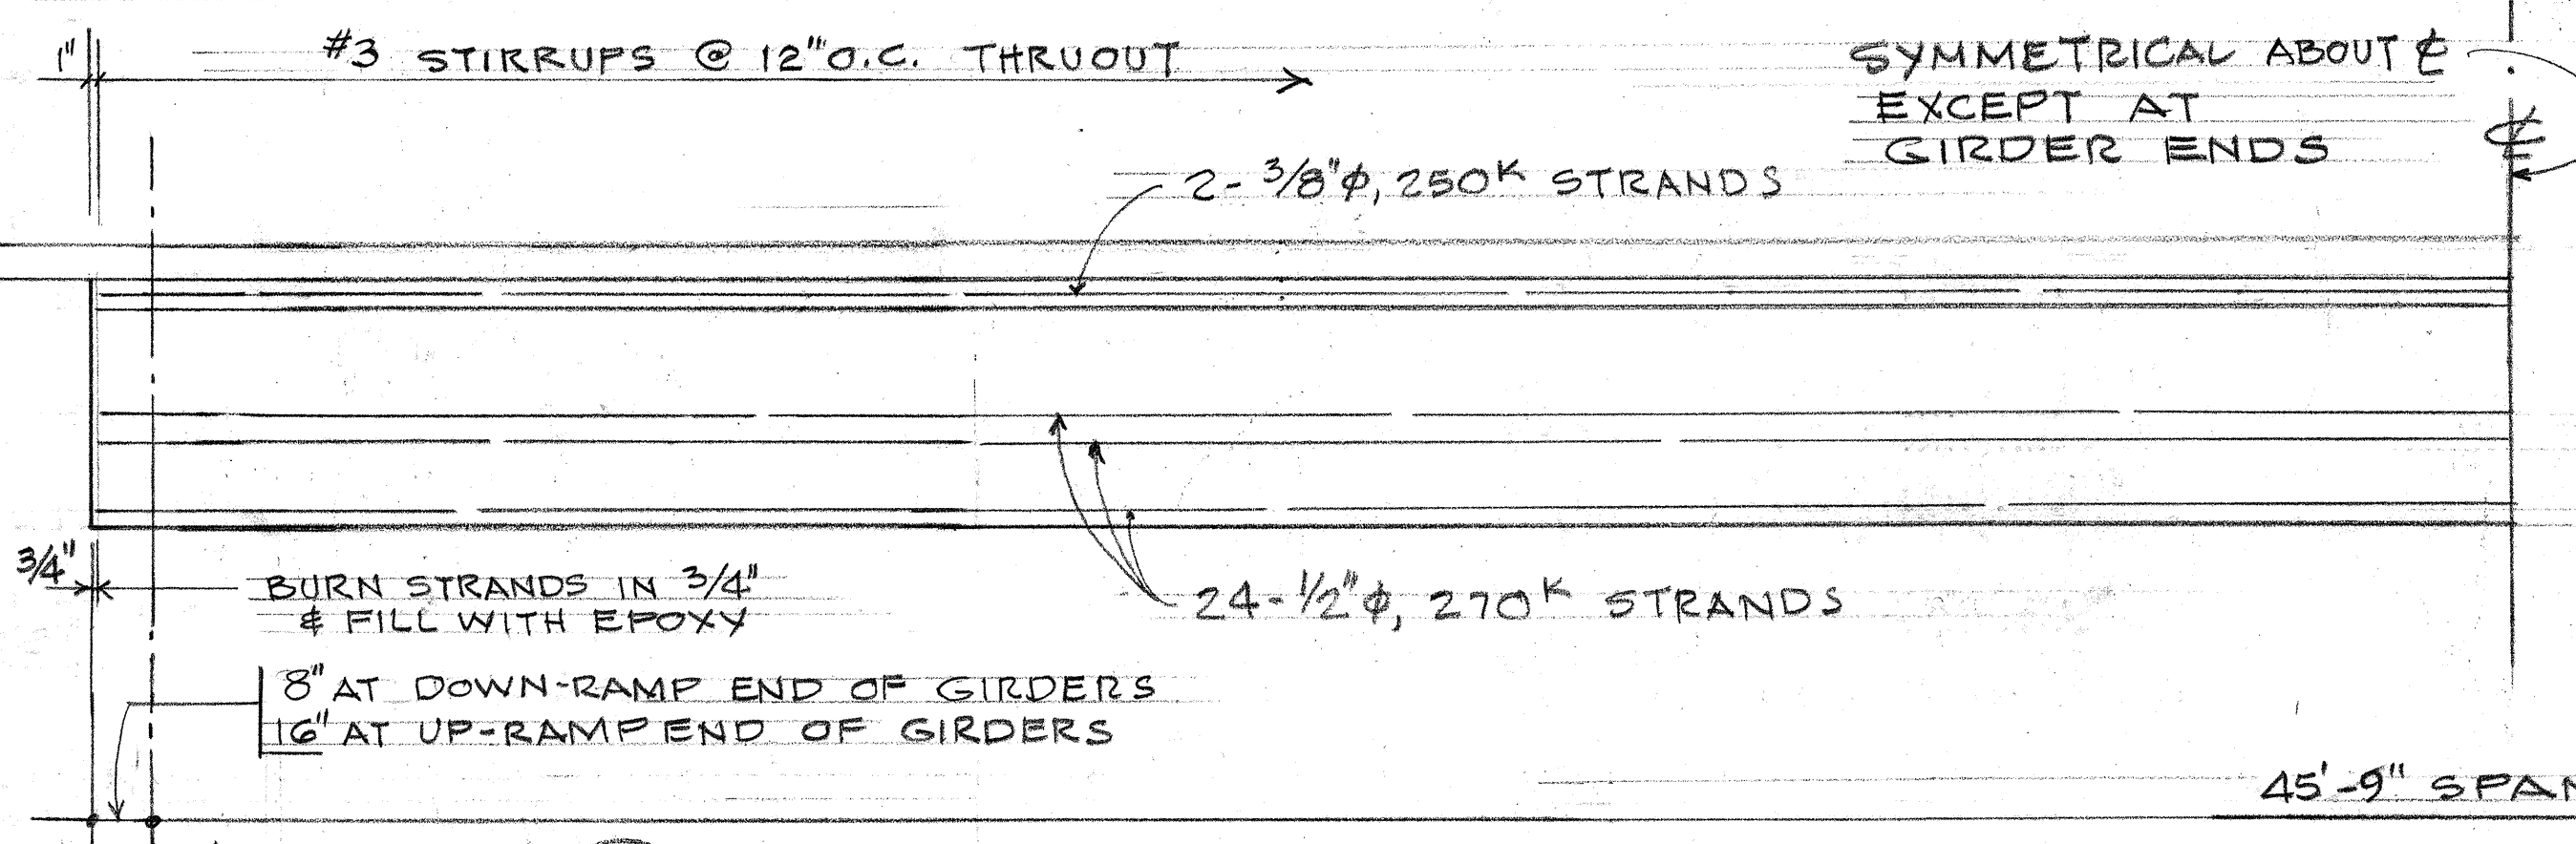
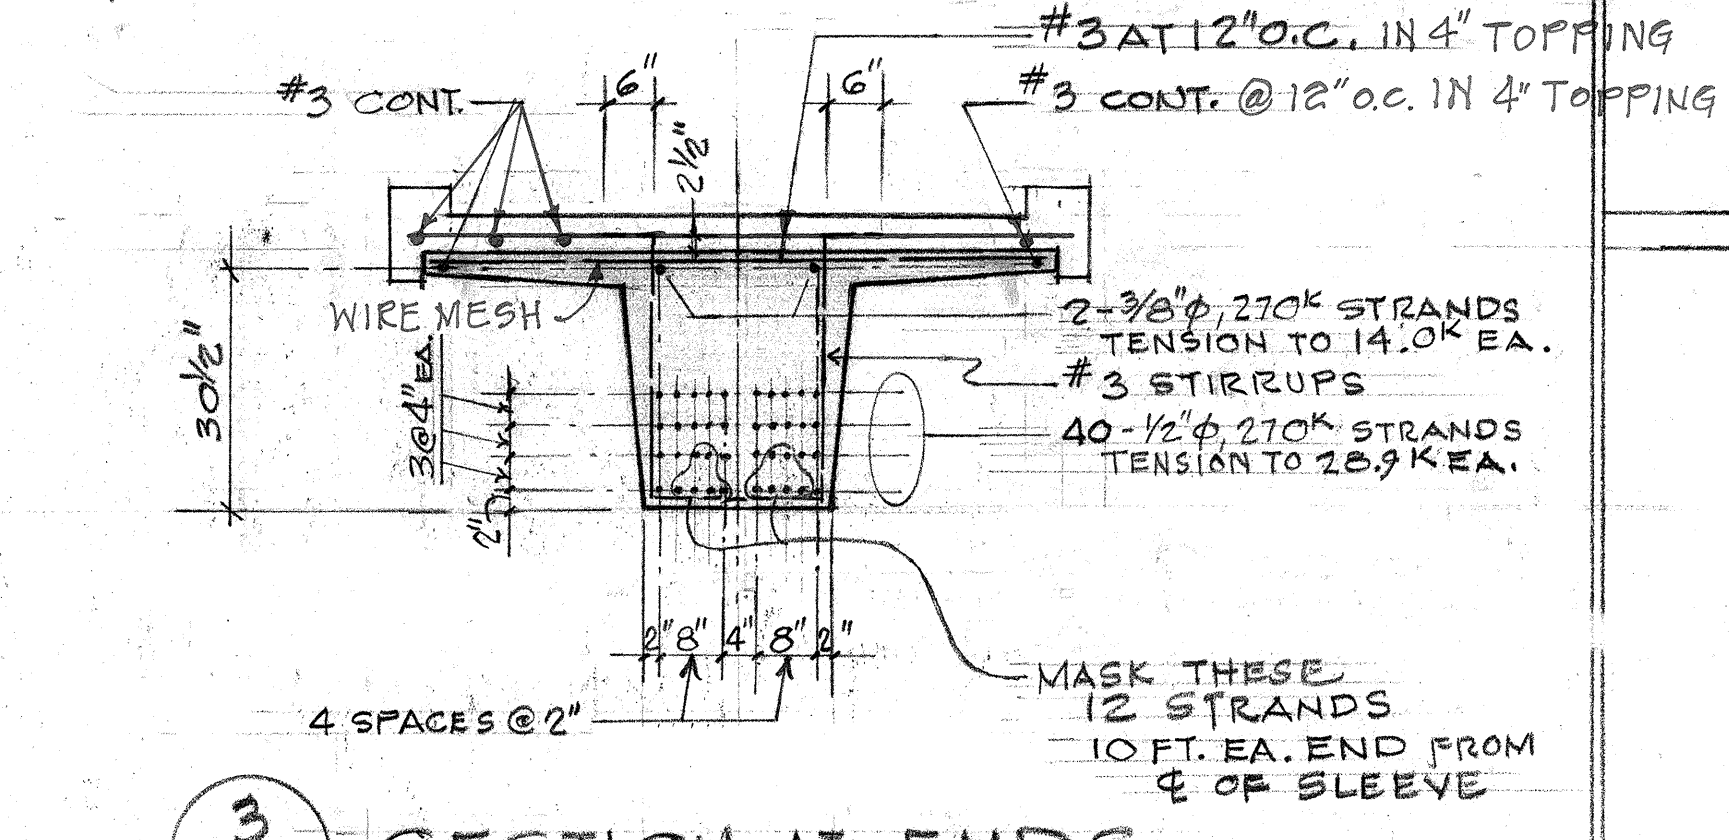
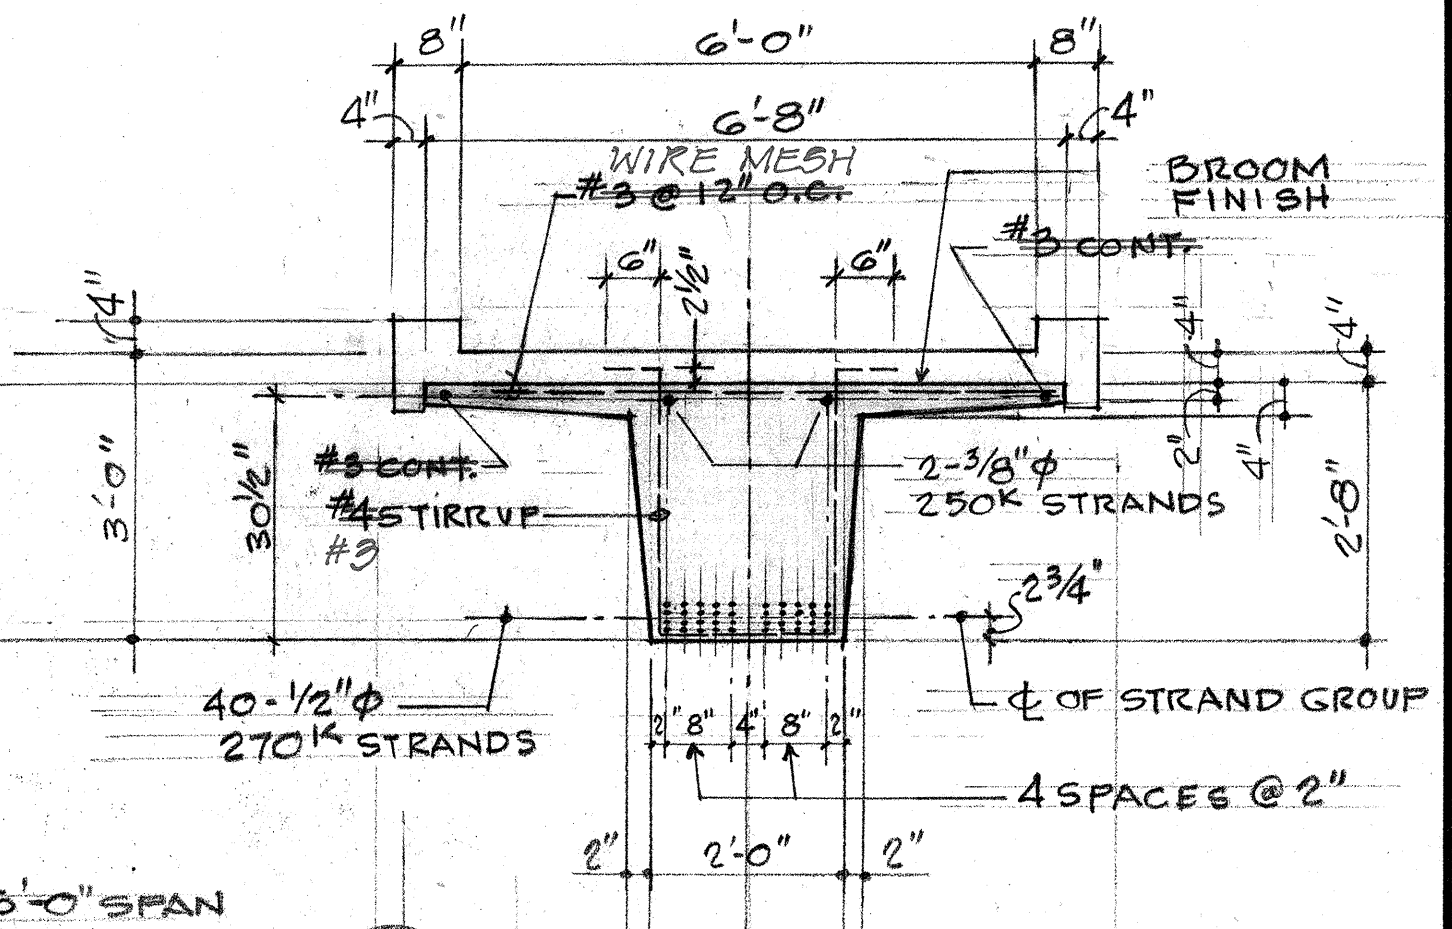


FED. ROAD DIST. NO.	STATE	PROJ. NO.	FISCAL YEAR	SHEET NO.	TOTAL SHEETS
HAWAII	HAW.	72B-02-68	1968	6	13

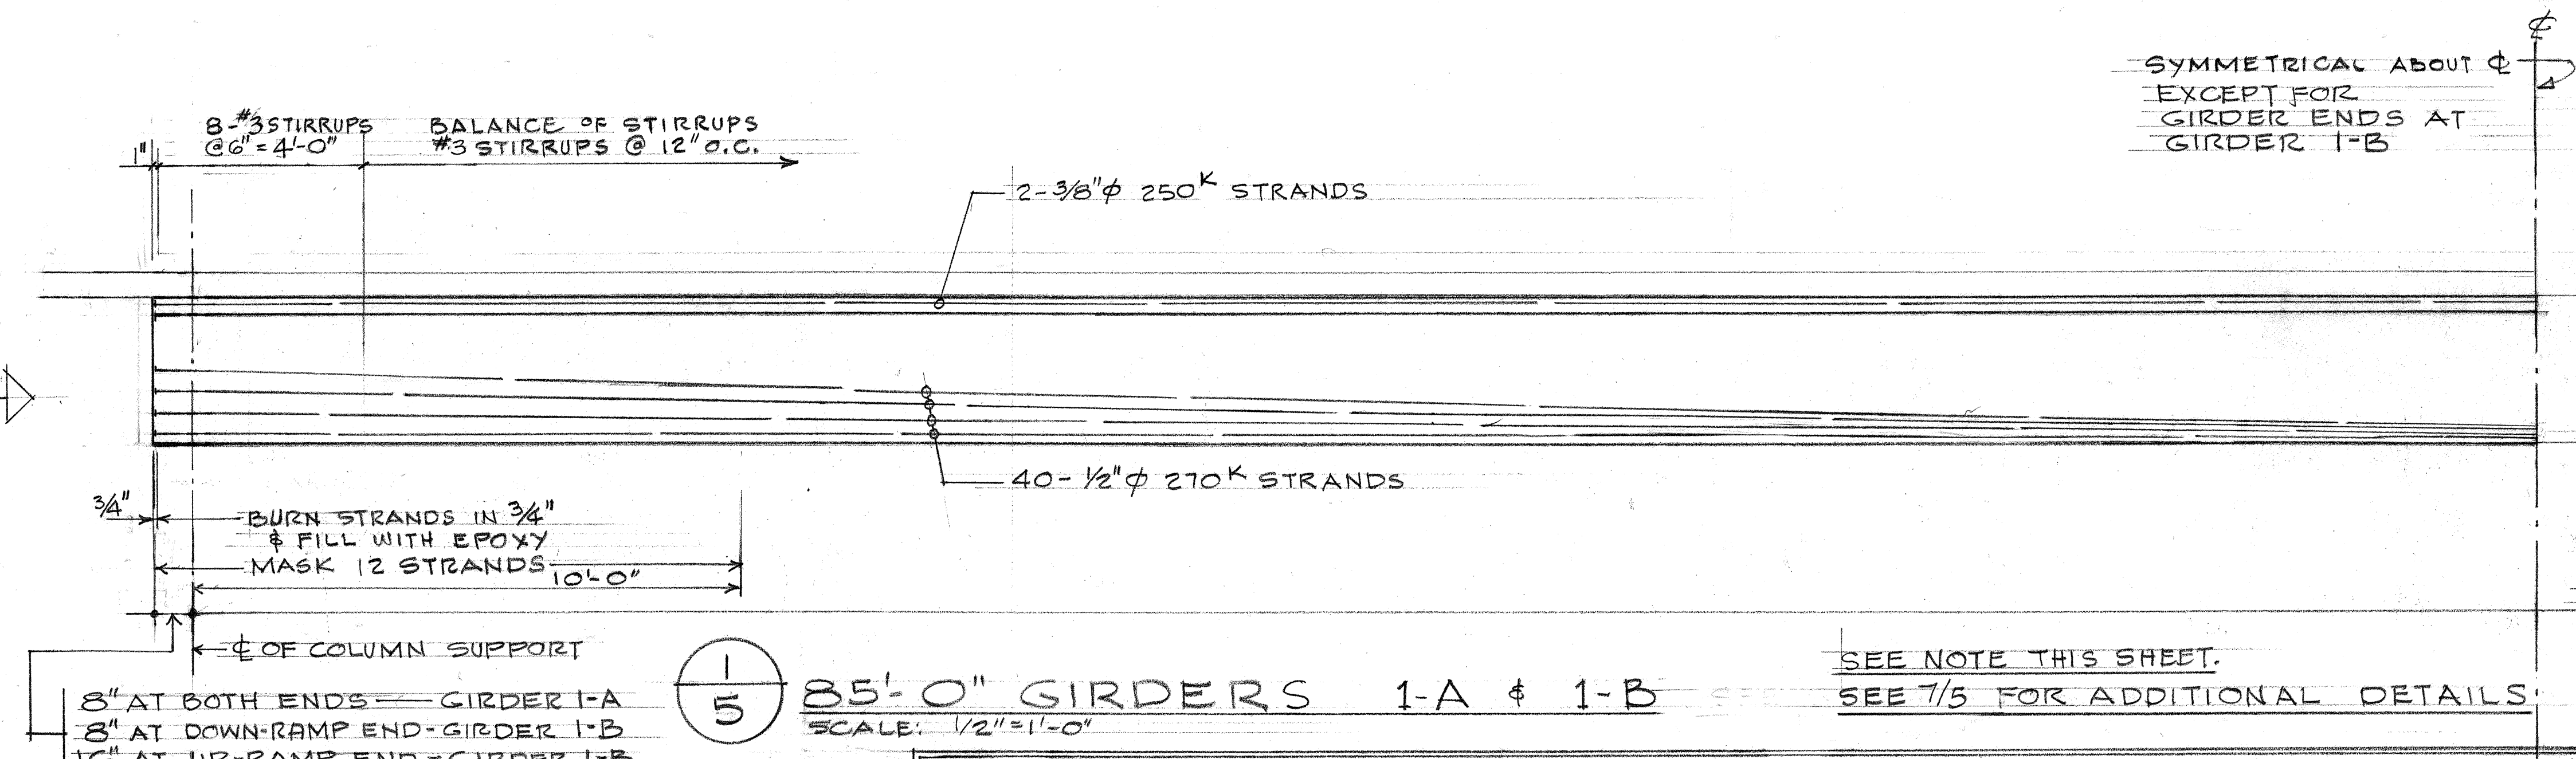

NOTE:
AT THE UP-RAMP SUPPORT END OF ALL GIRDERS, (EXCEPT 1-A) INSTALL ANCHORED PLATE. SEE DETAIL 1

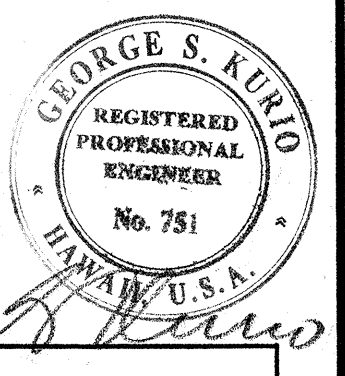

STATE OF HAWAII
DEPARTMENT OF TRANSPORTATION
HIGHWAYS DIVISION
PEDESTRIAN OVERPASS
PROJECT NO. 72B-02-68
KALANIANAOLE HWY. AT LUNALILO HOME RD.
HONOLULU OAHU
GIRDERS, POURED DECK
SCALE: AS NOTED AUG. 1968
SHEET No. 5 OF 11 SHEETS

DATE	
SURVEY PLOTTED BY	
DESIGNED BY	
NOTED BY	
CHECKED BY	
ORIGINAL PLAN	
NOTE BOOK	
NO.	