




FED. ROAD DIST. NO.	STATE	PROJ. NO.	FISCAL YEAR	SHEET NO.	TOTAL SHEETS
HAWAII	HAW.	72B-02-68	1968	7	13

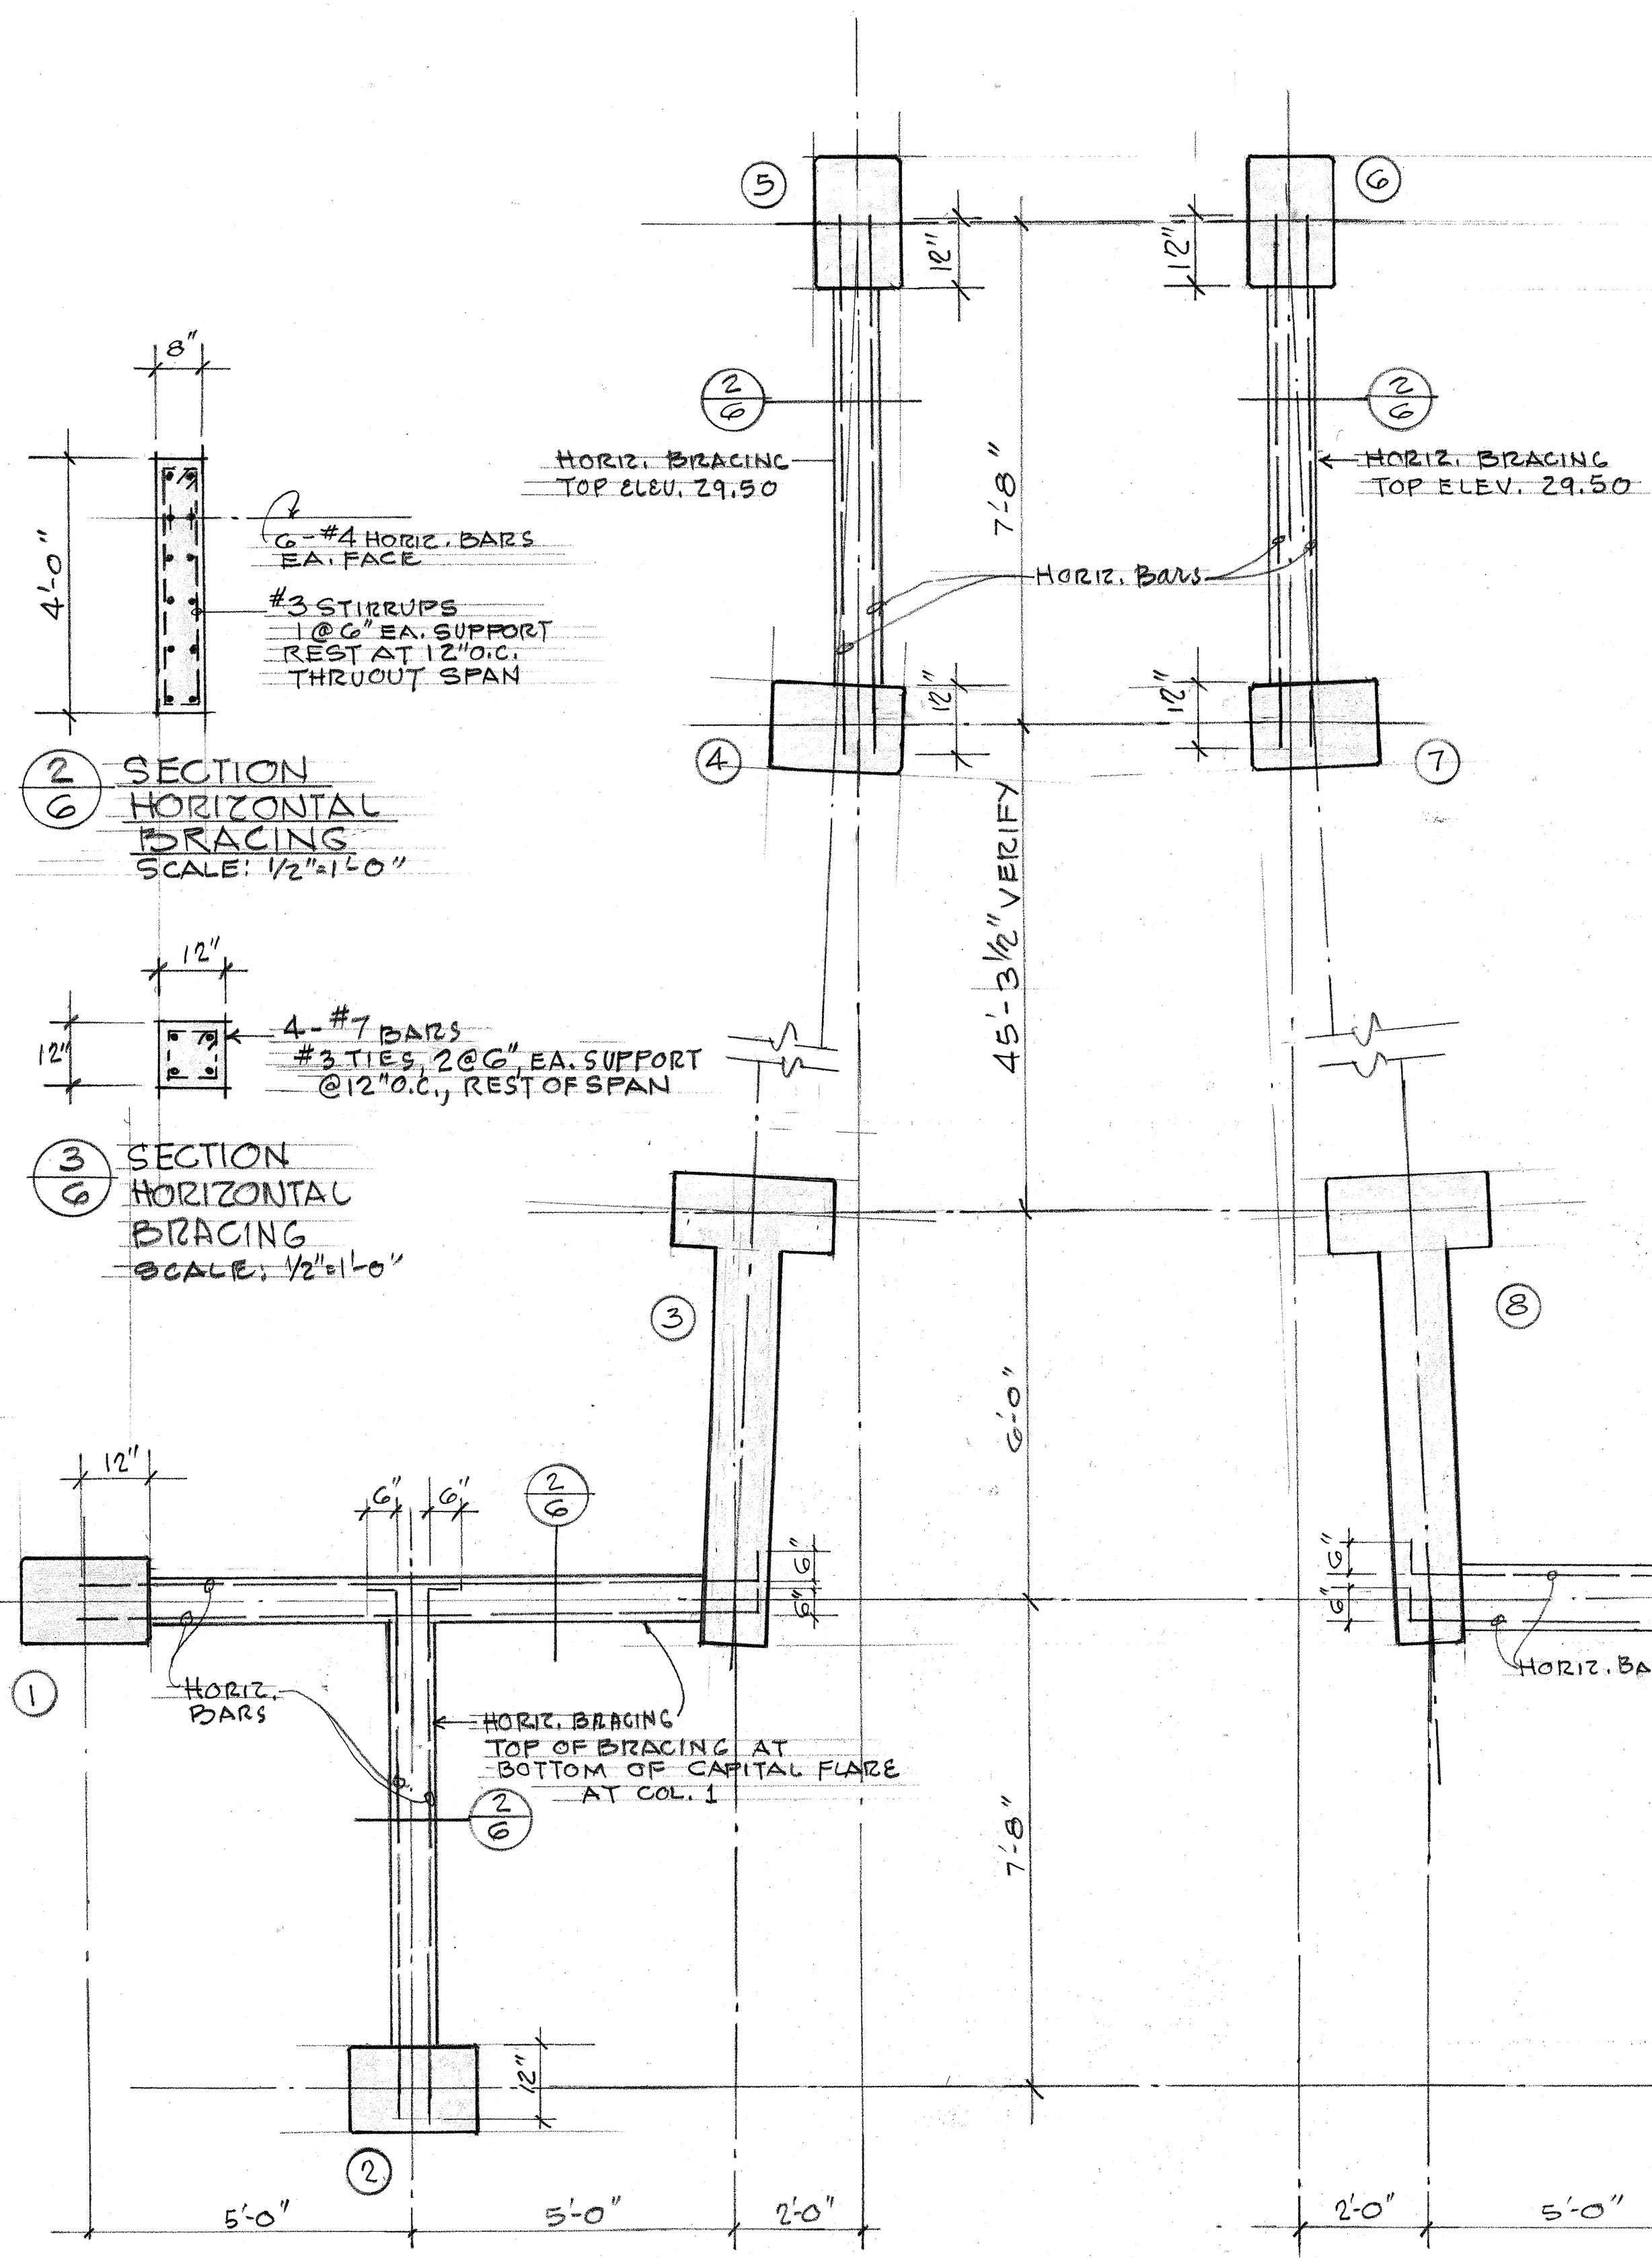


1/6 PLAN LAYOUT OF COLUMNS & HORIZONTAL BRACING
SCALE: 1/2"=1'-0"

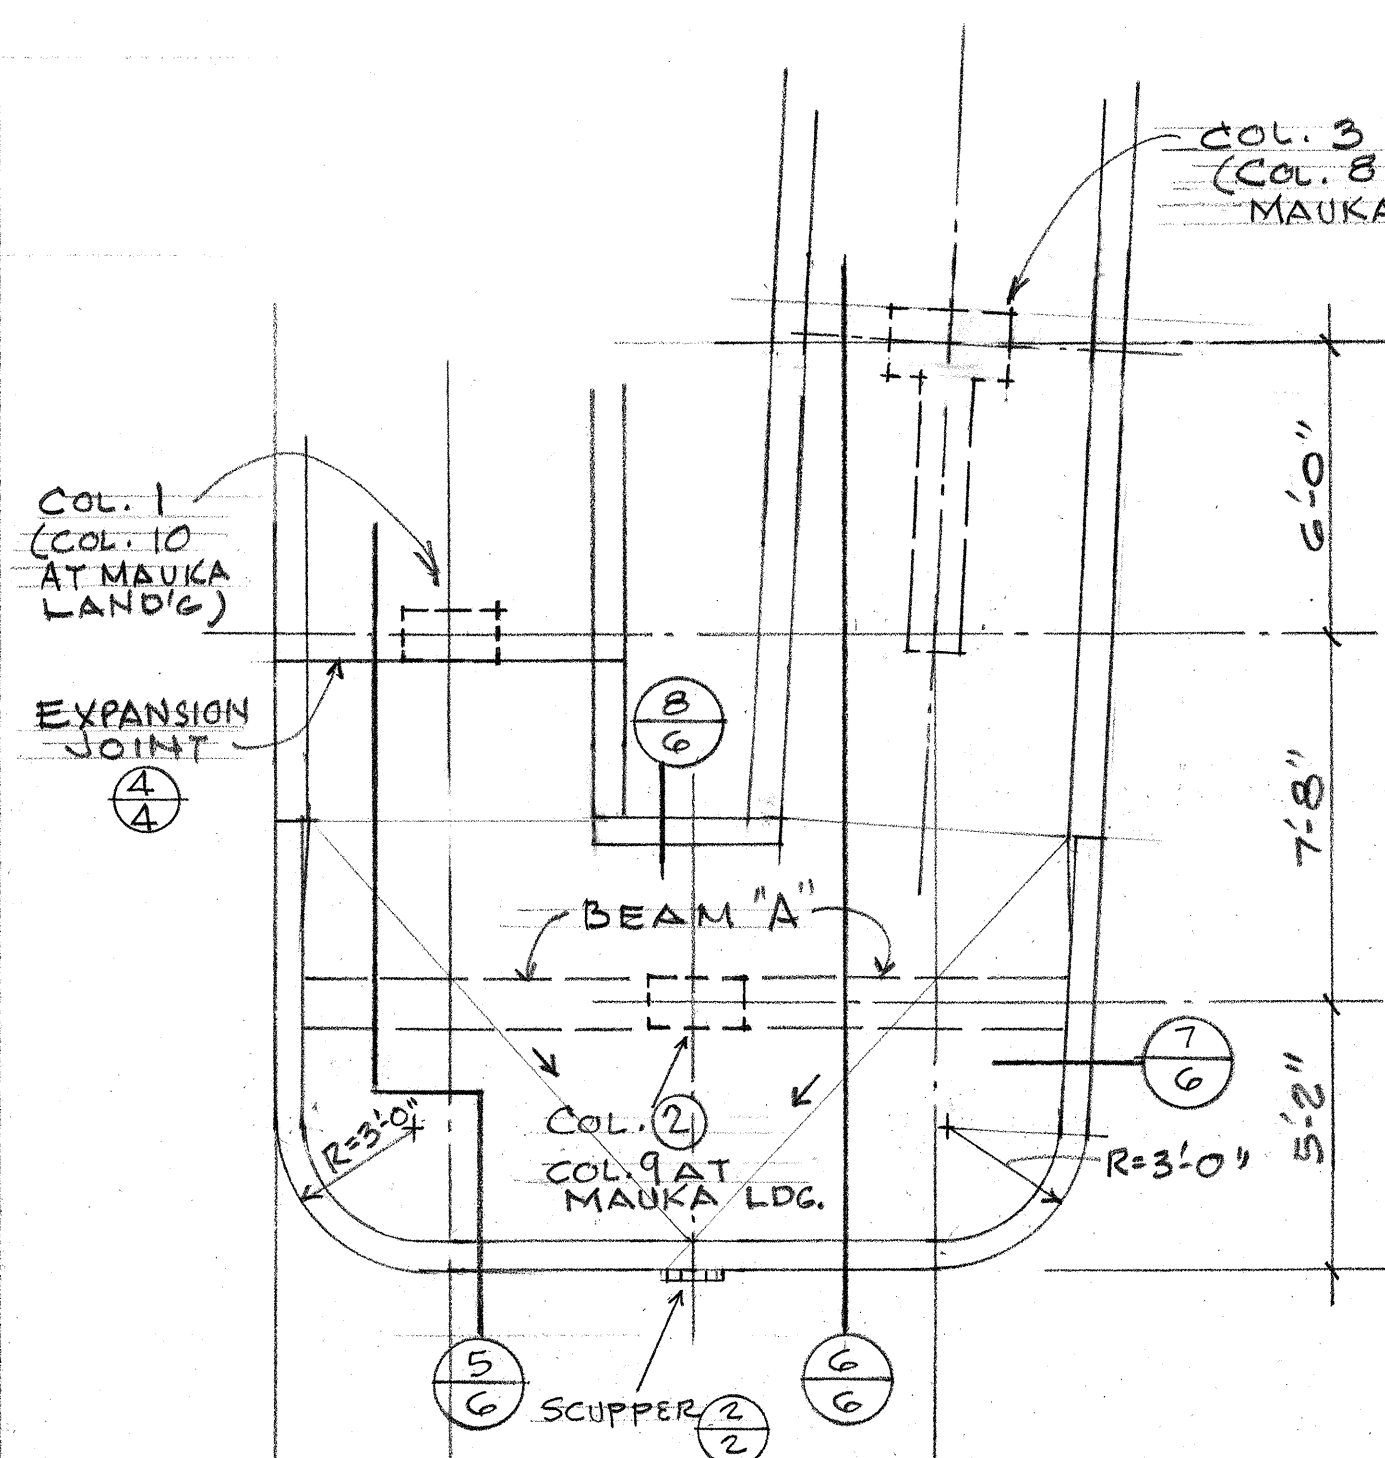


4/6 PLAN AT LANDING
SCALE: 1/4"=1'-0"
MAKAI LANDING
MAUKA LANDING SIMILAR
BUT OPPOSITE HAND

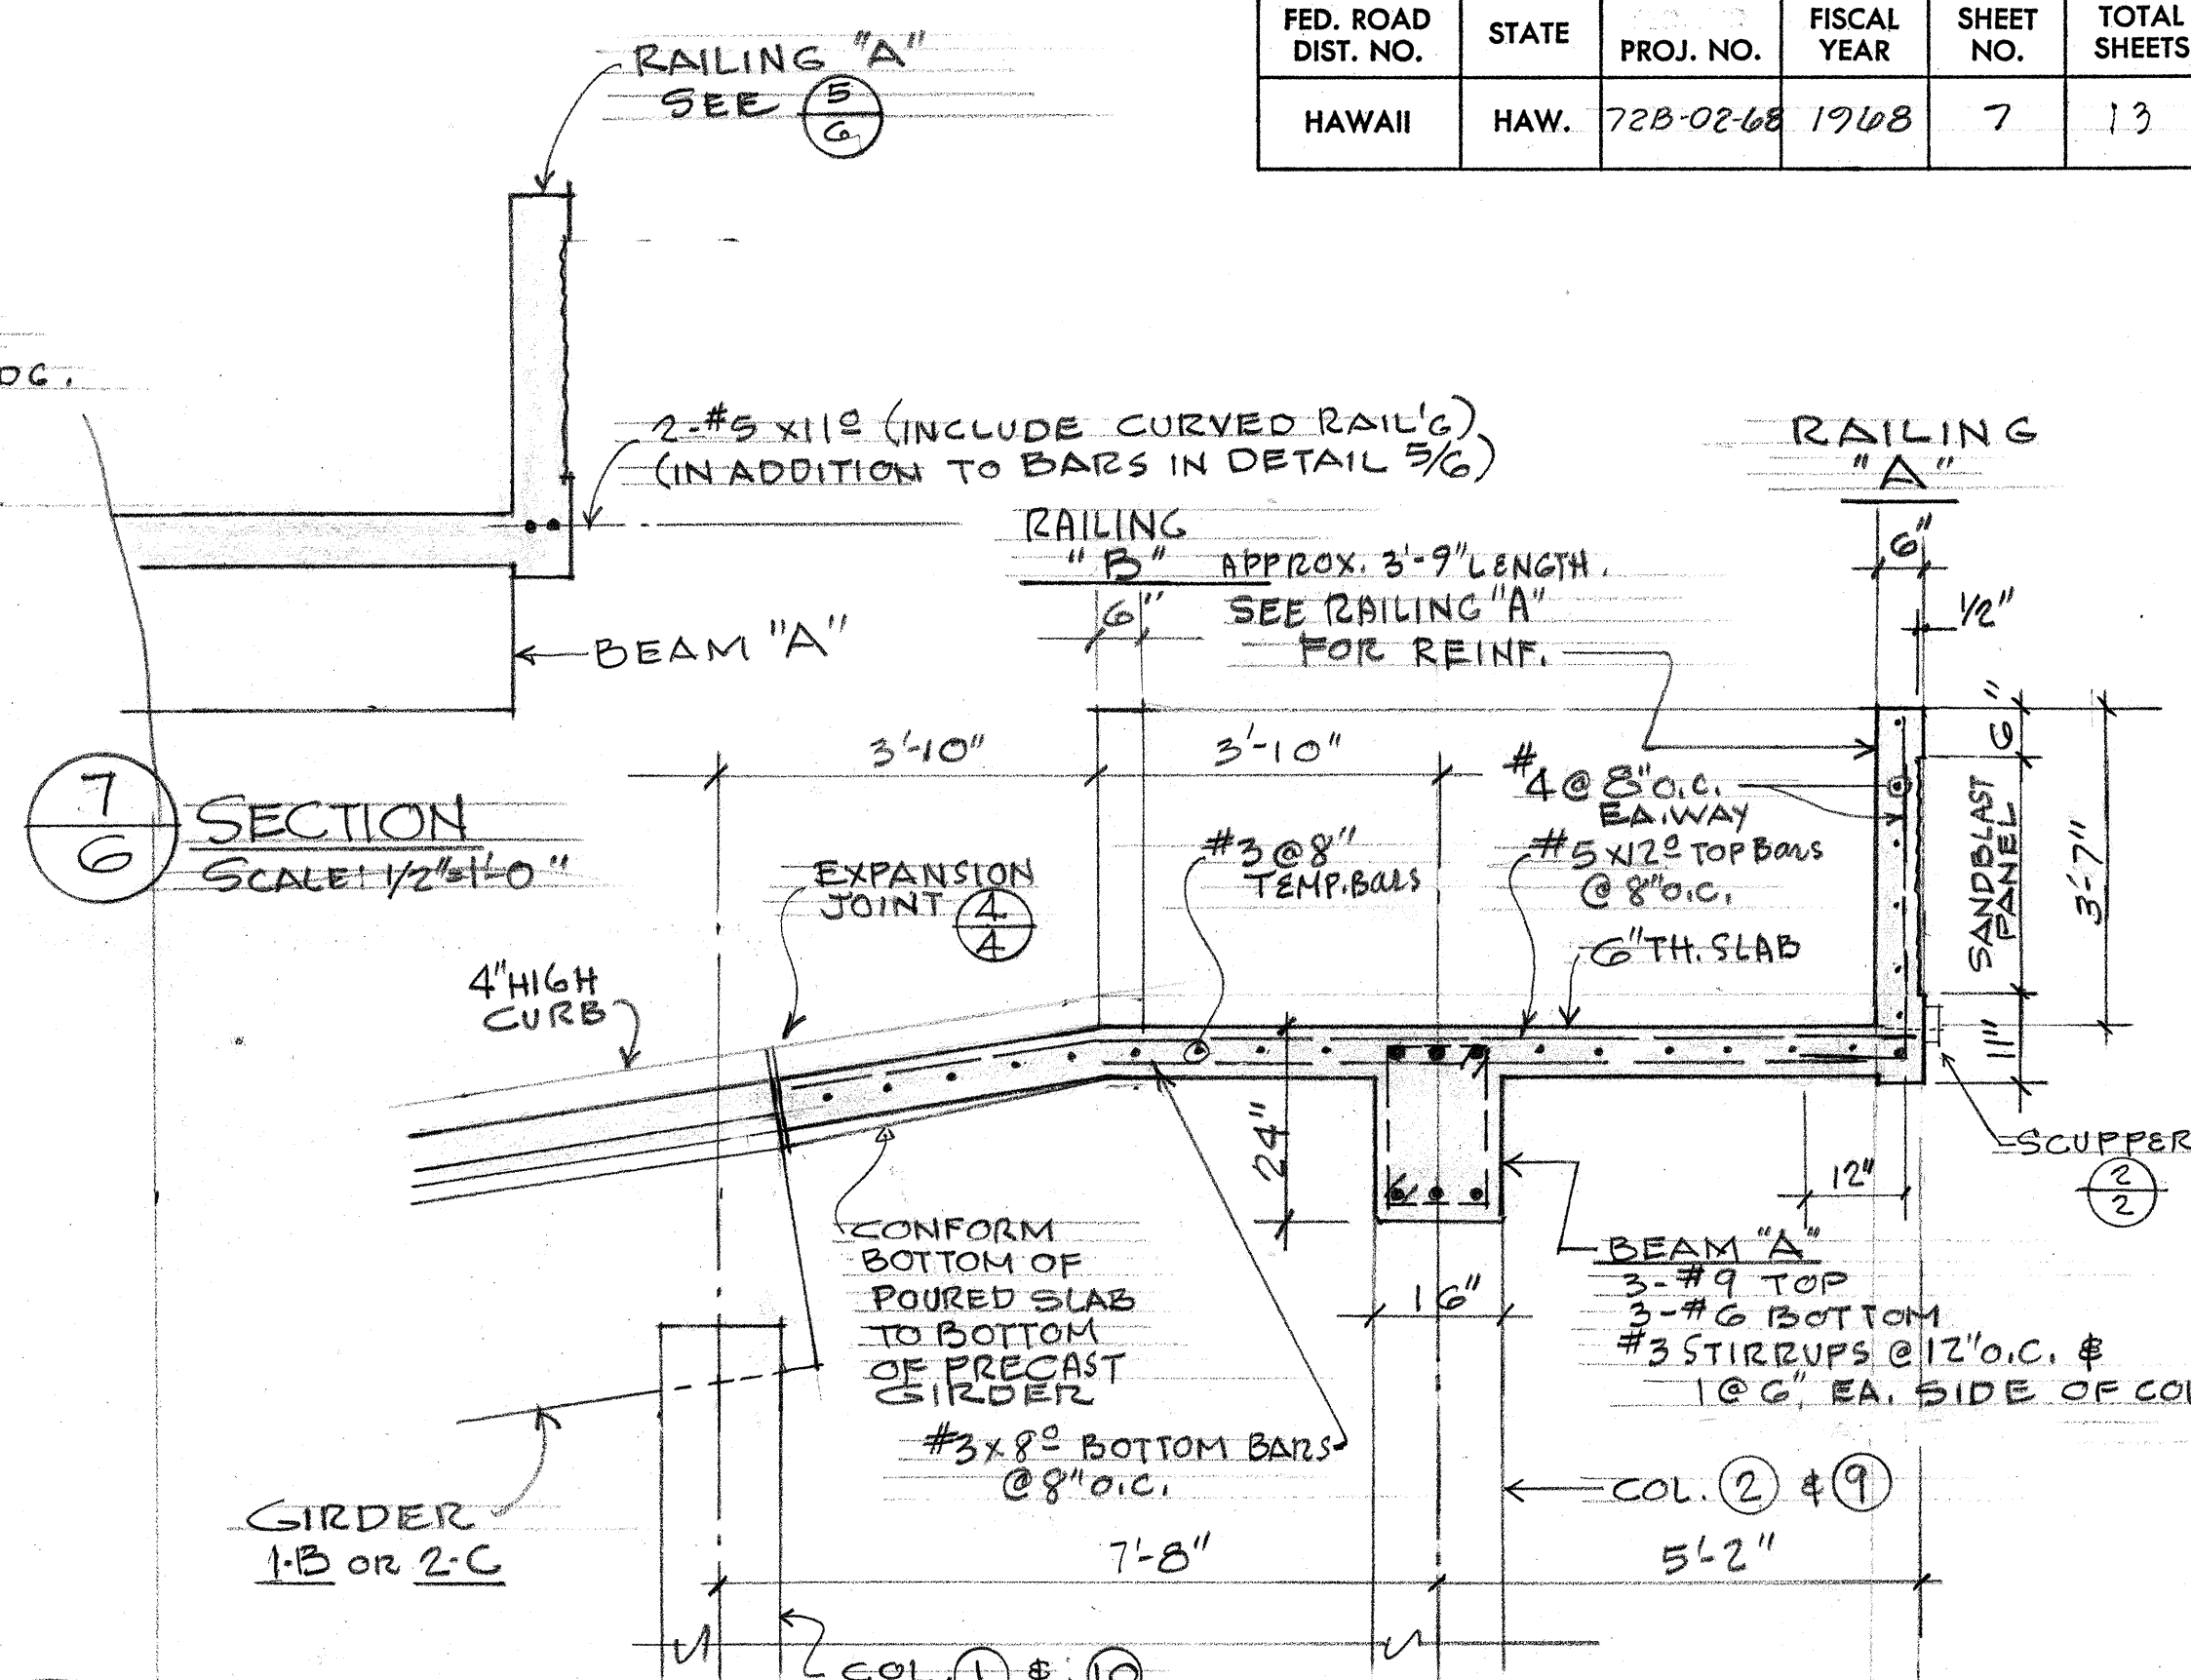

5/6 TYPICAL SECTION AT LANDING AT TOP OF RAMP
SCALE: 1/2"=1'-0"

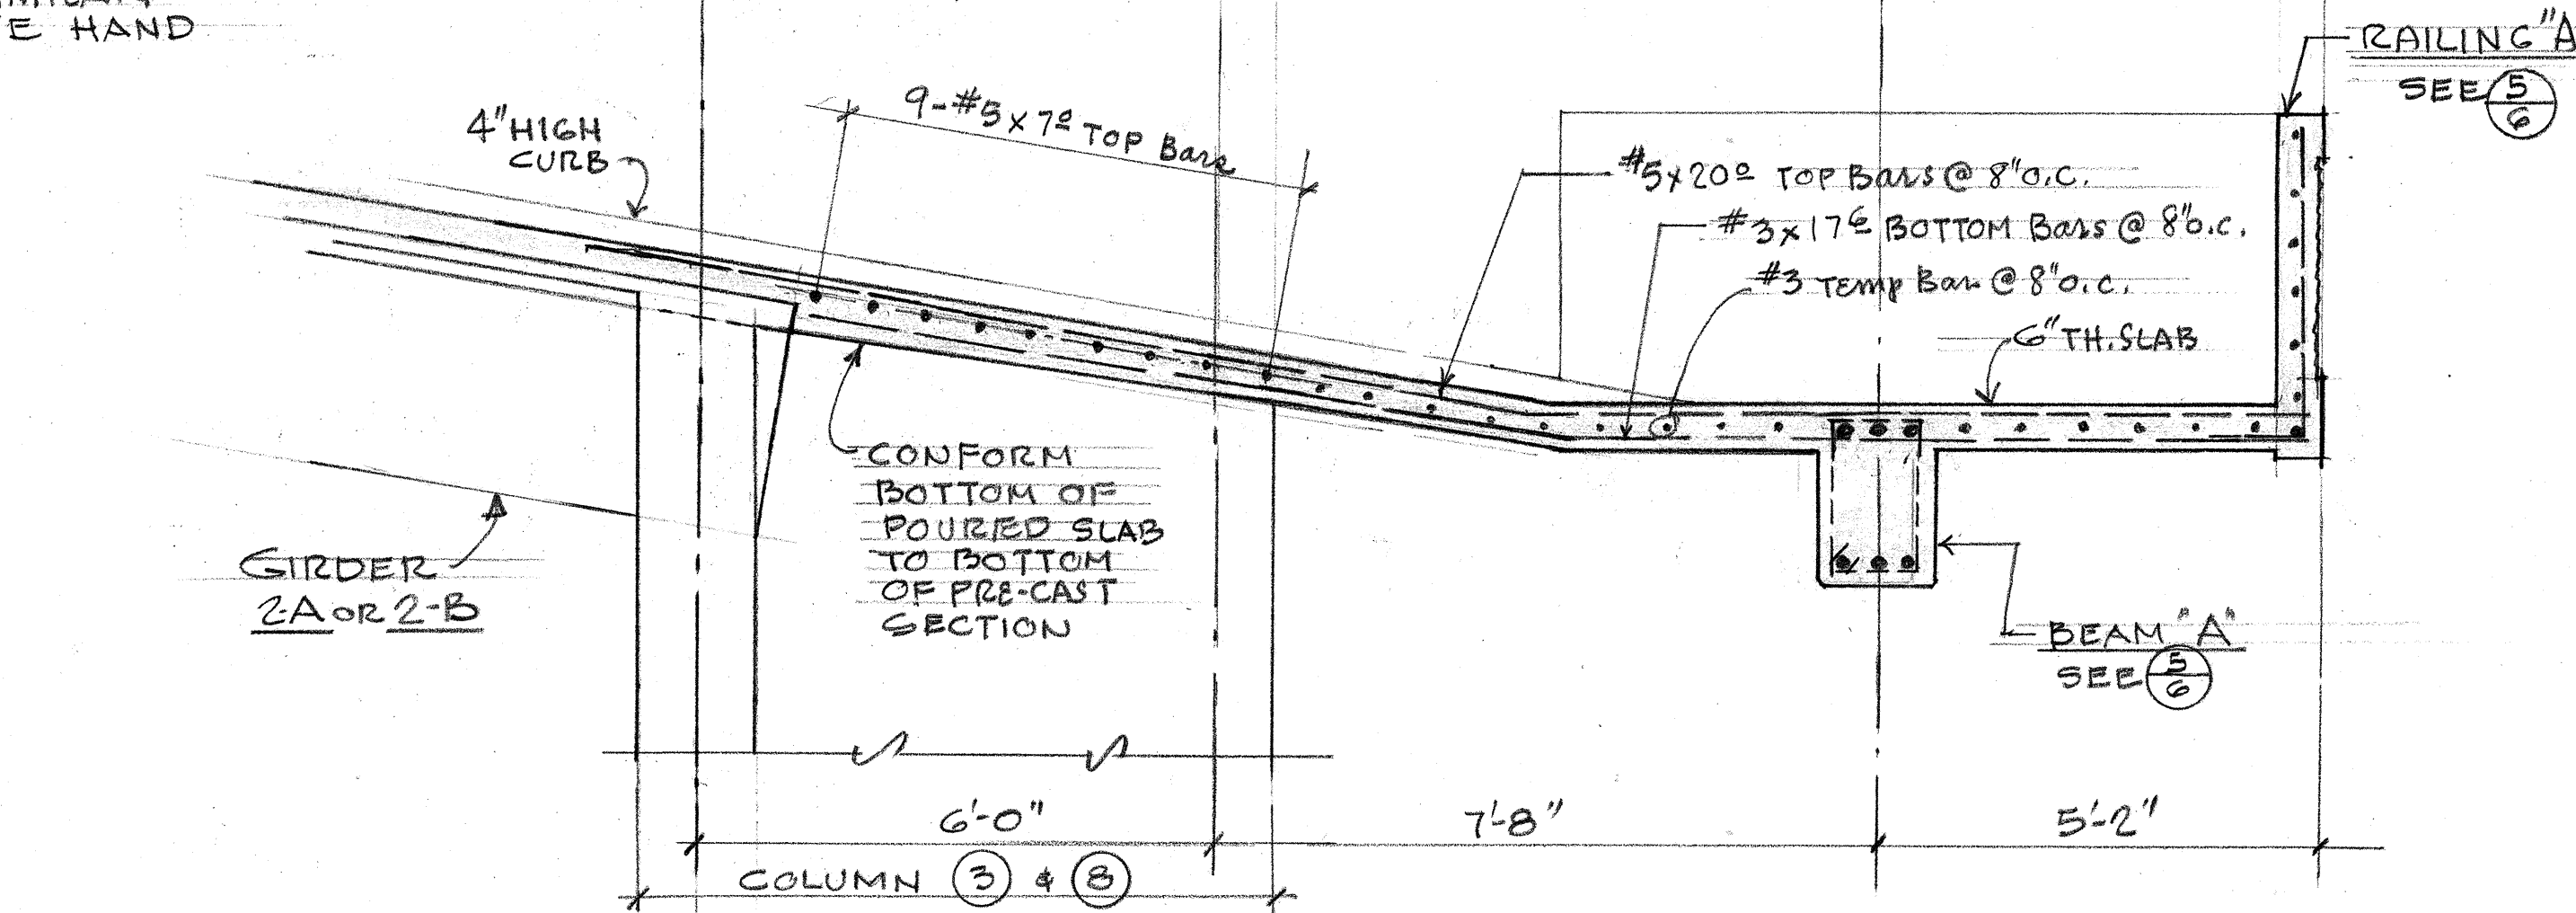

6/6 TYPICAL SECTION AT LANDING AT BOTTOM OF RAMP
SCALE: 1/2"=1'-0"

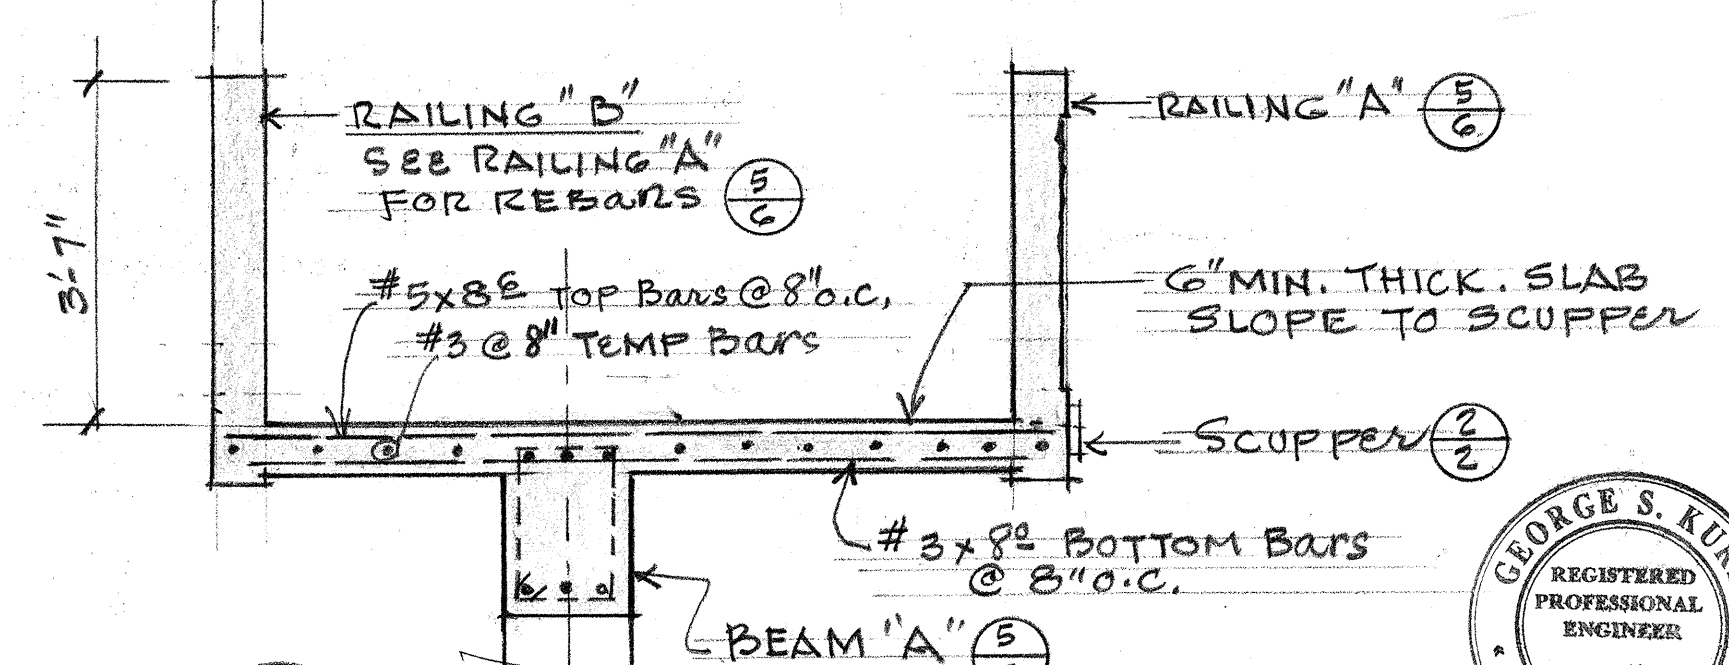

8/6 SECTION
SCALE: 1/2"=1'-0"

STATE OF HAWAII
DEPARTMENT OF TRANSPORTATION
HIGHWAYS DIVISION
PEDESTRIAN OVERPASS
PROJECT NO. 72B-02-68
KALANIANAOLE HWY. AT WAIKALUA HOME ROAD.
HONOLULU OAHU
LANDING, HORIZ. BRACING
SCALE: AS NOTED AUG. 1968
SHEET No. 6 OF 11 SHEETS

GEORGE S. KIRO
REGISTERED
PROFESSIONAL
ENGINEER
No. 781
HAWAII, U.S.A.

DATE
DESIGNED BY
CHECKED BY
NOTED BY
QUANTITIES BY
ORIGINAL PLAN