

FED. ROAD DIST. NO.	STATE	PROJ. NO.	FISCAL YEAR	SHEET NO.	TOTAL SHEETS
HAWAII	HAW.	72B-02-68	1968	1	13

STATE OF HAWAII

DEPARTMENT OF TRANSPORTATION

HIGHWAYS DIVISION

"AS BUILT" PLANS OF

PEDESTRIAN OVERPASS OVER

KALANIANA'OLE HIGHWAY AT LUNALILO HOME ROAD

PROJECT NO. 72B-02-68

DISTRICT OF HONOLULU


ISLAND OF OAHU

NOTE:

ALL CHANGES MADE DURING CONSTRUCTION
HAVE BEEN NOTED IN RED ON THESE TRACINGS
AND CHECKED BY:

[Signature]
PROJECT ENGINEER

6/12/72
DATE

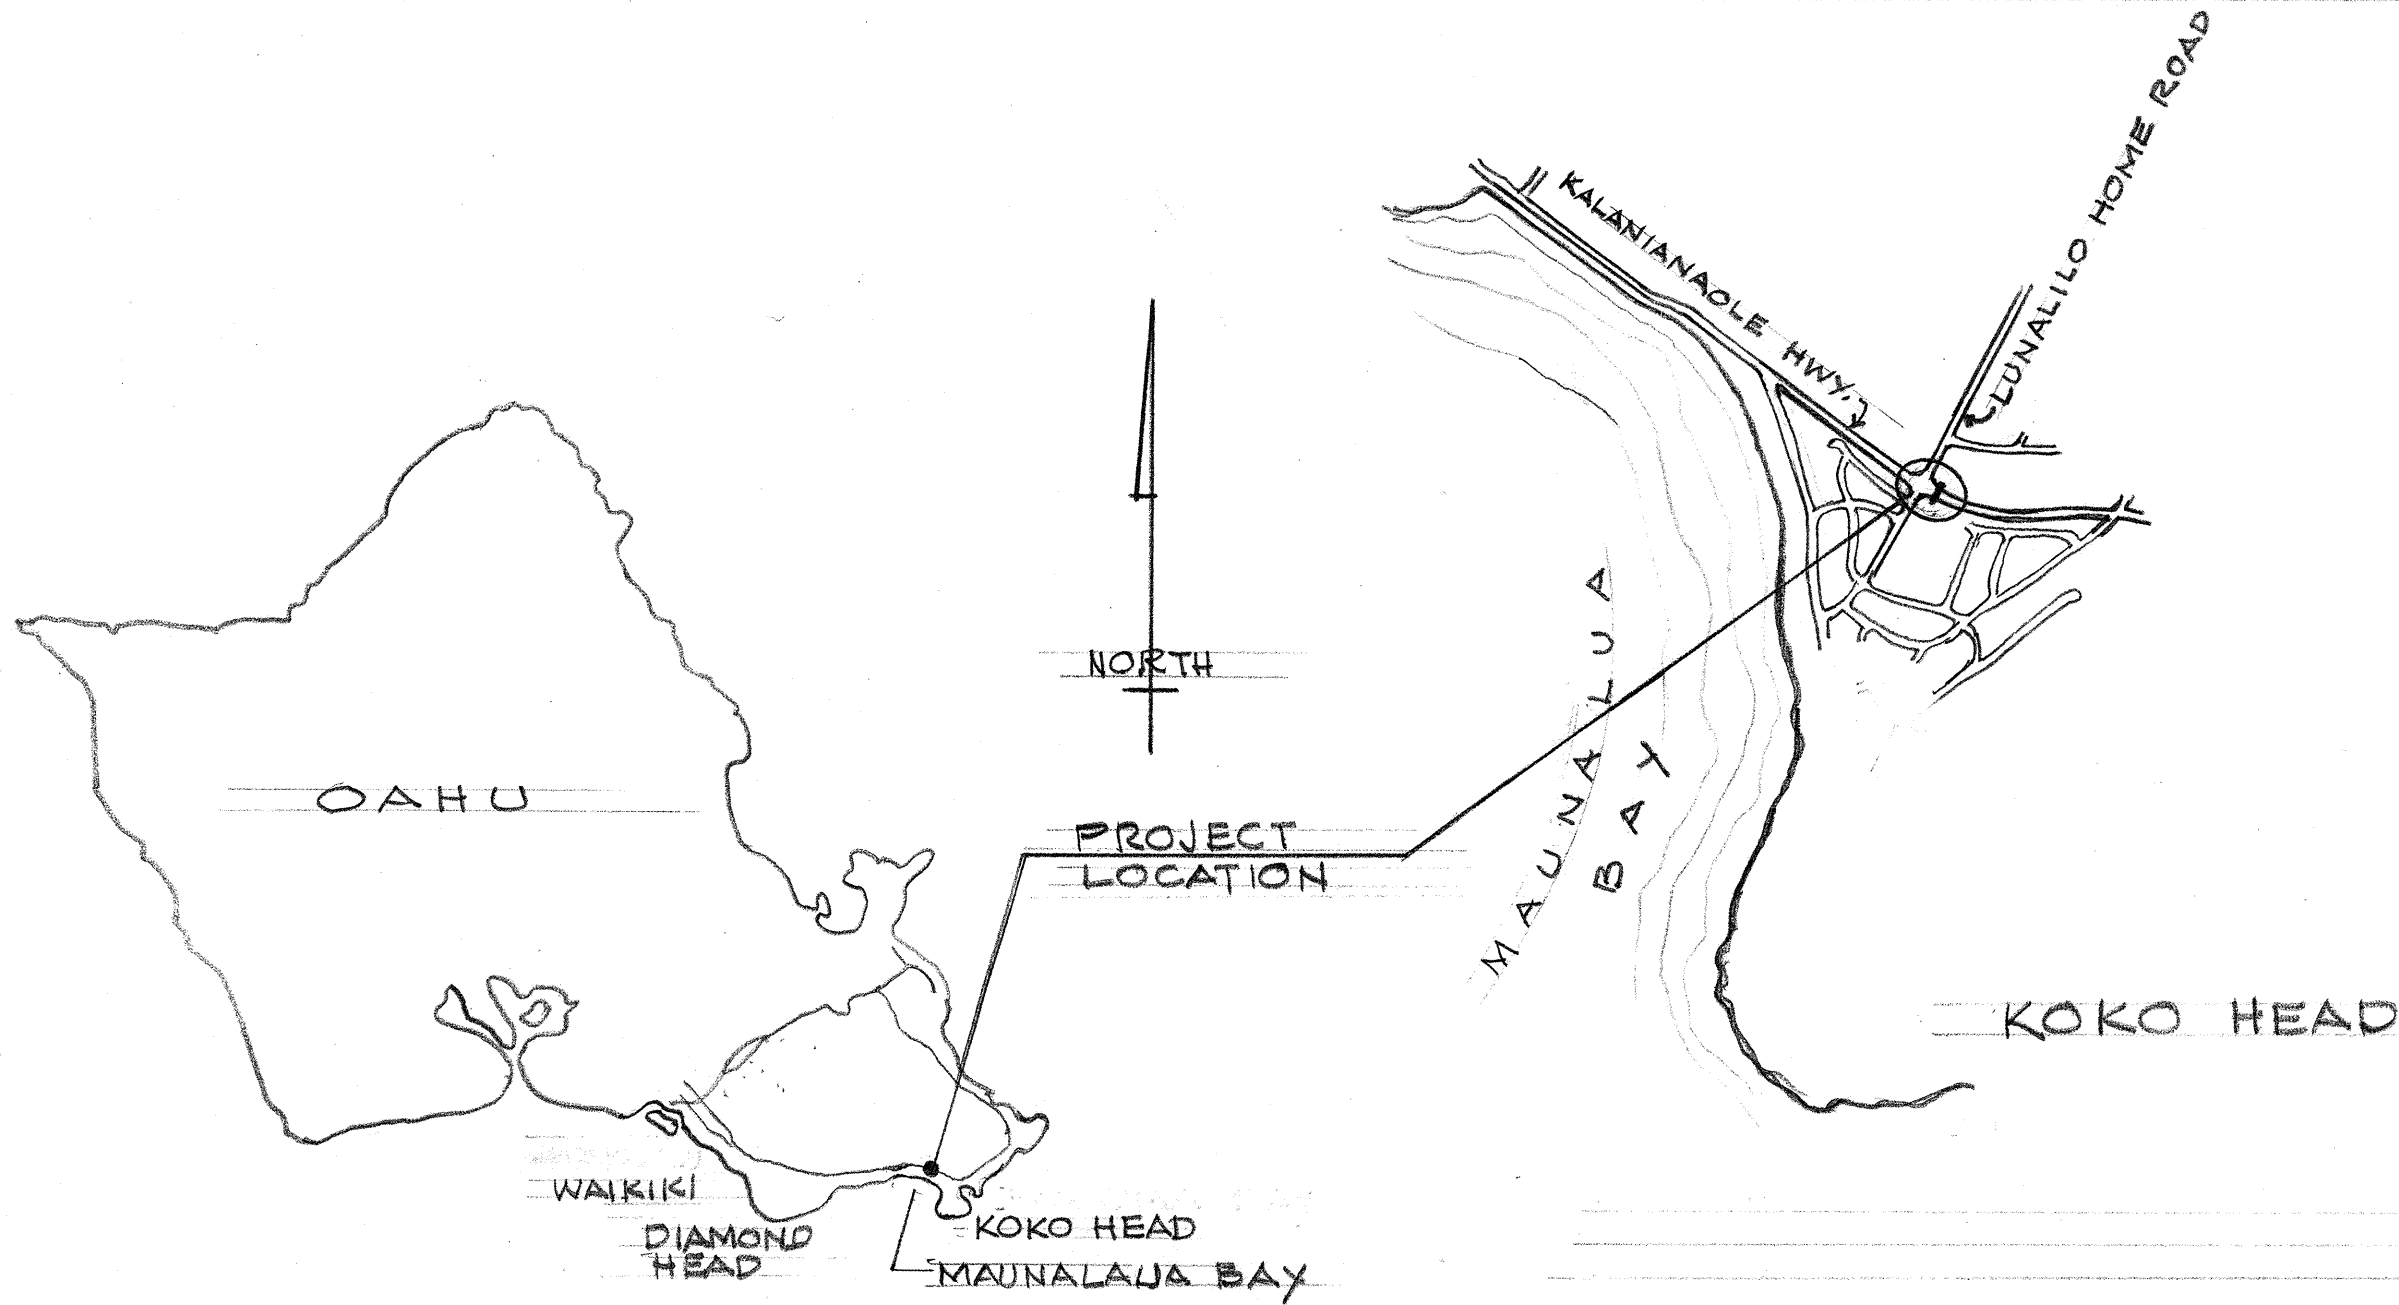

LOCATION MAPS

NO SCALE

SUBMITTED BY:


GEORGE S. KURIO, P.E.

APPROVED BY:

E. Alvey Knight

Asy DIRECTOR OF TRANSPORTATION

SHEET	INDEX TO DRAWINGS
1 & 2	PLAN & SITE PLAN
3	ELEVATIONS
4	FOUNDATION
5	STRUCTURAL PLAN
6	GIRDERS, POURED DECK
7	LANDING, HORIZ. BRACING
8	COLUMNS 3, 8, 11 & 12
9	COLUMN CAPITALS
10 - 13	METAL GUARD RAIL

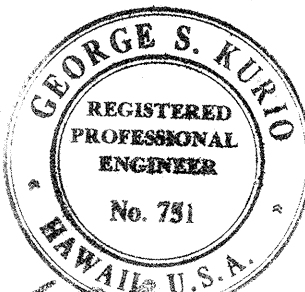

R. TERADA

