

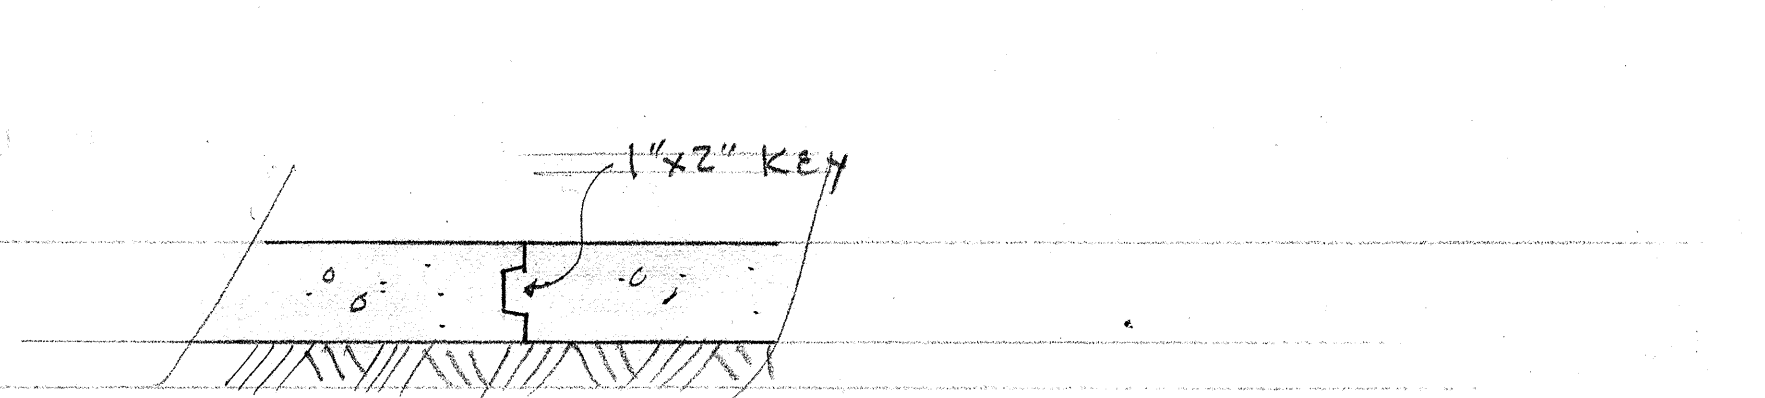
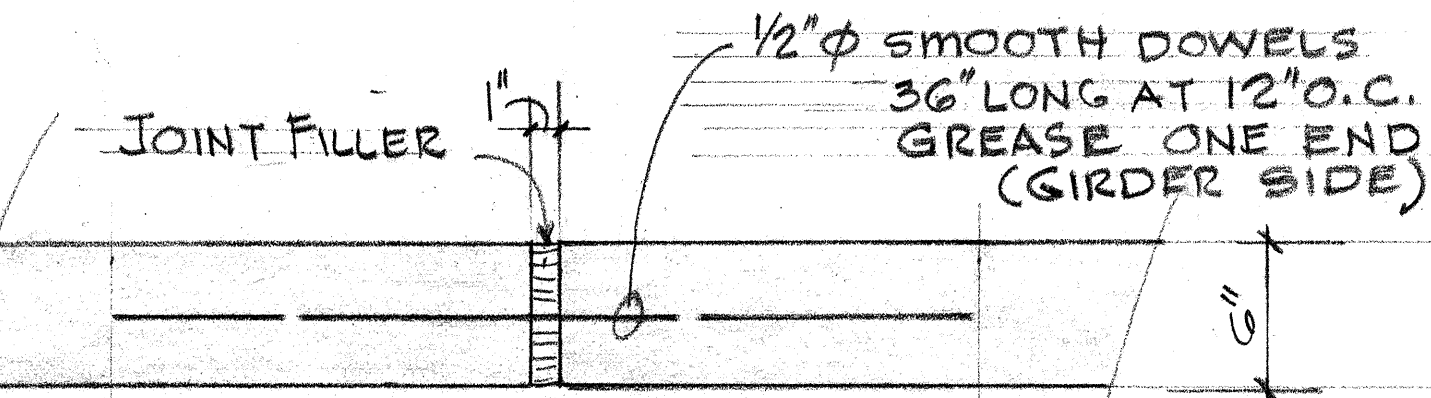
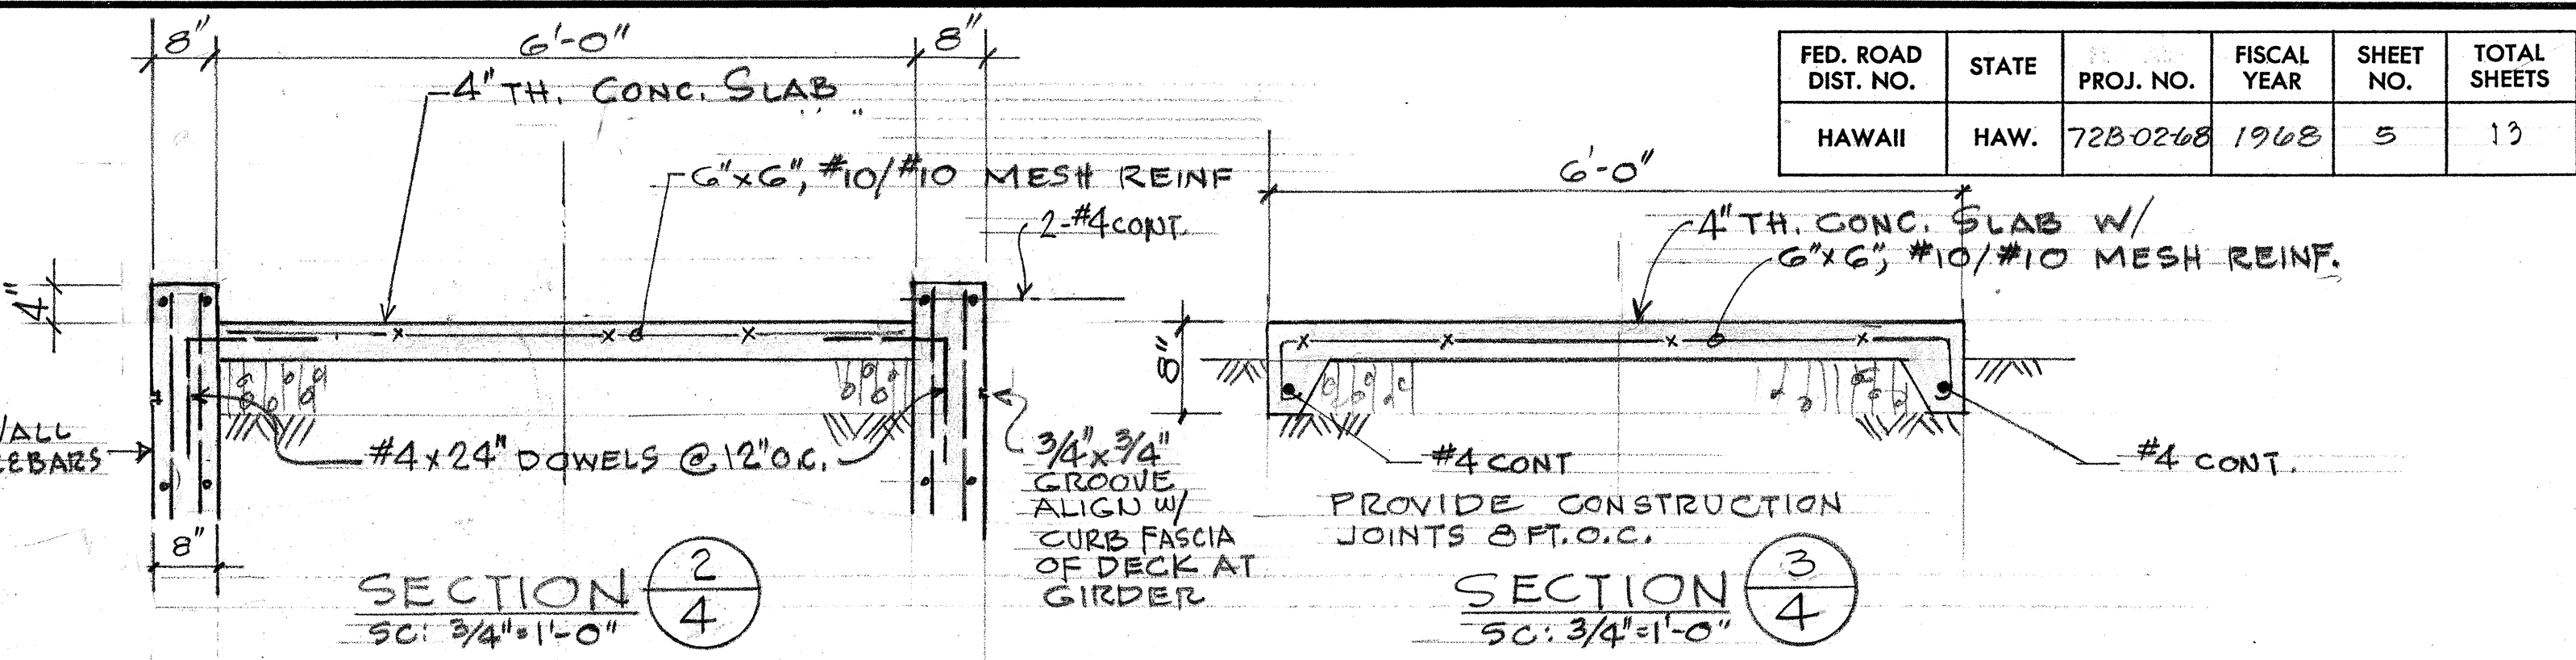


FED. ROAD DIST. NO.	STATE	PROJ. NO.	FISCAL YEAR	SHEET NO.	TOTAL SHEETS
HAWAII	HAW.	72B-02-68	1968	5	12

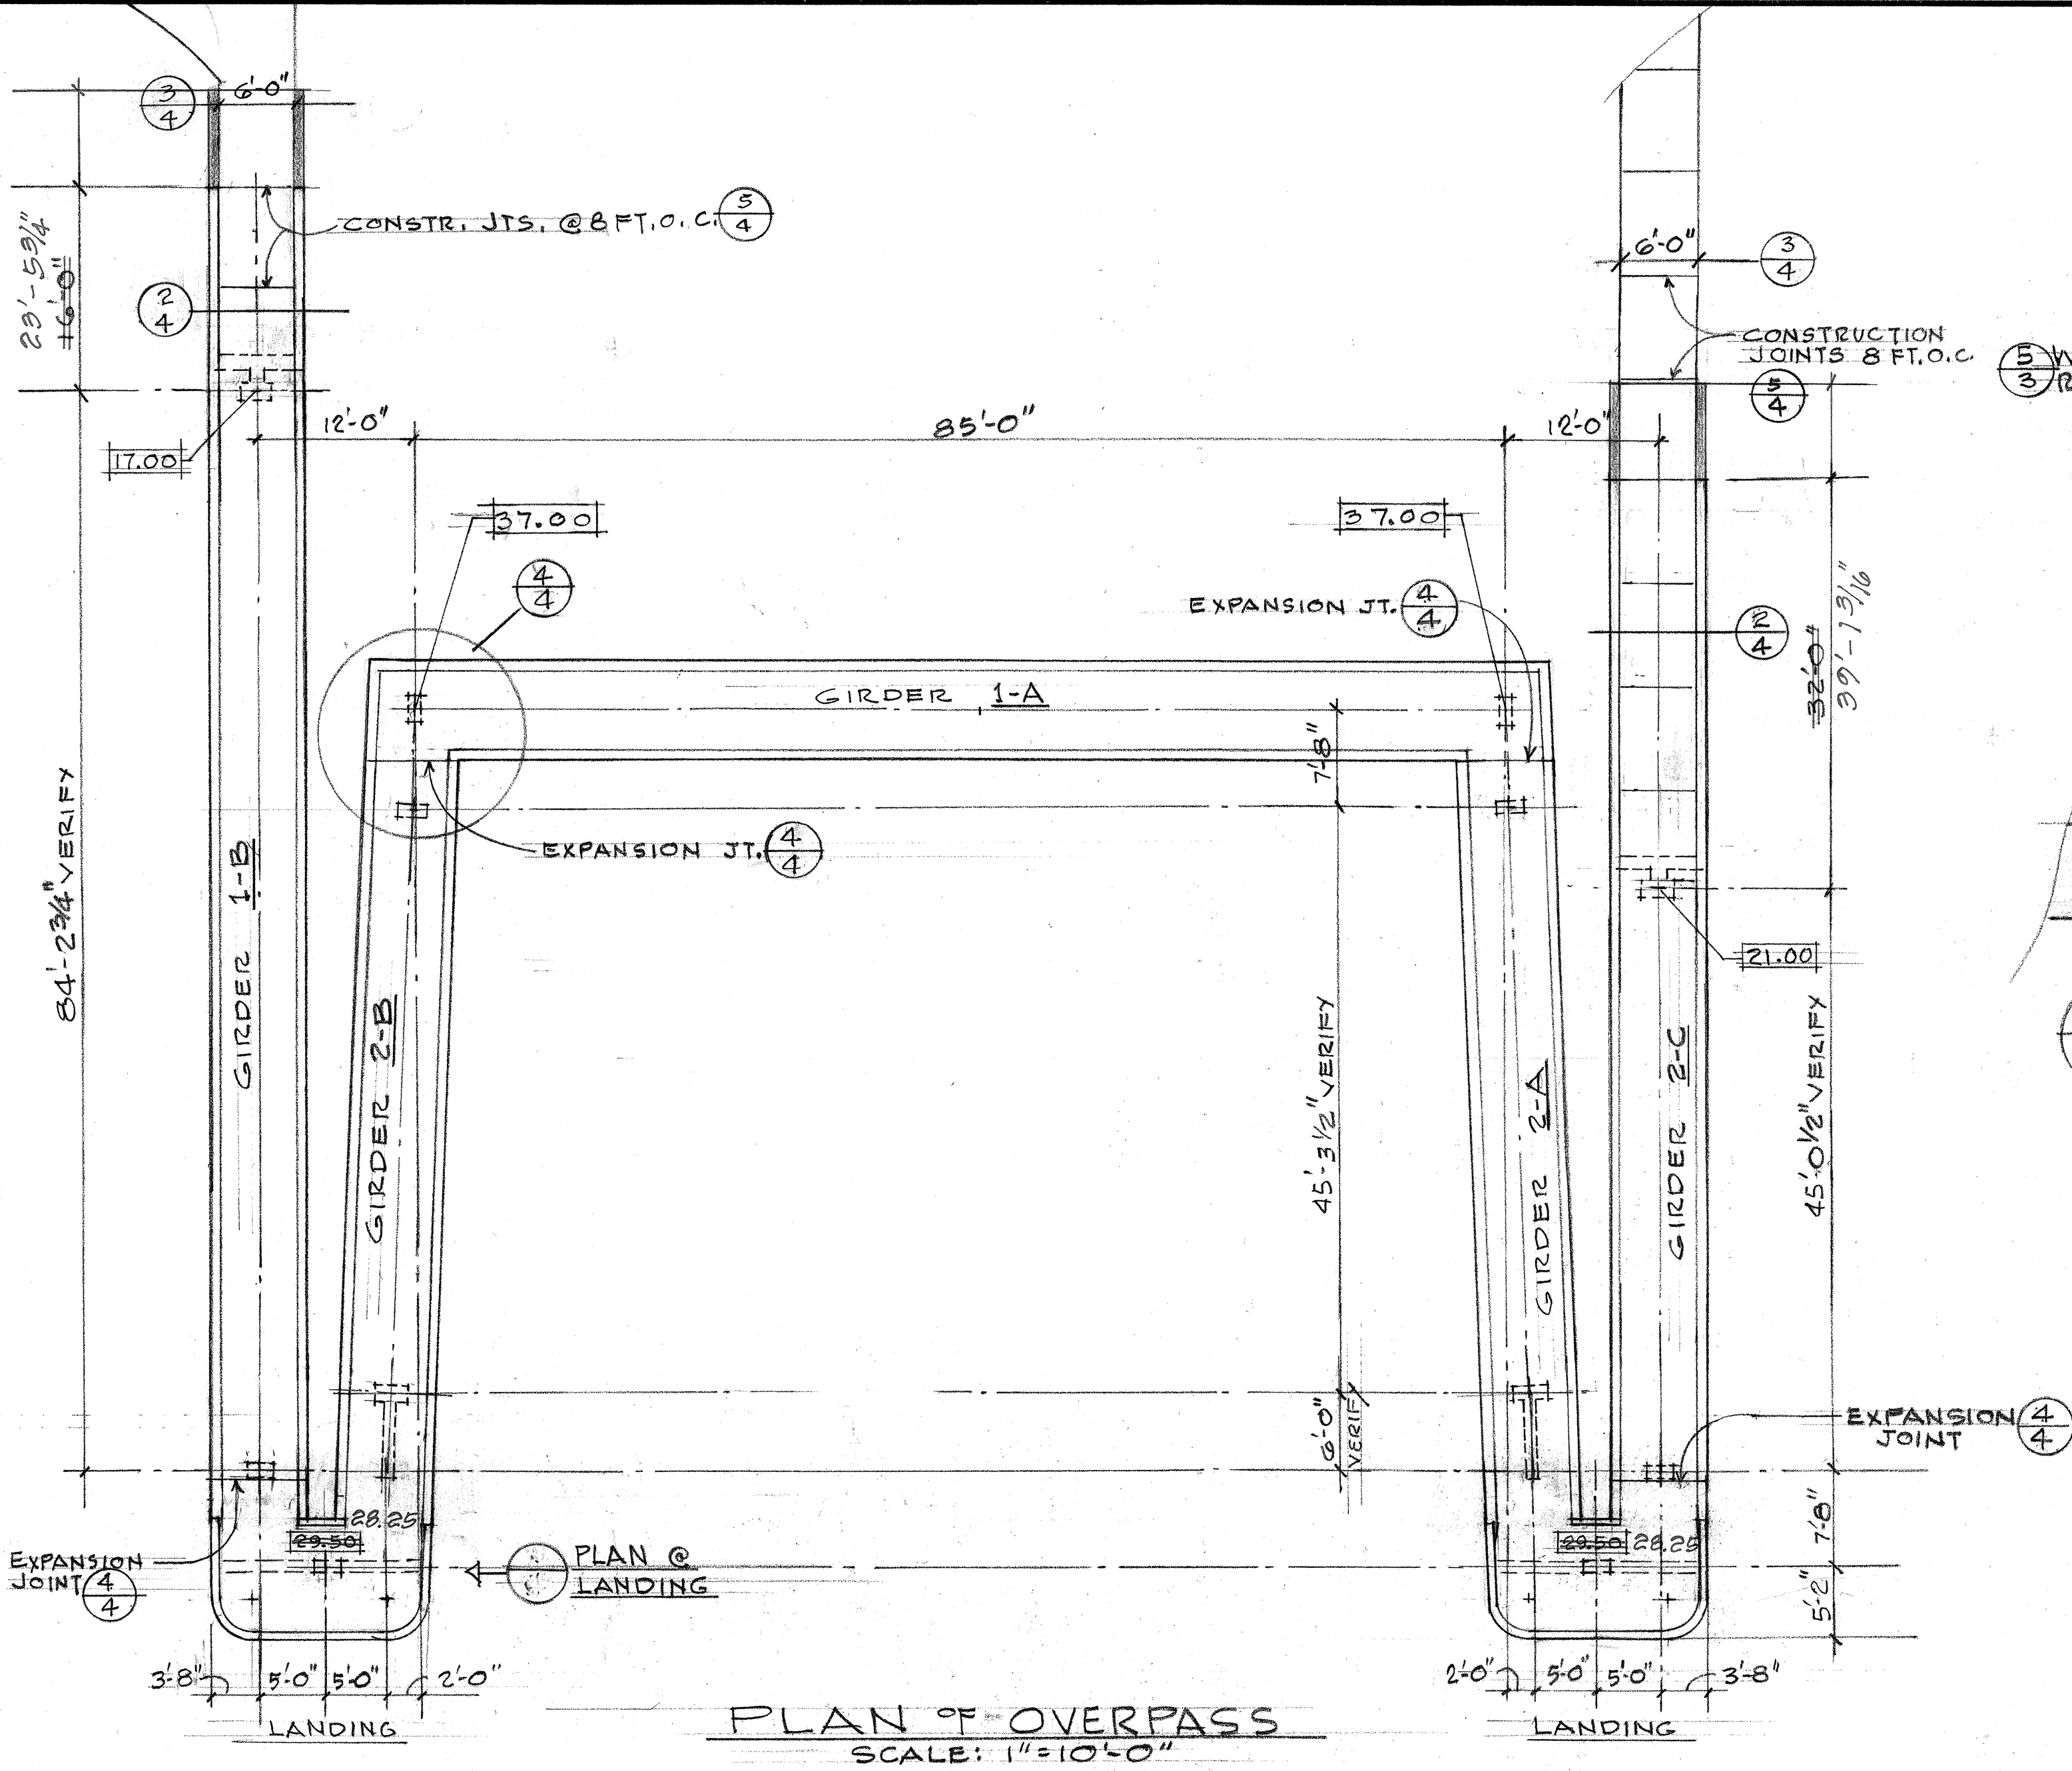

4 TYPICAL EXPANSION JOINT AT SLAB SCALE: 1/2"=1'-0"

5 TYPICAL CONSTRUCTION JOINT - SLAB ON GRADE SCALE: 1/2"=1'-0"

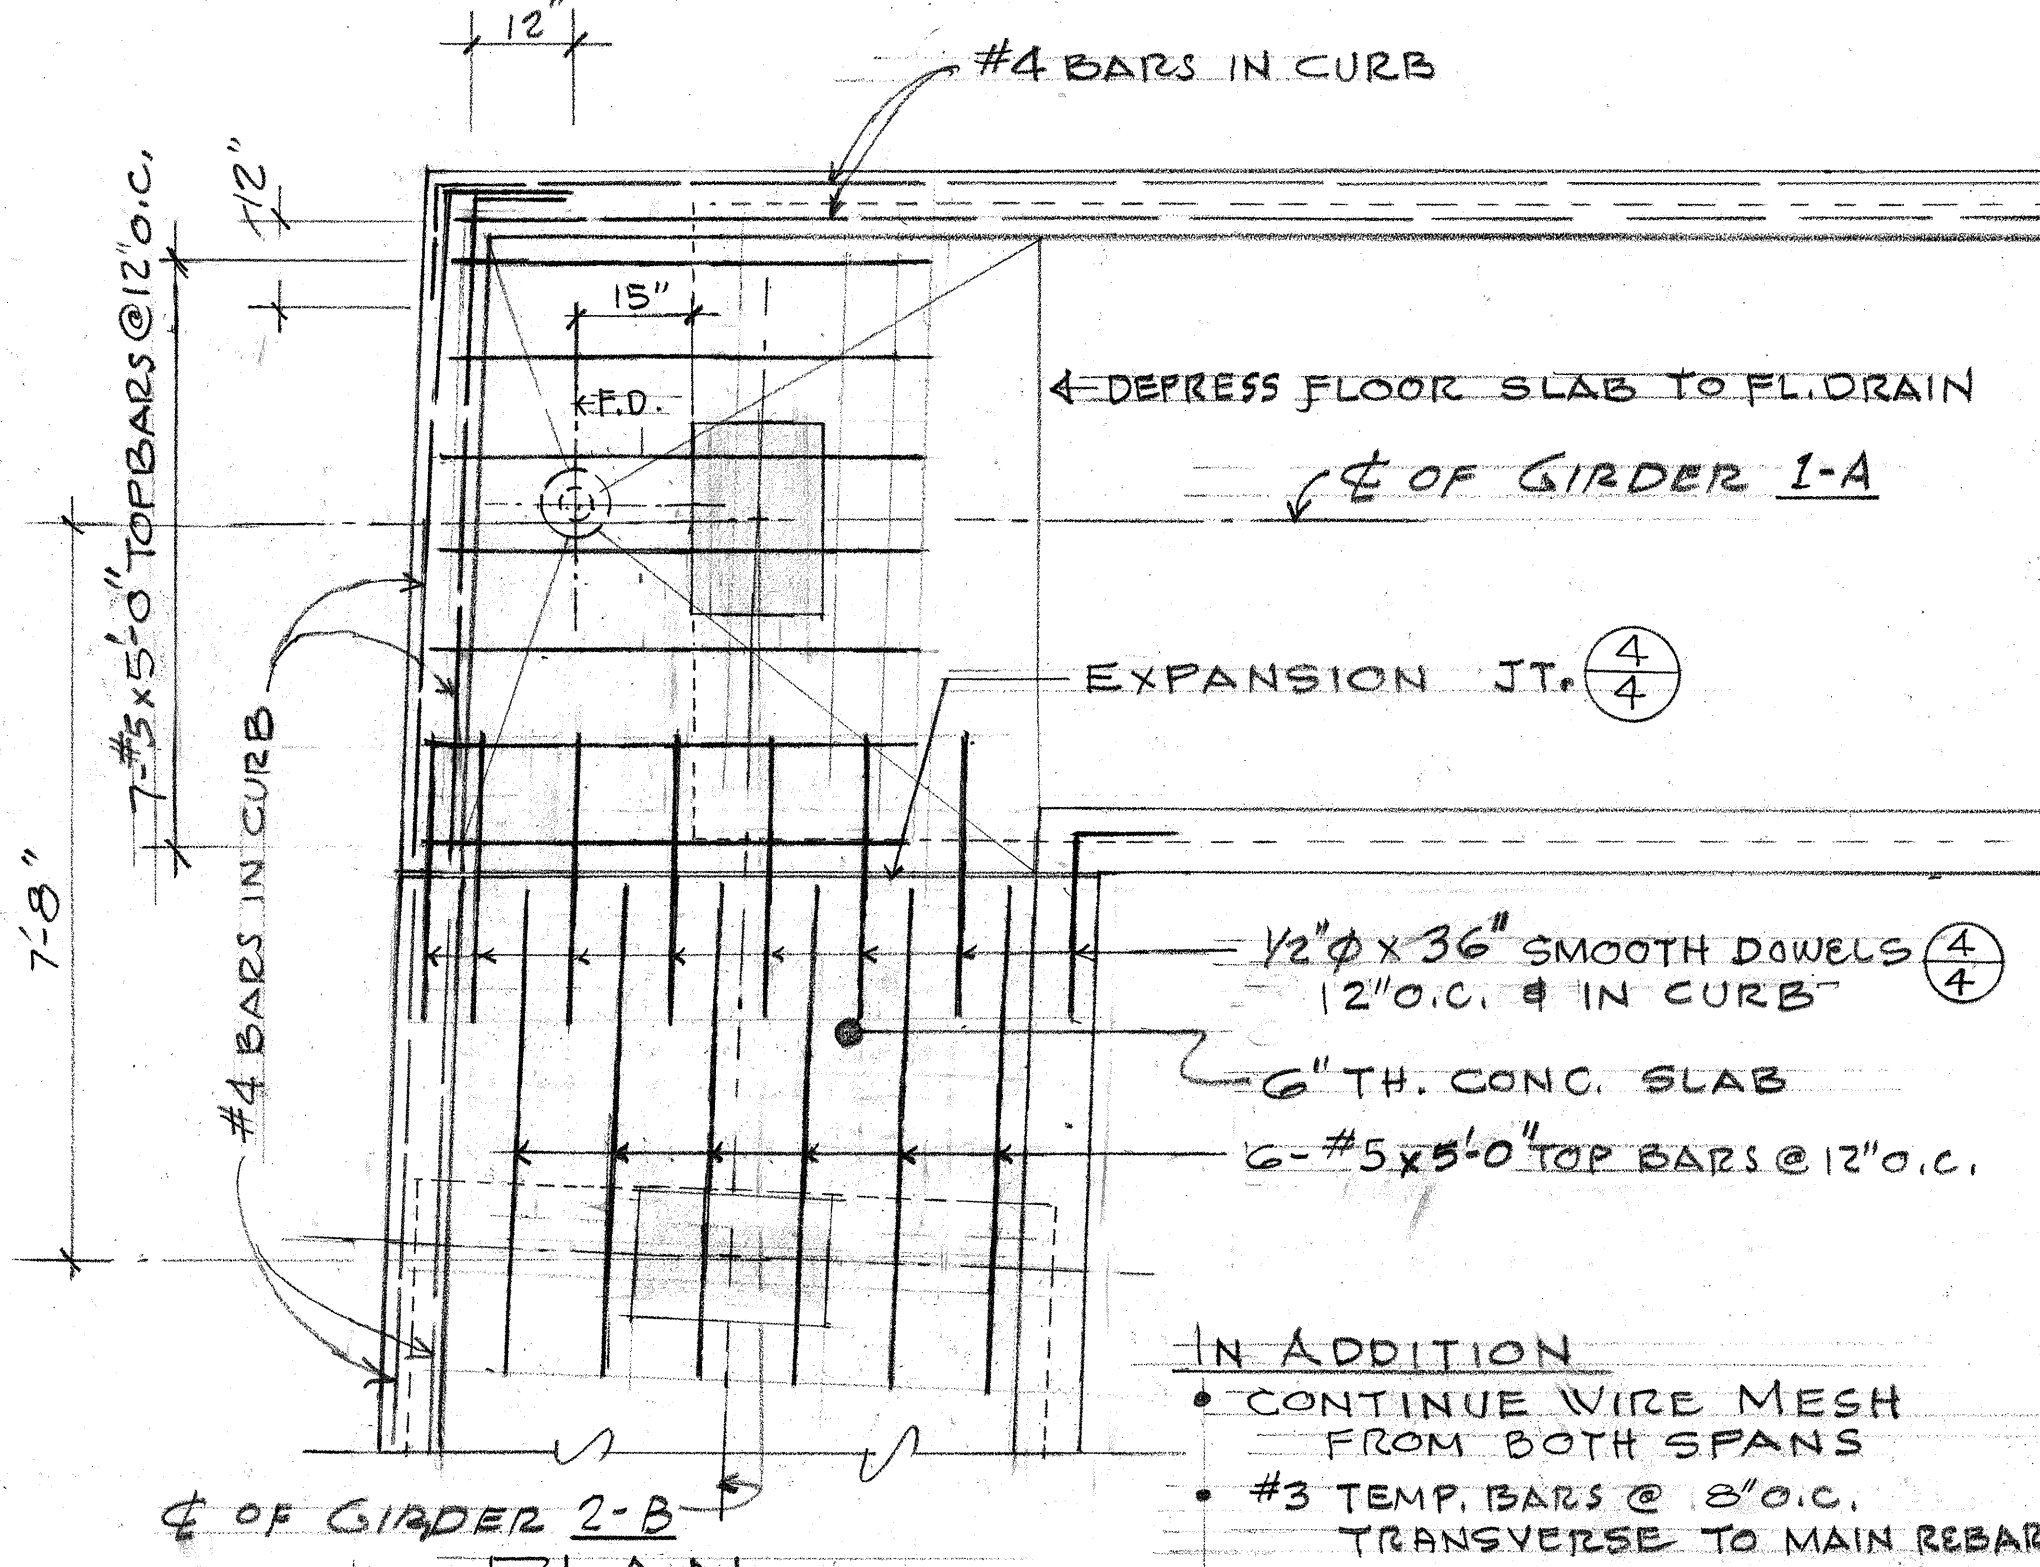

1 SLAB CONNECTION @ GIRDERS 1-A & 2-B SCALE: 1/2"=1'-0" SLAB CONNECTION @ GIRDER 1-A & 2-A SIMILAR

ORIGINAL PLAN	DATE
DESIGNED BY	
NOTED BY	
CHECKED BY	
QUANTITIES BY	
NO.	

STATE OF HAWAII
DEPARTMENT OF TRANSPORTATION
HIGHWAYS DIVISION

PEDESTRIAN OVERPASS
PROJECT No. 72B-02-68
KALANIANA'OLE HWY AT LUALABU HOMERD.
HONOLULU OAHU

STRUCTURAL PLAN
SCALE: AS NOTED AUG. 1968
SHEET No. 4 OF 11 SHEETS

