
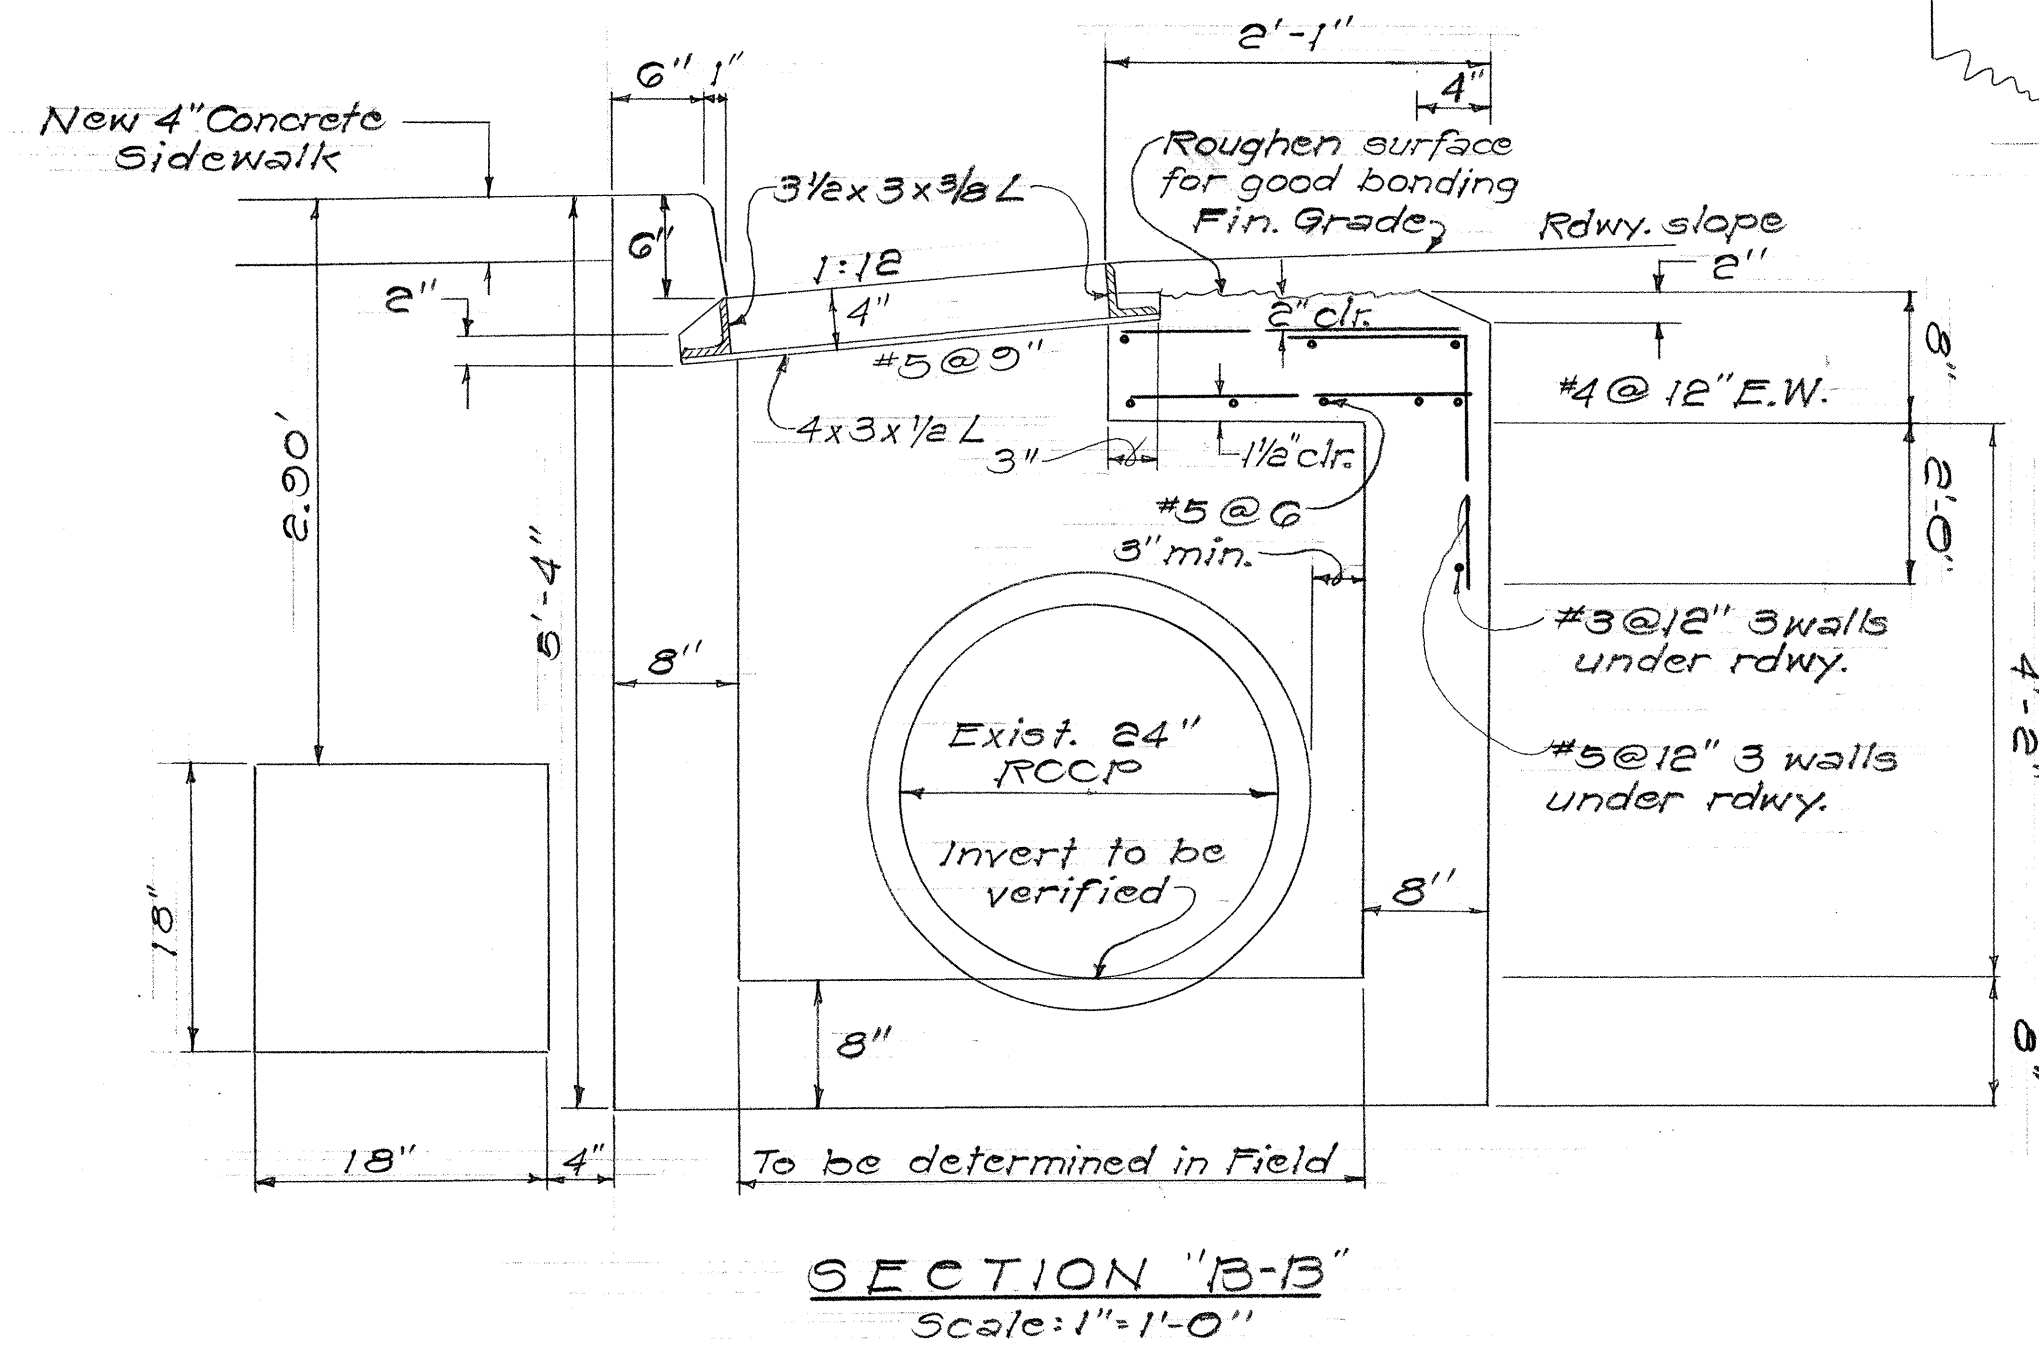
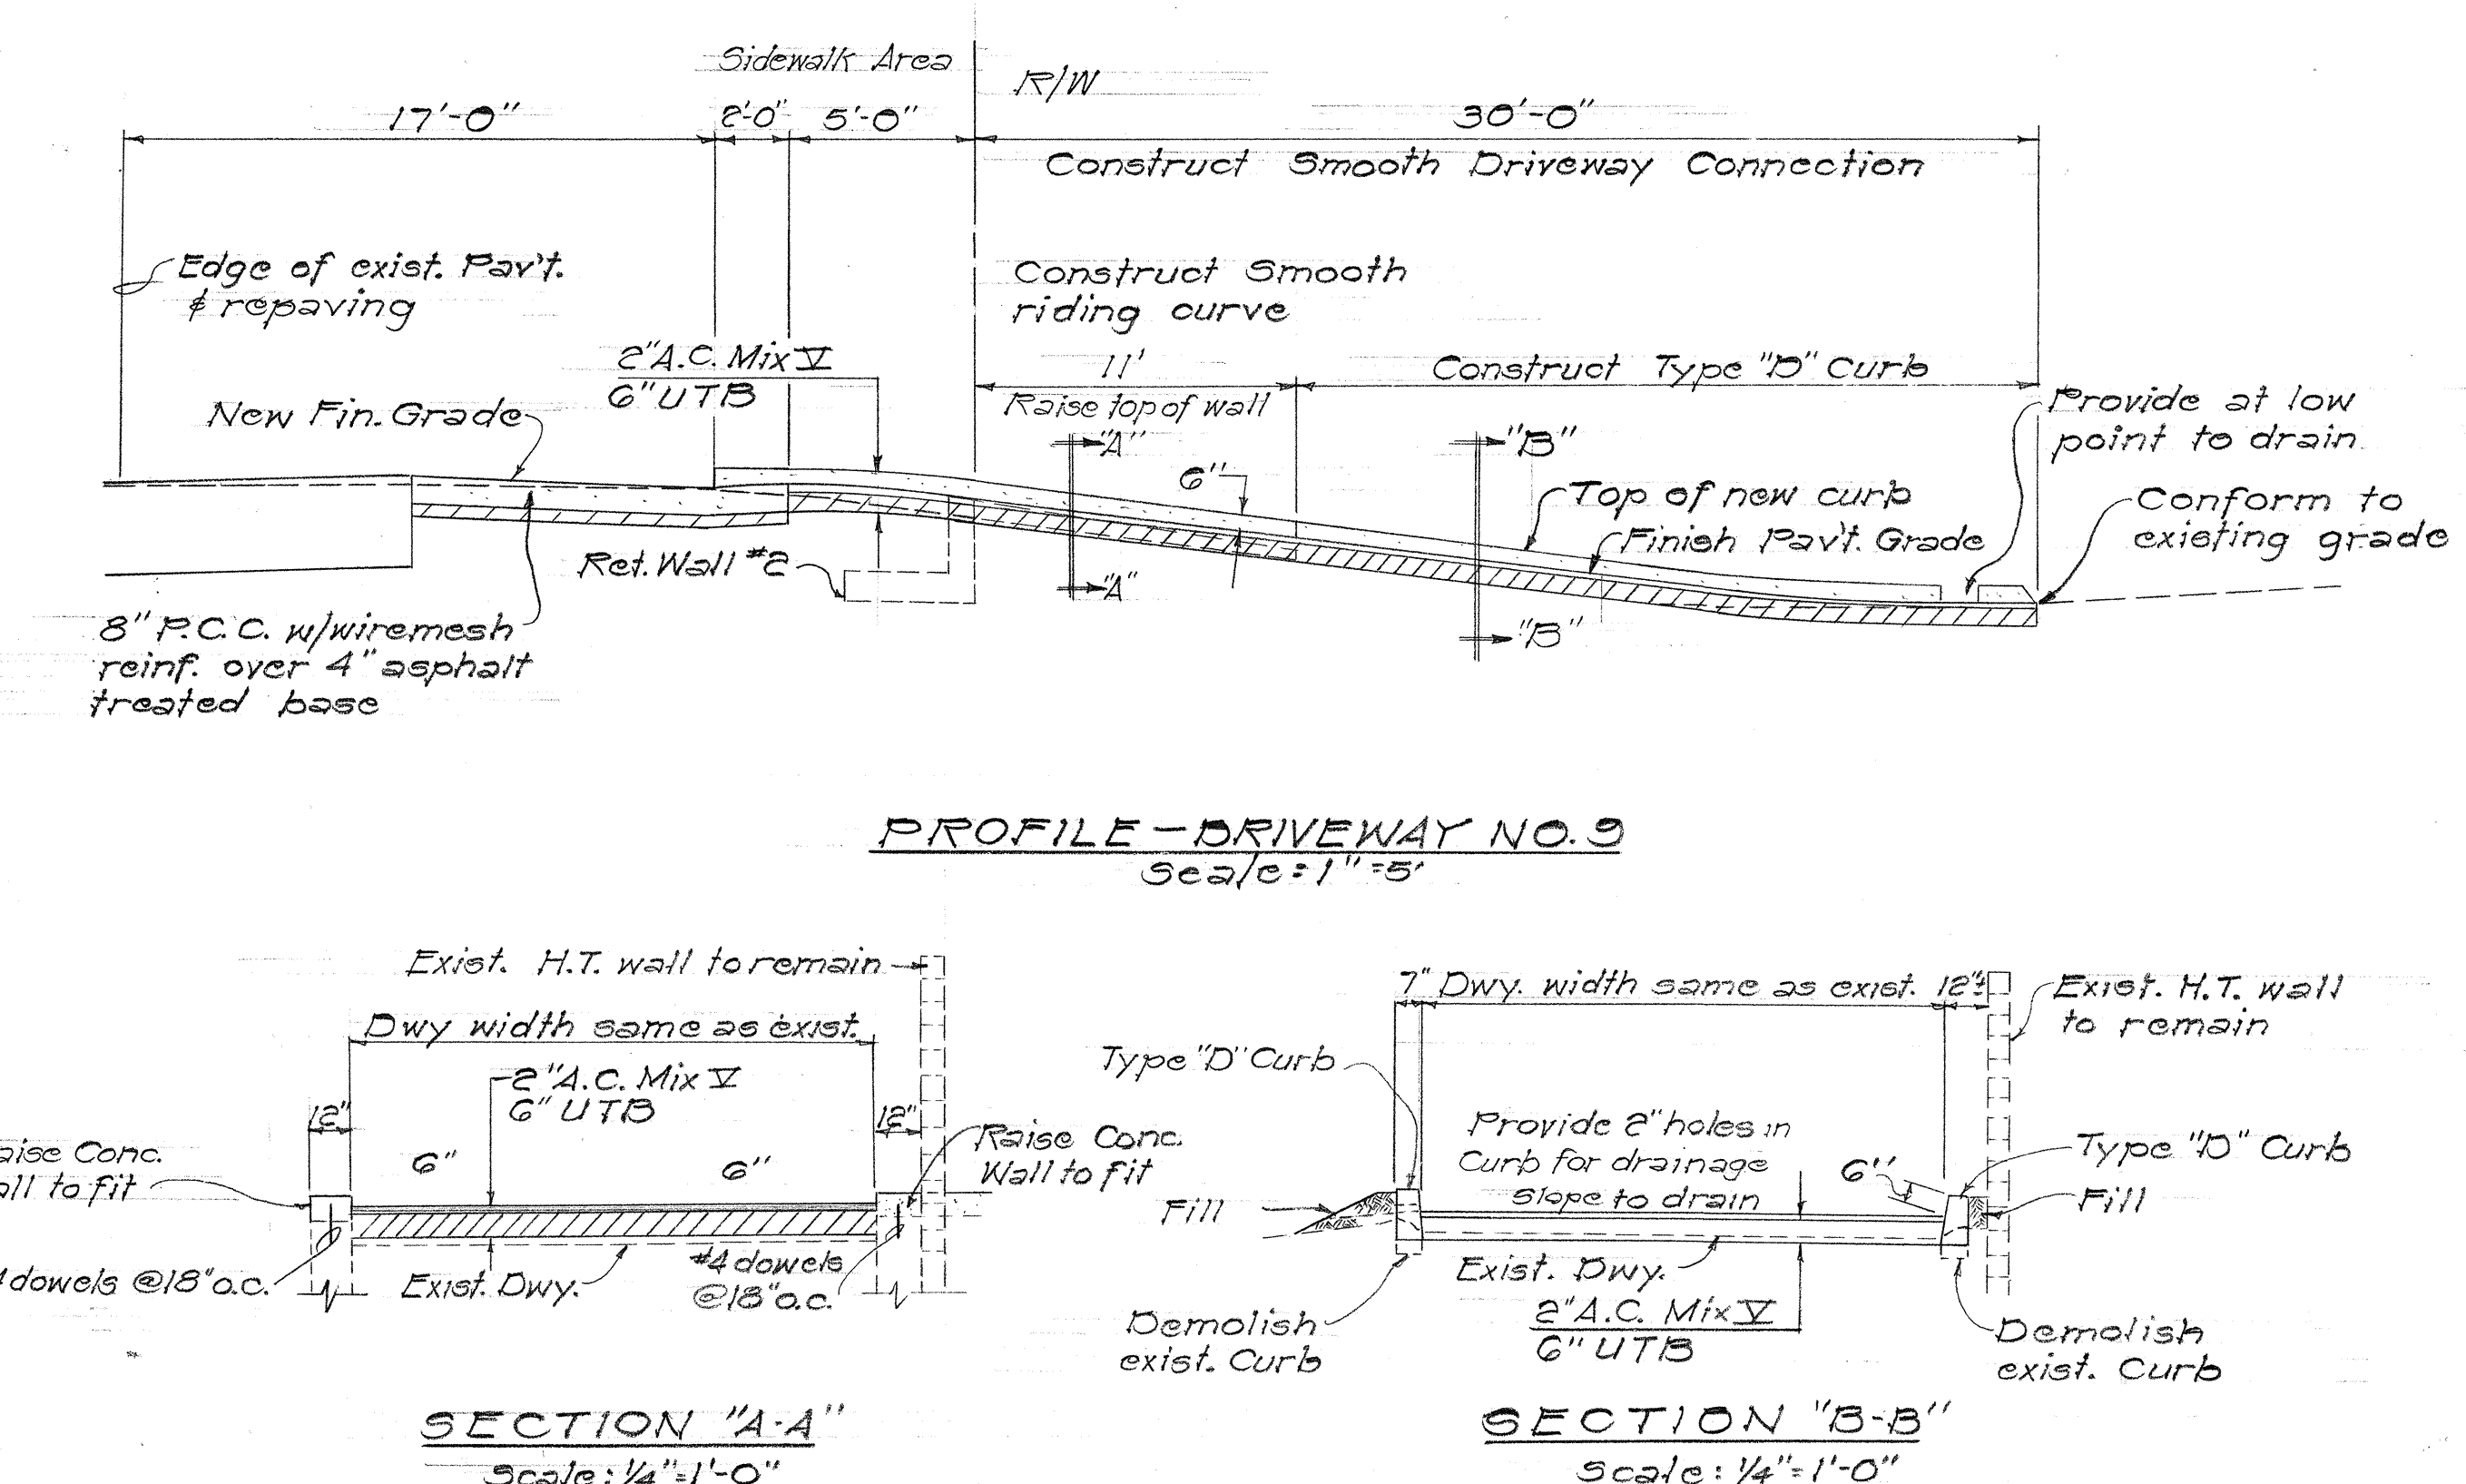
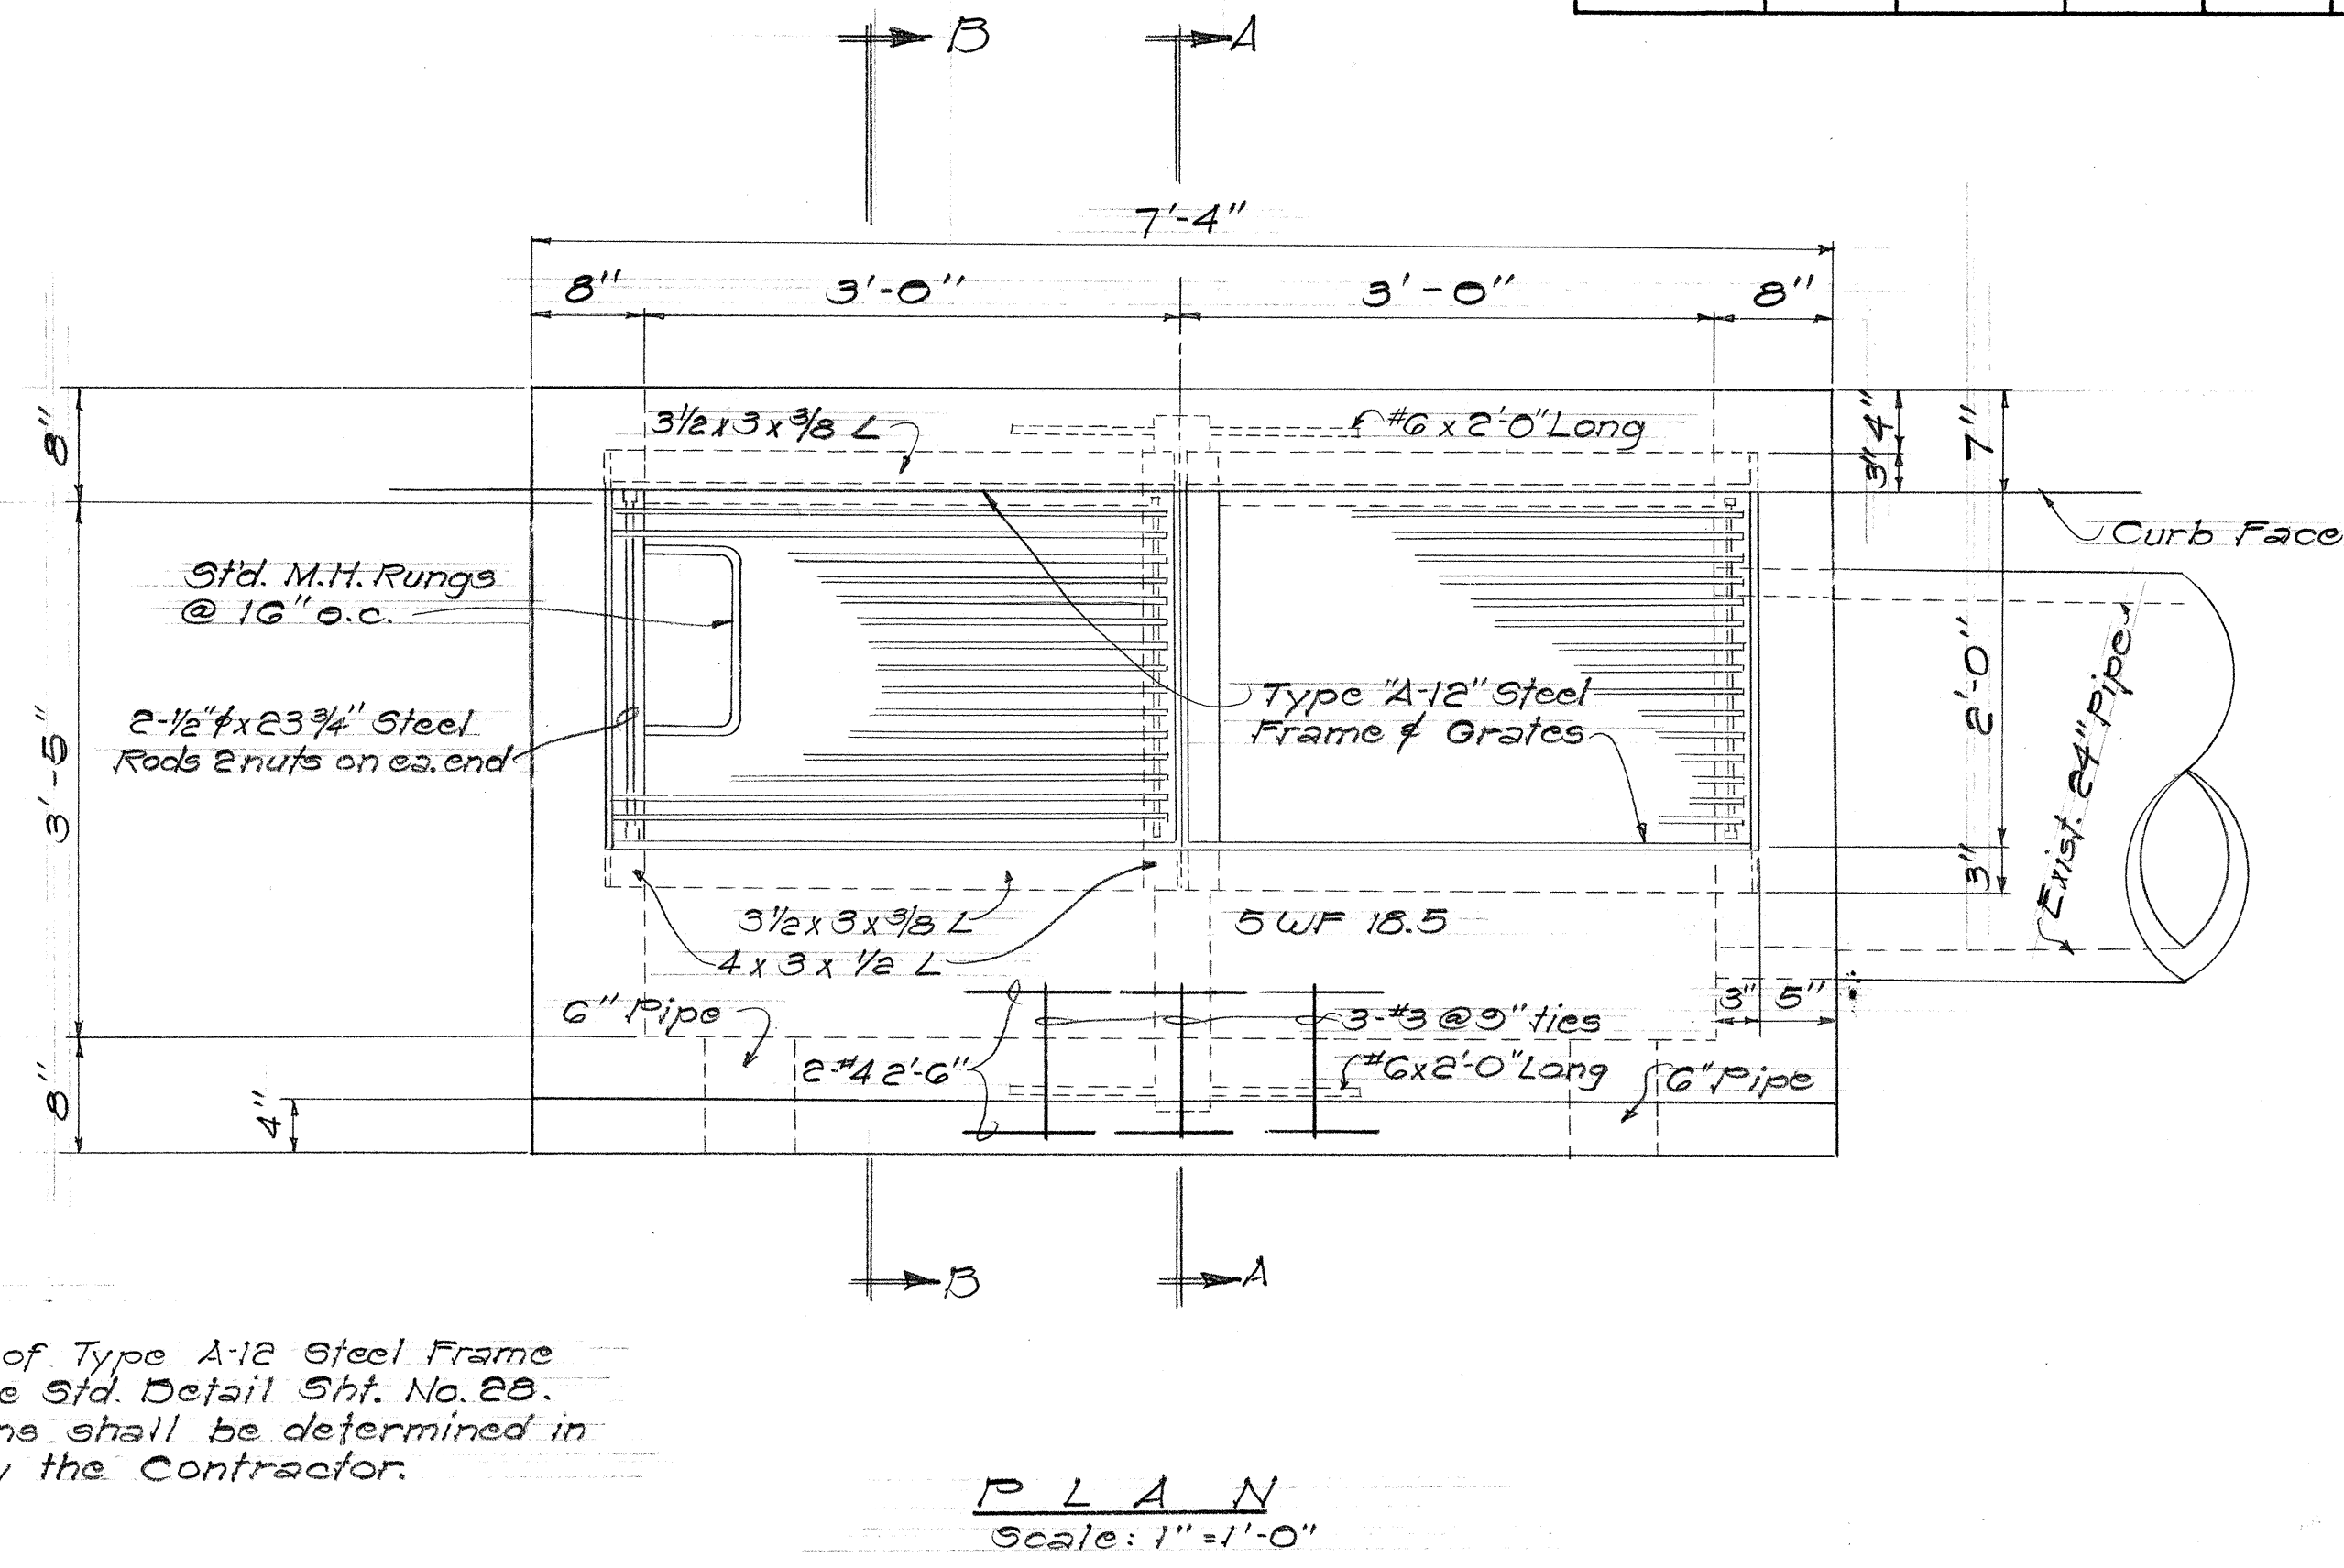


FED. ROAD DIST. NO.	STATE	FED. AID PROJ. NO.	FISCAL YEAR	SHEET NO.	TOTAL SHEETS
HAWAII	HAW.	72B03-68 UNIT I	1968	503-1	50

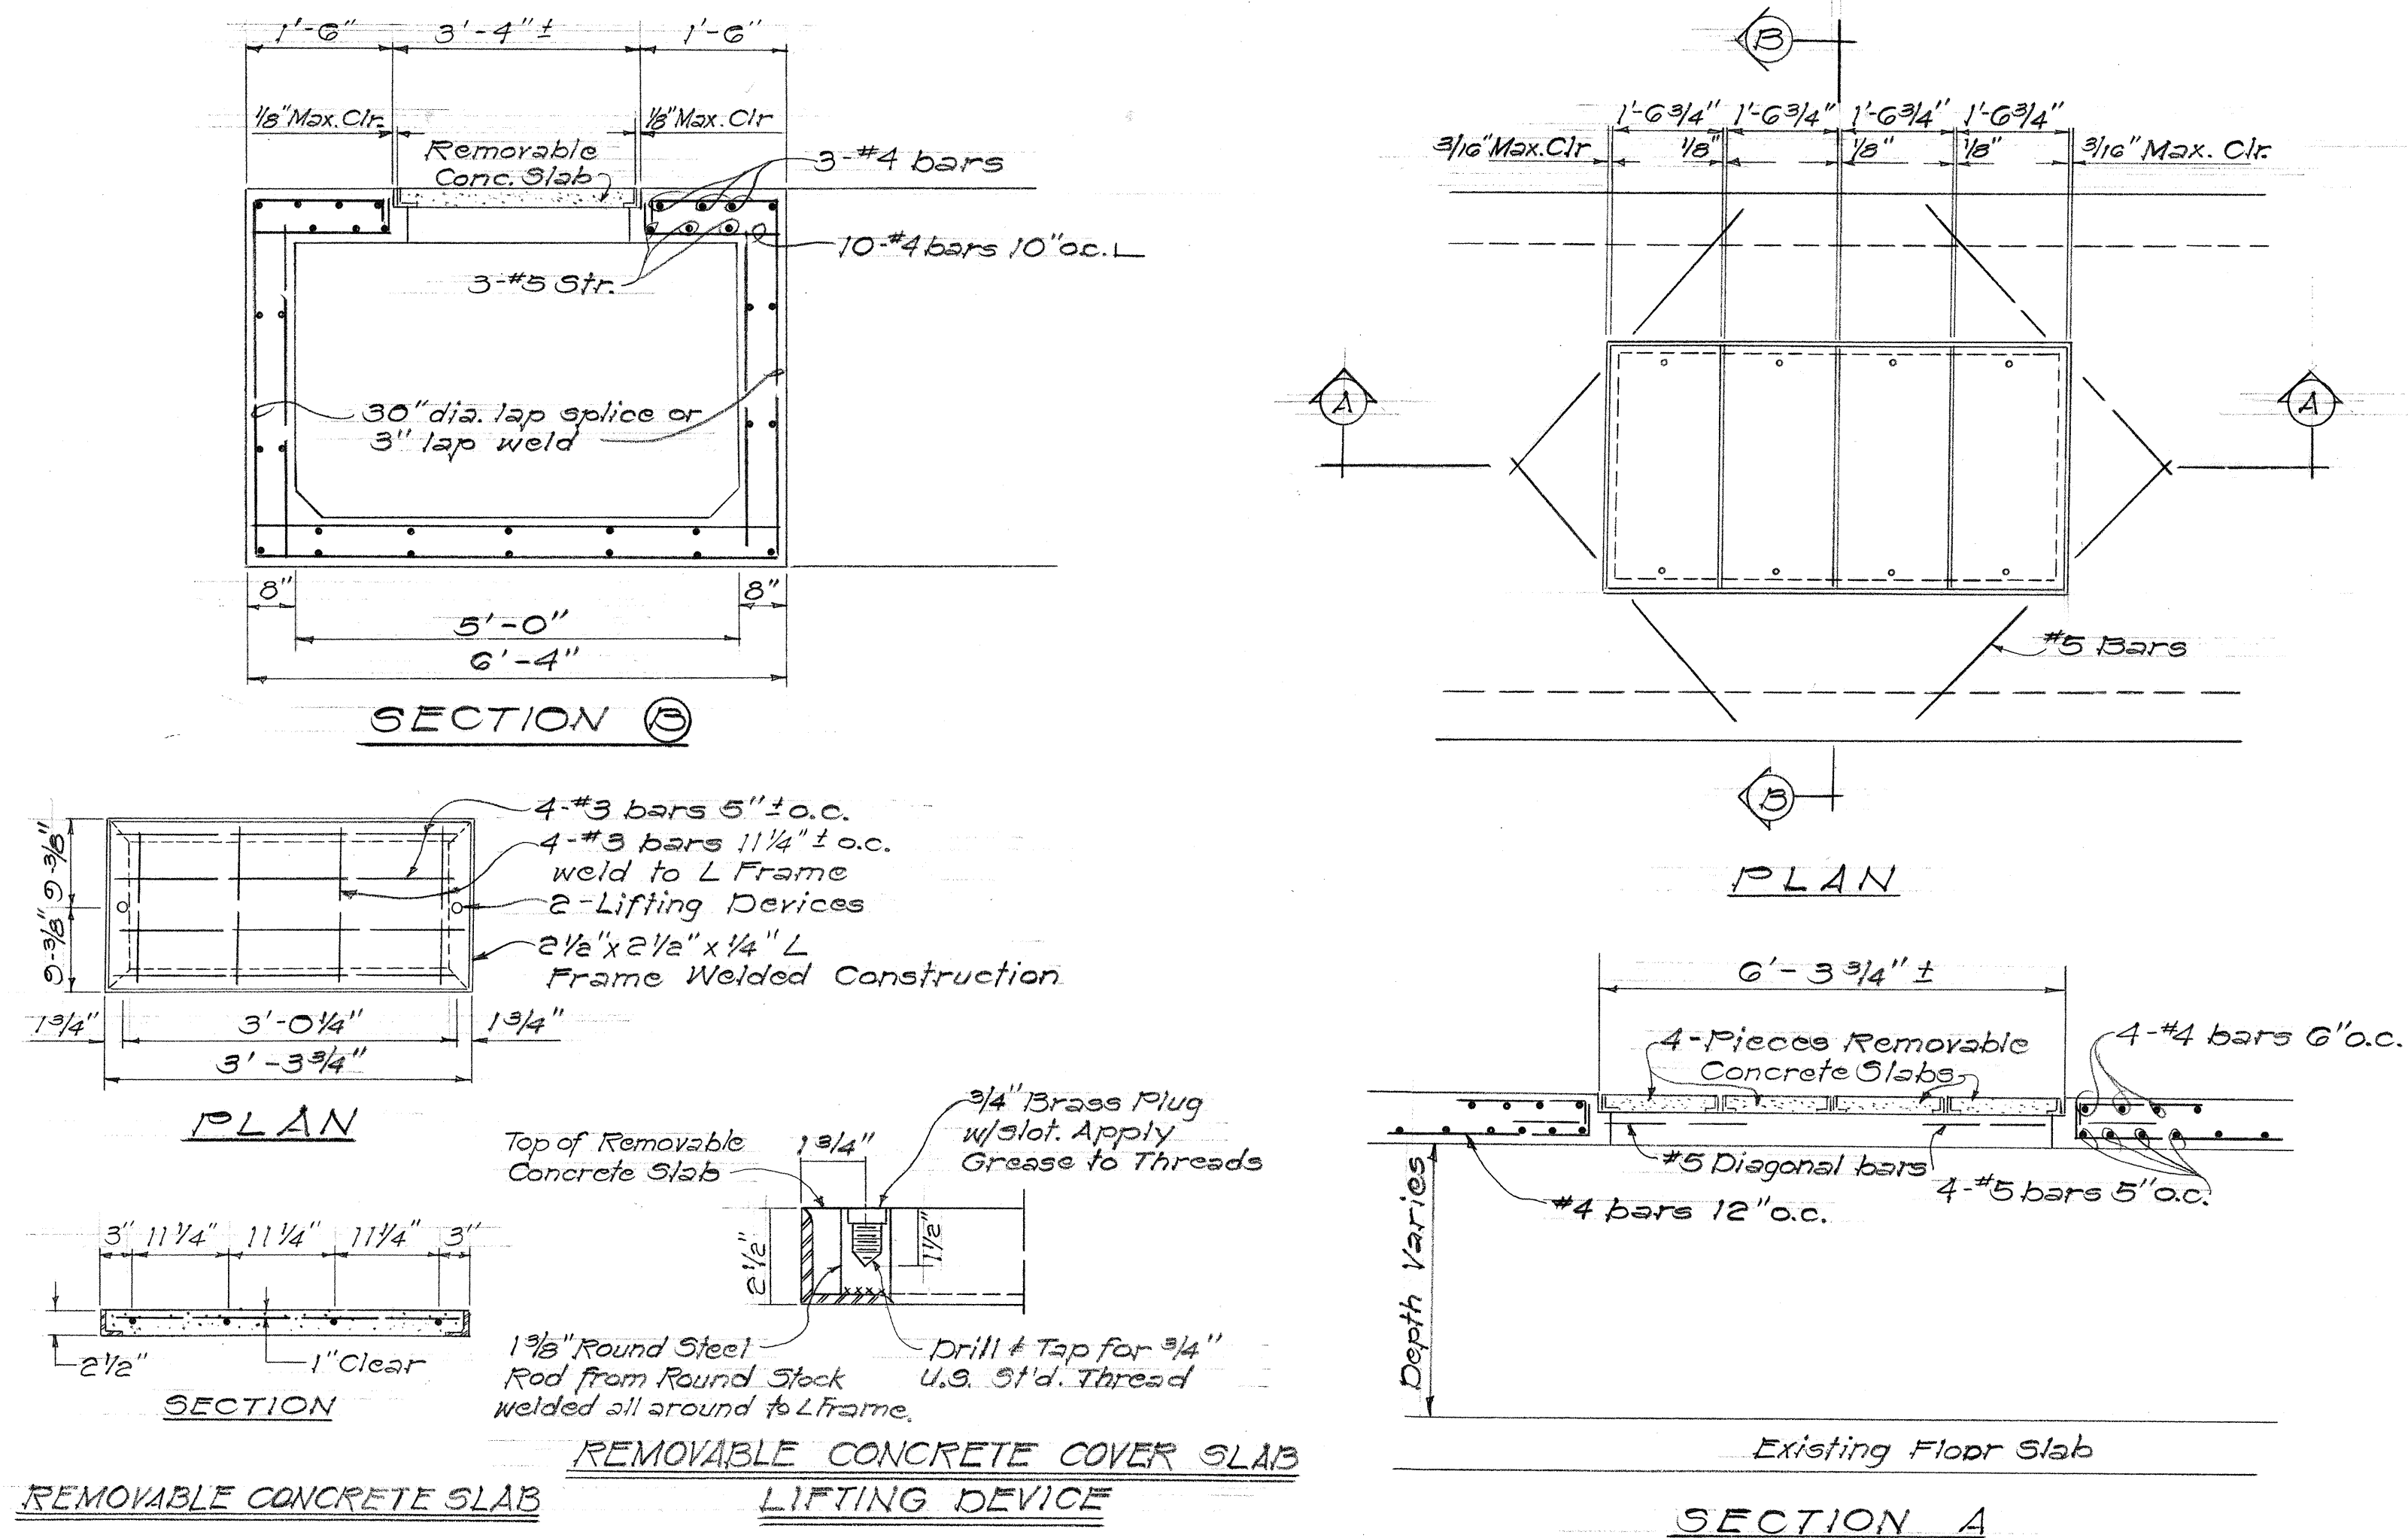

THIS SHEET ADDED AS PART OF "AS-BUILT" POSTING.


STATE OF HAWAII
DEPARTMENT OF TRANSPORTATION
HIGHWAYS DIVISION
MISCELLANEOUS DETAILS

KALANIANA'OLE HIGHWAY WIDENING
PROJ. NO. 72B-03-68 Unit I


Scale: As Noted Date: July, 1972
SHEET No. OF SHEETS

DATE	BY
PLAN	DESIGNED BY
NOTE BOOK	CHECKED BY
ORIGINAL	NO.


FED. ROAD DIST. NO.	STATE	FED. AID PROJ. NO.	FISCAL YEAR	SHEET NO.	TOTAL SHEETS
HAWAII	HAW.	72B-03-68 UNIT 1	1978	505-2	50

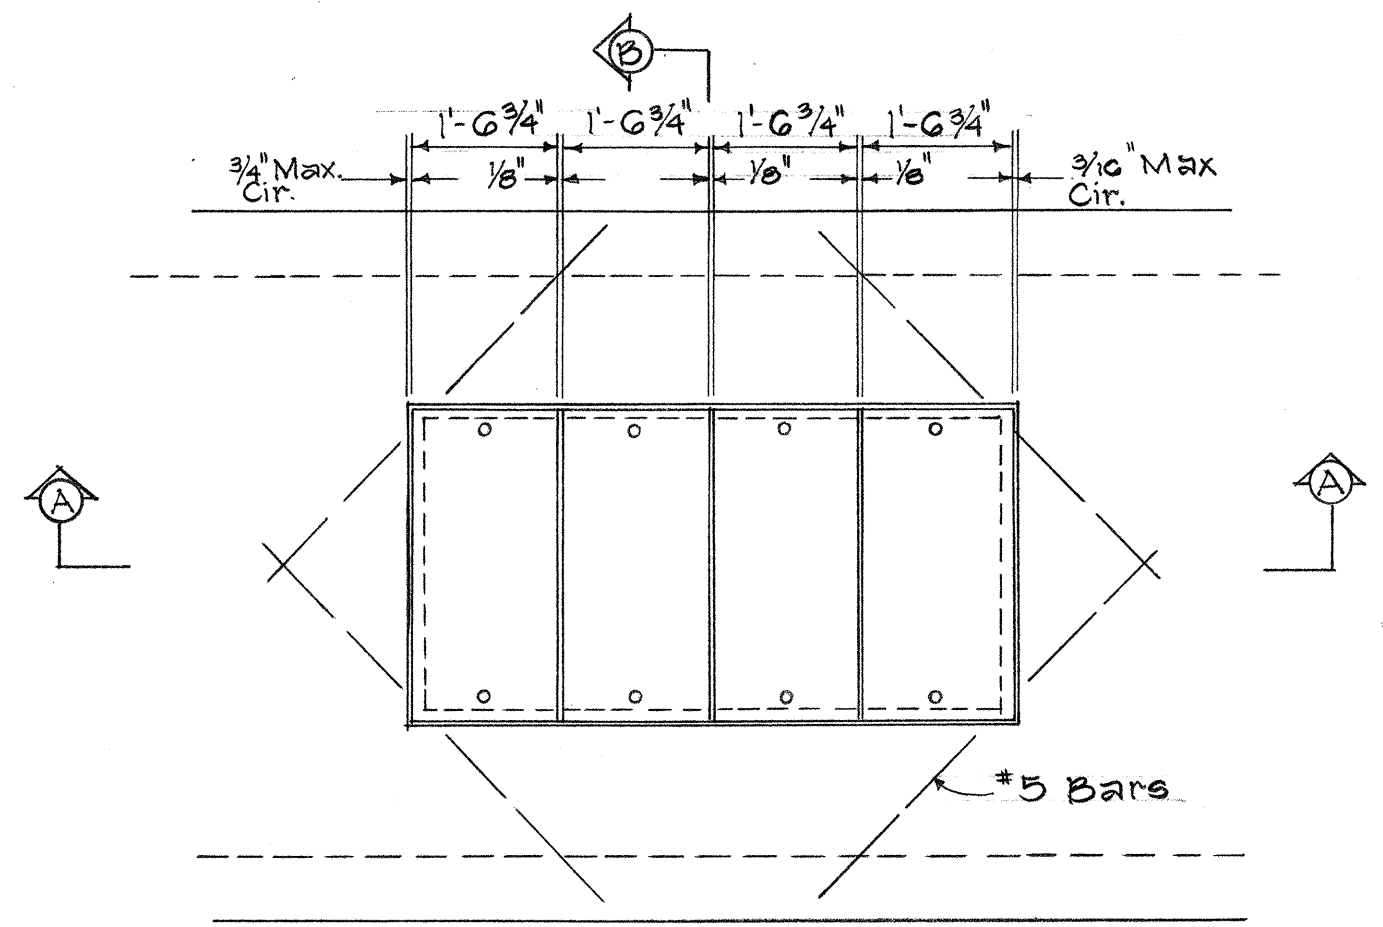


PLAN
Scale: 1/2" = 1'-0"

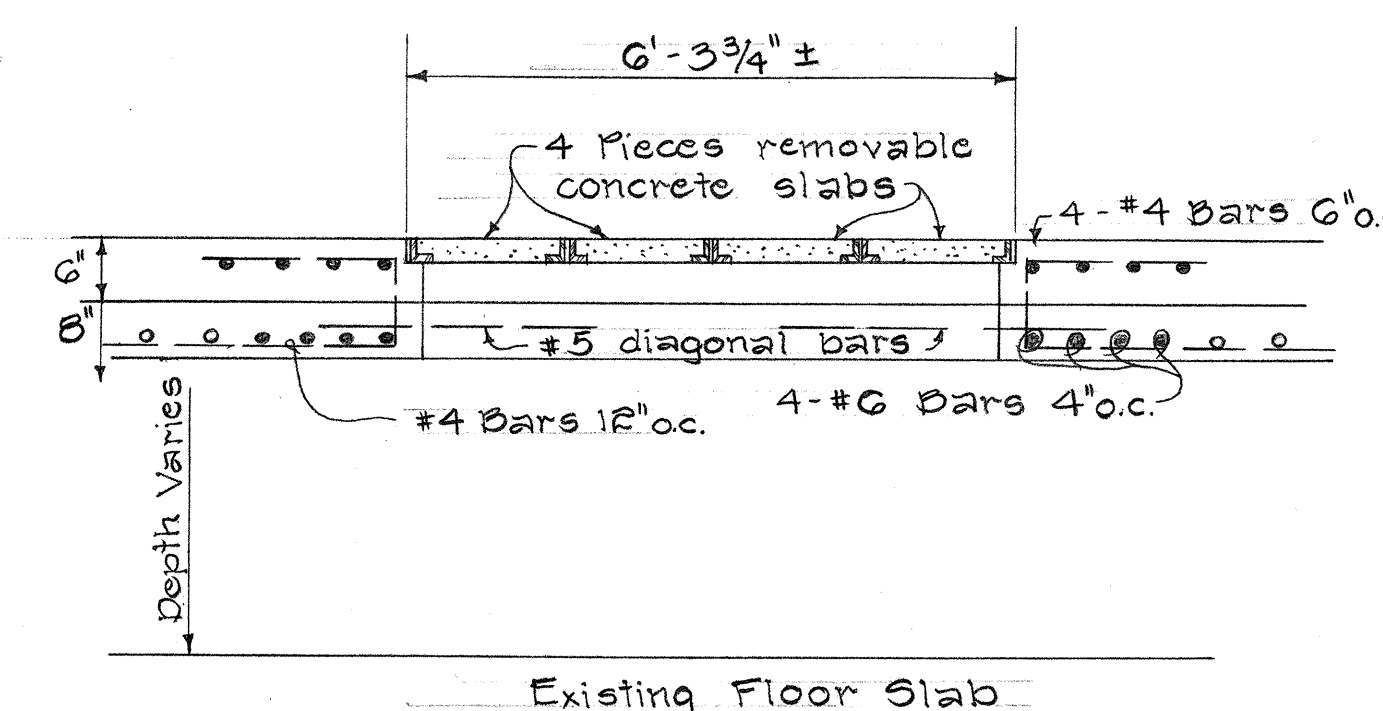

SECTION A-A
Scale: 1/2" = 1'-0"

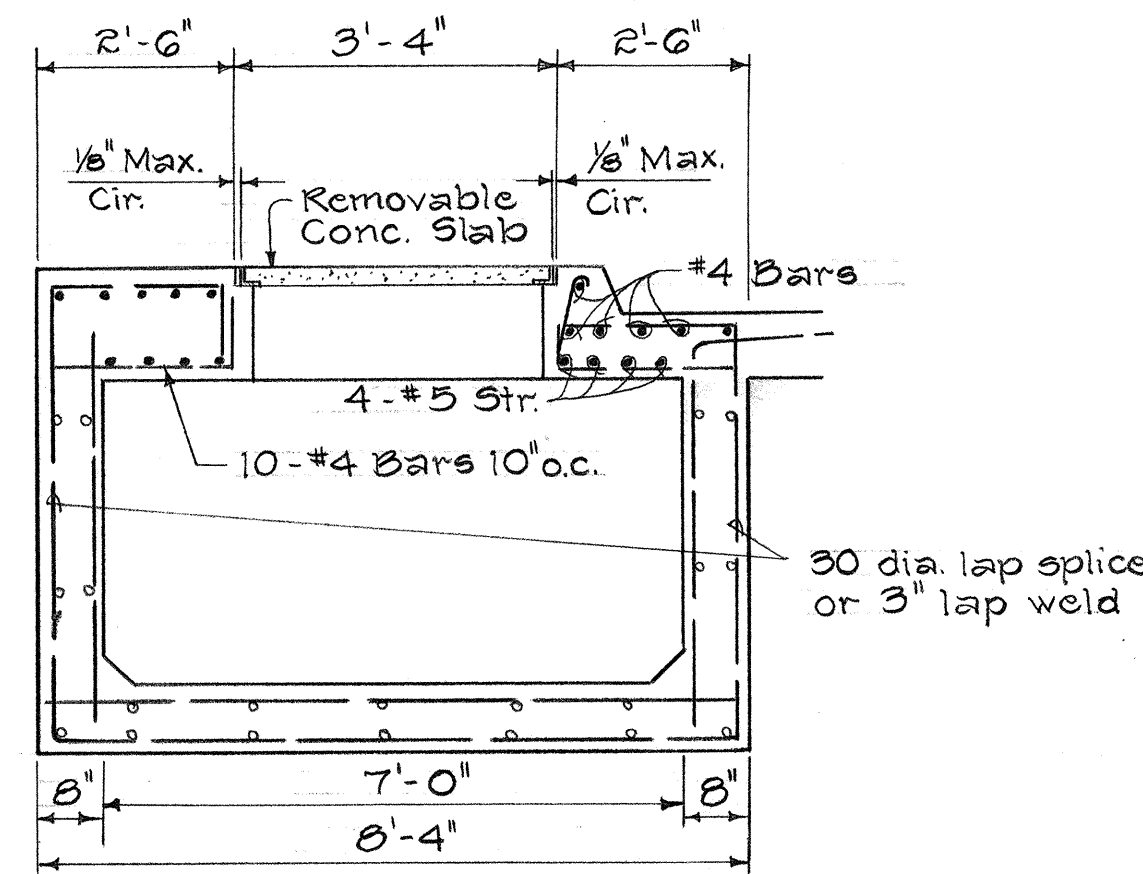


SECTION B-B
Not to Scale

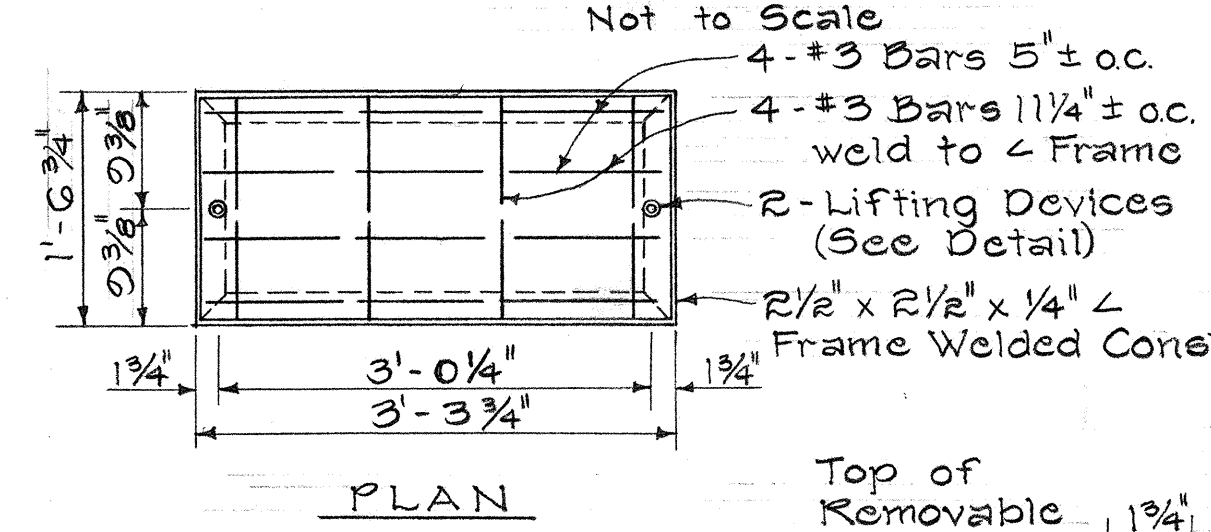

REMOVABLE CONCRETE SLAB
Scale: 3/4" = 1'-0"


REMOVABLE CONCRETE COVER SLAB LIFTING DEVICE
Scale: 1" = 3'-0"

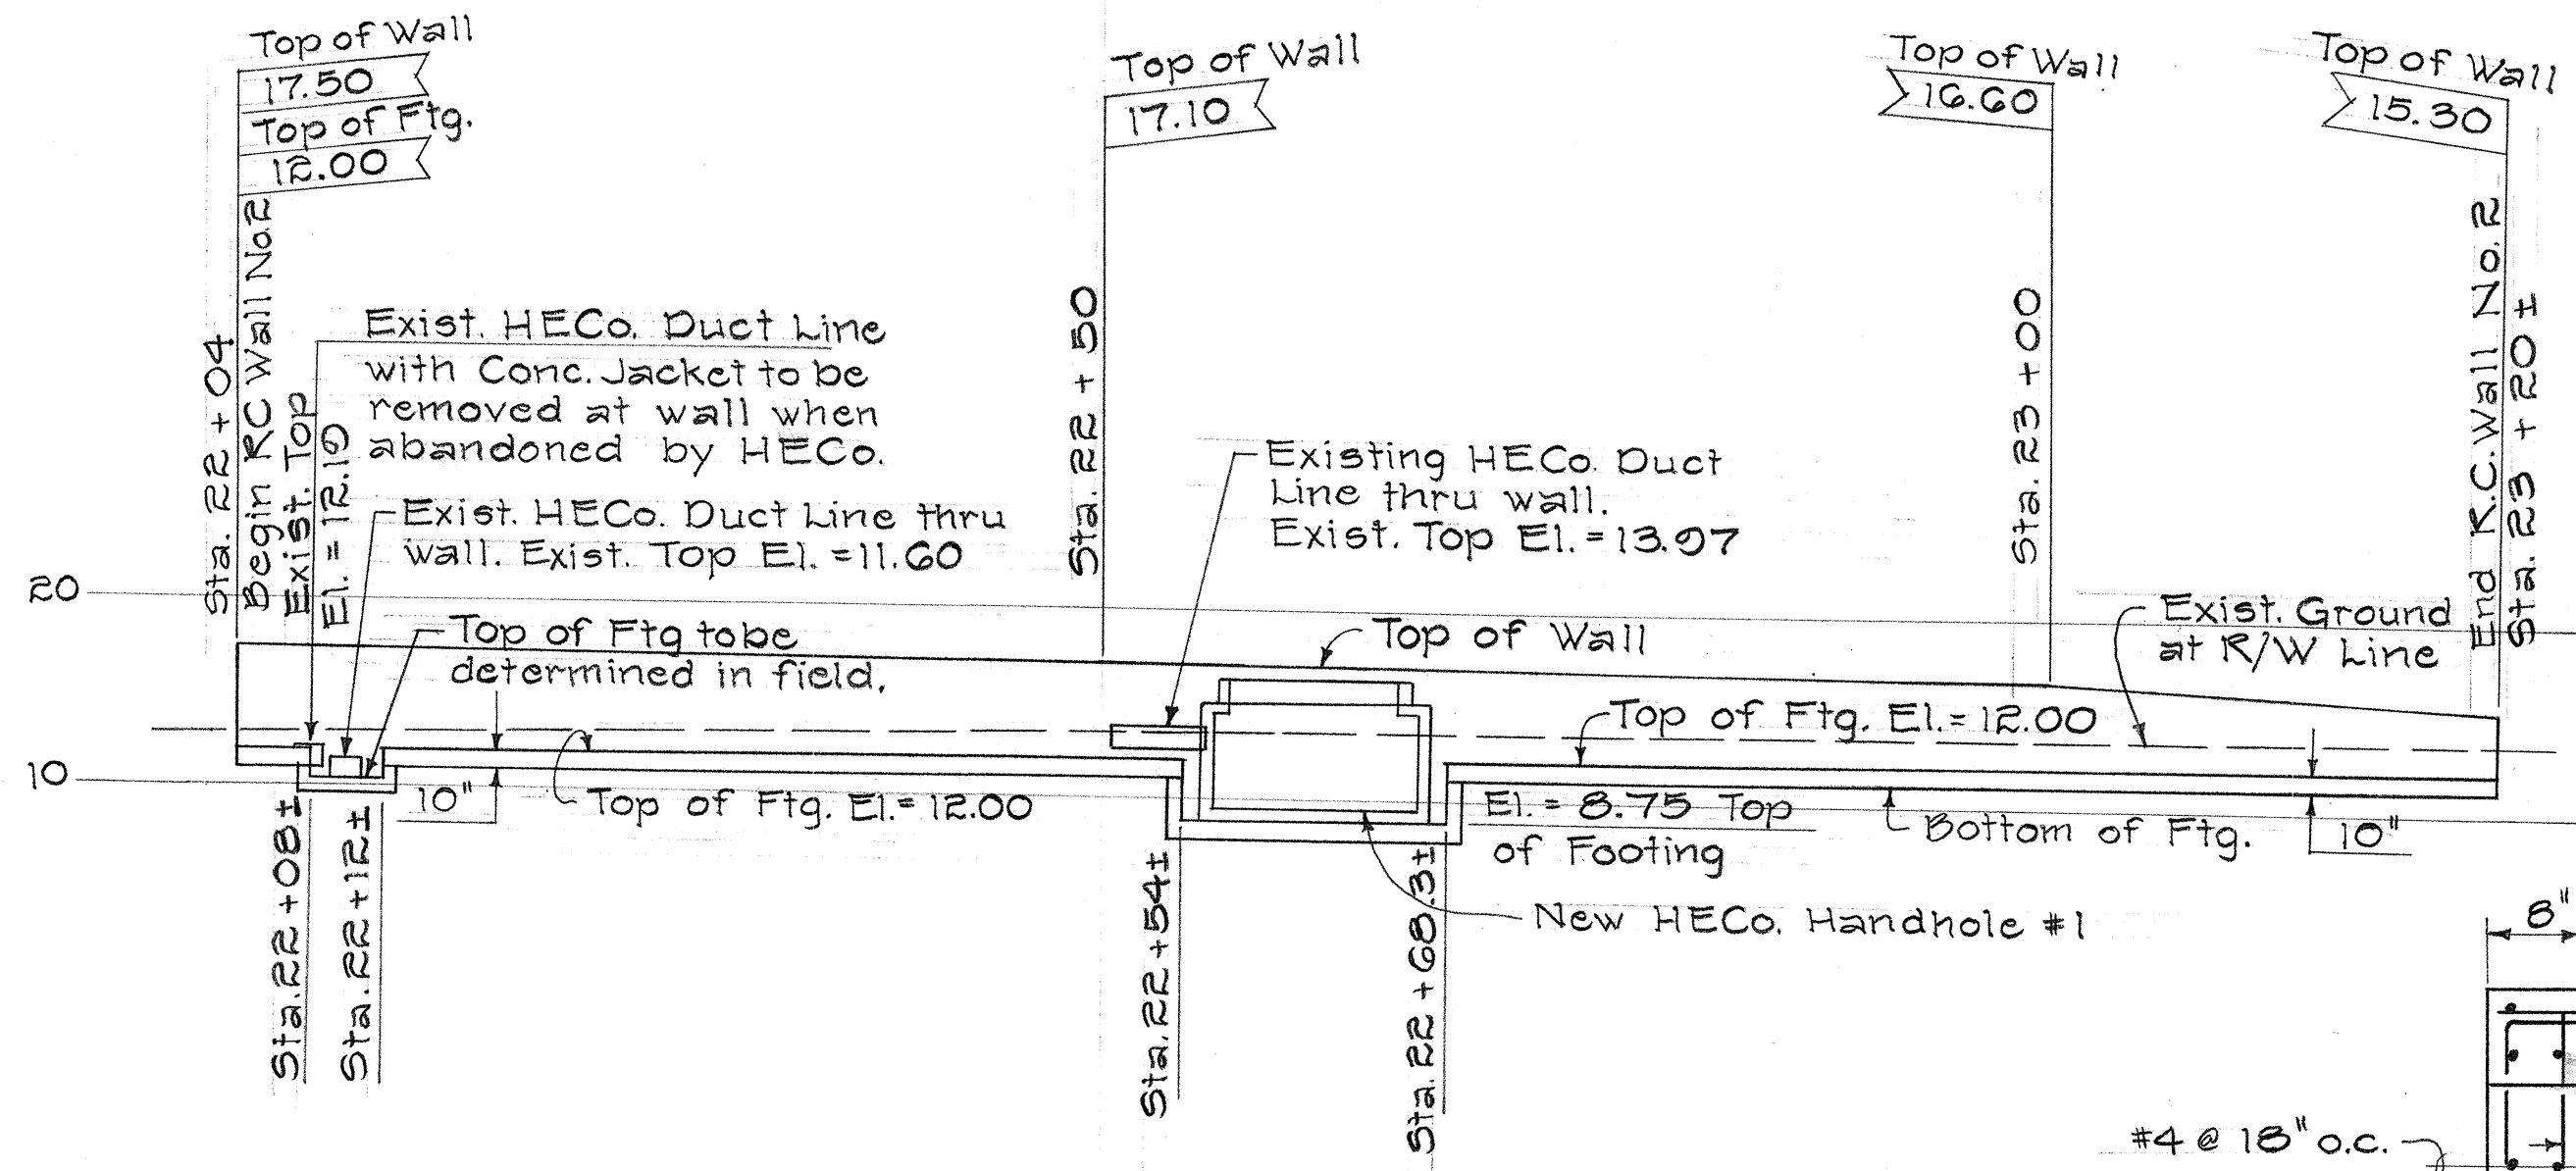

- NOTE:
- The Contractor shall verify all duct line locations and adjust wall to fit.
 - The Contractor shall verify the exact location and invert of new HECO Handhole #1 and adjust wall to fit.

ELEVATION ~ REVISED REINF. CONC. RET. WALL NO. 2
Scale: 1" = 10' (Bothways)

TYPICAL STEPPED FOOTING DET.
Not To Scale

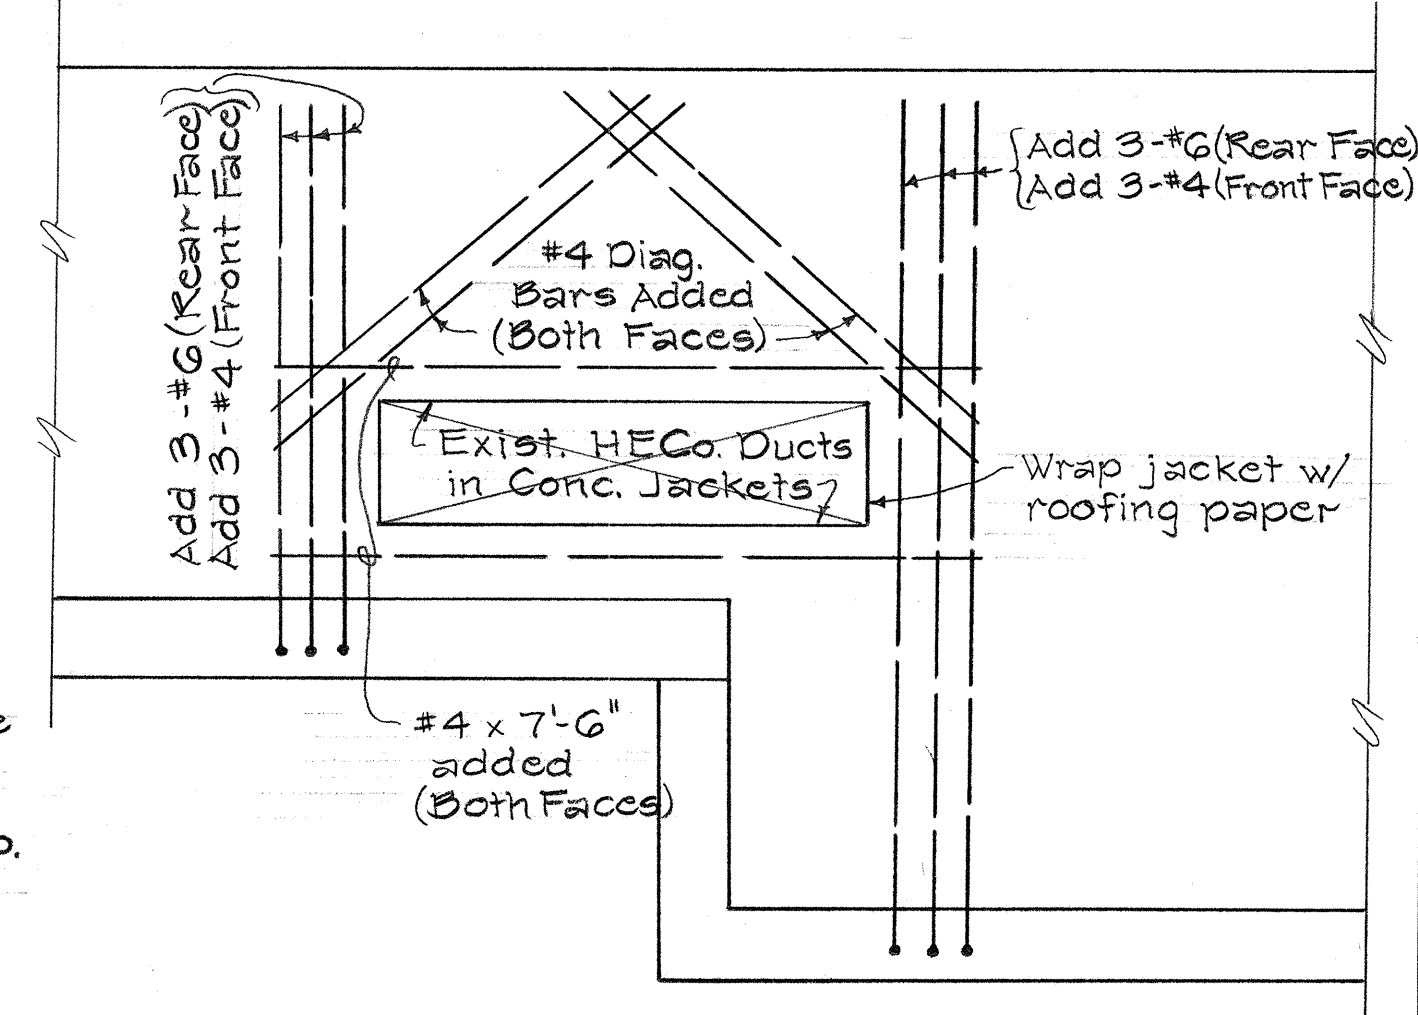


WALL ELEVATION AT DUCT LINE CROSSING (STA. 22+53±)
SHOWING ADDITIONAL REBARS
Not To Scale

THIS SHEET ADDED AS PART OF "AS BUILT" POSTING.


STATE OF HAWAII
DEPARTMENT OF TRANSPORTATION
HIGHWAYS DIVISION
MISCELLANEOUS DETAILS

KALANIANA'OLE HWY. WIDENING
PROJ. NO. 72B-03-68 Unit 1

Scale: As Noted Date: July, 1978
SHEET No. OF SHEETS

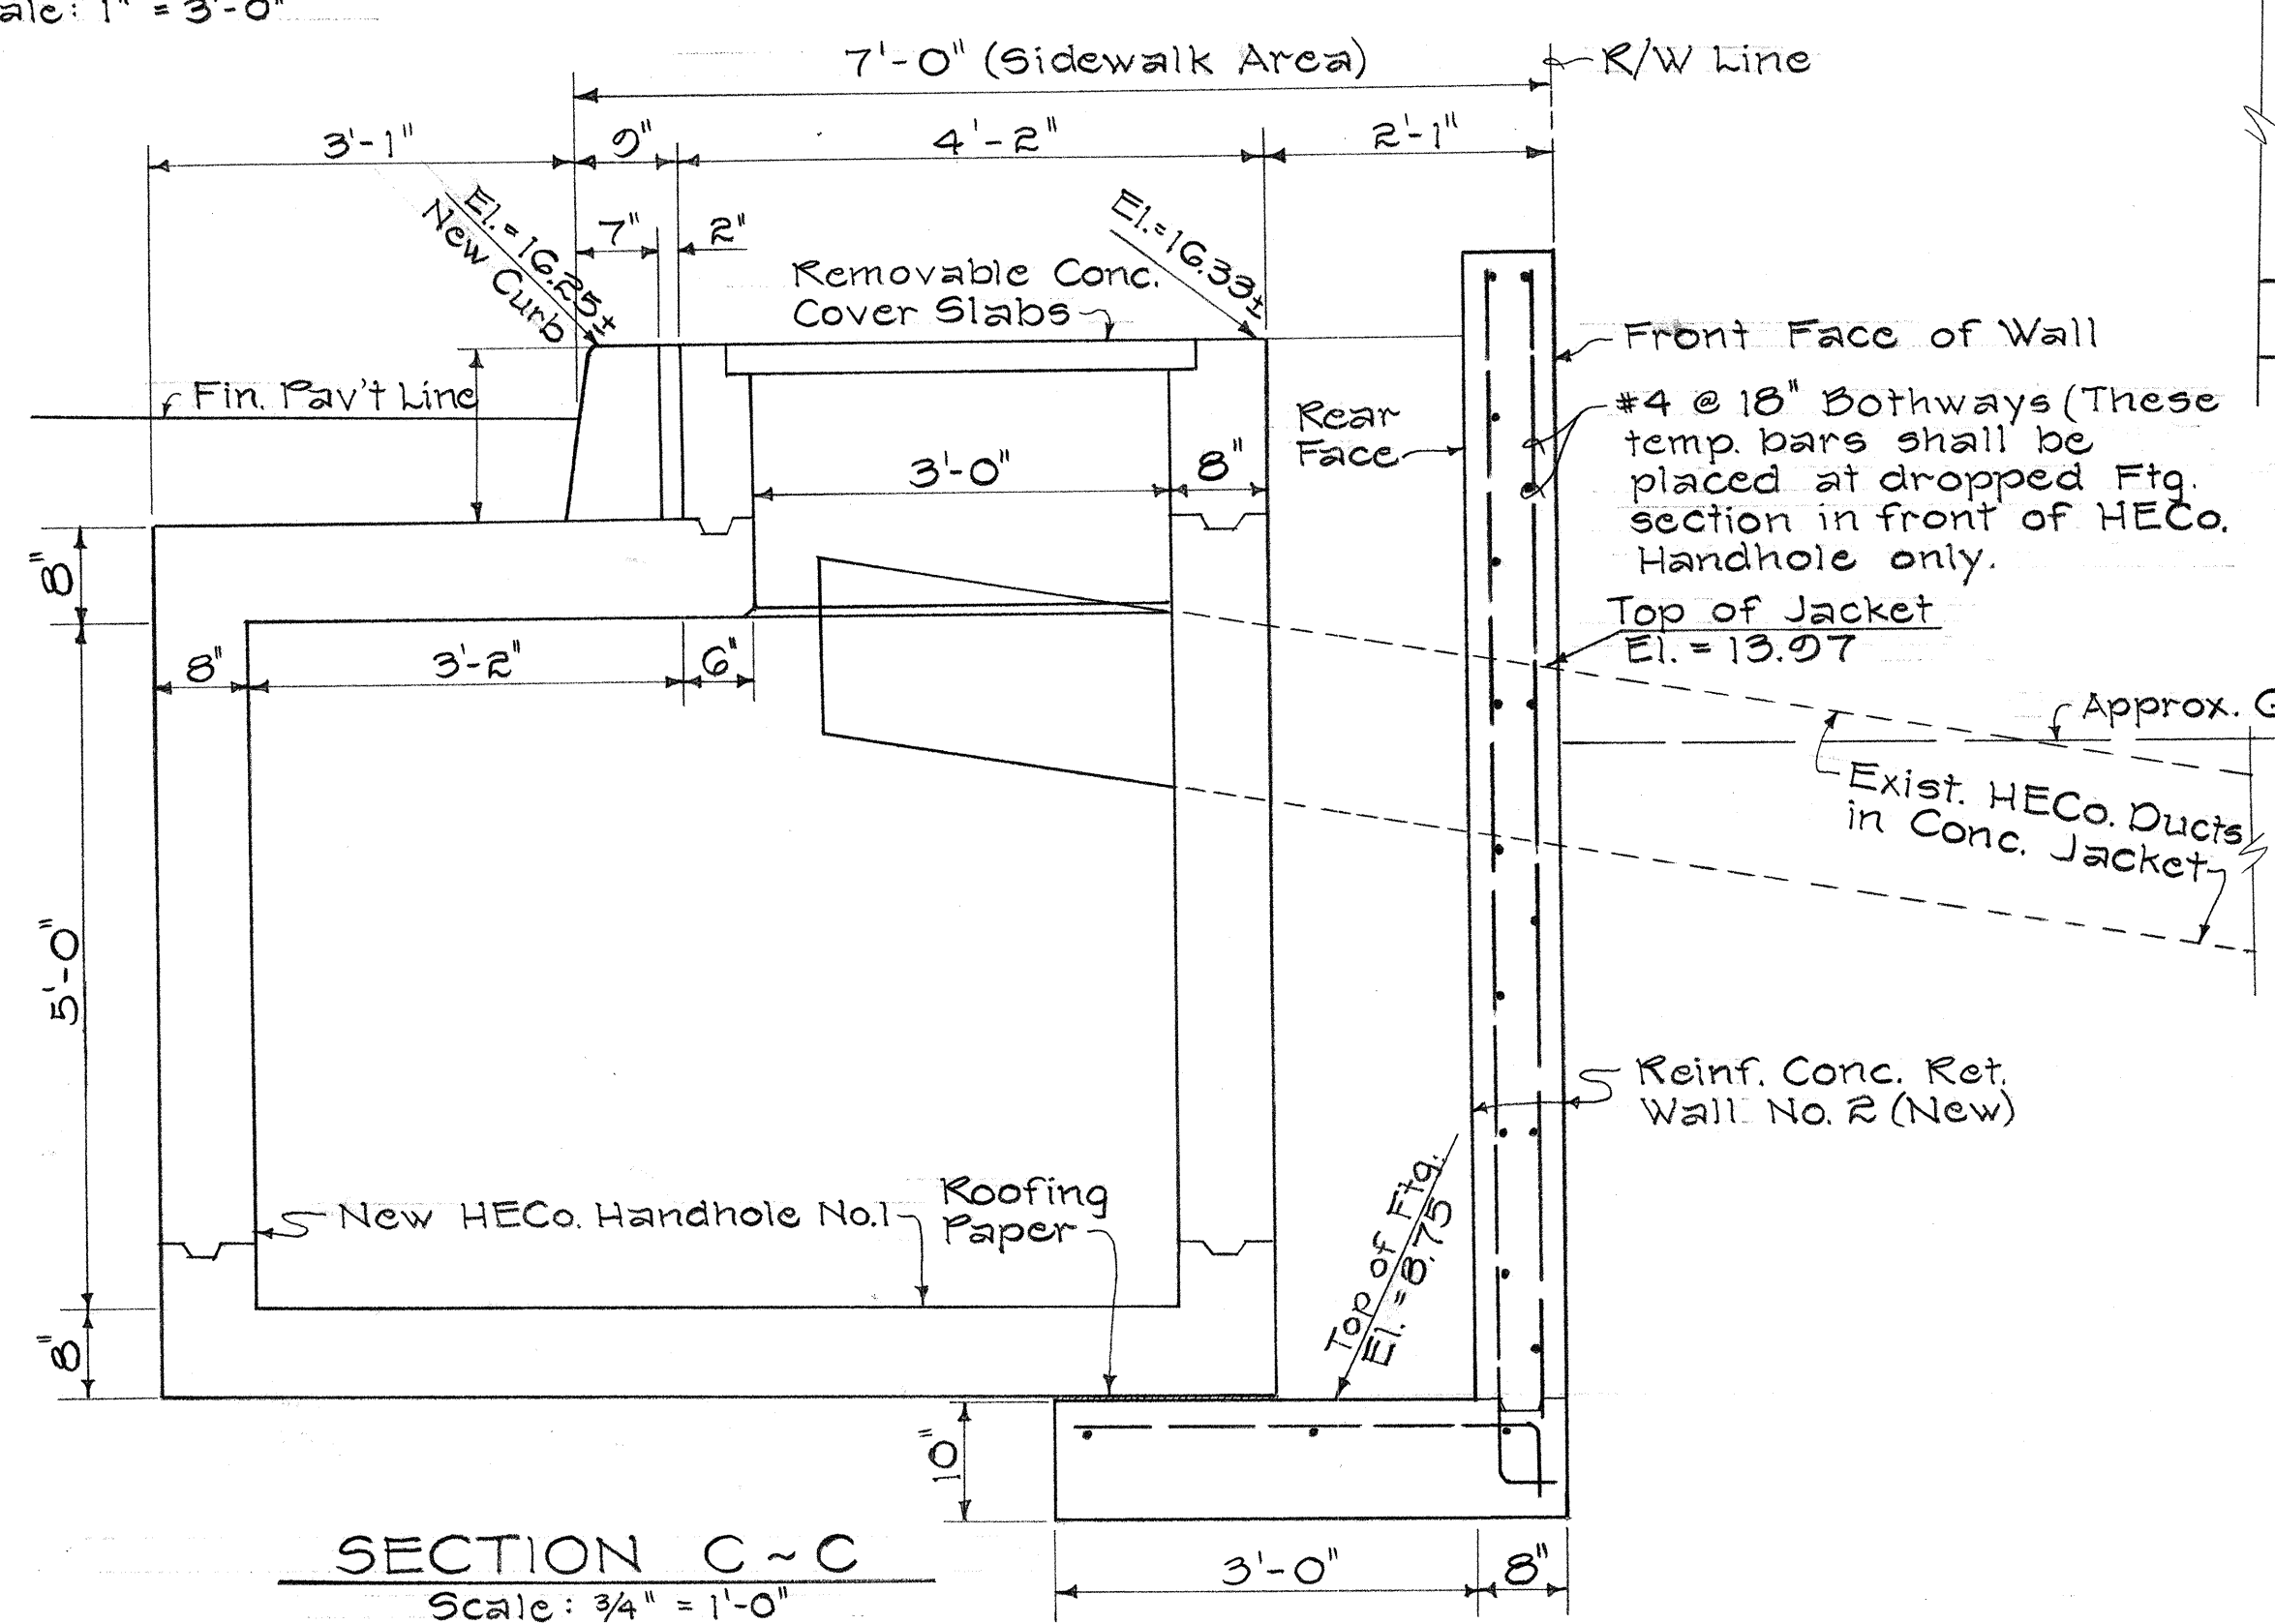

SECTION C-C
Scale: 3/4" = 1'-0"

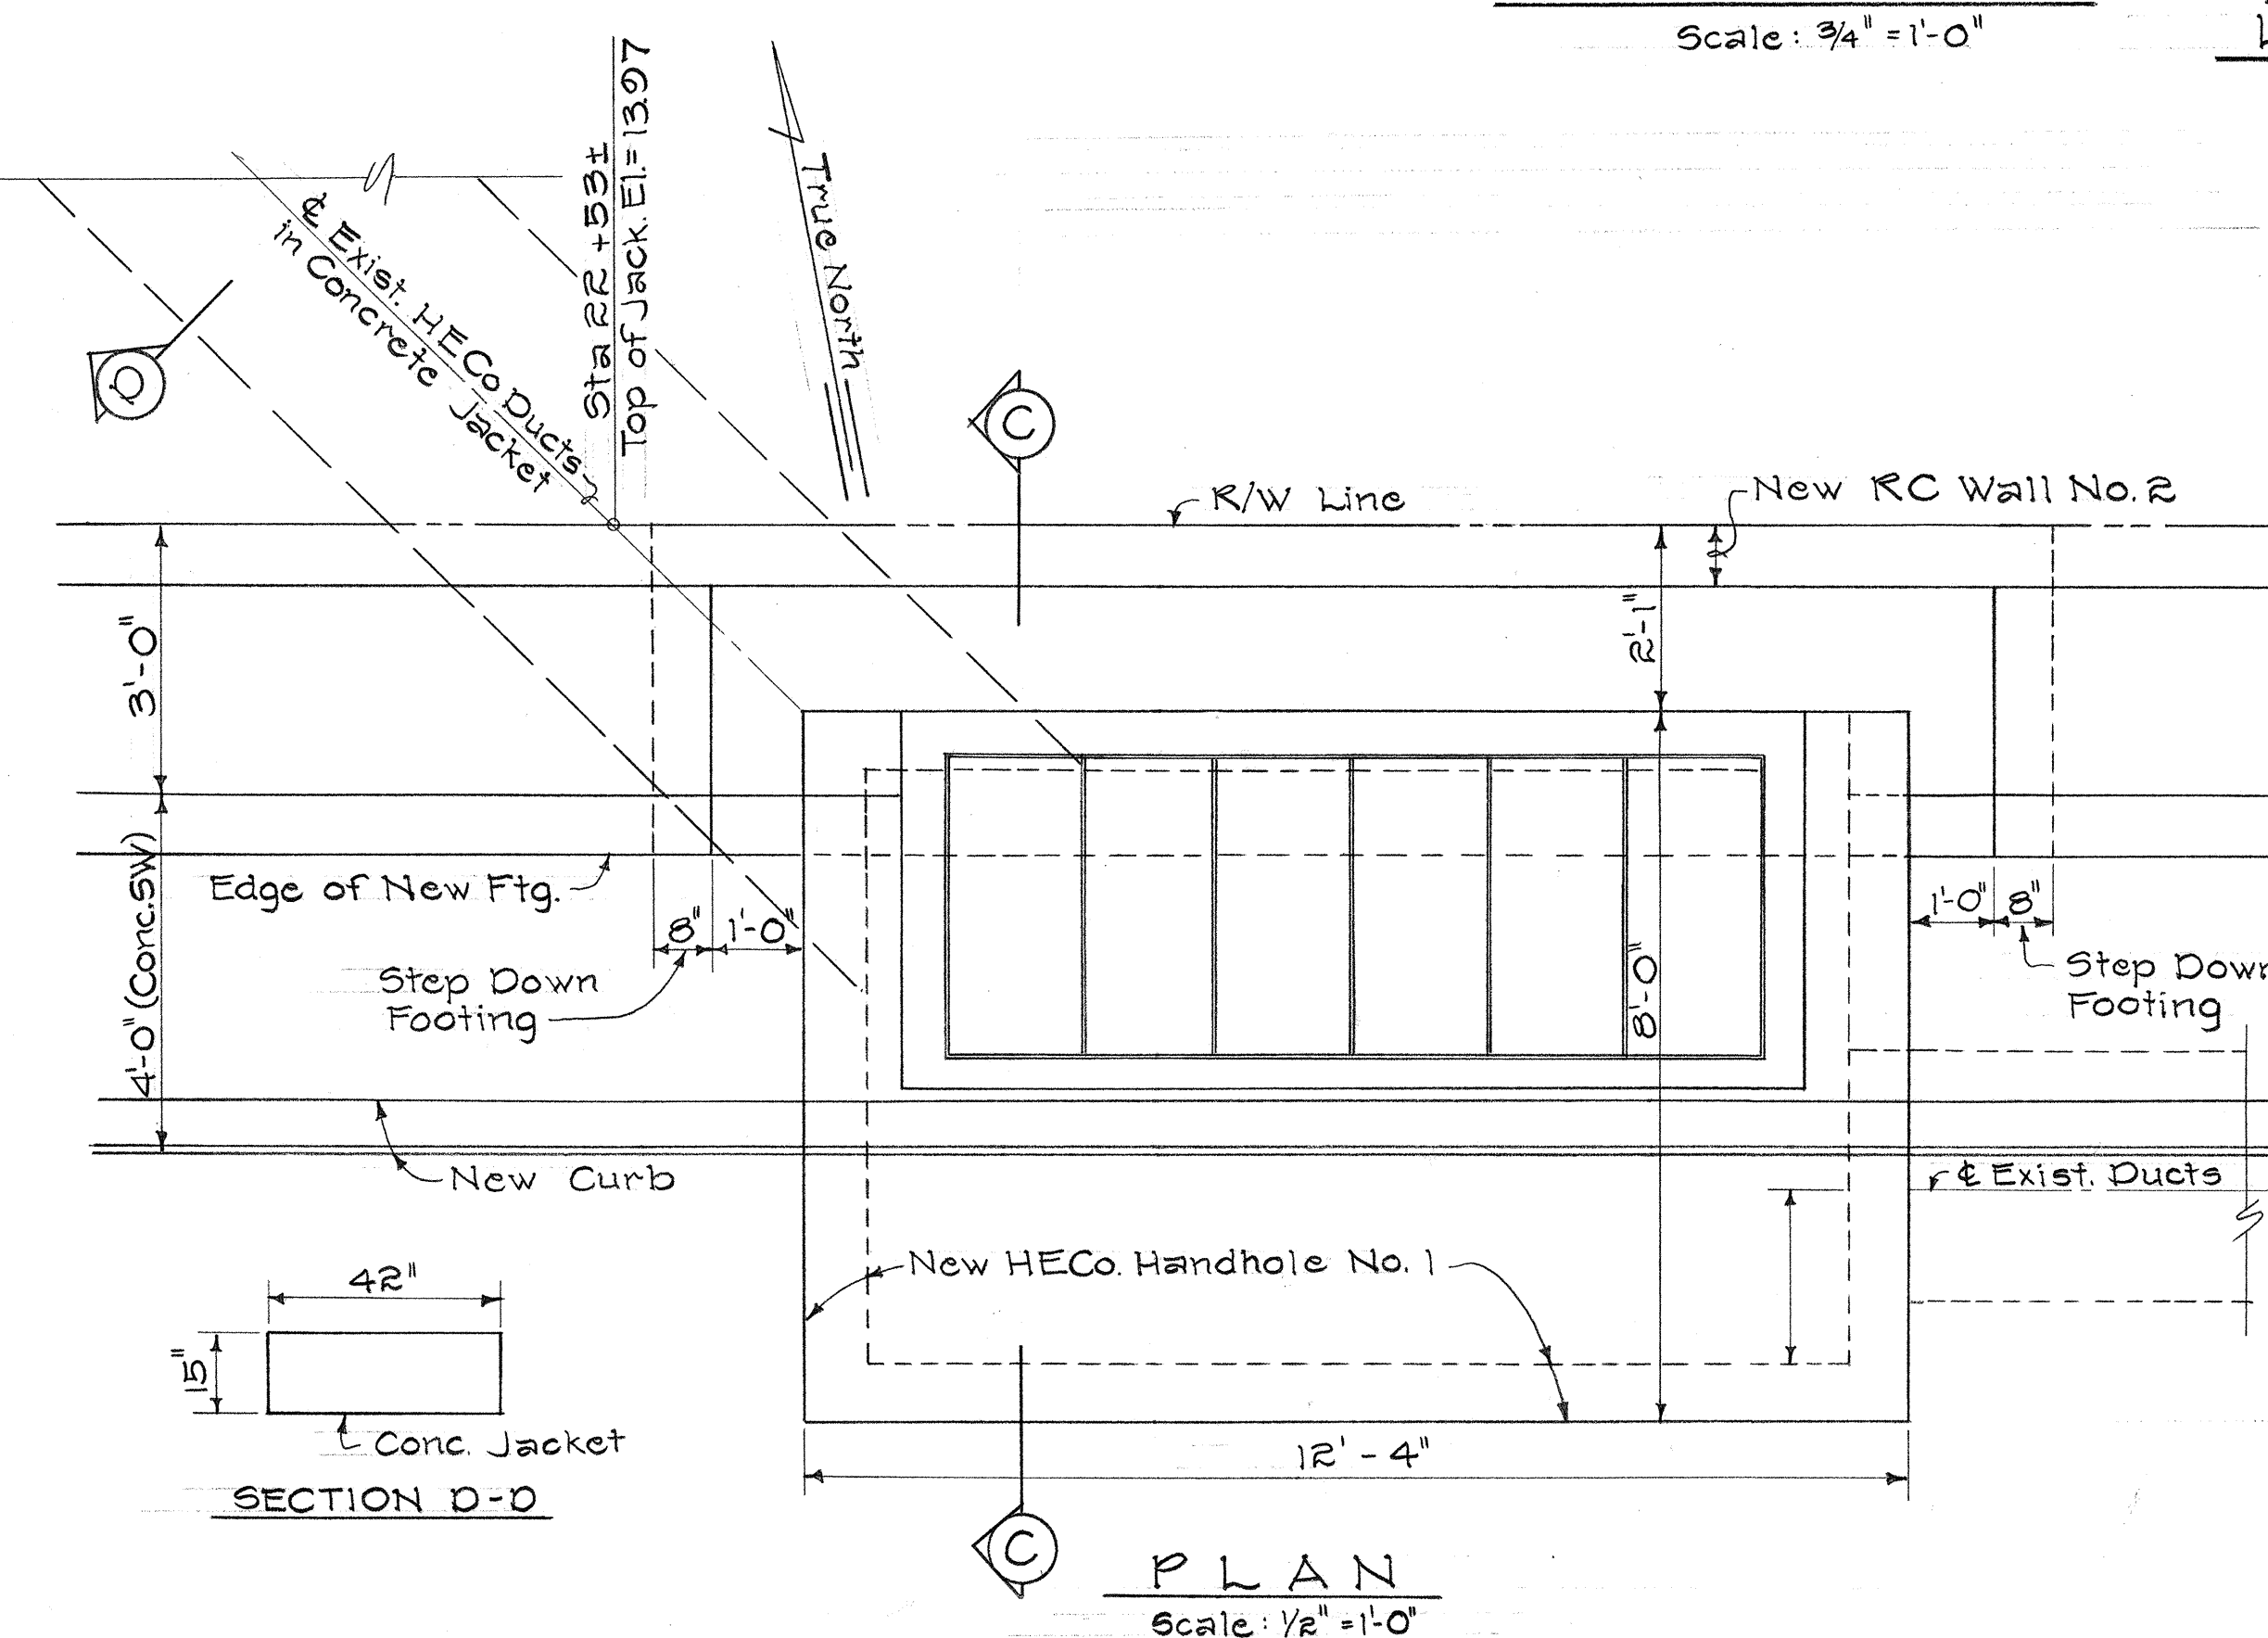


PLAN
Scale: 1/2" = 1'-0"

NEW HECO. HANDHOLE NO. 1

ORIGINAL PLAN	DATE
DRAWN BY	
DESIGNED BY	
QUANTITIES BY	
CHECKED BY	


FED. ROAD DIST. NO.	STATE	FED. AID PROJ. NO.	FISCAL YEAR	SHEET NO.	TOTAL SHEETS
HAWAII	HAW.	72B-03-68 UNIT 1	1968	505-3	50

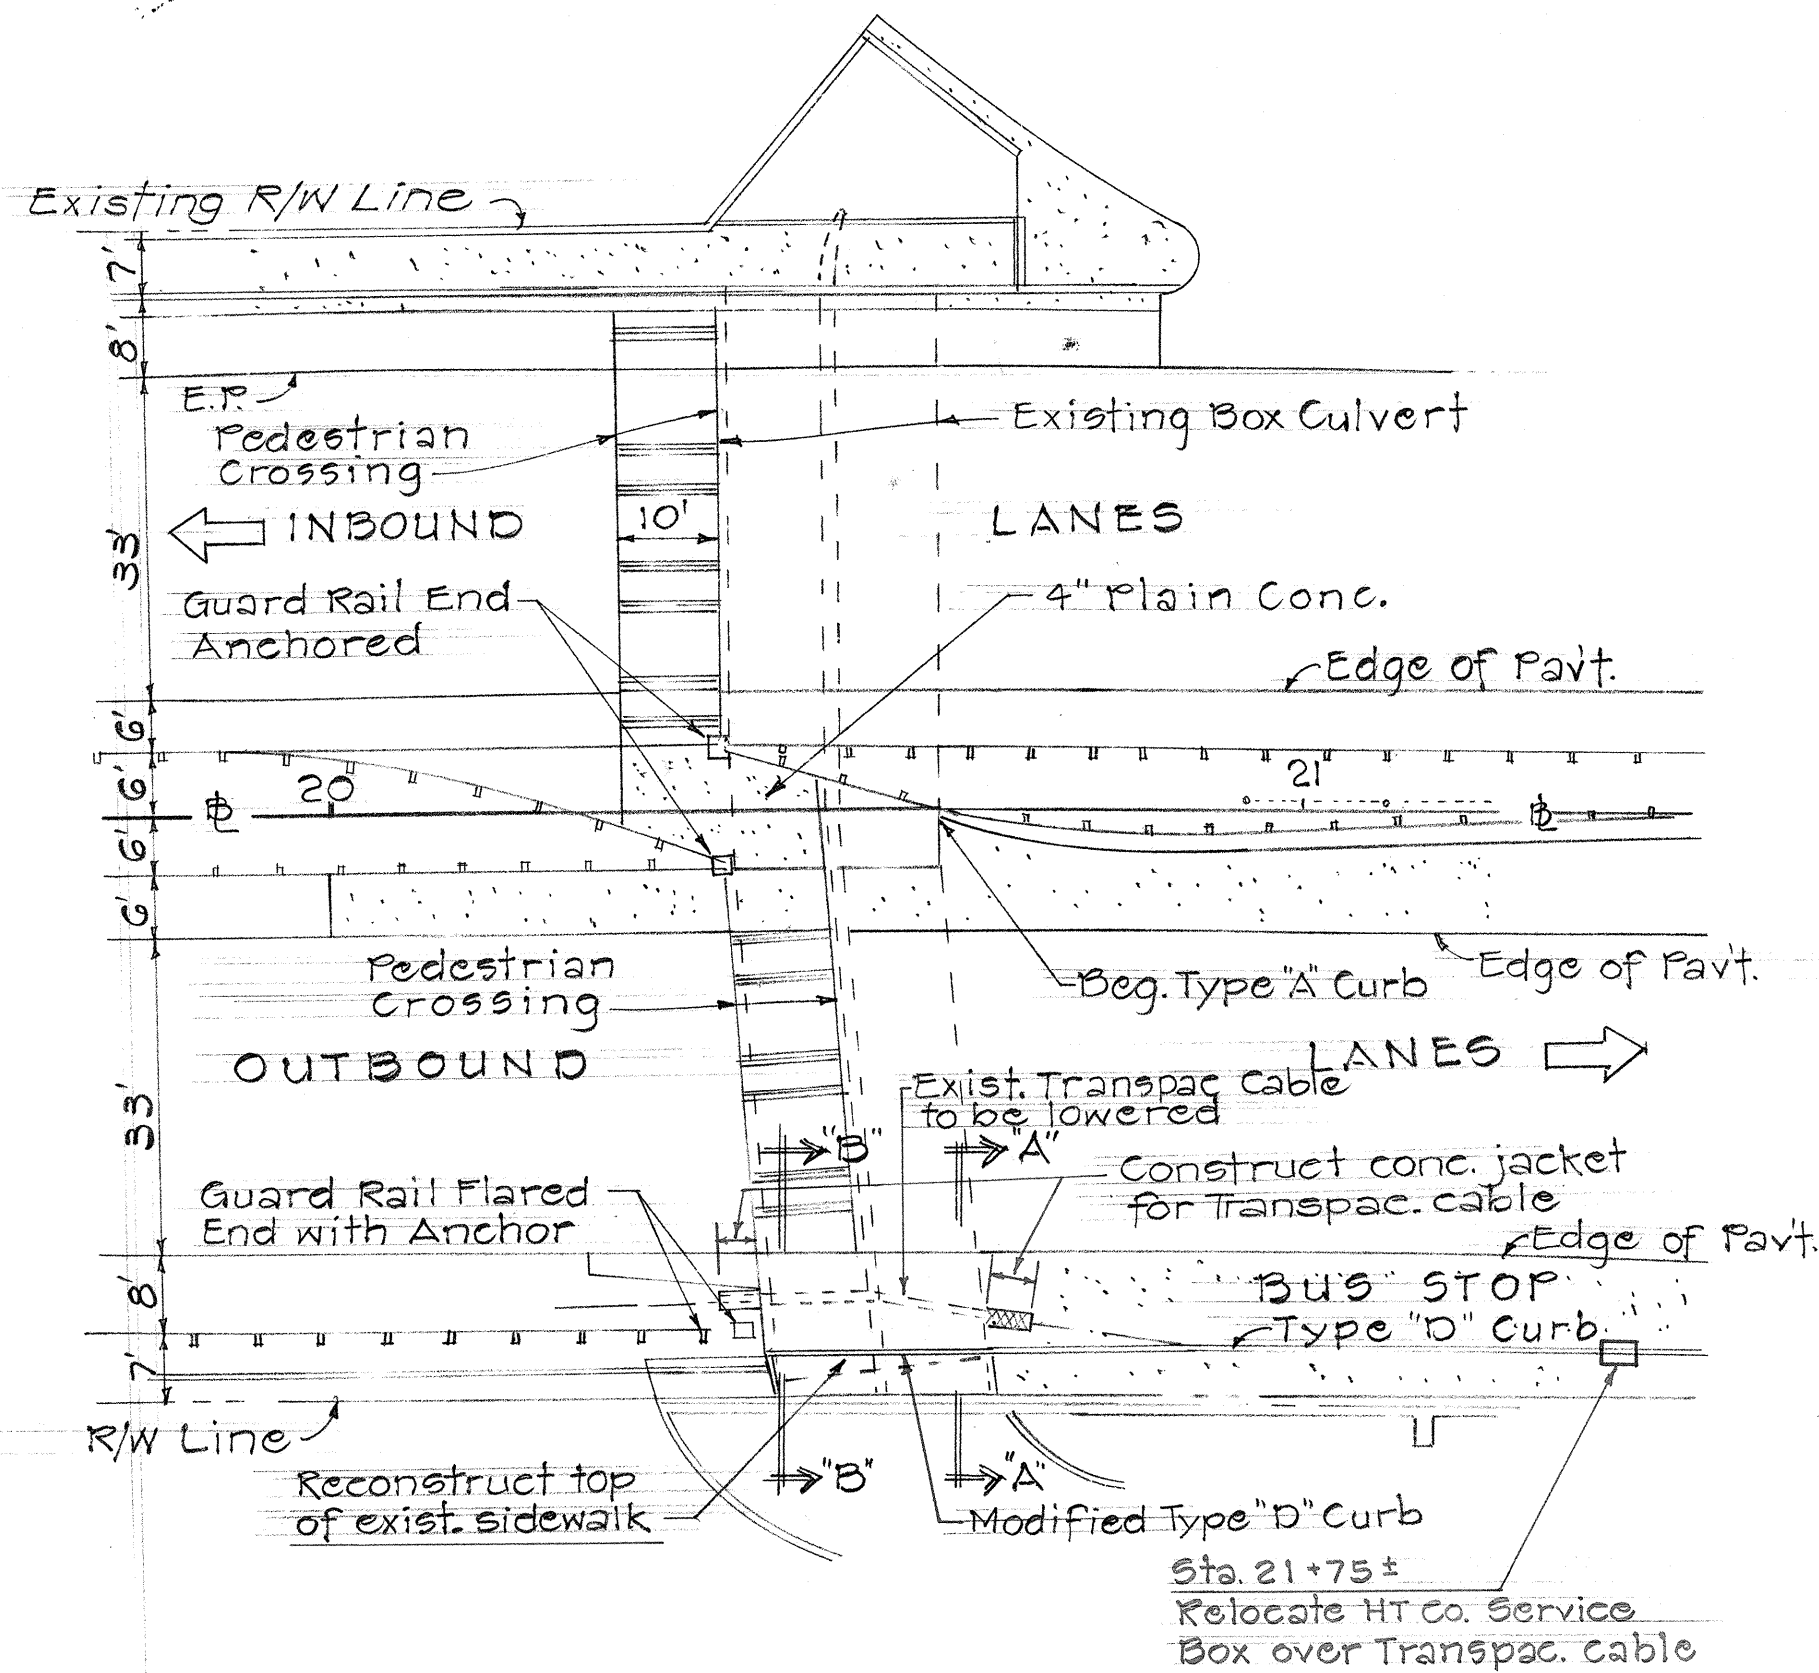


REVISED PEDESTRIAN CROSSING AND GUARD
RAIL INSTALLATION, REVISED CURB, SIDEWALK
AND P.C.C. PAYT. OVER EXIST. BOX CULVERT
KALANIANA'OLE HWY. WIDENING UNIT-1
PROJ. NO. 72B-03-68 UNIT-1 C.C.O. #6
SCALE: 1"=20'-0" 3/10/69

NOTE:

The Contractor shall have H.T. Co. Inspector
Mr. R. Gonsalves (PH-7321707) at job site
when breaking existing concrete jacket
and/or doing any work on the Transpacific
Cable.

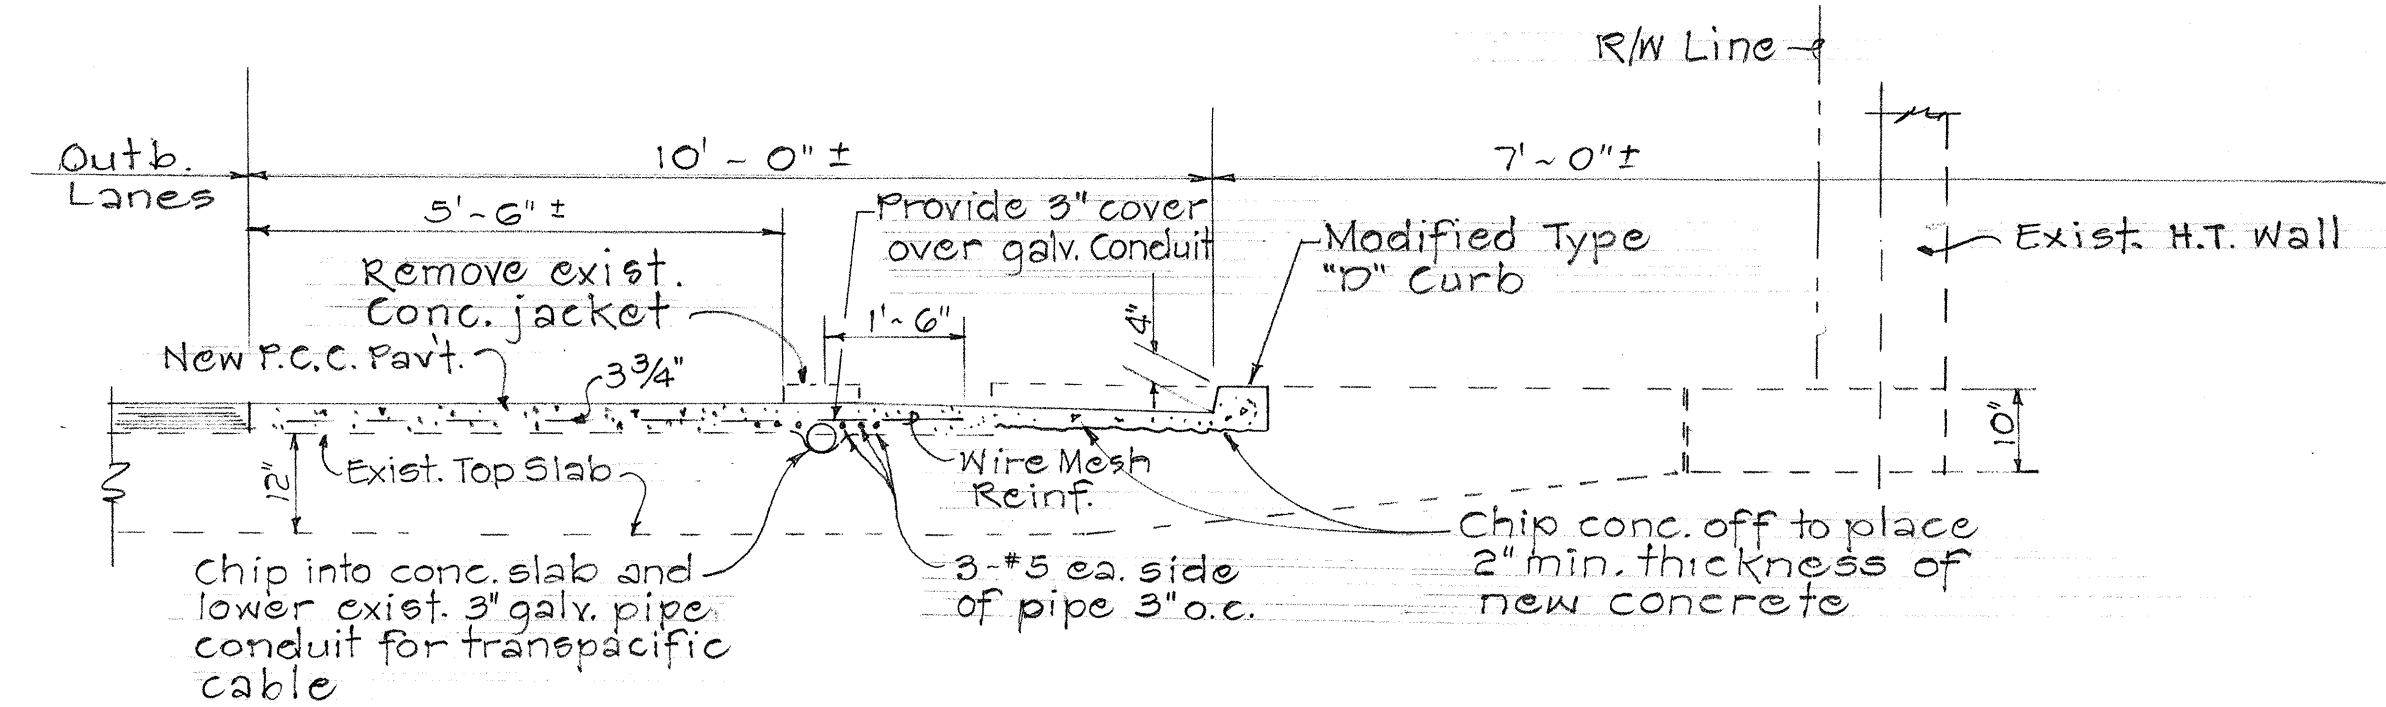

SECTION "A-A"

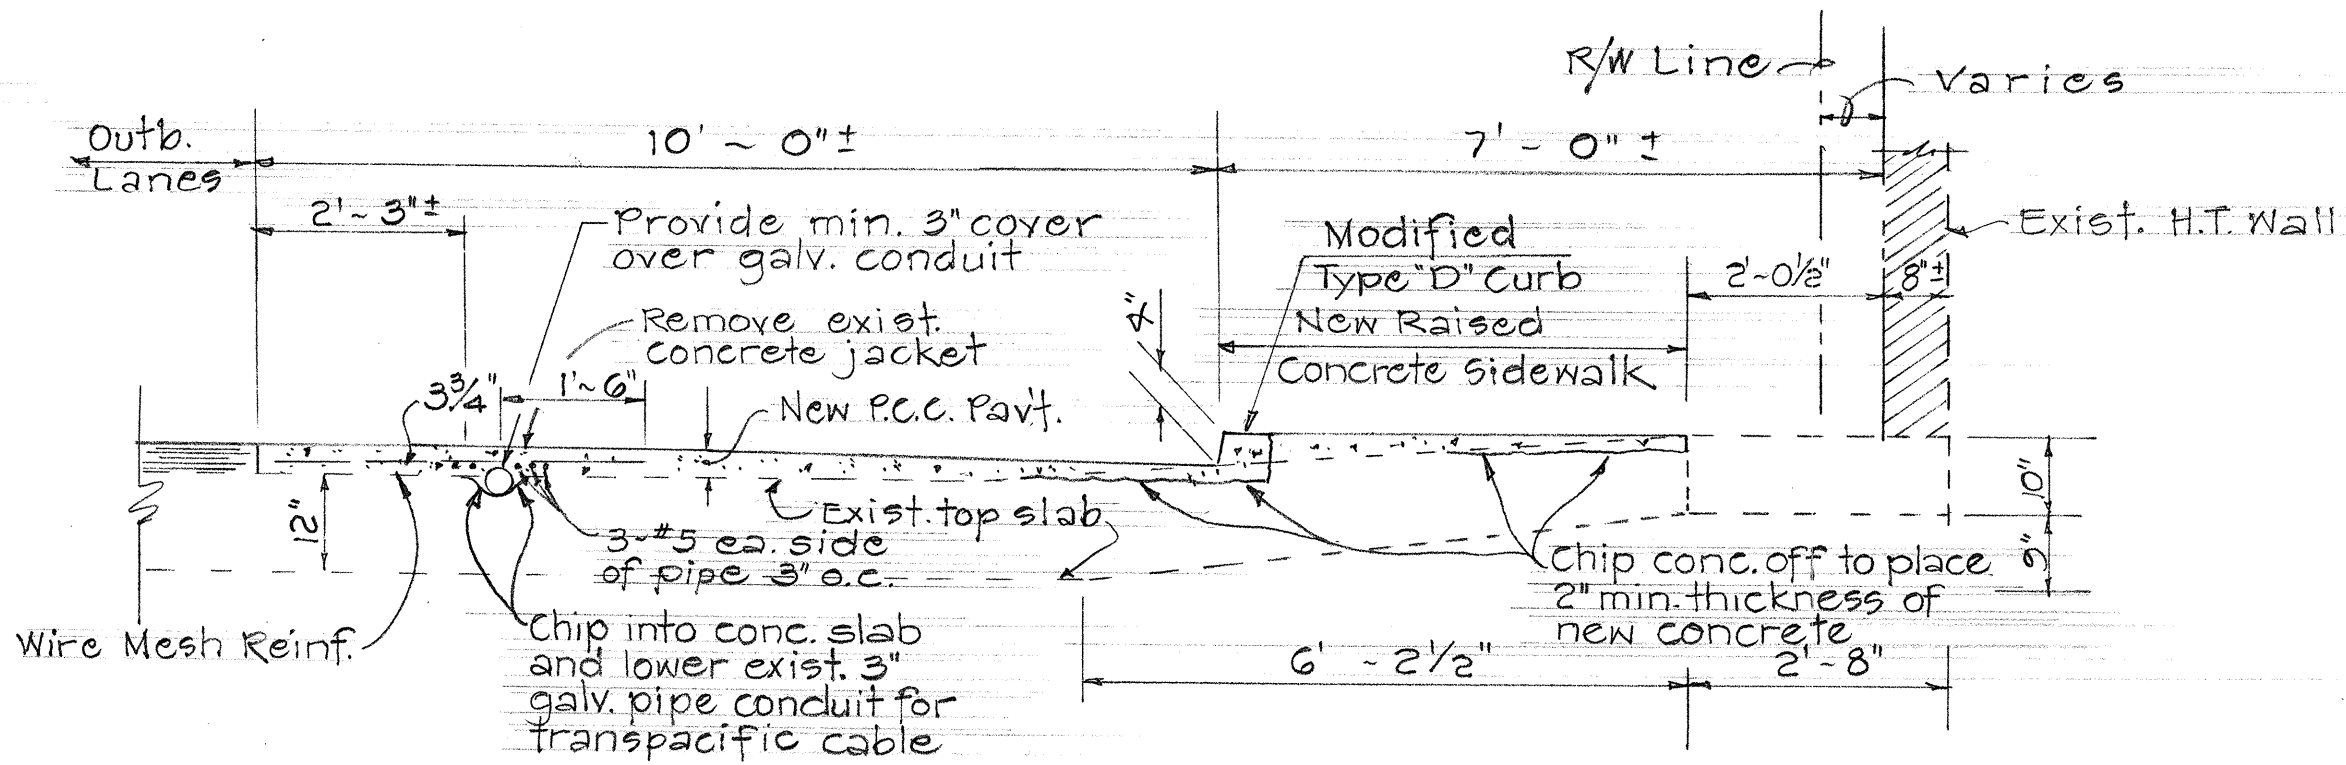

SECTION "B-B"

scale: 1/2"=1'-0"

THIS SHEET ADDED AS PART
OF "AS-BUILT" POSTING

STATE OF HAWAII
DEPARTMENT OF TRANSPORTATION
HIGHWAYS DIVISION

MISCELLANEOUS DETAILS
KALANIANA'OLE HWY. WIDENING
PROJ. NO. 72B-03-68 Unit 1
Scale: As Noted Date: July, 1972
SHEET No. OF SHEETS