we'	
INDEX TO DRAWINGS	
SHEET NO.	DESCRIPTION
<u> </u>	TITLE SHEET
2-3	TYPICAL ROADWAY SECTIONS
4-8	PLAN & PROFILE
9-14	SEWER, WATER, GAS & SPRINKLER
	SYSTEM
15-17	ELECTRIC, TELEPHONE, HIGHWAY
•	LIGHTING & TRAFFIC SIGNAL SYSTE
18-21	ROADWAY & DRAINAGE DETAILS
22-39	STANDARD HIGHWAY DETAILS
40-50	STANDARD ELECTRIC, TELEPHONE
	HIGHWAY LIGHTING & TRAFFIC SIGNA
	SYSTEM DETAILS
5081-5083	MISCELLANEOUS DETAILS
Ŷ	
the state of the s	
	, per
	· · · · · · · · · · · · · · · · · · ·

STATE OF HAWAII


DEPARTMENT OF TRANSPORTATION HIGHWAYS DIVISION

HONOLULU, HAWAII

"AS BUILT" PLANS FOR CONSTRUCTION OF A PORTION OF


## KALANIANAOLE HIGHWAY WIDENING

AINA KOA AVENUE TOWARD AINA HAINA PROJECT NO. 72B-03-68 UNIT I (AINA KOA AVENUE TO LAUKAHI STREET) DISTRICT OF HONOLULU ISLAND OF OAHU

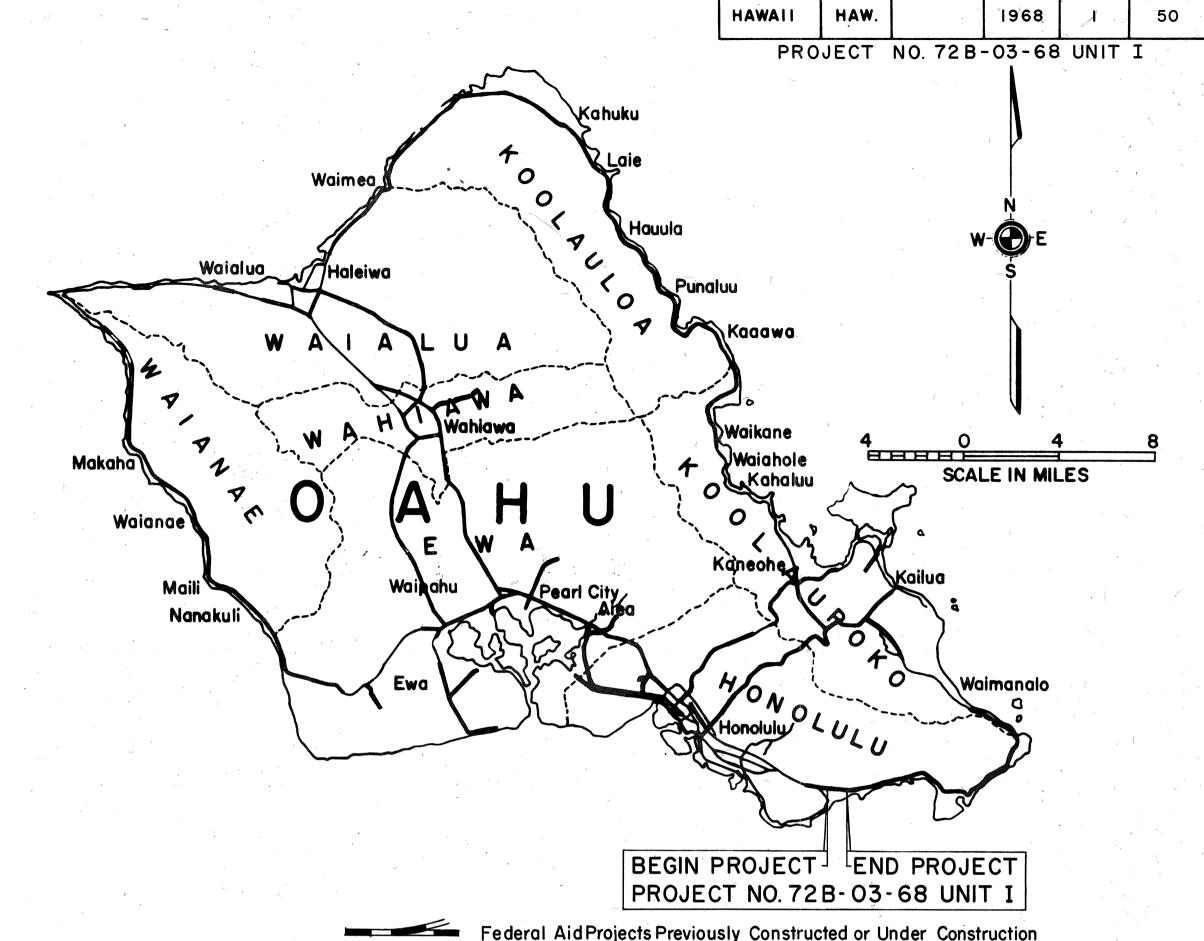

FED. ROAD STATE PROJ. NO. FISCAL SHEET TOTAL PROJ. NO. SHEETS

DIR. OF TRANSPORTATION

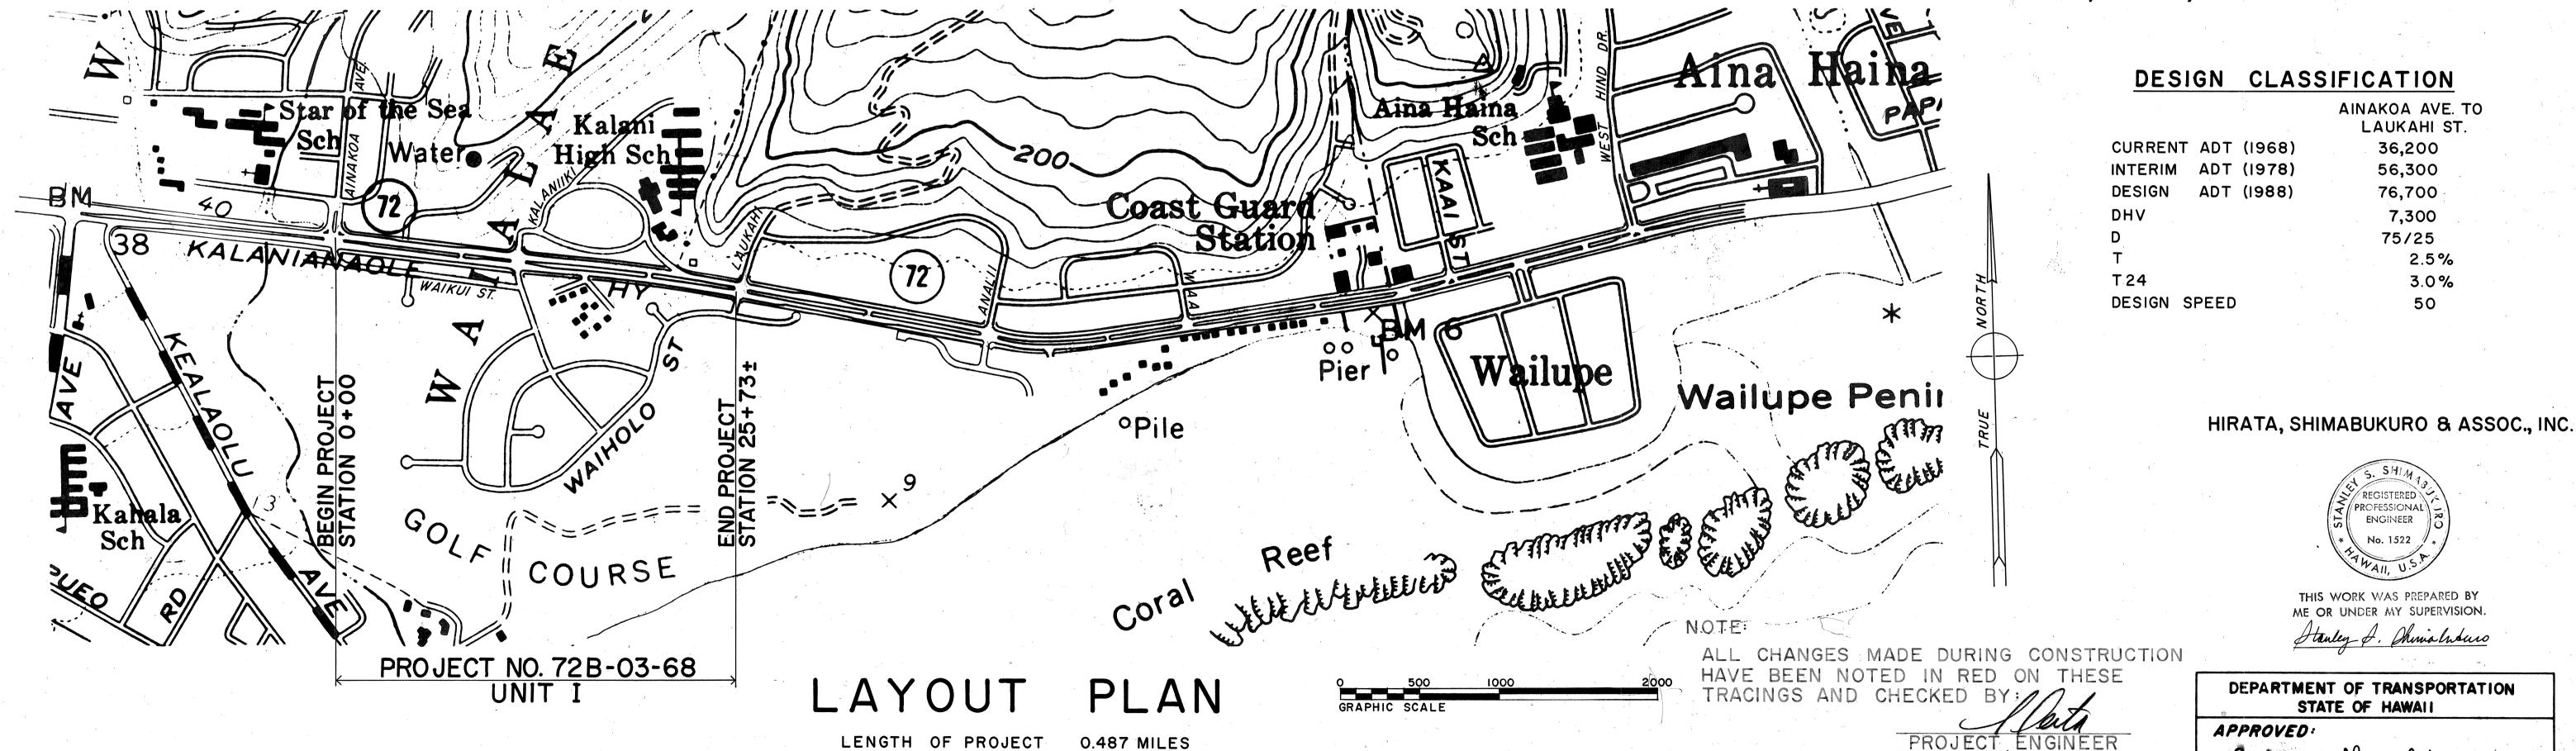

0.487 MILES