

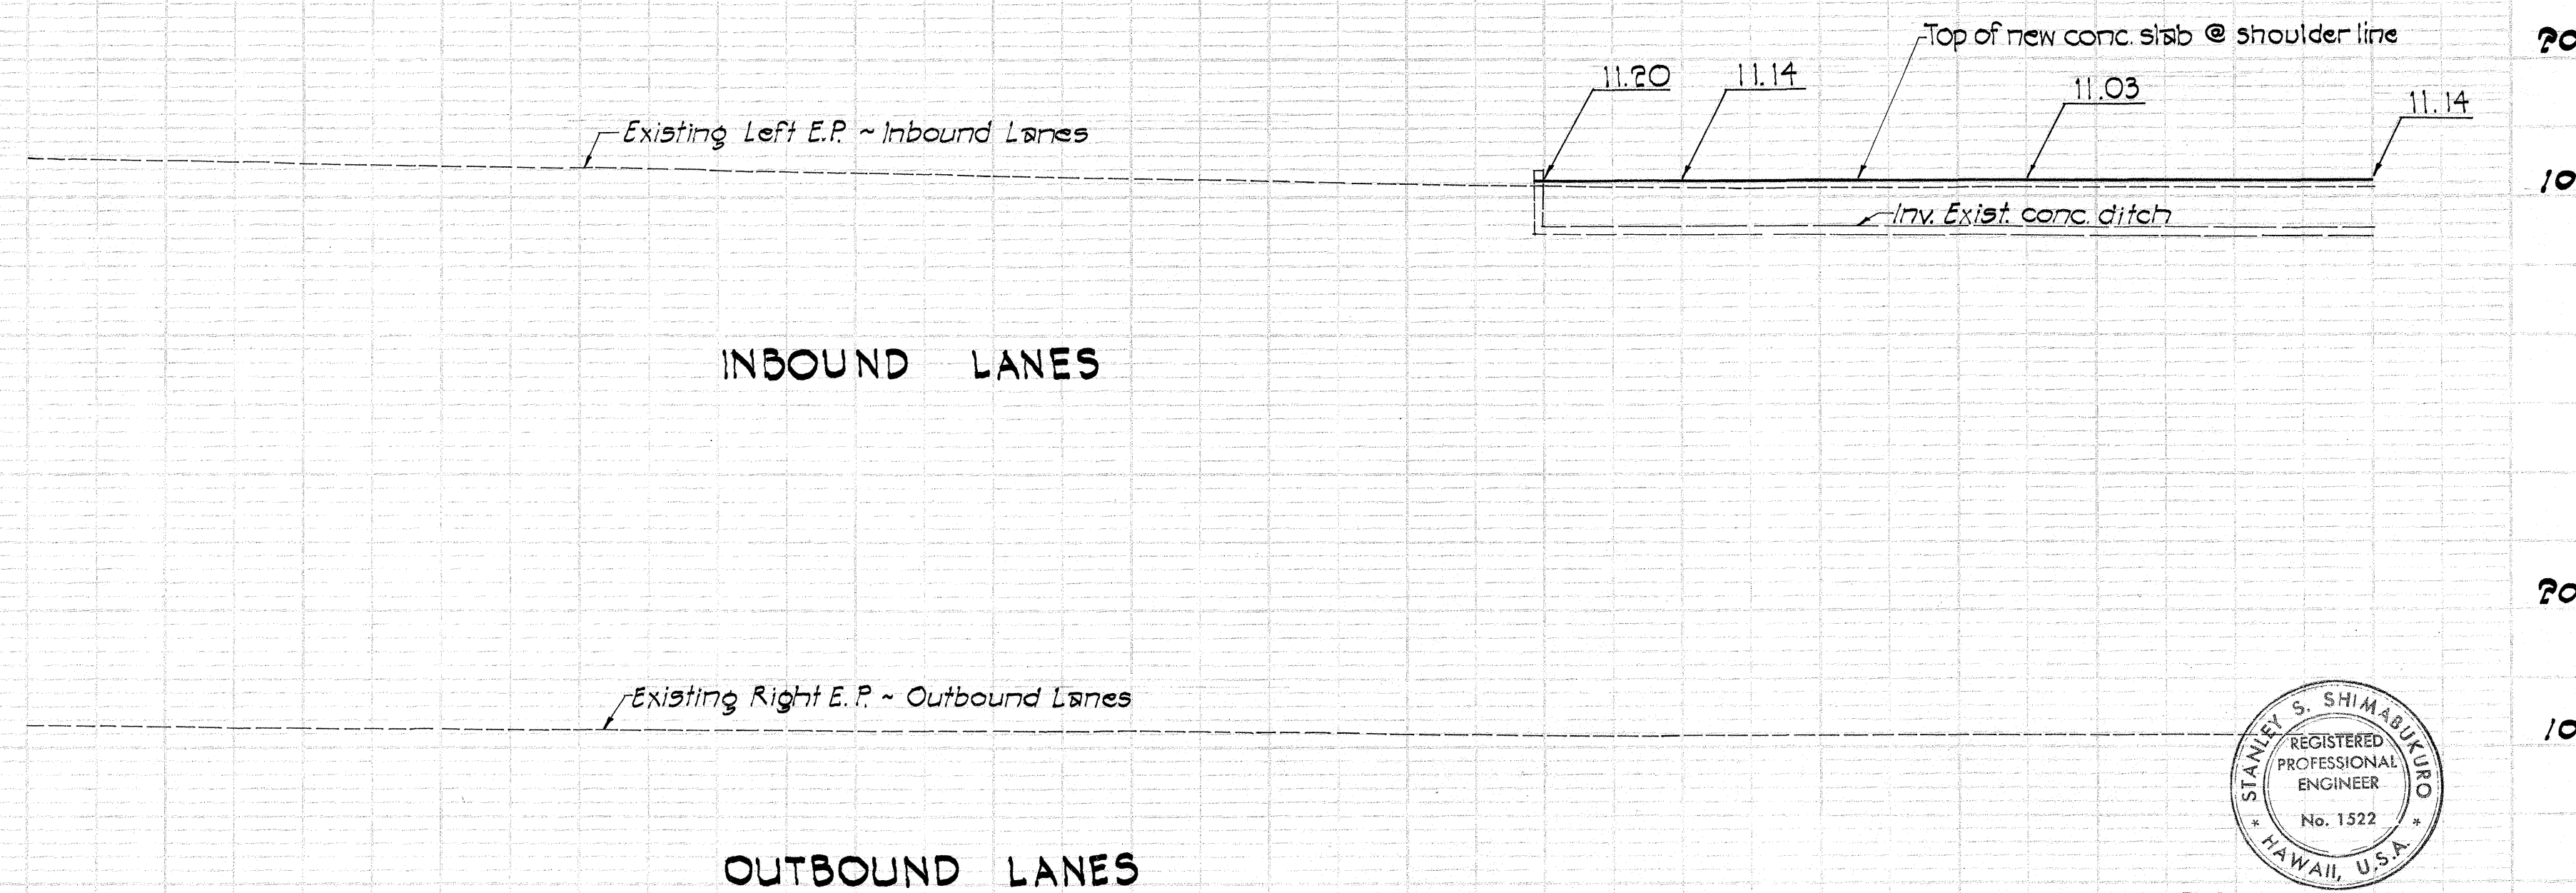


1. Shoulder pavement shall be the same as travelled way pavement in those designated areas.
2. Branches of trees encroaching into the outside shoulders of both the inbound and outbound lanes shall be trimmed to provide a minimum of 15 feet vertical clearance. All shrubbery shall be trimmed back as necessary. Incidental to various items of work.
3. Hibiscus plants shall be trimmed and transplanted into planter box at 3 feet o.c. The contractor may at his option provide slips from the existing plants.
4. All demolition work unless otherwise noted shall be incidental to Roadway Excavation.
5. The contractor shall place first priority on the Inbound Lanes and shall have all improvements complete and open to traffic within 40 working days from the Date of Notice to Proceed.
6. All mail boxes to remain.

FED. ROAD DIST. NO.	STATE	PROJ. NO.	FISCAL YEAR	SHEET NO.	TOTAL SHEET
HAWAII	HAW.	72B-03-68 UNIT II	1968	4	71

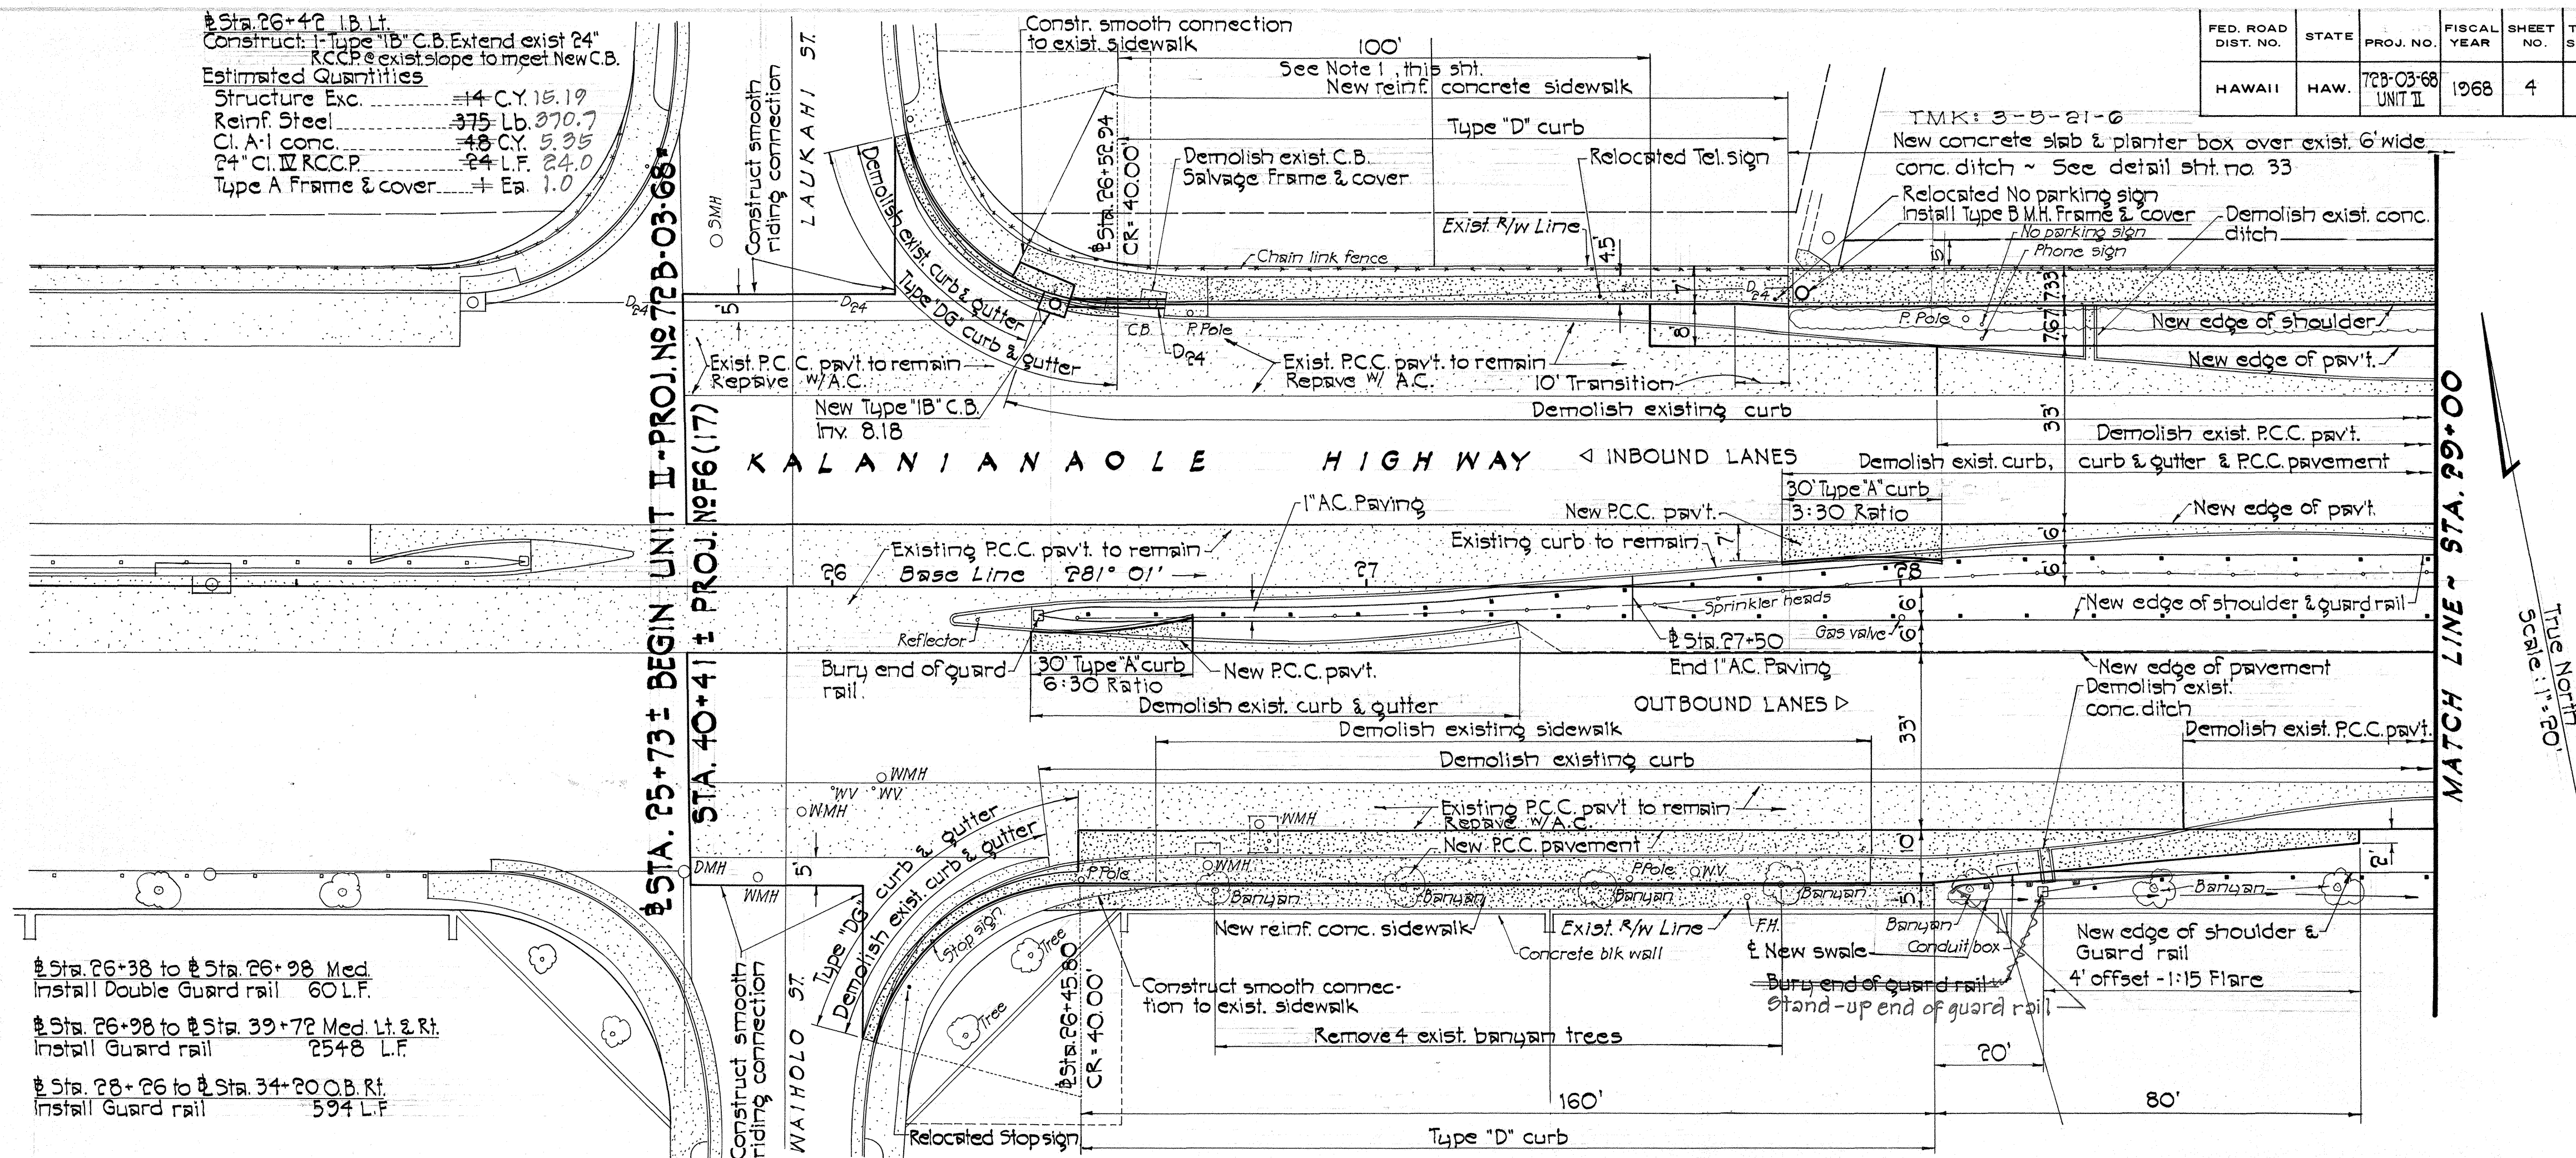

THIS WORK WAS PREPARED BY
ME OR UNDER MY SUPERVISION.
Stanley B. Chinsaburo



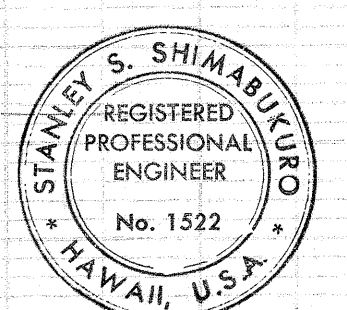


THIS WORK WAS PREPARED BY
ME OR UNDER MY SUPERVISION.
Stanley B. Shimaluk

PLAN
 DRAWN BY: [blank]
 CHECKED BY: [blank]
 DATE: [blank]

PROFILE
 DRAWN BY: [blank]
 CHECKED BY: [blank]
 DATE: [blank]

FED. ROAD DIST. NO.	STATE	PROJ. NO.	FISCAL YEAR	SHEET NO.	TOTAL SHEETS
HAWAII	HAW.	728-03-68 UNIT II	1968	8	71

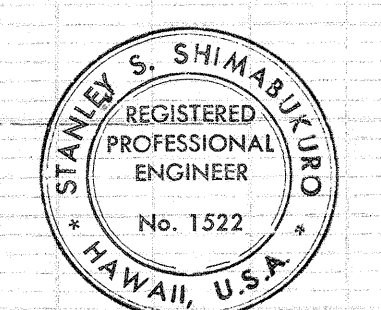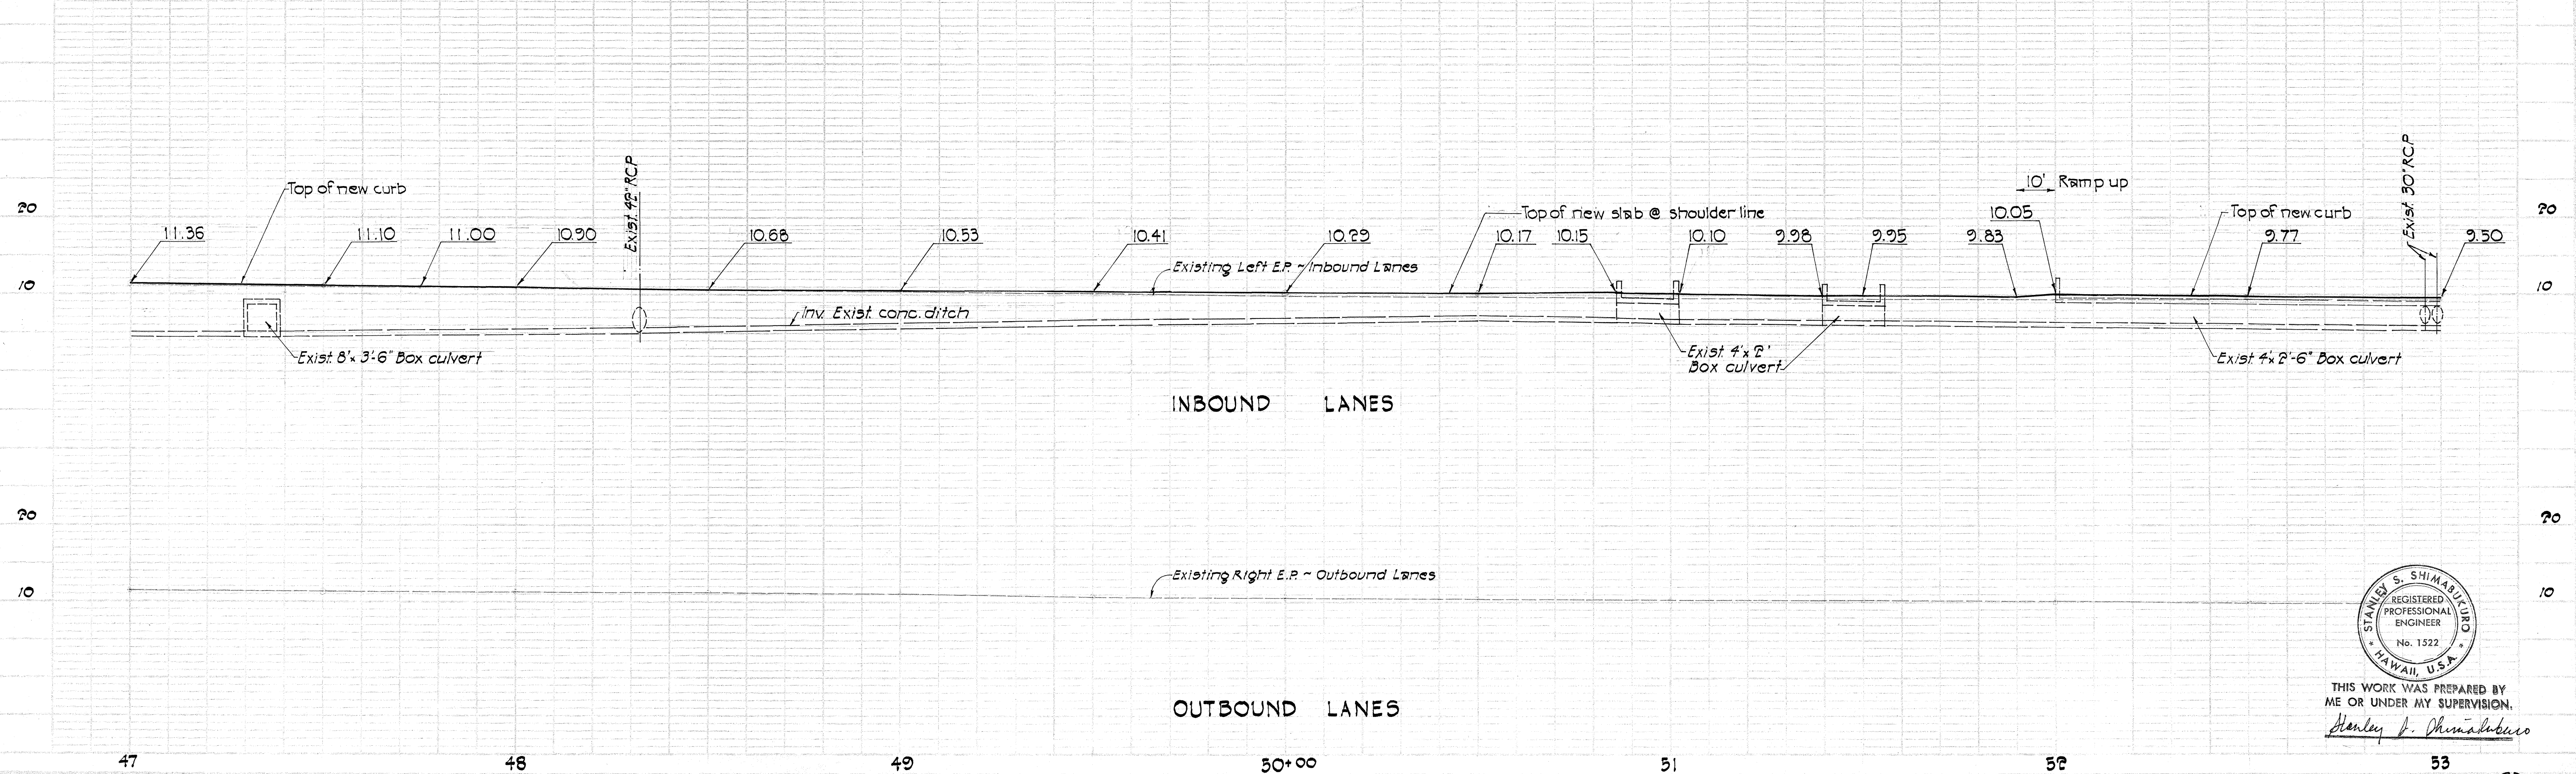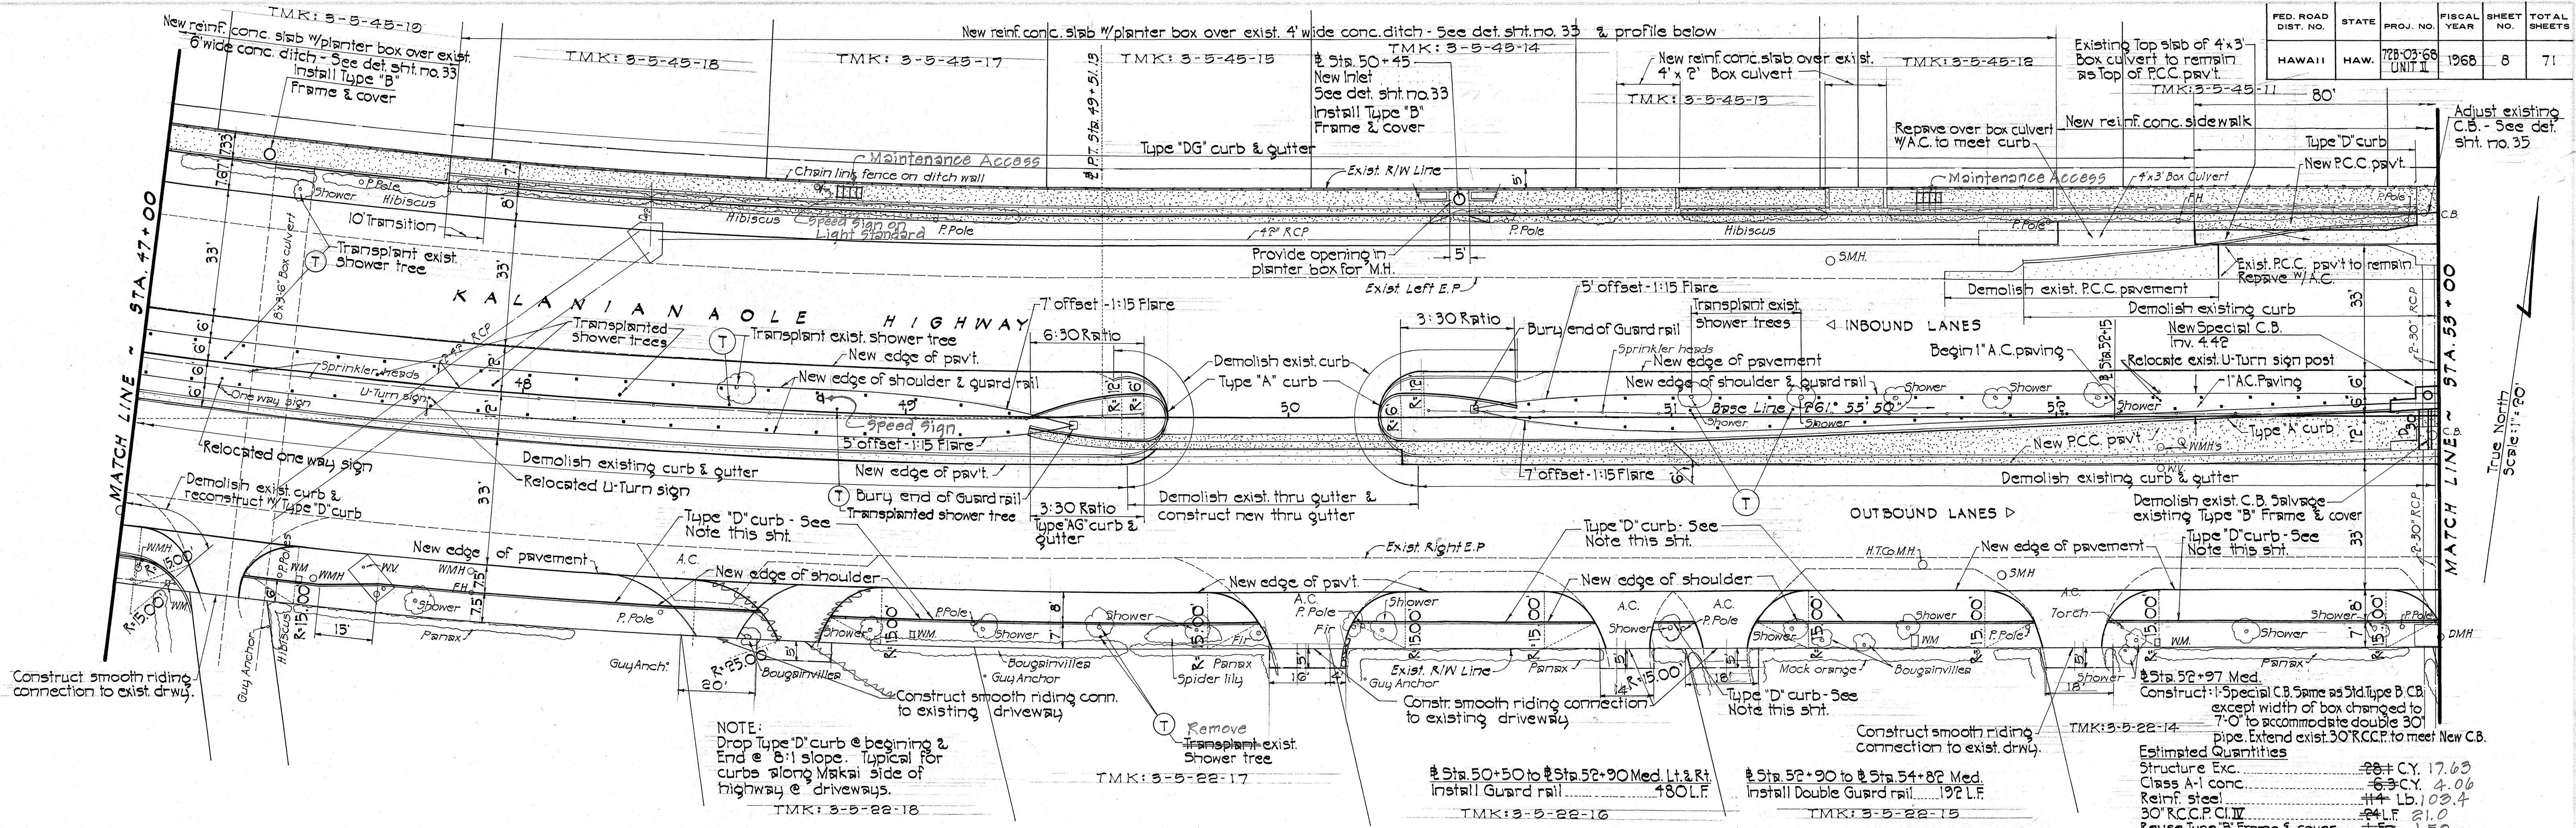



THIS WORK WAS PREPARED BY ME OR UNDER MY SUPERVISION.
 Stanley S. Shimabara

DD-D-3-4

FED. ROAD DIST. NO.	STATE	PROJ. NO.	FISCAL YEAR	SHEET NO.	TOTAL SHEETS
HAWAII	HAW.	728-03-68 UNIT II	1968	9	71



PLAN	DATE	BY	DATE	BY
SURVEYED				
NOTE BOOK				
NO.				


PROFILE	DATE	BY	DATE	BY
SURVEYED				
NOTE BOOK				
NO.				

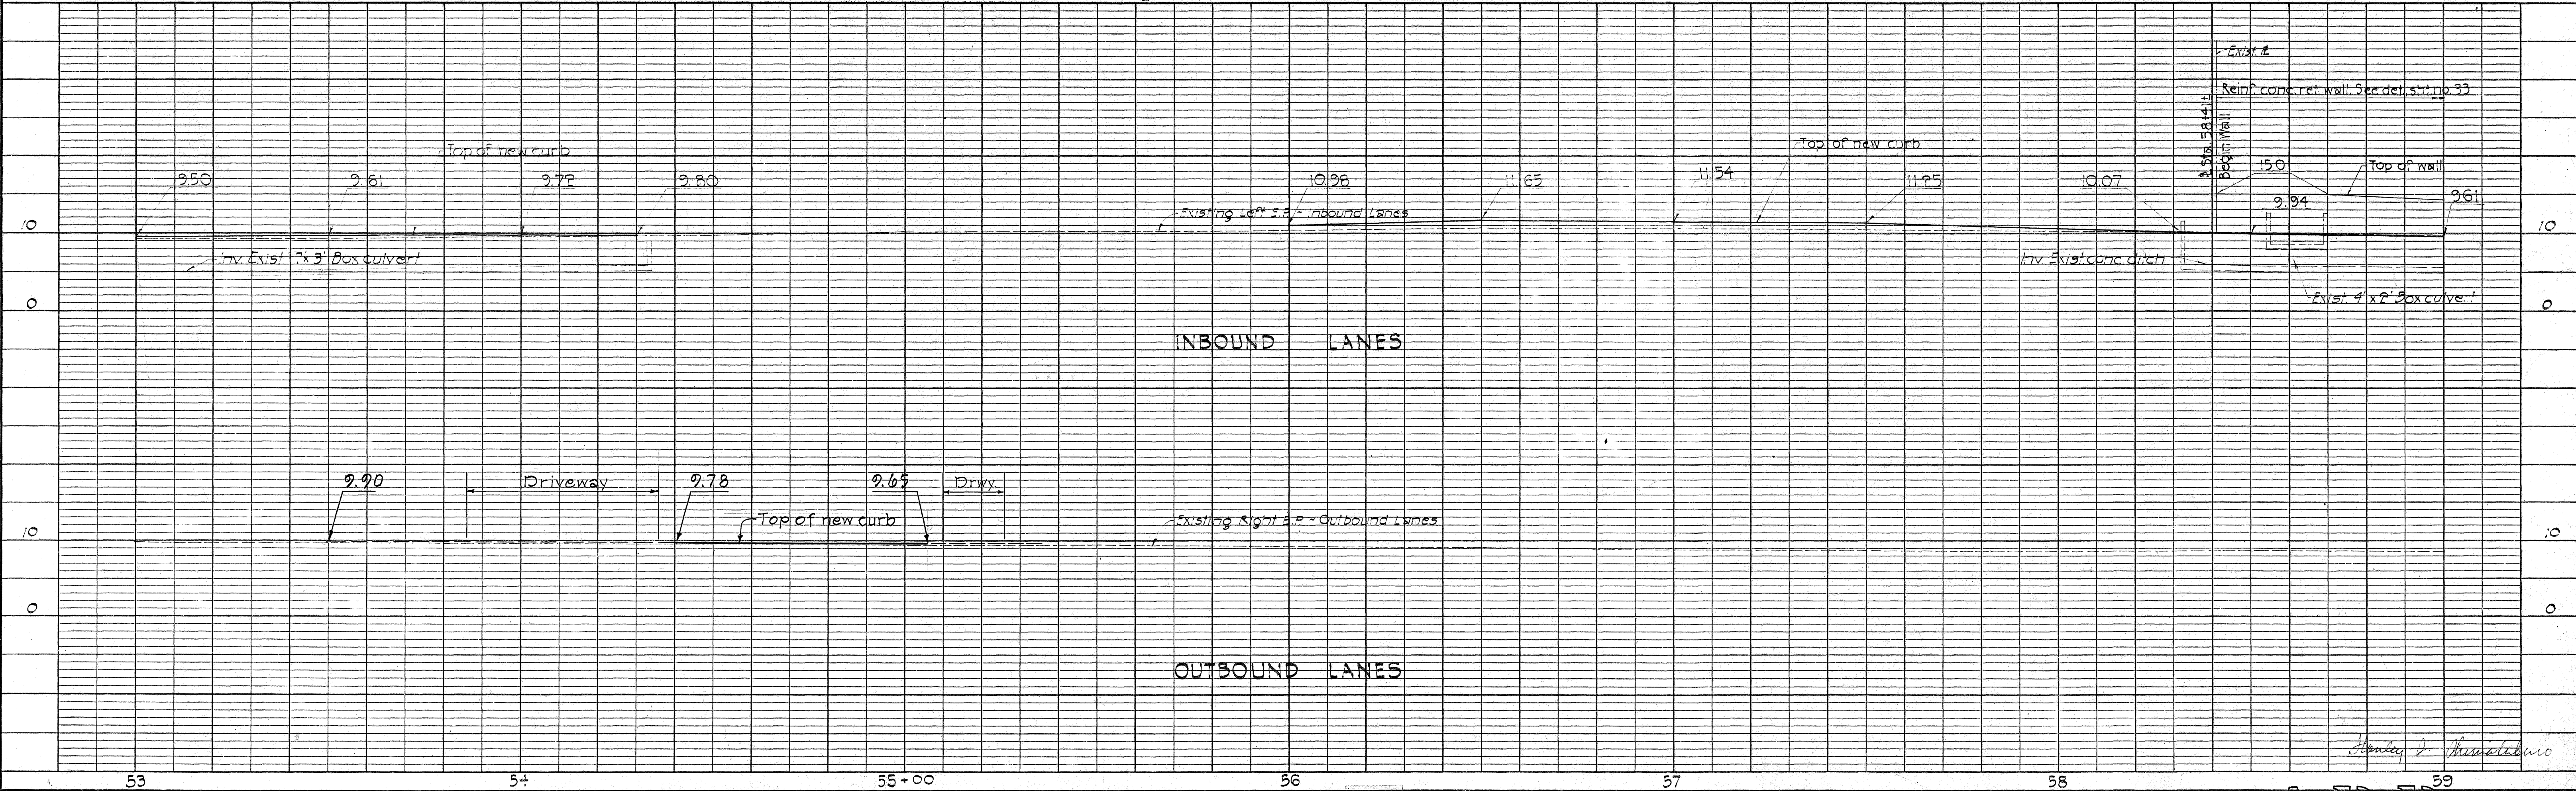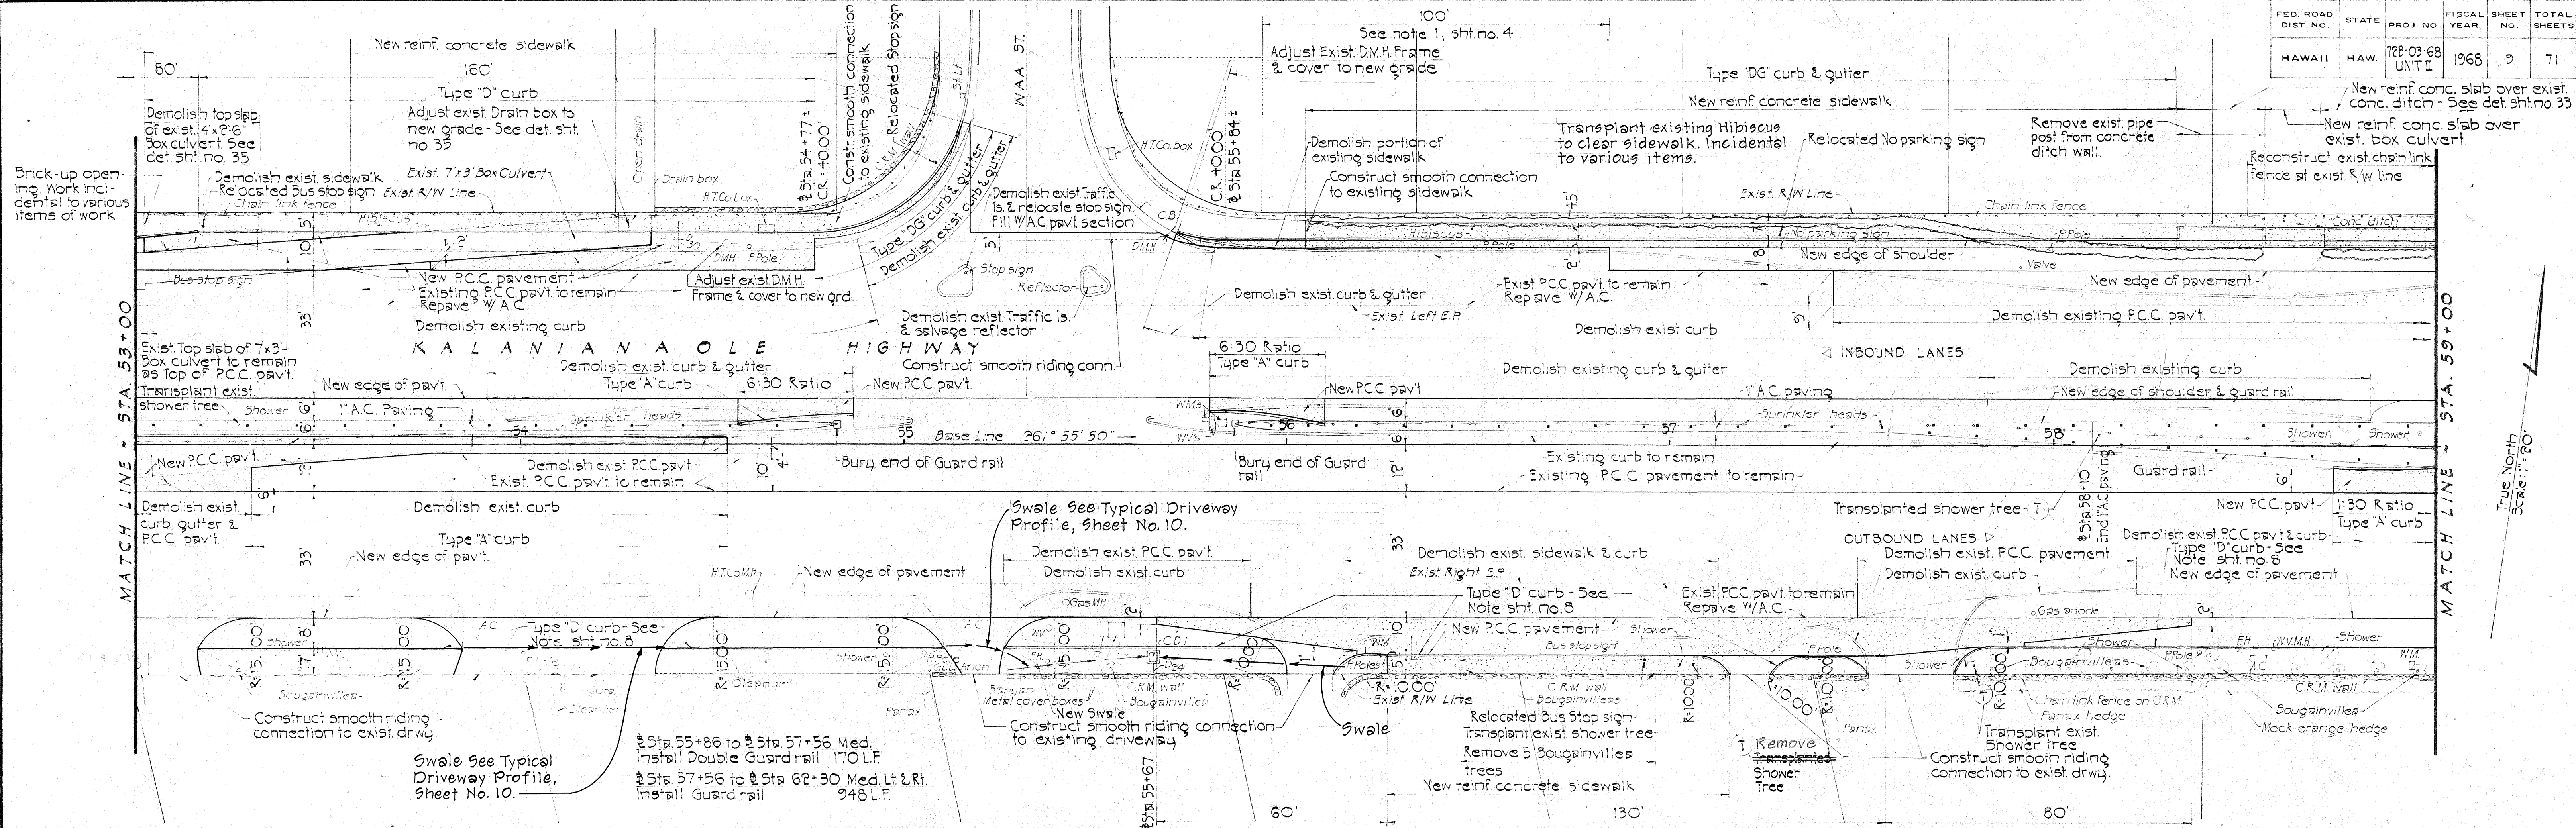

PLAN	DATE	BY	NO.
SURVEYED			
NOTE BOOK			
ALIGNMENT CHECKED			
RT. OF WAY CHECKED			

PROFILE	DATE	BY	NO.
SURVEYED			
NOTE BOOK			
GRADES CHECKED			
B. M. NOTED			
STRUCTURE NOTATIONS CHECKED			

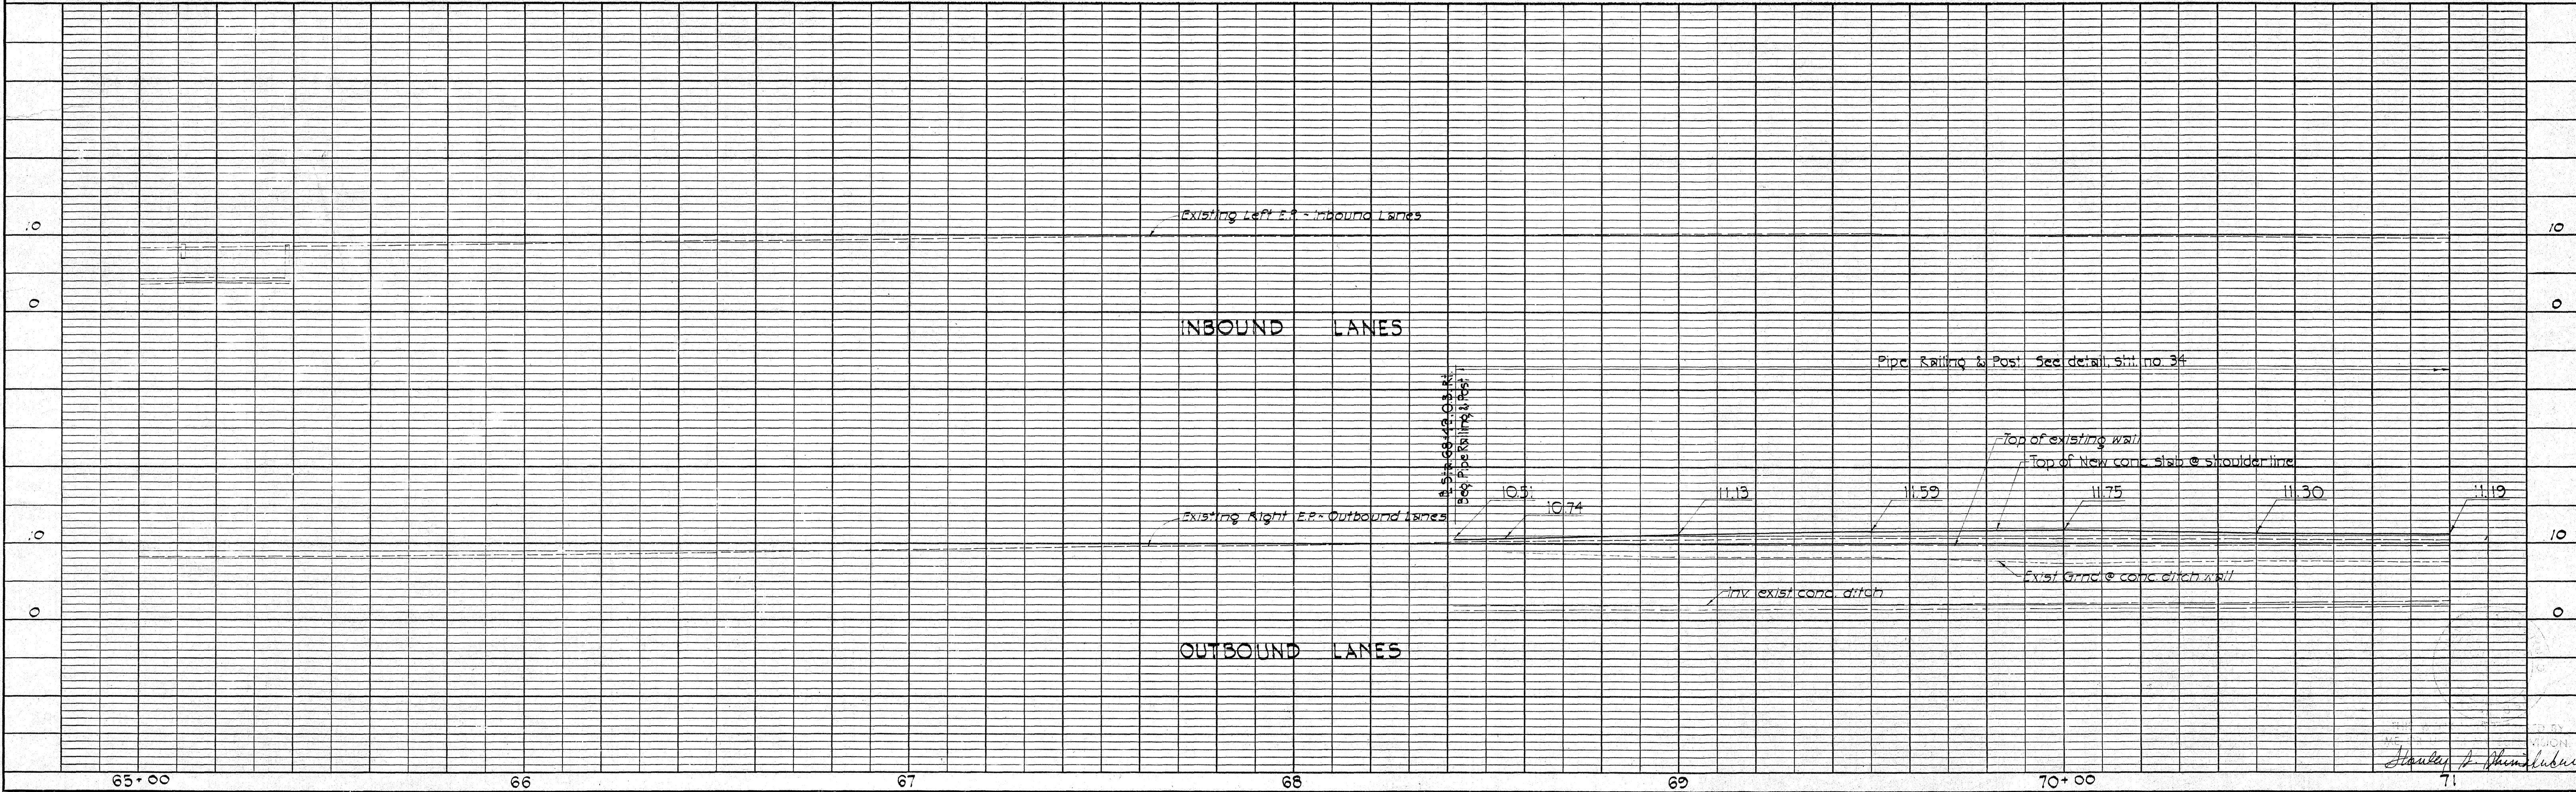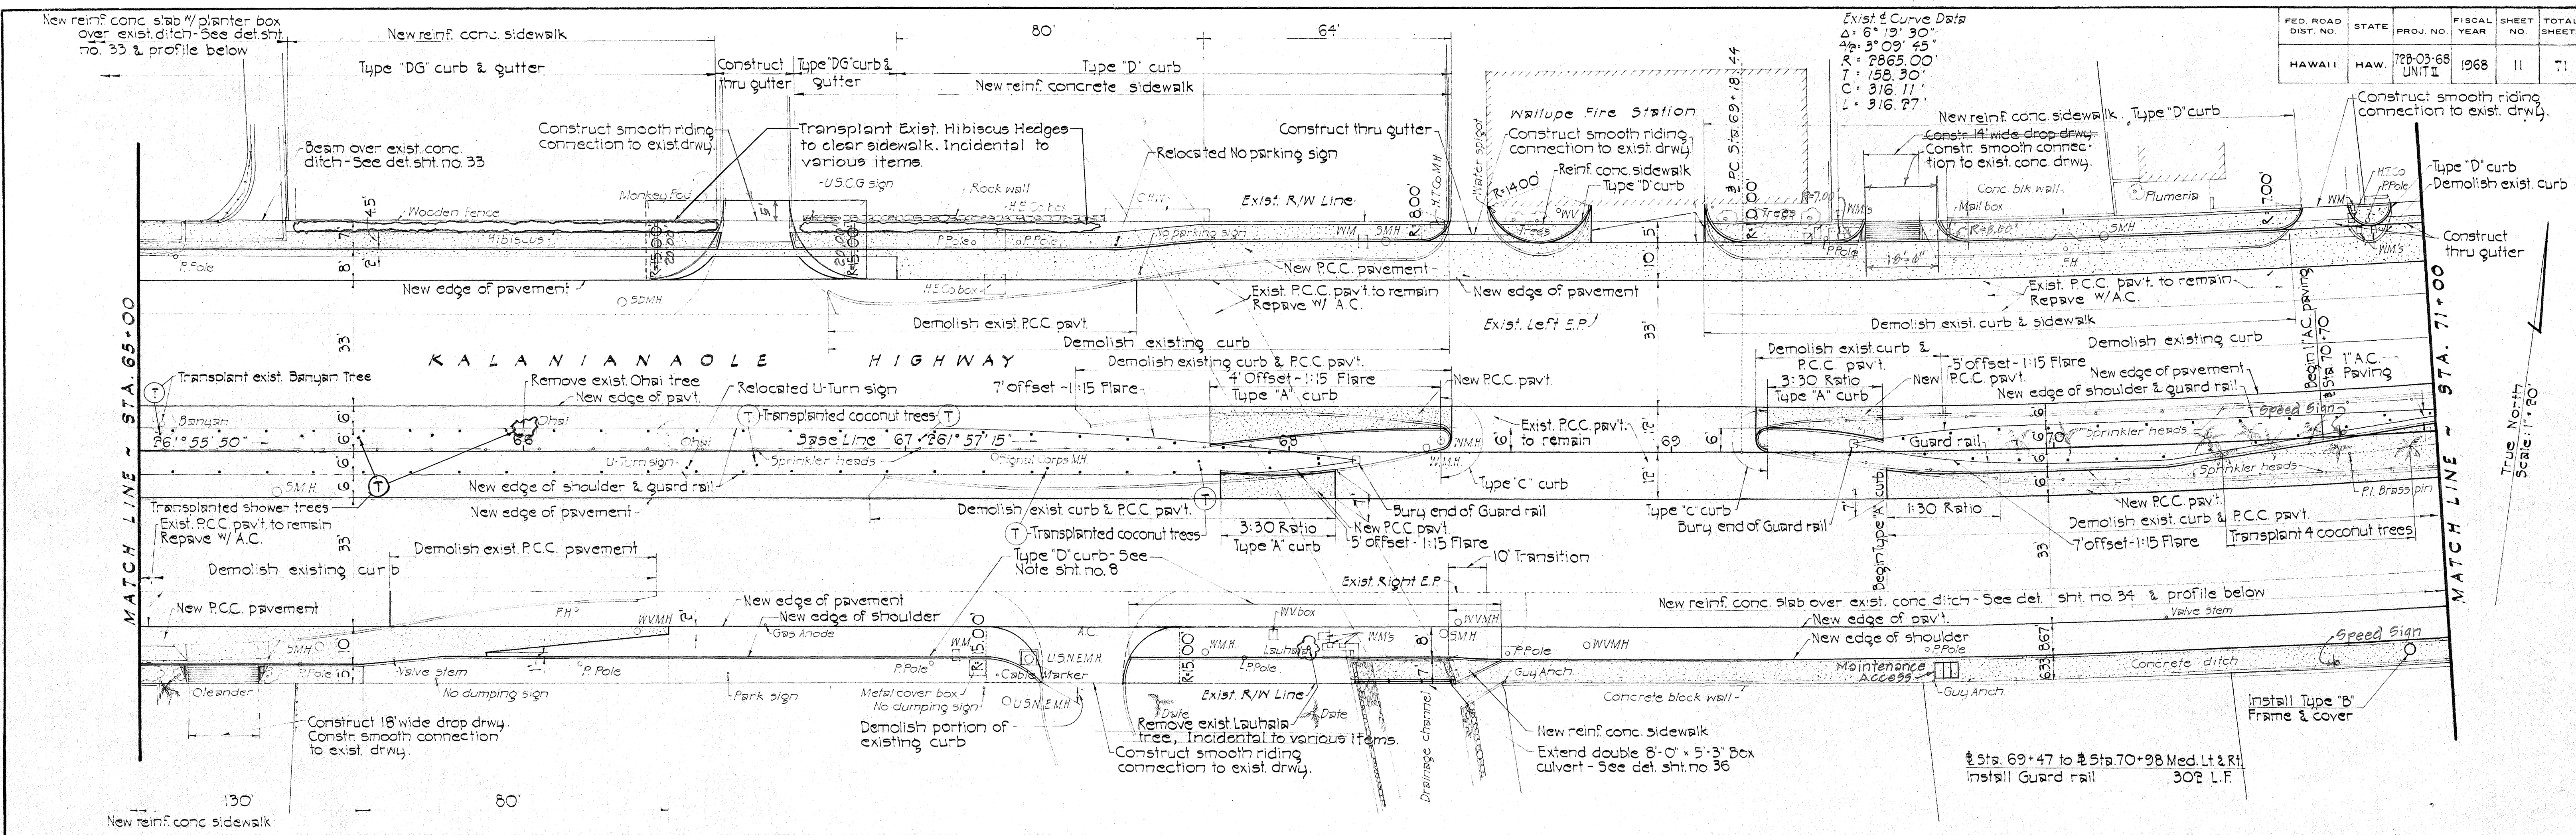

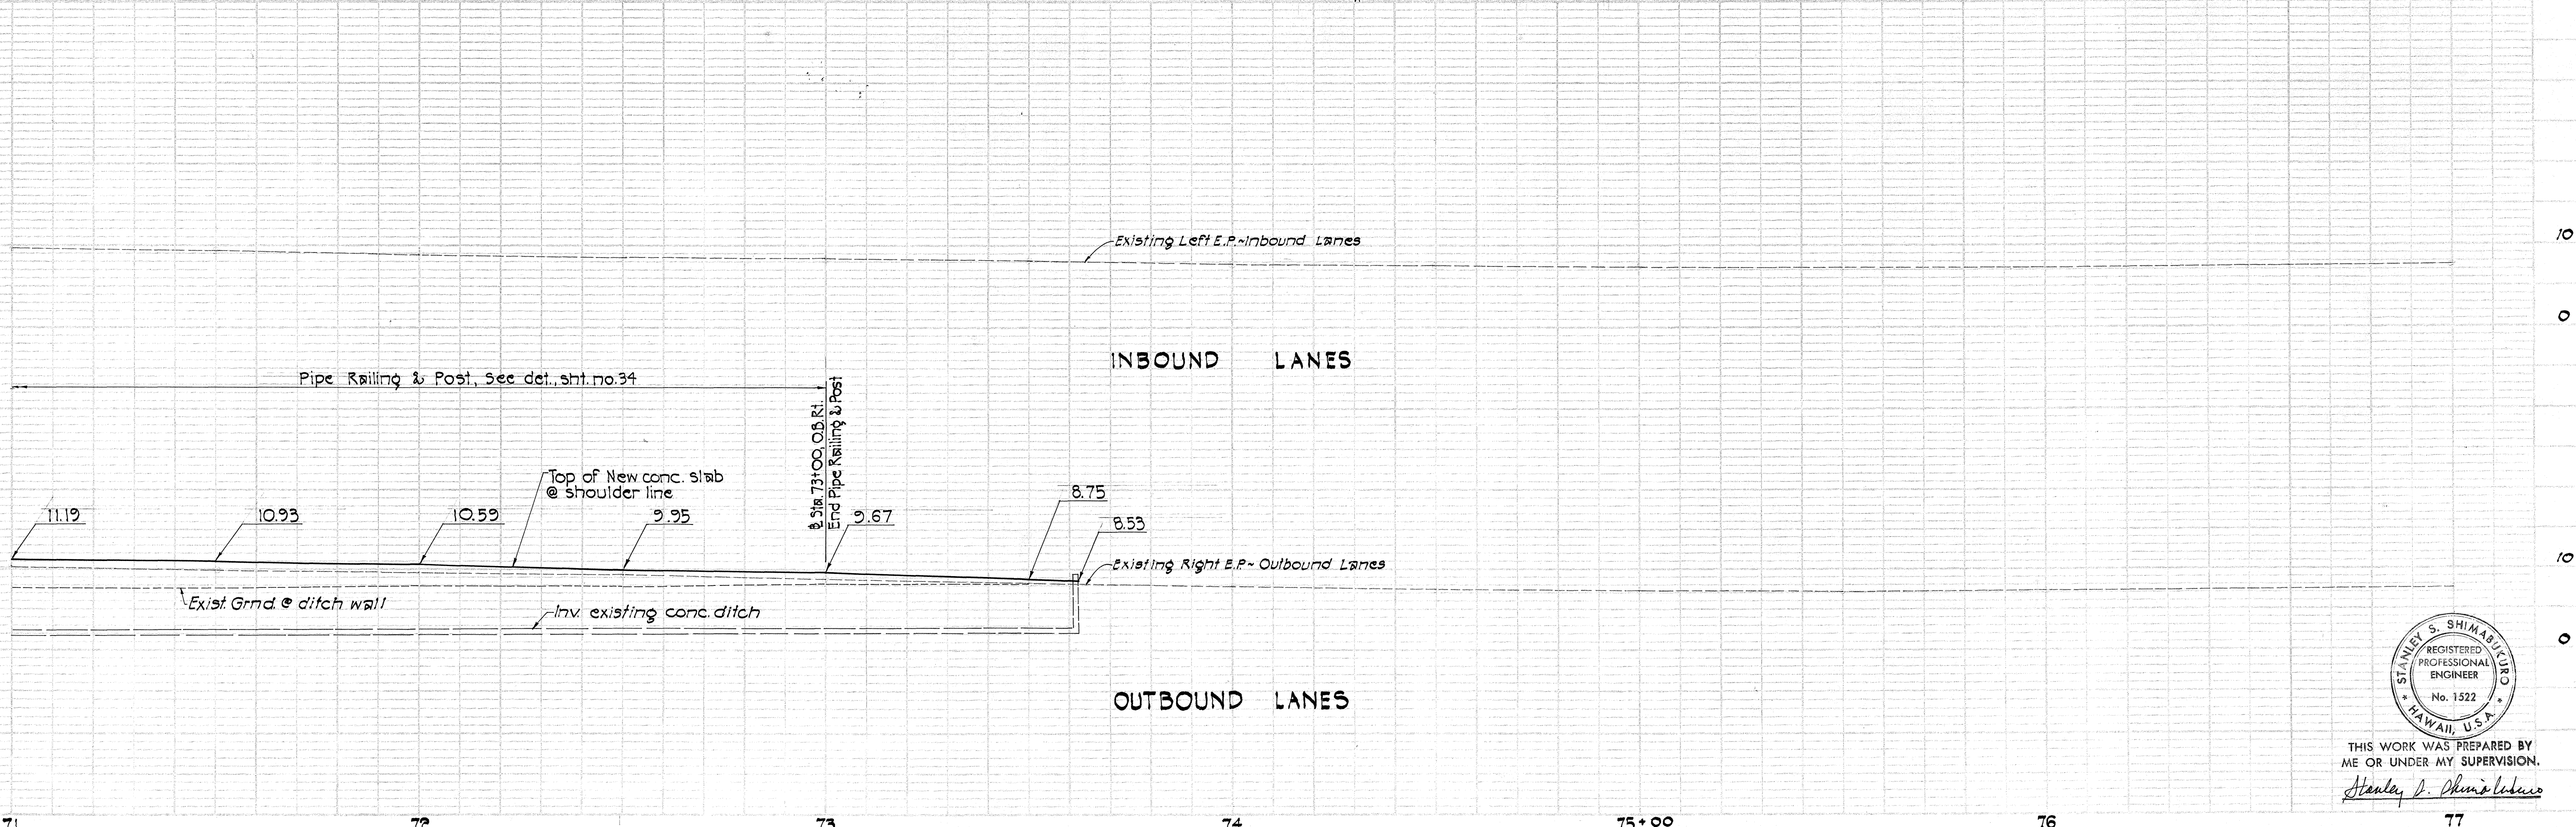

THIS WORK WAS PREPARED BY
ME OR UNDER MY SUPERVISION.
Stanley J. Phinias

