INDEX TO DRAWINGS	
SHEET NO.	DESCRIPTION
1	TITLE SHEET
2 - 3	TYPICAL ROADWAY SECTIONS
4-14	PLAN & PROFILE
15-25	SEWER, WATER, GAS & SPRINKLER
	SYSTEM
26 - 32	ELECTRIC, TELEPHONE, HIGHWAY
·	LIGHTING & TRAFFIC SIGNAL SYSTE
33 - 36	ROADWAY & DRAINAGE DETAILS
37- 39	ELECTRIC, TELEPHONE, HIGHWAY
	LIGHTING & TRAFFIC SIGNAL SYSTEM
	DETAILS
40 - 53	STANDARD HIGHWAY DETAILS
54-71	STANDARD ELECTRIC, TELEPHONE,
	HIGHWAY LIGHTING & TRAFFIC
,	SIGNAL SYSTEM DETAILS

STATE OF HAWAII

DEPARTMENT OF TRANSPORTATION HIGHWAYS DIVISION


HONOLULU, HAWAII


"AS BUILT" PLANS FOR

CONSTRUCTION OF A PORTION OF

KALANIANAOLE HIGHWAY WIDENING

AINA KOA AVENUE TOWARD AINA HAINA PROJECT NO. 72B-03-68 UNIT II (LAUKAHI STREET TO WEST HIND DRIVE) DISTRICT OF HONOLULU ISLAND OF OAHU

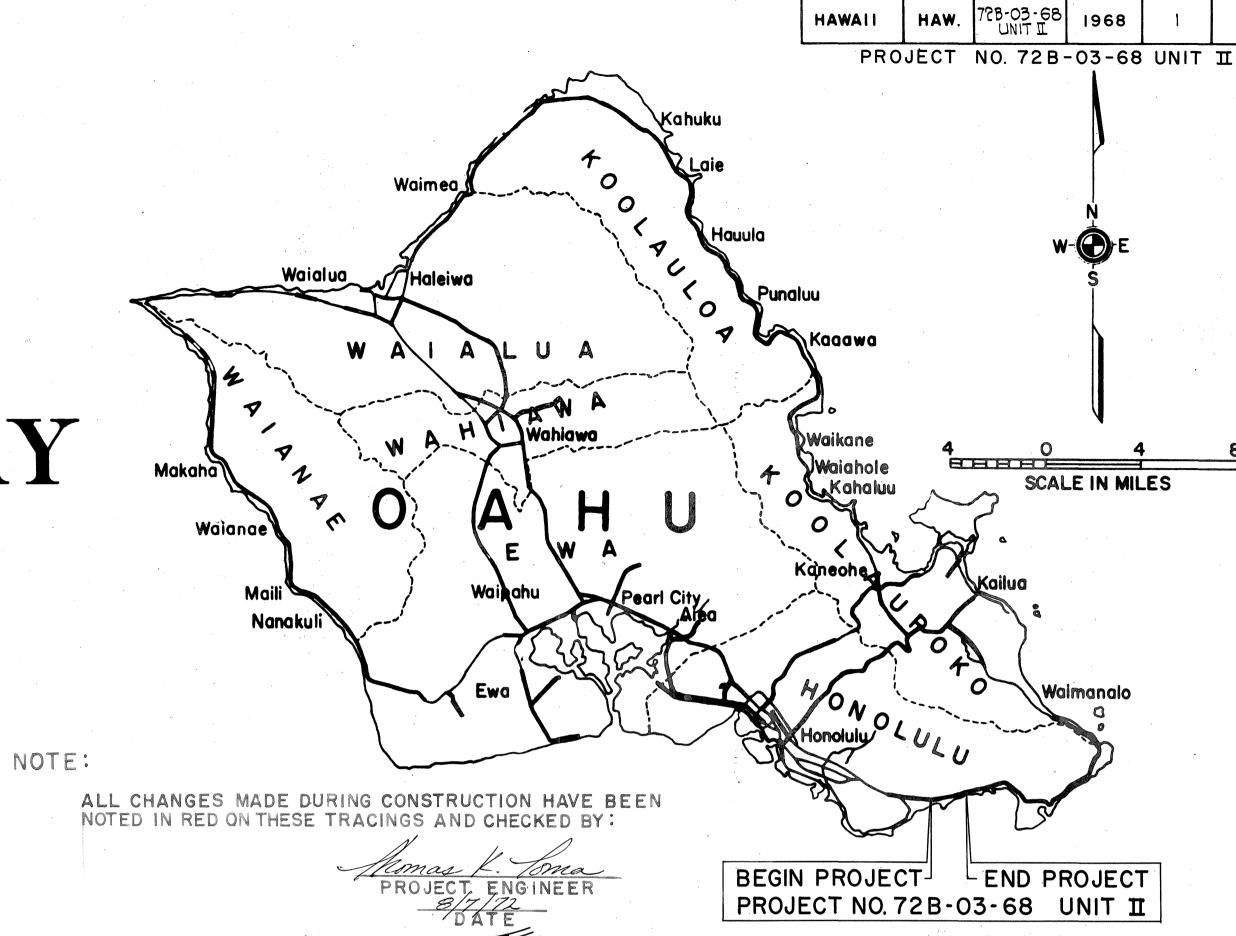

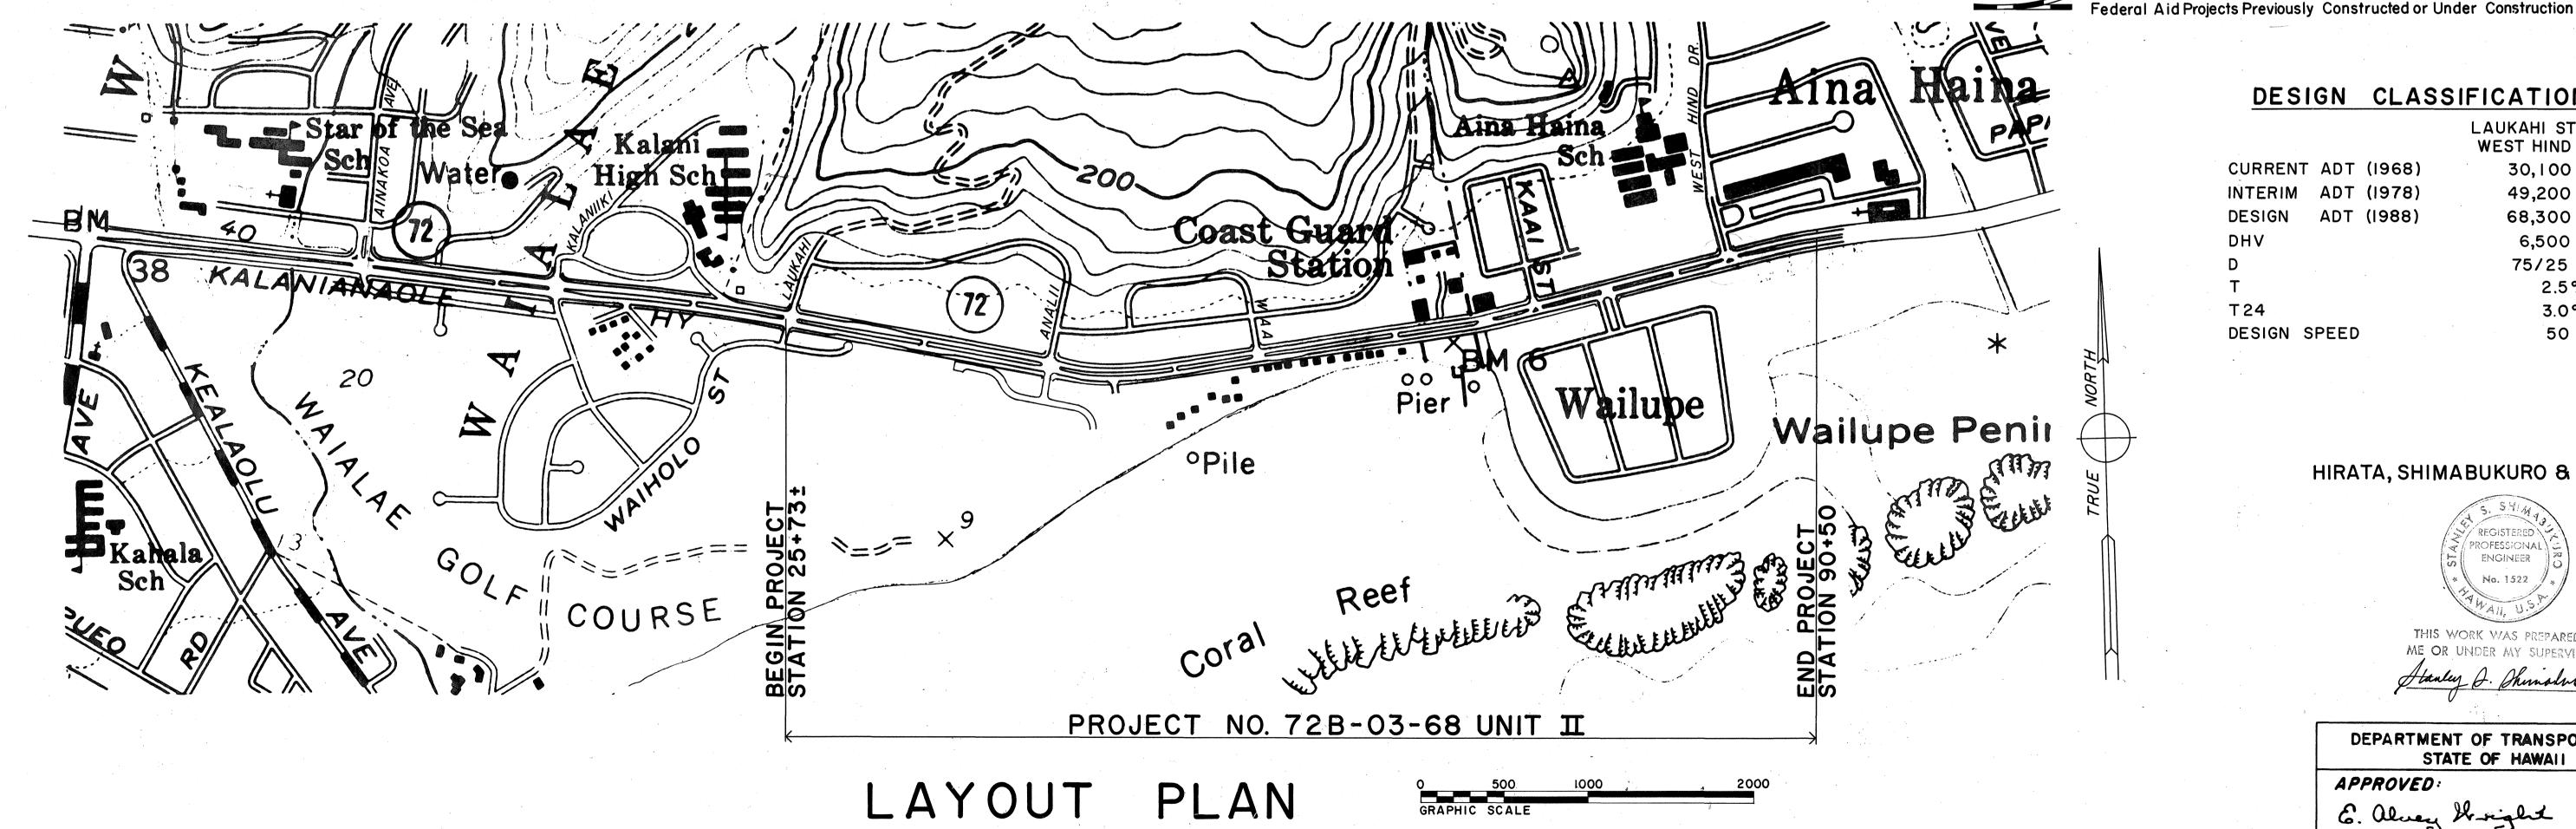

1.321 MILES

LENGTH OF PROJECT


DESIGN CLASSIFICATION

FED. ROAD DIST. NO.

FISCAL S

LAUKAHI ST. TO WEST HIND DR. CURRENT ADT (1968) 30,100 49,200 INTERIM ADT (1978) 68,300 ADT (1988) 6,500 75/25 2.5% 3.0% DESIGN SPEED

HIRATA, SHIMABUKURO & ASSOC., INC.

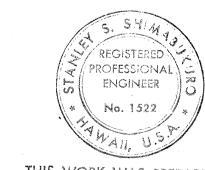

DEPARTMENT OF TRANSPORTATION STATE OF HAWAII APPROVED: 11/7/68

6. alway thright DIR. OF TRANSPORTATION