SHEET NO.	DESCRIPTION
1	TITLE SHEET
2	TRAFFIC SIGNAL SYSTEM
* 3-4	MISCELLANEOUS DETAILS
,	

STATE OF HAWAII

DEPARTMENT OF TRANSPORTATION

HIGHWAYS DIVISION

HONOLULU, HAWAII

"AS BUILT"

PLANS FOR

INSTALLATION OF TRAFFIC SIGNALS

ON

KALANIANAOLE HIGHWAY


AT

HALEMAUMAU STREET


PROJECT NO.


72C-03-68

DISTRICT OF HONOLULU ISLAND OF OAHU

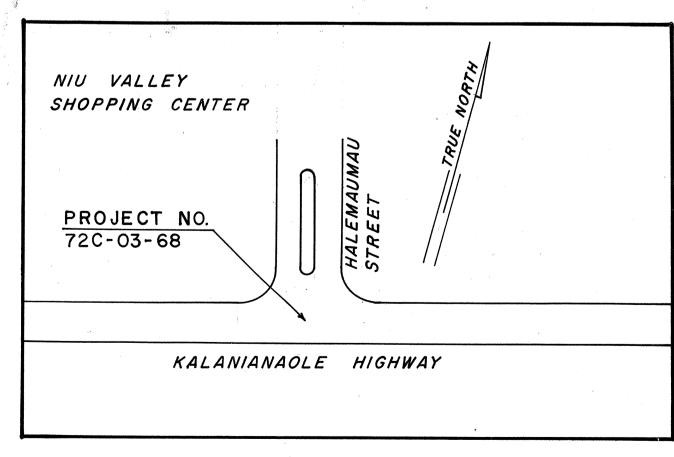

LAYOUT PLAN

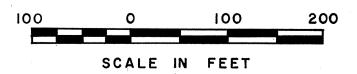

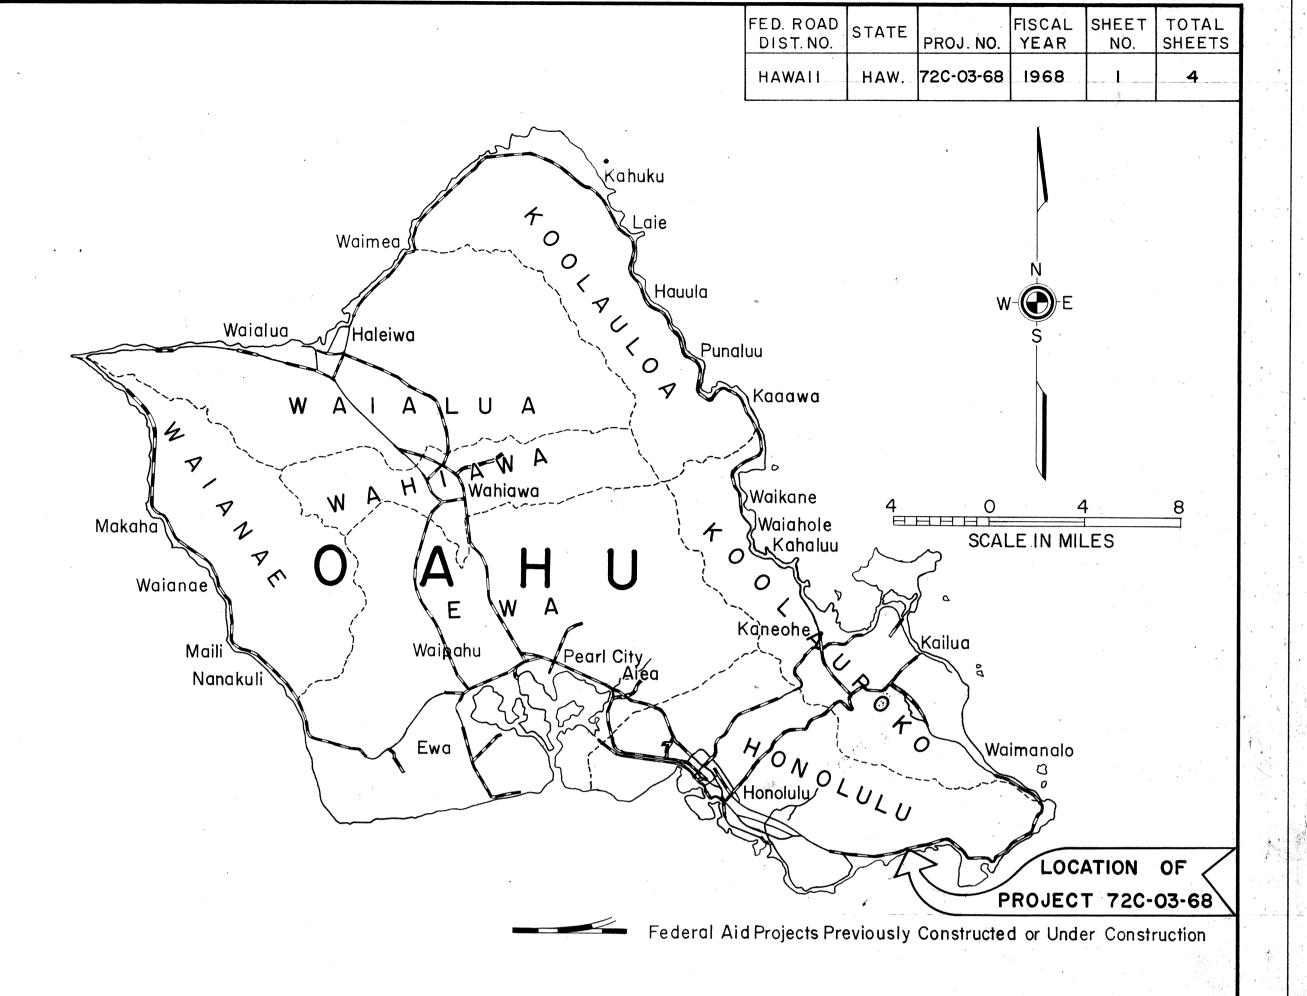

NOTE:

ALL CHANGES MADE DURING CONSTRUCTION HAVE BEEN NOTED IN RED ON THESE TRACINGS AND CHECKED BY

CHECKED BY

PROJECT ENGINEER

0/16/23 DATE

DEPARTMENT OF TRANSPORTATION
STATE OF HAWAII

APPROVED:

DIR. OF TRANSPORTATION DATE