INDEX TO DRAWINGS	
SHEET NO.	DESCRIPTION
l	TITLE SHEET
2 – 3	PLAN
4 - 11	STANDARD DETAILS
See and the control of the control o	
The second secon	
Angen Mendemon rependent unterstellt i Lieben (Lieben des productions des parties et en en ede	
The second of the second secon	

STATE OF HAWAII

DEPARTMENT OF TRANSPORTATION HIGHWAYS DIVISION

HONOLULU, HAWAII


"AS BUILT" PLANS OF


KALANIANAOLE HIGHWAY
AT LUNALILO HOME ROAD INTERSECTION IMPROVEMENTS

PROJECT NO. 72B-04-69

DISTRICT OF HONOLULU

ISLAND OF OAHU

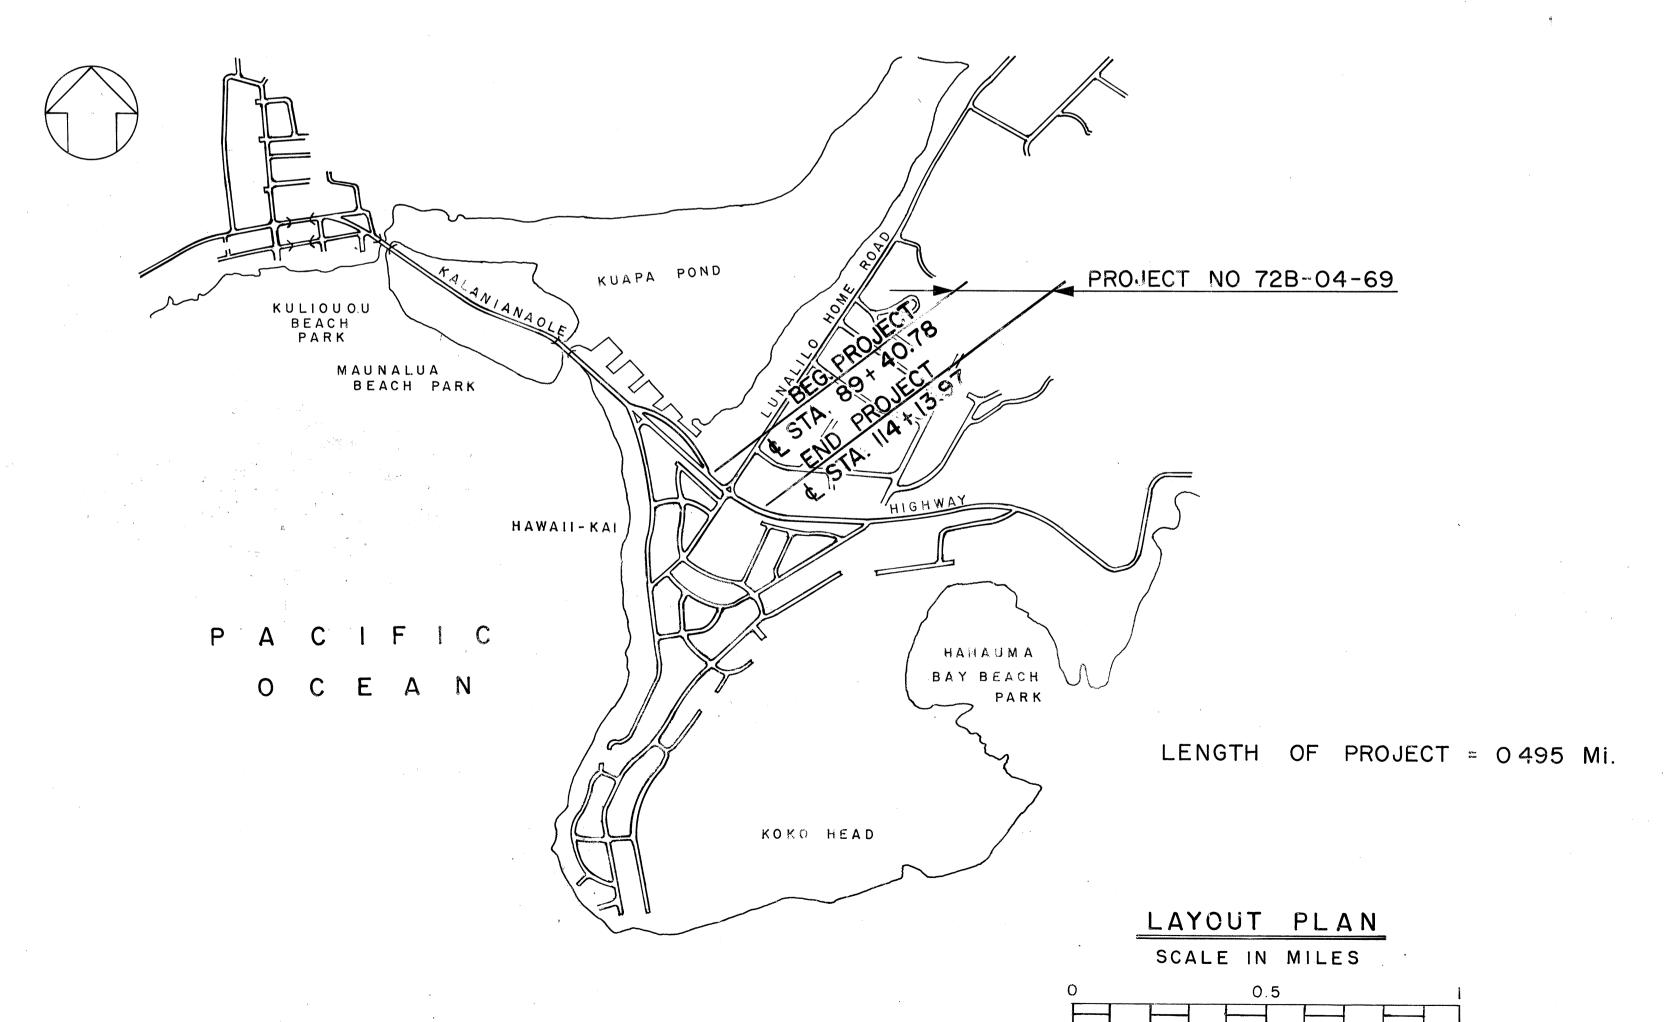

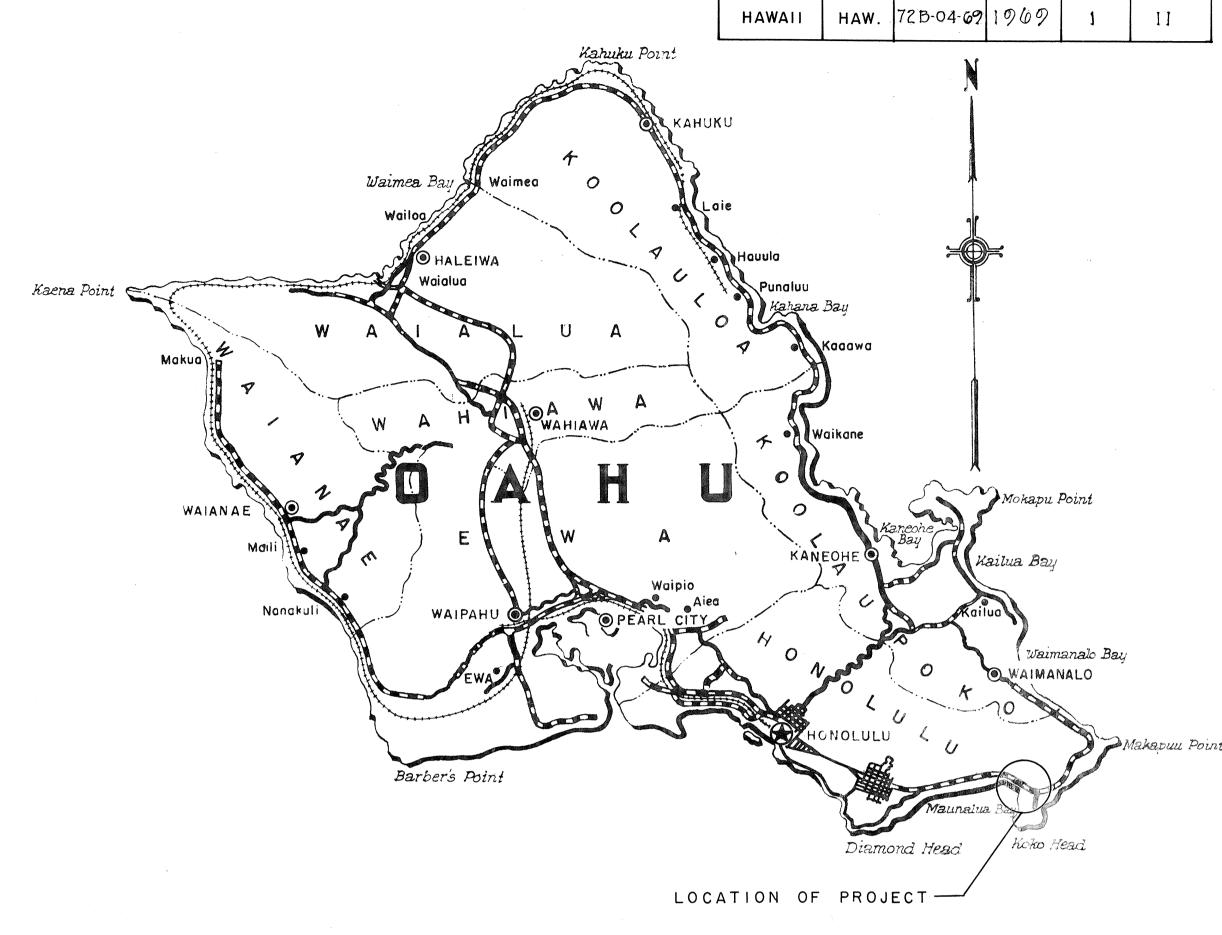

Federal Aid Projects Previously Constructed Or Under Construction

NOTE:

ALL CHANGES MADE DURING CONSTRUCTION HAVE BEEN NOTED IN RED ON THESE TRACINGS AND CHECKED BY:

PROJECT ENGINEER

FED. ROAD STATE PROJ. NO. FISCAL SHEET TOTAL YEAR NO. SHEETS

DATE

DEPARTMENT OF TRANSPORTATION
STATE OF HAWAII

APPROVED:

DIR. OF TRANSPORTATION DATE

7-2-QQ

SURVEY PLOTTED BY
DESIGNED BY
DRAWN BY
TRACED BY
OUANTITIES BY
OUANTITIES CHECKED BY