


FED. ROAD DIST. NO.	STATE	FED. AID PROJ. NO.	FISCAL YEAR	SHEET NO.	TOTAL SHEETS
HAWAII	HAW.	F-072-1(24)	1962	15	26

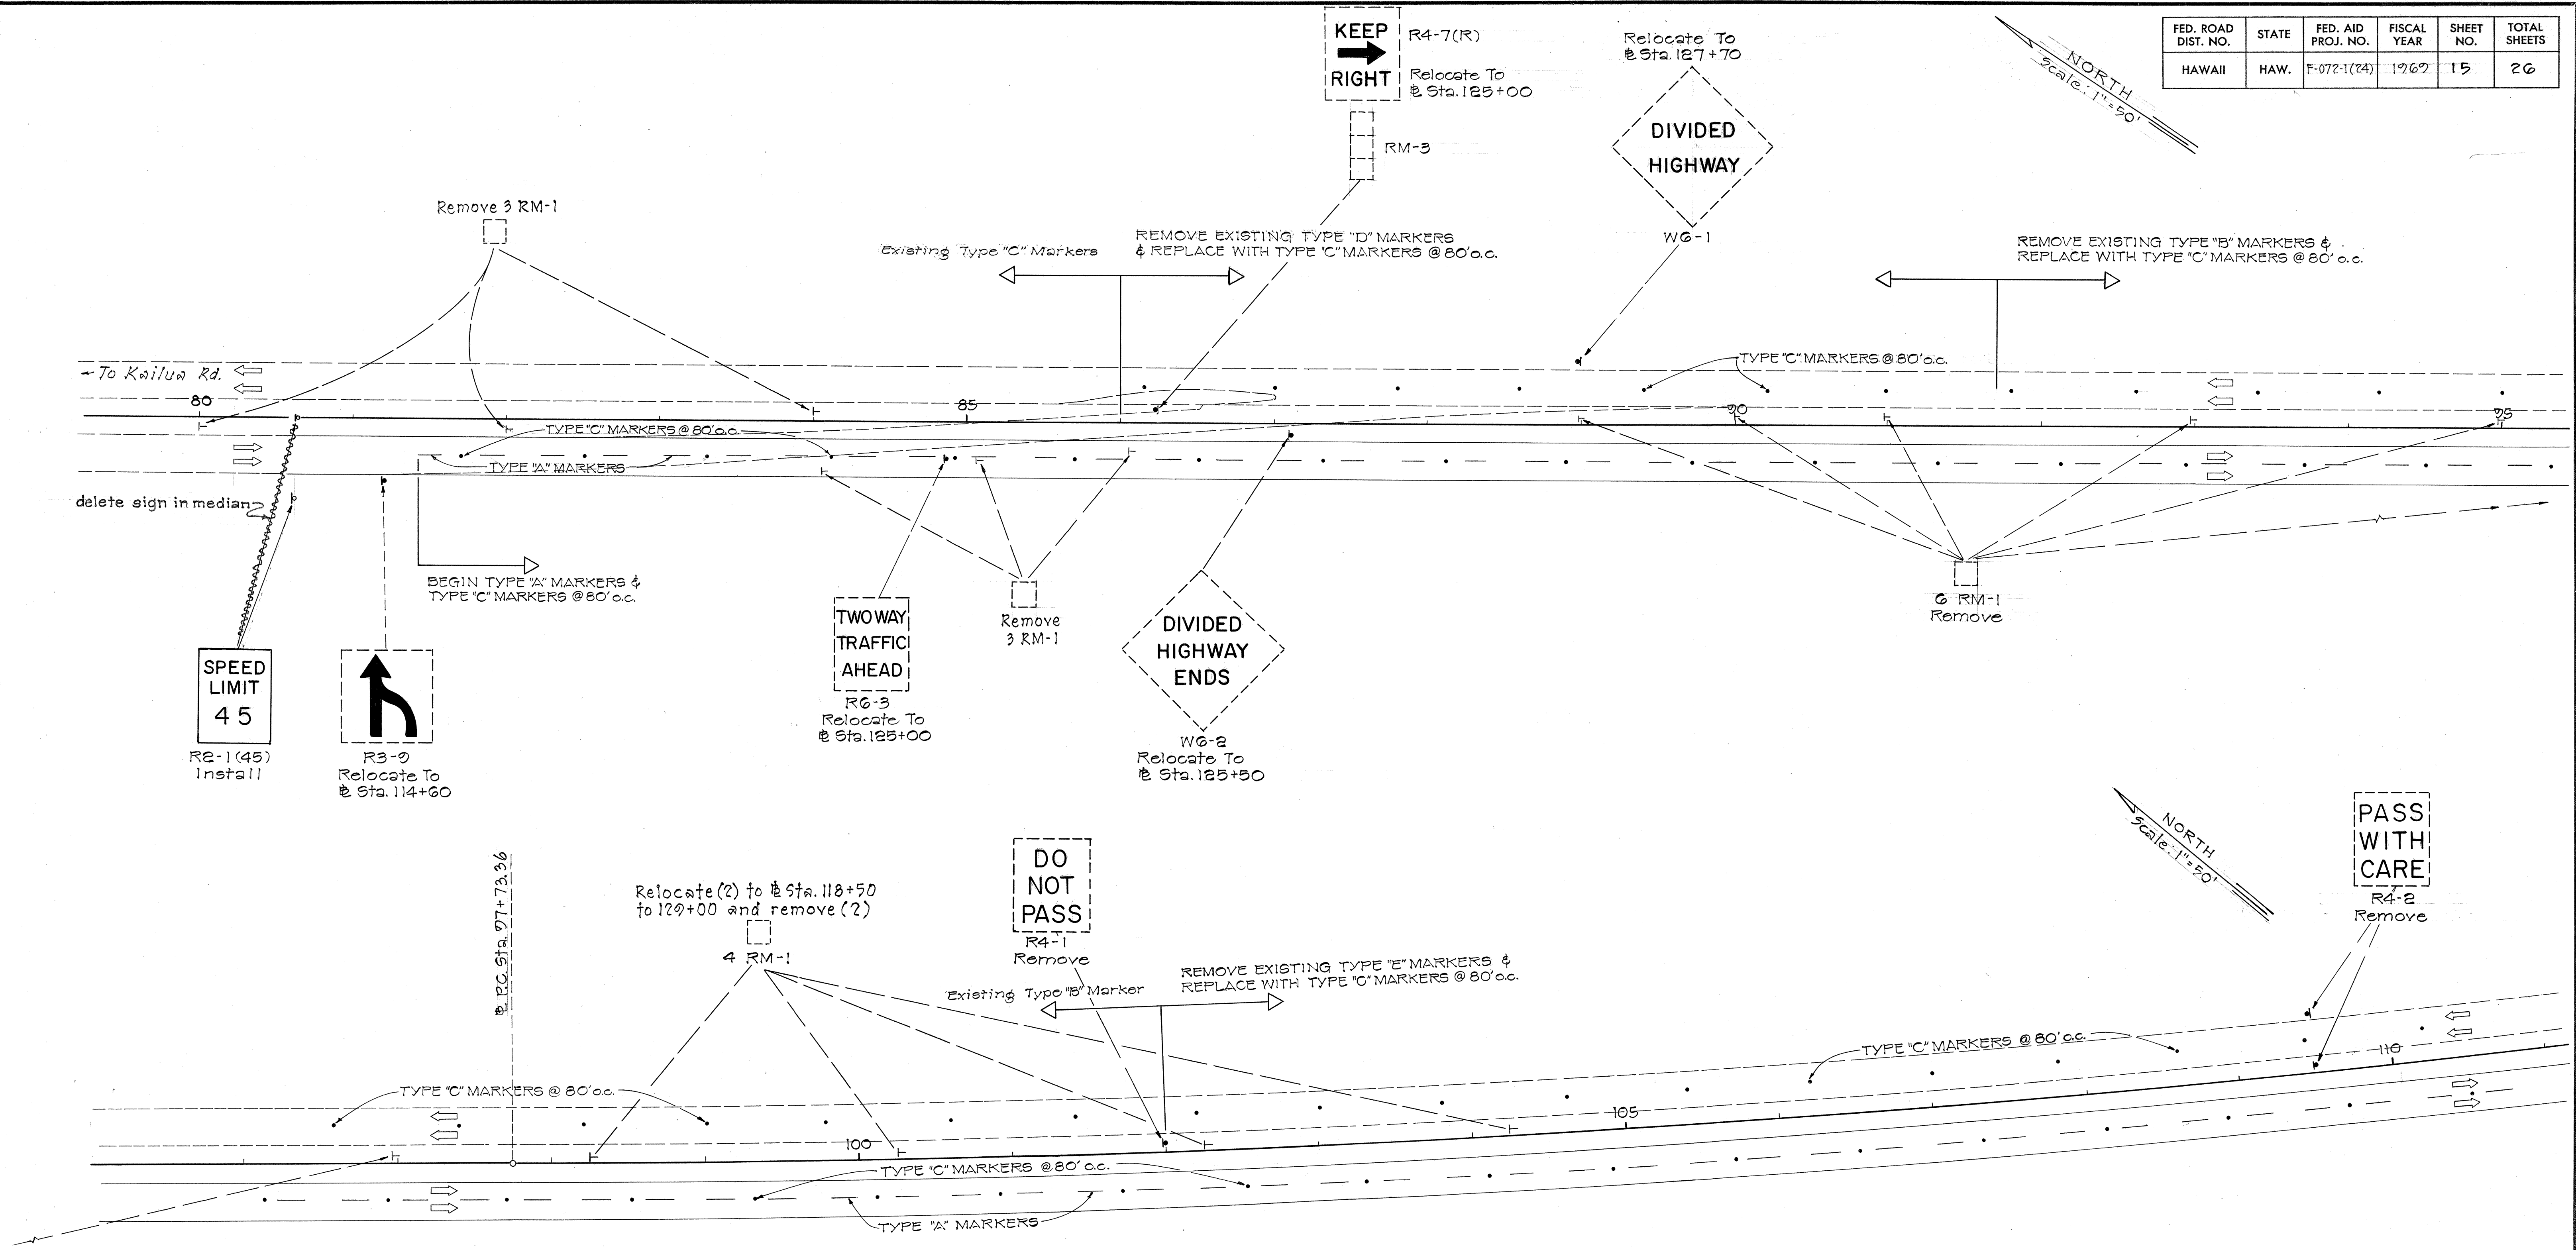

ORIGINAL PLAN	SURVEY PLOTTED BY	DATE
NOTE BOOK	DRAWN BY	" "
No.	TRACED BY	" "
	QUANTITIES BY	" "
	CHECKED BY	" "

STATE OF HAWAII
DEPARTMENT OF TRANSPORTATION
HIGHWAYS DIVISION

**TRAFFIC SIGNS &
PAVEMENT MARKER**

KALANIANA'OLE HIGHWAY
PROJECT NO. F-072-1(24)

FED. ROAD DIST. NO.	STATE	FED. AID PROJ. NO.	FISCAL YEAR	SHEET NO.	TOTAL SHEETS
HAWAII	HAW.	F-072-1(24)	1967	16	26

NORTH
Scale: 1"=50'

KEEP
→
RIGHT

R4-7

RM-3

Relocated From
Sta. 86+20

REMOVE EXISTING TYPE 'E' MARKERS
& REPLACE WITH TYPE 'D' MARKERS @ 40' o.c.
4" PAINTED YELLOW STRIPE

A.C. TRAFFIC ROLL

2 RM-1

Relocate to
Sta. 118+50 to
129+00

3 RM-1
Relocated
Reflective Markers

TWO WAY
TRAFFIC
AHEAD

Relocated From
Sta. 85+00

SPEED
ZONE
AHEAD

R2-5
Relocate To
Sta. 128+00

DIVIDED
HIGHWAY
ENDS

Relocated From
Sta. 87+00

TRAFFIC SIGN SUMMARY

TYPE	DESCRIPTION	QUANTITY	
		NEW	RELOCATE
R1-1	STOP		1
R2-1(45)	SPEED LIMIT 45	1	
R2-5	SPEED ZONE AHEAD		1
R3-9	h		1
R4-7(R)	KEEP RIGHT		1
R6-3	TWO WAY TRAFFIC AHEAD		1
R6-1	ONE WAY	1	1
W6-1	DIVIDED HIGHWAY		1
W6-2	DIVIDED HIGHWAY ENDS		1
RM-1	REFLECTOR MARKER		8
RM-3	REFLECTOR MARKER		1
R3-2	NO LEFT TURN	1	
PAVEMENT MARKERS			
A	NON-REFLECTIVE WHITE	570 EA.	
C	RED-CLEAR	25 EA.	
D	2-WAY YELLOW	27 EA.	

STATE OF HAWAII
DEPARTMENT OF TRANSPORTATION
HIGHWAYS DIVISION

TRAFFIC SIGNS & PAVEMENT MARKER

KALANIANA'OLE HIGHWAY
PROJECT NO. F-072-1(24)

SHEET No. 2 OF 2 SHEETS

116

DO
NOT
PASS
R4-1
Remove

Relocate to Sta. 118+50
to 129+00

2 RM-1

delete
Relocated Reflective Marker

3 RM-1

TYPE 'C' MARKERS @ 80' o.c.

TYPE 'C' MARKERS @ 80' o.c.

TYPE 'C' MARKERS @ 80' o.c.

TYPE 'A' MARKERS

END TYPE 'C' MARKERS @ 80' o.c.

END TYPE 'A' MARKERS

ONEWAY

STOP

R1-1
Relocate

NO
LEFT
TURN

Install New
R3-2

Relocated From
Sta. 81+20

2 RM-1
Relocate To Sta. 118+50
to 129+00

Relocated from
Sta. 125+00

SPEED
ZONE
AHEAD

DIVIDED
HIGHWAY

Relocated From
Sta. 80+00

SPEED
LIMIT
45

R2-1(45)
Existing To Remain

DO
NOT
PASS
R4-1
Remove

5 RM-1

END 4" PAINTED YELLOW STRIPE &
TYPE 'D' MARKERS @ 40' o.c.

PROVIDE OPENING

Existing Two-Way Flashing
Amber Beacon

135

Existing 4" Painted
Double White Stripe

Replaced existing which
were destroyed

2 RM-1

Relocated
Reflective Markers

4 RM-1

6 RM-1

W1-2(R)

25
M.P.H.

W13-1(25)

RM-1

Existing To Remain

SPEED
LIMIT
30

Existing To Remain

W1-2(L)
Existing To Remain

To Heiropo

DATE	11/1/67
SURVEY PLATTED BY	W. J. HARRIS
DRAWN BY	W. J. HARRIS
DESIGNED BY	W. J. HARRIS
CHECKED BY	W. J. HARRIS
ORIGINAL PLAN	NO. 1
NOTE BOOK	NO. 1
NO.	1