INDEX TO DRAWINGS

SHEET NO. DESCRIPTION

I TITLE SHEET

2 TRAFFIC SIGNAL SYSTEM

3-7 MISCELLANEOUS DETAILS

STATE OF HAWAII

DEPARTMENT OF TRANSPORTATION
HIGHWAYS DIVISION

HONOLULU, HAWAII

"AS BUILT" PLANS FOR

## INSTALLATION OF TRAFFIC SIGNALS


ON


KALANIANAOLE HIGHWAY

AT

LUNALILO HOME ROAD PROJECT NO. 740A-02-70

DISTRICT OF HONOLULU
ISLAND OF OAHU

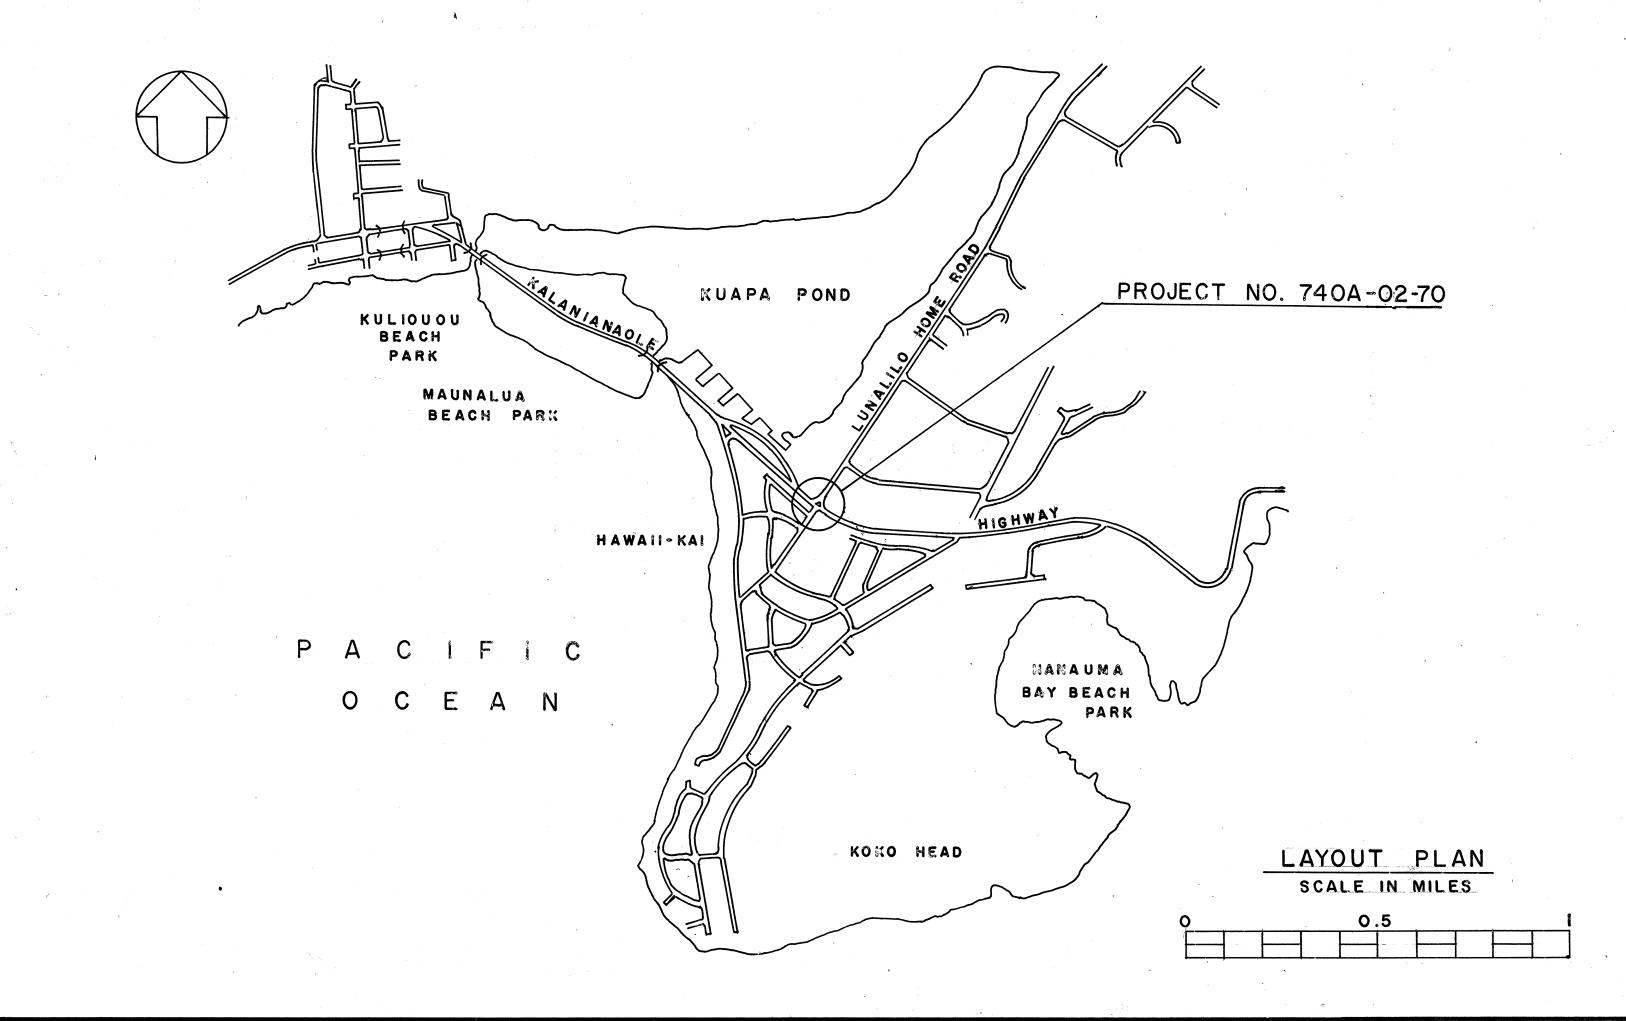

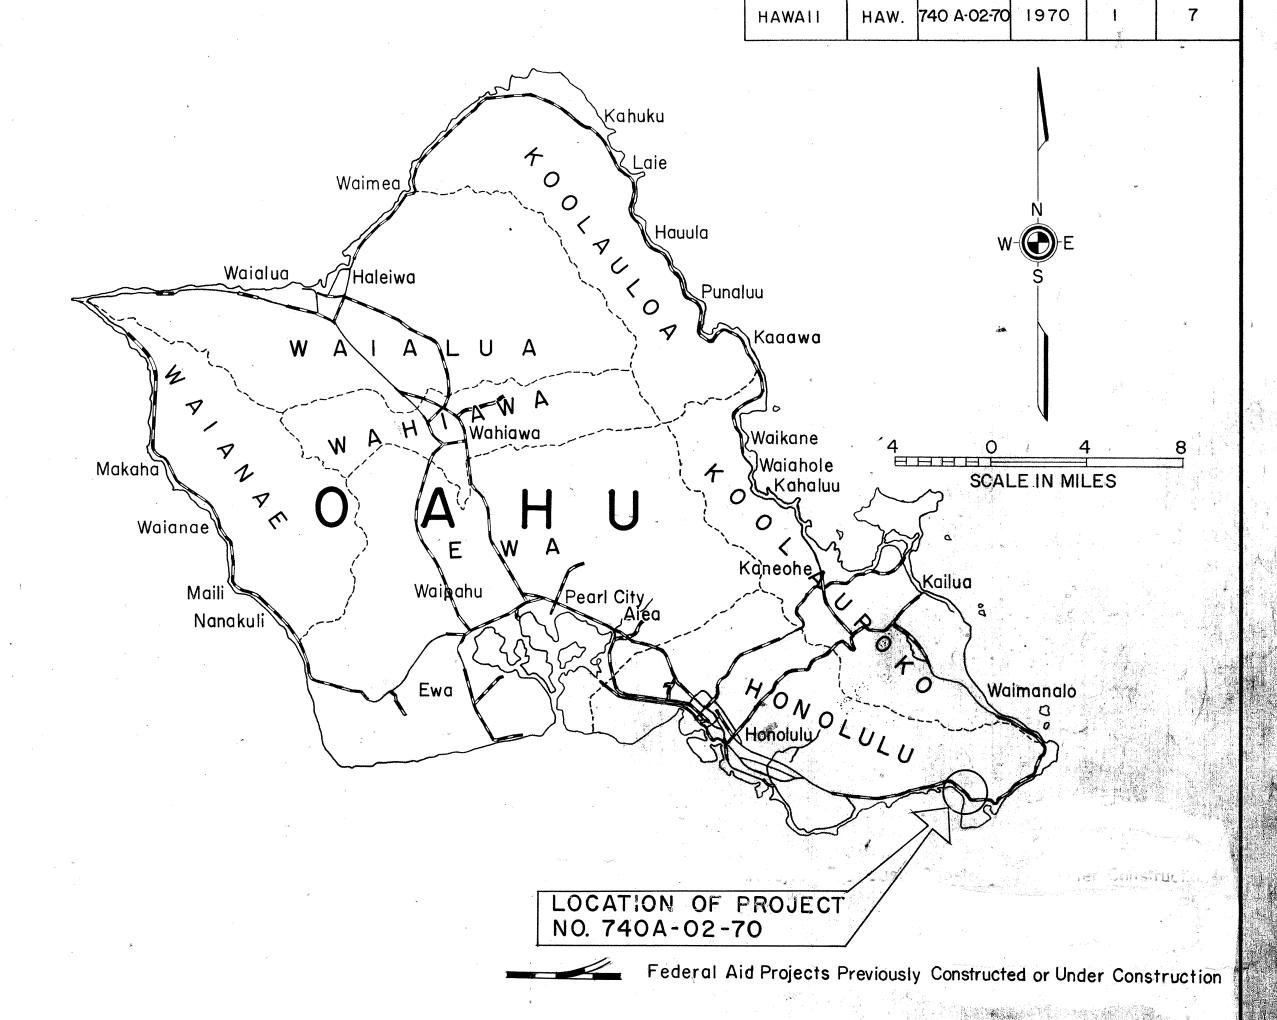

FED. ROAD DIST. NO. FED. AID FISCAL SHEET TOTAL PROJ. NO. YEAR NO. SHEETS

NOTE:

ALL CHANGES MADE DURING CONSTRUCTION
HAVE BEEN NOTED IN RED ON THESE TRACINGS
AND CHECKED BY:

PROJECT ENGINEER

8/9/79

D'ATE

DEPARTMENT OF TRANSPORTATION
STATE OF HAWAII

APPROVED:

G. Oliver Harista 5/6/2

DIR. OF TRANSPORTATION DATE

NAY 1970