
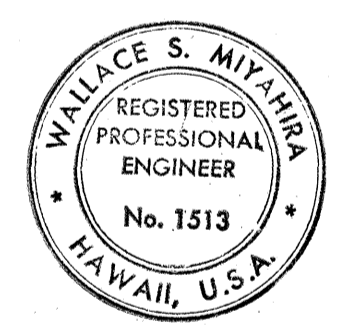


FED. ROAD DIST. NO.	STATE	PROJ. NO.	FISCAL YEAR	SHEET NO.	TOTAL SHEETS
HAWAII	HAW.	740A-01-70	1970	8	40

NOTES:

- All signs, flashing beacon, chain-link fencing and other items within the State Right-of-Way that are to be "Salvaged" shall be removed, loaded, hauled and unloaded at the Oahu District Office, 727 Kakoi St., Honolulu 96810. Check with Purchasing Clerk before unloading at the District Office site.
- Trees designated to be transplanted in the Maunalua Beach Park shall be carefully removed, loaded, hauled, unloaded and planted in the area designated on this sheet. Before transplanting, however, the Contractor shall notify the Board of Parks and Recreation, in writing, and shall coordinate the planting with the City Maintenance. This shall be in accordance with the Specifications.
- Work to salvage, adjust, or relocate existing signs on either a new or existing post shall be paid for under "Salvage, Adjust or Relocate Existing Signs and Posts." The price bid for this item shall be full compensation for all labor, materials and equipment necessary to complete the plan as shown, including new posts, footings and all hardware.
- Painted Traffic Striping shall be done by State maintenance personnel.
- Payment for pipe posts necessary to install relocated signs shall be considered included in the unit cost for "Resetting Regulatory & Warning Signs."

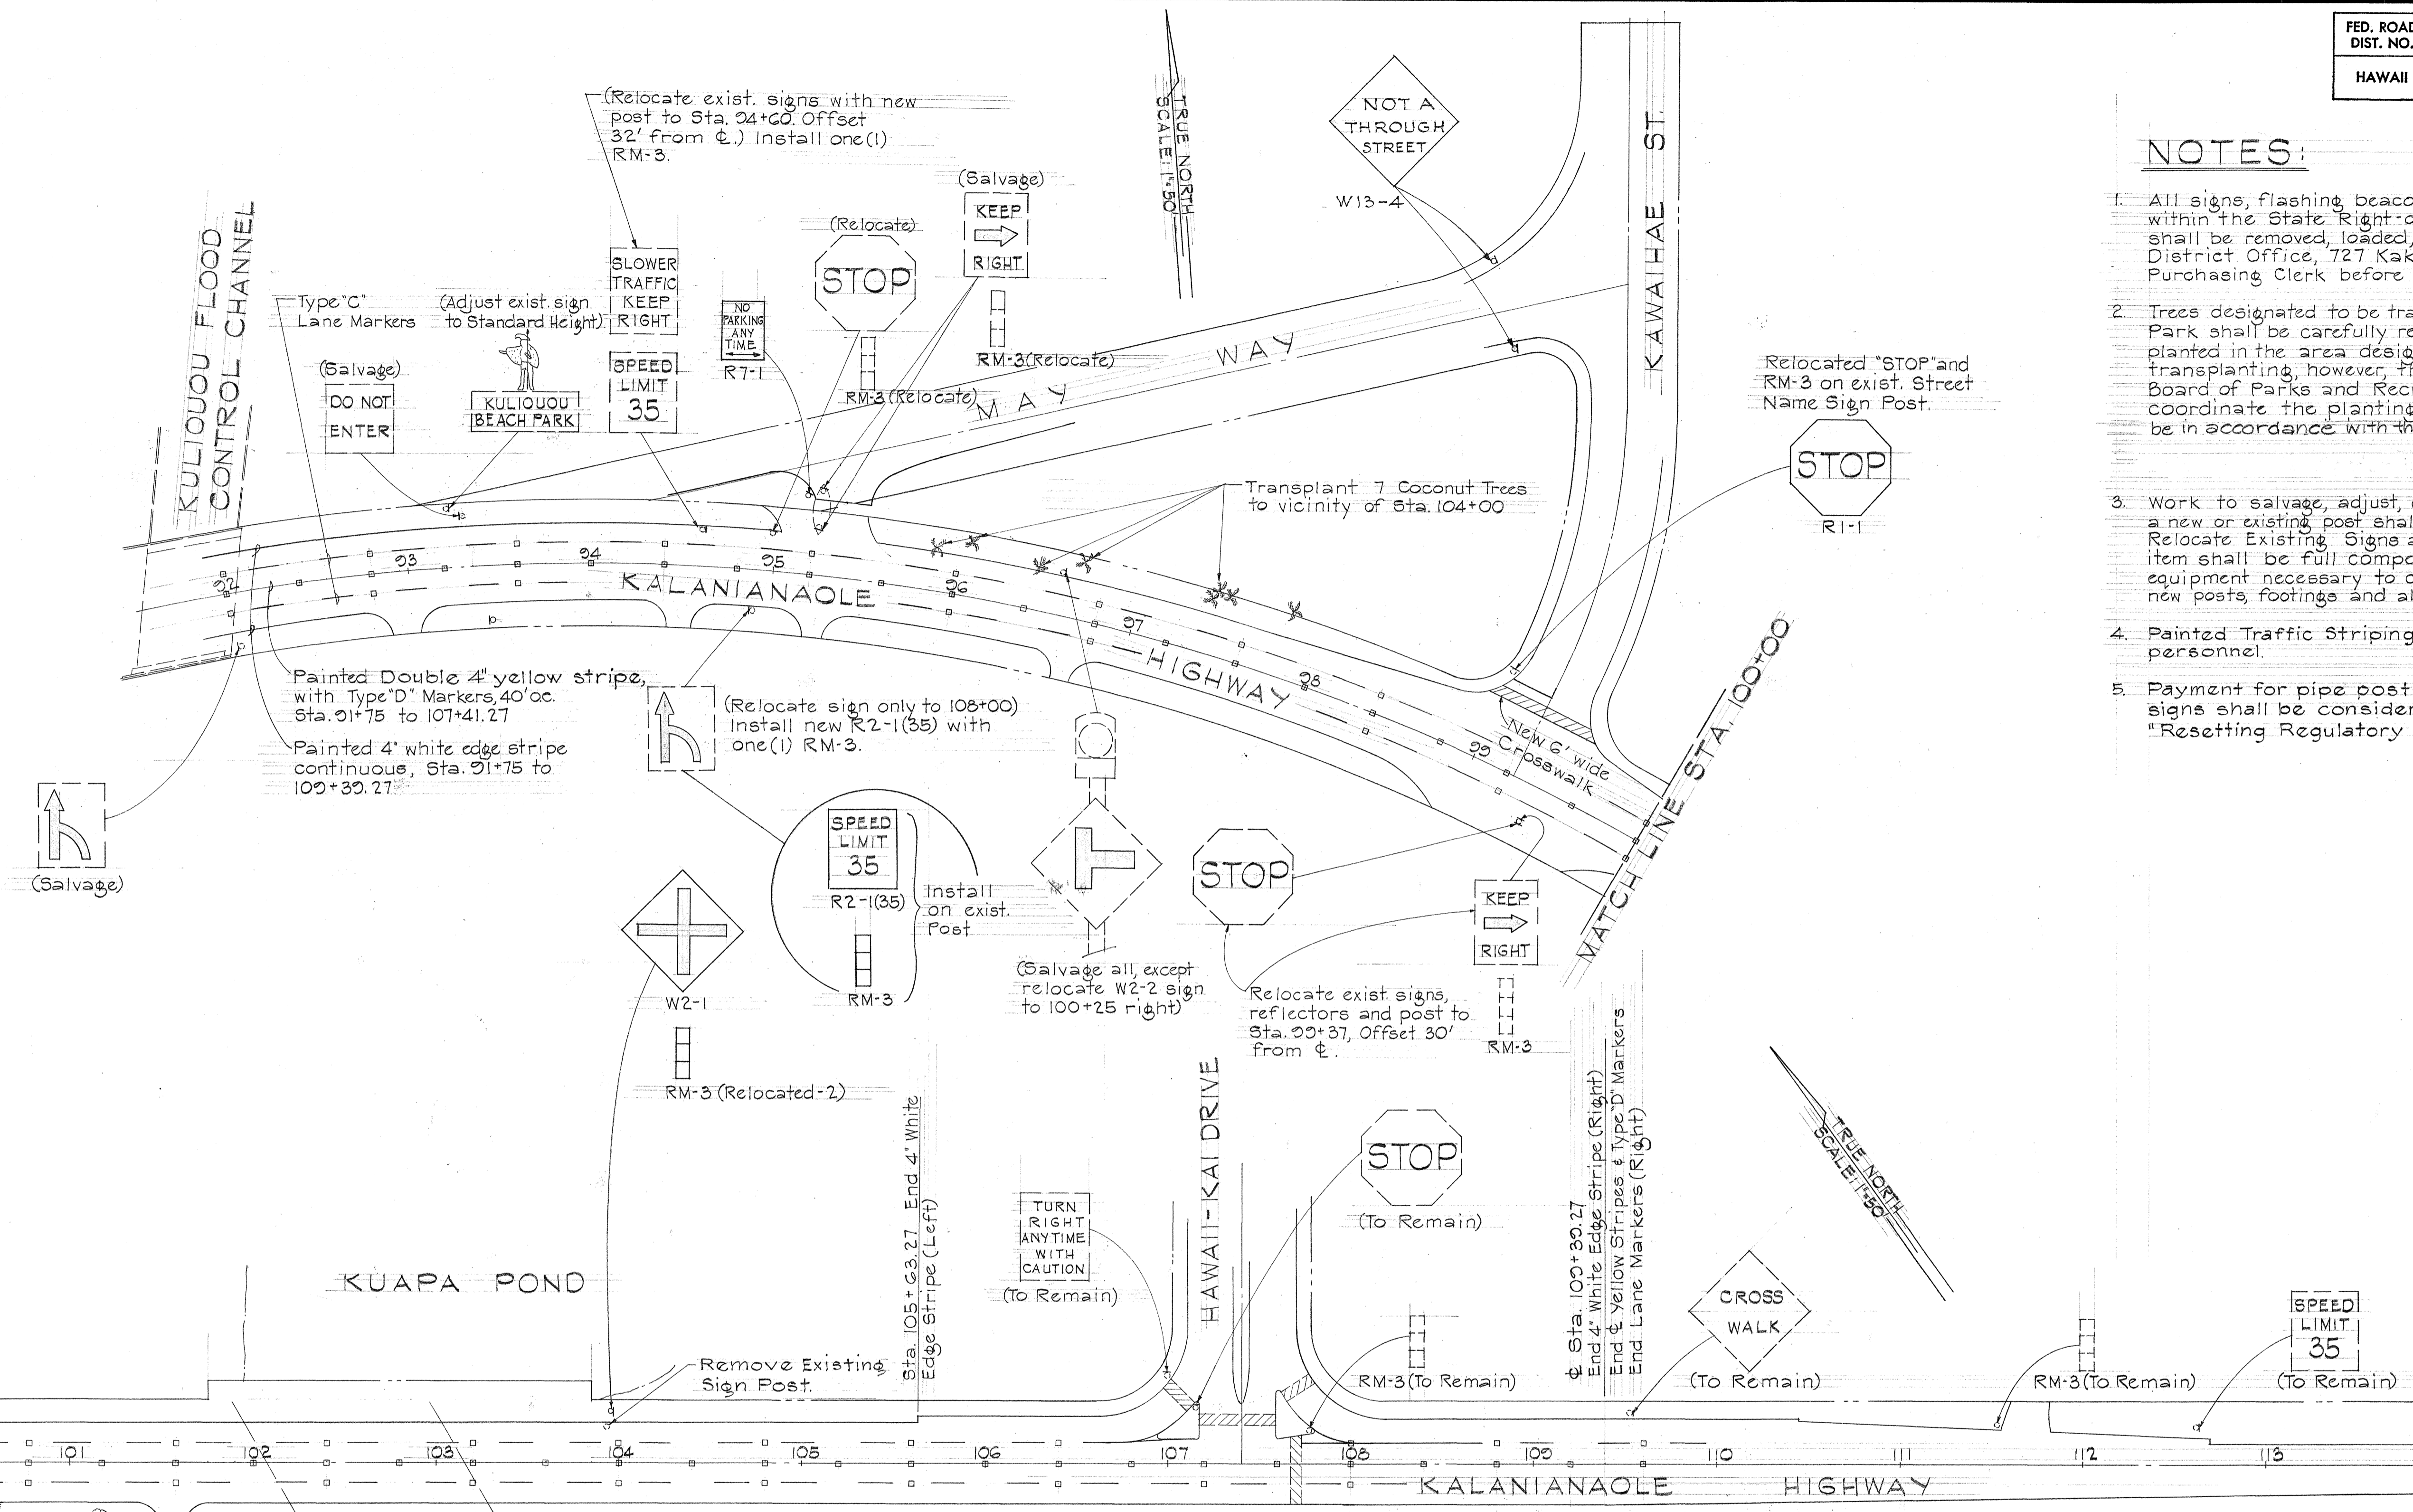

This work was prepared by me or under my supervision
Wallace S. Myrberg

SURVEY PLOTTED BY	DATE
DRAWN BY	
DESIGNED BY	
CHECKED BY	
NOTE BOOK No.	

Clear and grub exist. planting in this area. Also, remove and haul away conc. curbing to District Office. Work for clearing, grubbing, and hauling curbing to District Office shall be incidental to Roadway Excavation.

Transplanted Coconut Trees (7), 10' OC. (Coordinate with City and County Dept. Parks and Recreation for exact location.)

SUMMARY OF RAISED PAVEMENT MARKERS

TYPE	DESCRIPTION	QUANTITY
A	Non-Reflective White	480
C	Red-Clear Reflective	40
D	2-Way Yellow Reflective	45

SUMMARY OF NEW REGULATORY & WARNING SIGNS

TYPE	DESCRIPTION	QUANTITY	
		WITH POST	WITHOUT POST
R7-1	No Parking Any Time	1	-
R2-1(35)	Speed Limit 35	-	1
W2-1	Cross Road Sign	2	-
RM-3	Reflectors	-	2
W13-4	Not a through Street	2	-

STATE OF HAWAII
 DEPARTMENT OF TRANSPORTATION
 HIGHWAYS DIVISION
KALANIANA'OLE HIGHWAY WIDENING
PAVEMENT MARKINGS, SIGNING AND LANDSCAPING

Proj. No. 740A-01-70
 Scale: As Shown Date: Oct, 1970
SHEET No. 1 OF 1 SHEETS