

INDEX TO DRAWINGS	
SHEET NO.	DESCRIPTION
1	TITLE SHEET
2	TYPICAL & SPECIAL SECTIONS
3-4	PLAN AND PROFILE
5	ROADWAY DETAILS
6	MAUNALUA BRIDGE UTILITY
	RELOCATION PLAN
7	GAS LINE RELOCATION
	PLAN AND DETAILS
8	PAVEMENT MARKINGS, SIGNING AND LANDSCAPING
9	MISCELLANEOUS ROADWAY DET.
10-21	STANDARD DETAILS
22-24	CROSS SECTIONS
25-35	MAUNALUA BRIDGE PLANS AND DETAILS
36-40	STANDARD DETAILS

STATE OF HAWAII

DEPARTMENT OF TRANSPORTATION

HIGHWAYS DIVISION

HONOLULU, HAWAII

"AS BUILT" PLANS OF


KALANIANA'OLE HIGHWAY WIDENING

MAY WAY TO HAWAII KAI DRIVE


PROJECT NO. 740A-01-70

DISTRICT OF HONOLULU

ISLAND OF OAHU

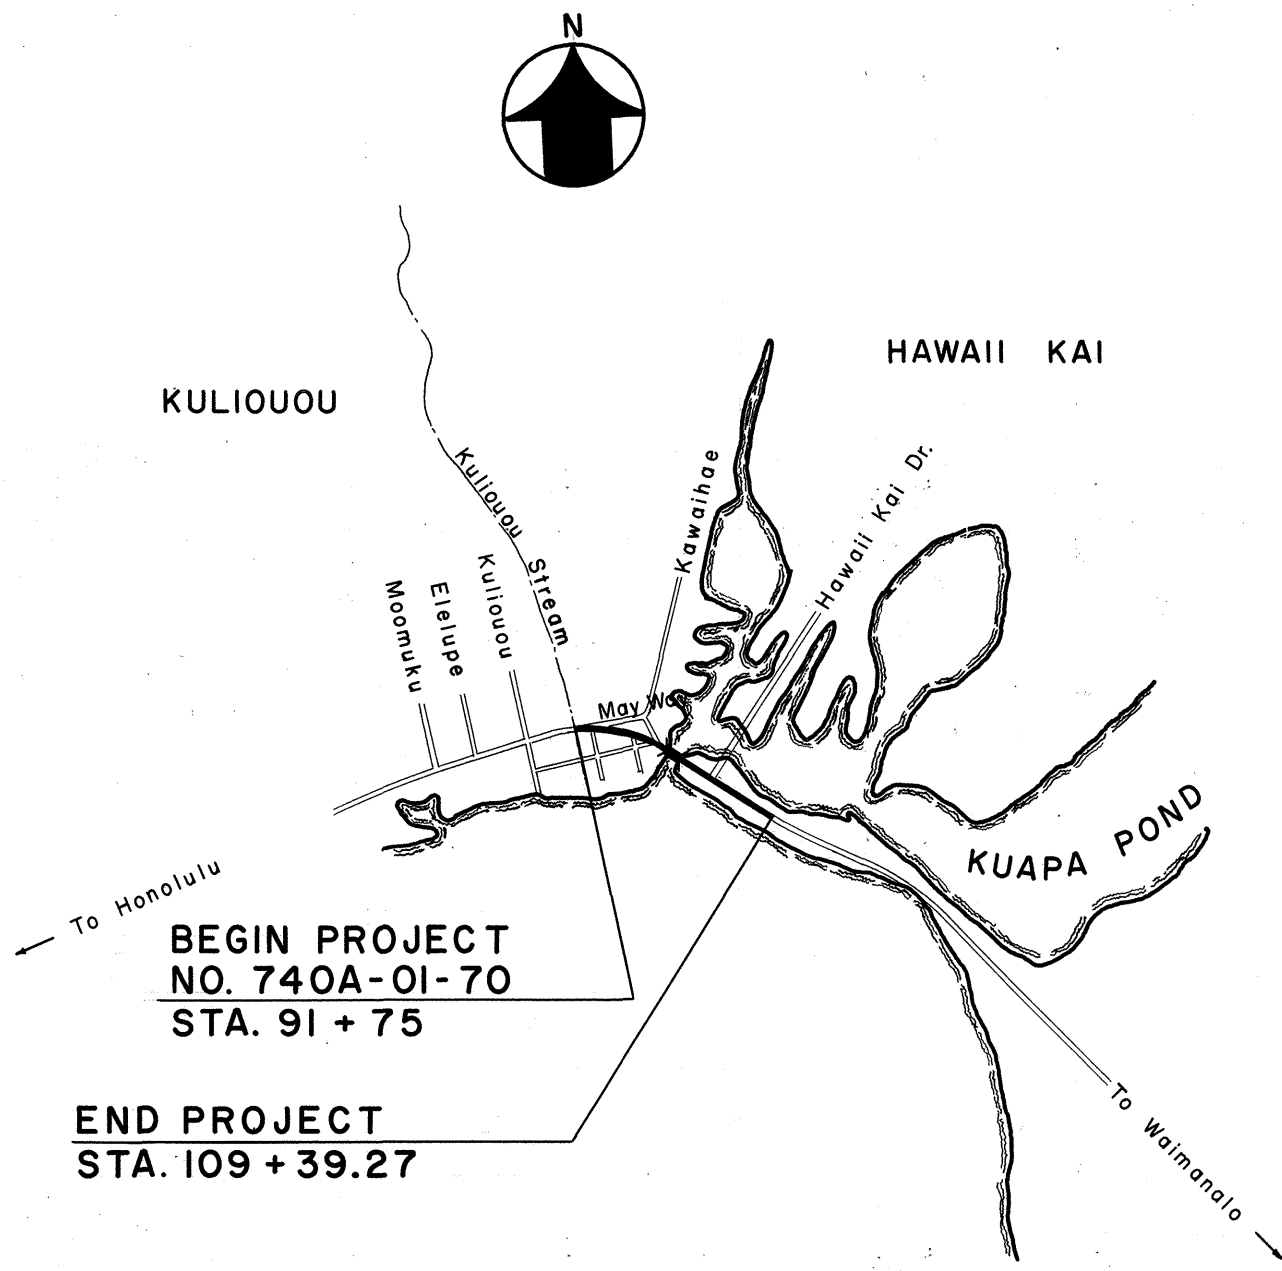


LOCATION MAP

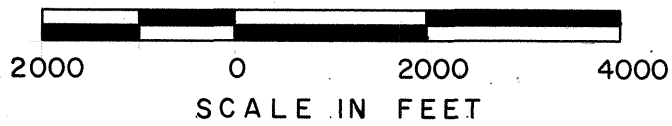

GROSS LENGTH OF PROJECT.....0.334 MILE
 BRIDGE OVER 20.00' SPAN 0.021 MILE
 NET LENGTH OF PROJECT 0.313 MILE

FED. ROAD DIST. NO.	STATE	PROJ. NO.	FISCAL YEAR	SHEET NO.	TOTAL SHEETS
HAWAII	HAW.	740A-01-70	1970	1	40

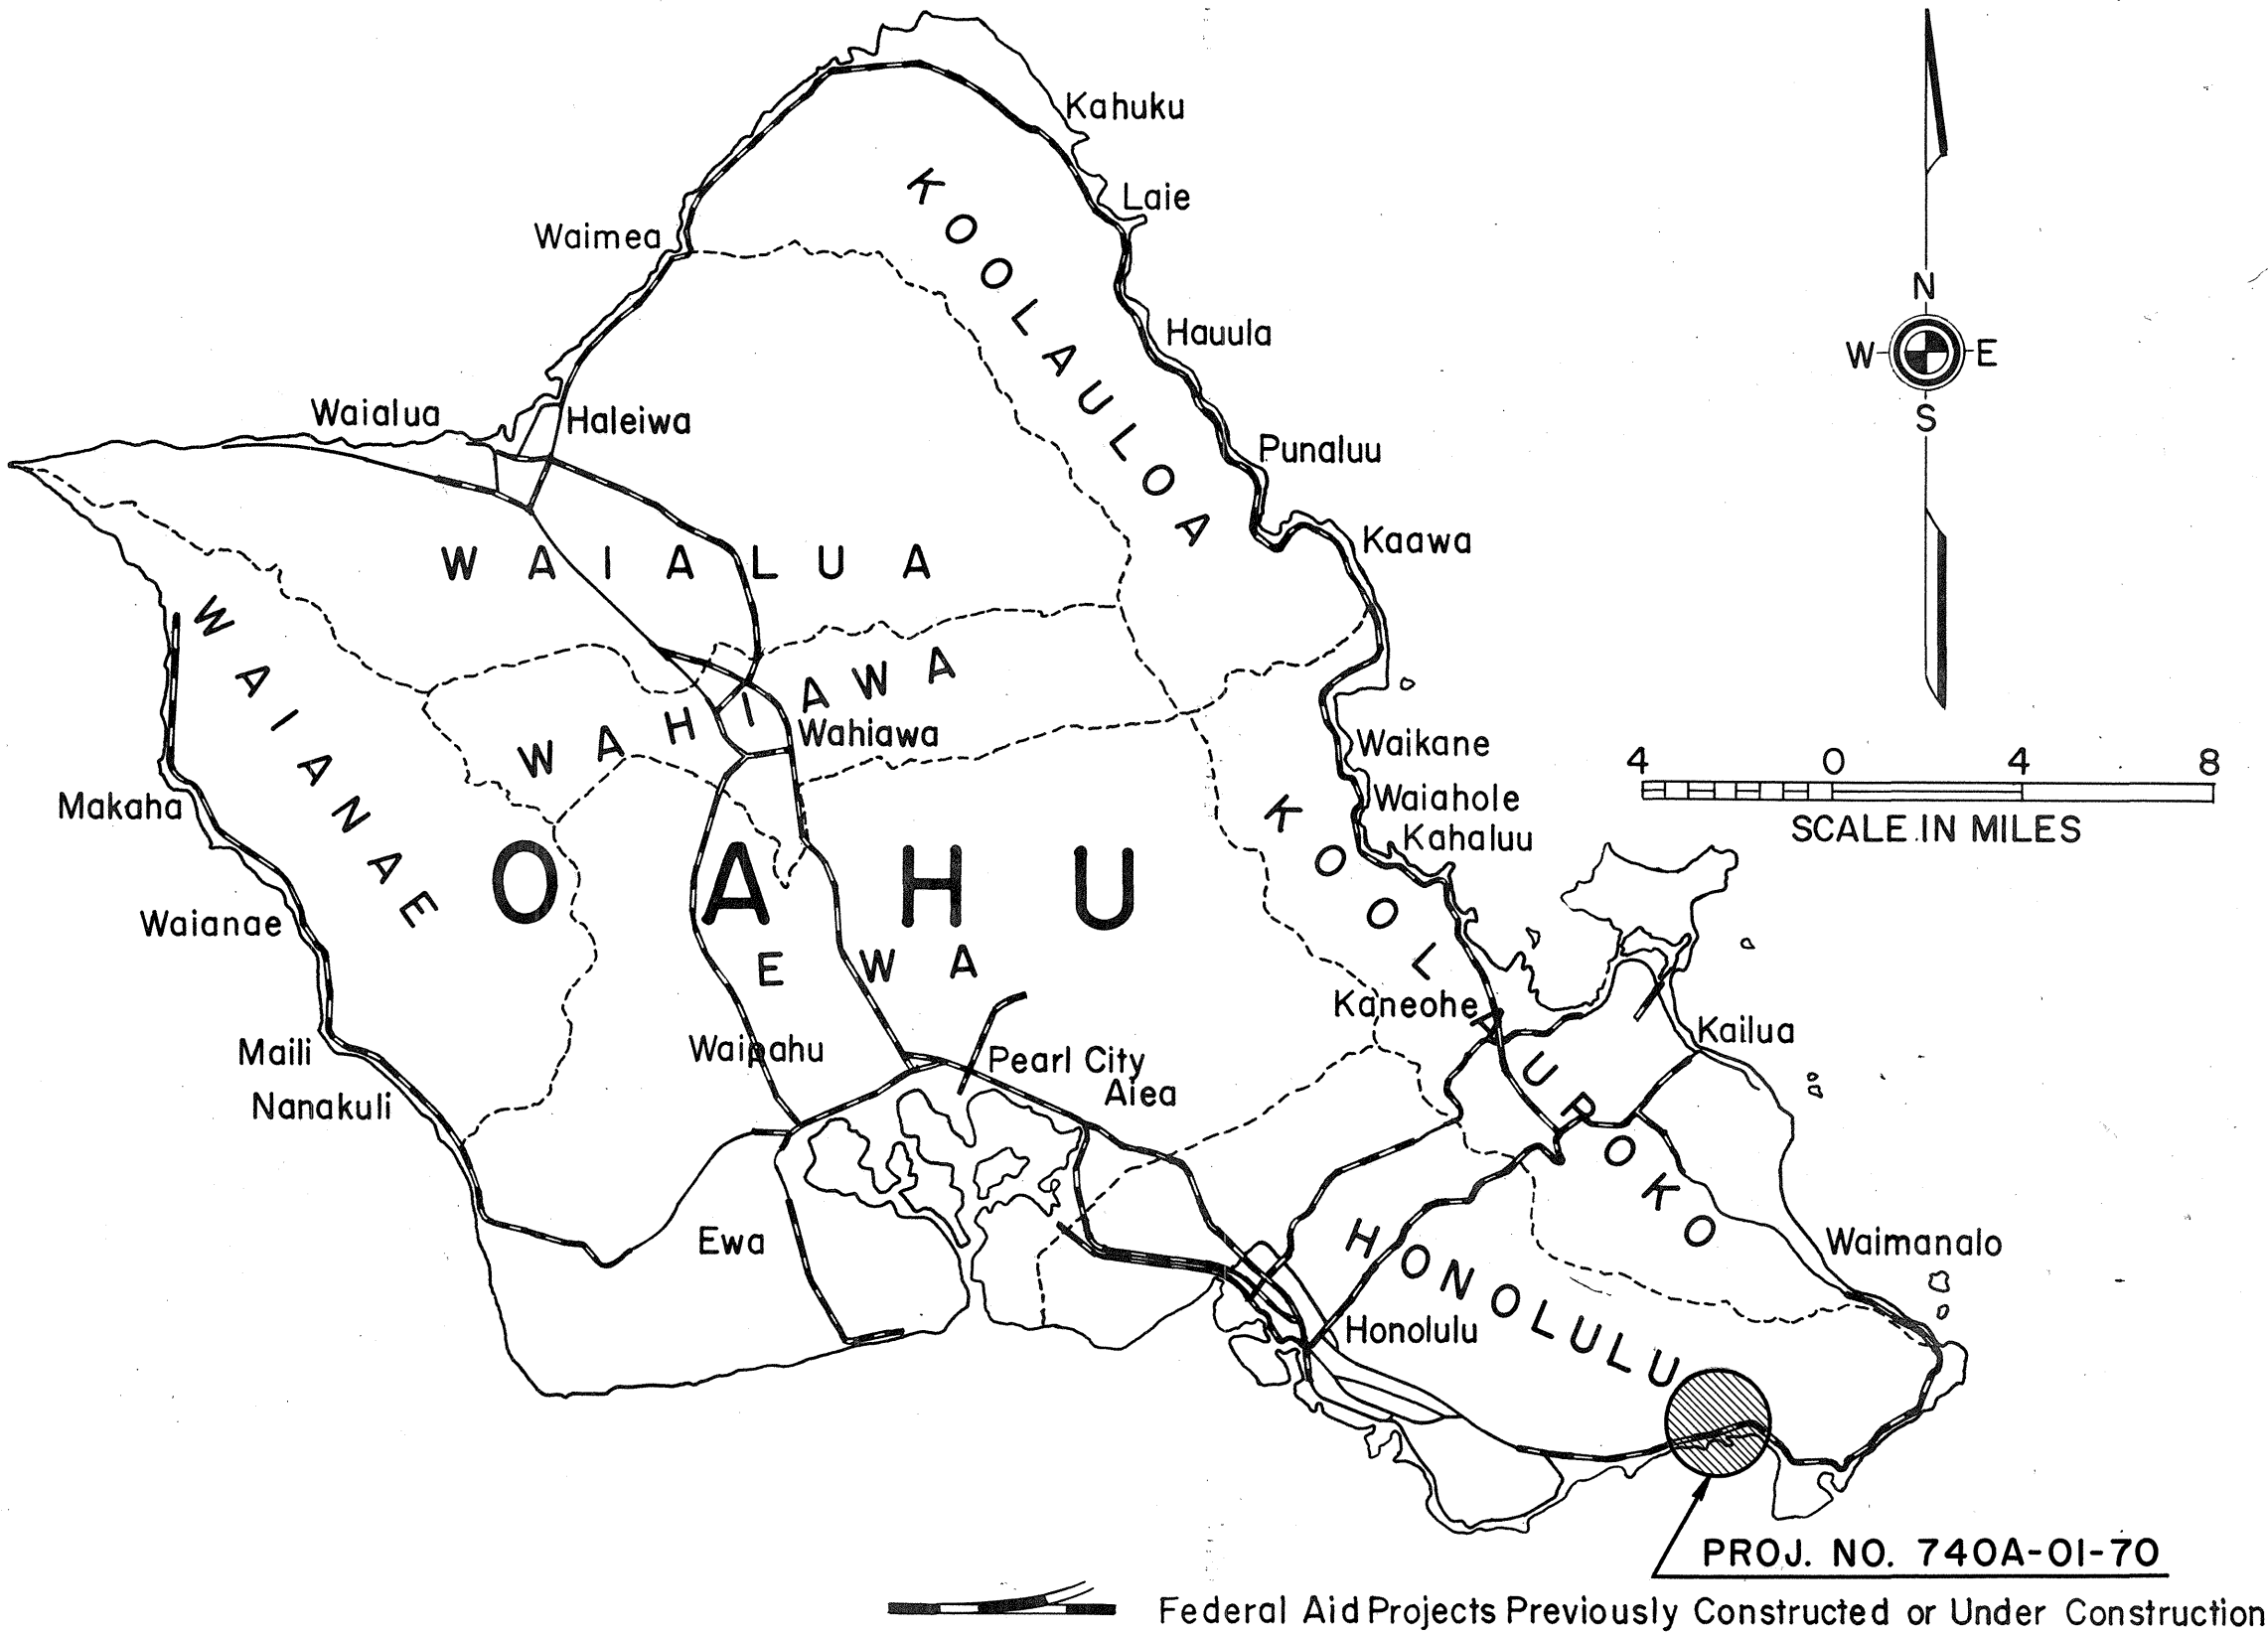

NOTE:
 ALL CHANGES MADE DURING CONSTRUCTION
 HAVE BEEN NOTED IN RED ON THESE TRACINGS
 AND CHECKED BY:

Ralph J. Hoie
 PROJECT ENGINEER

4/11/72
 DATE

DEPARTMENT OF TRANSPORTATION STATE OF HAWAII	
APPROVED:	
<i>G. Alvey Wright</i> DIR. OF TRANSPORTATION	<i>12/10/70</i> DATE

L. Char December, 1970

B-1-8