

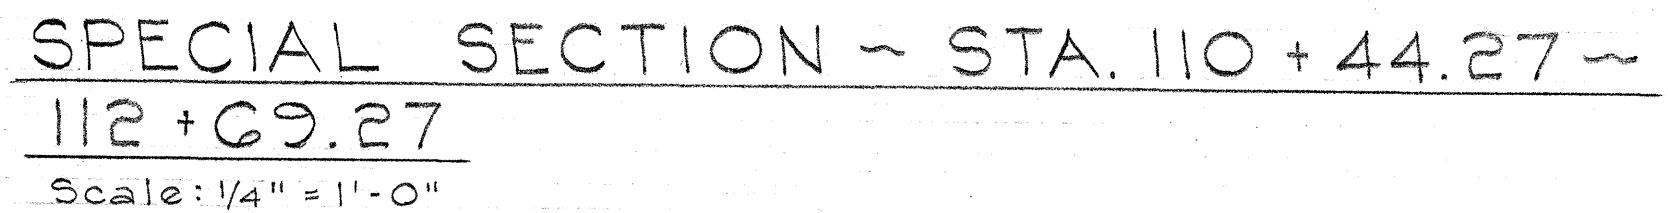
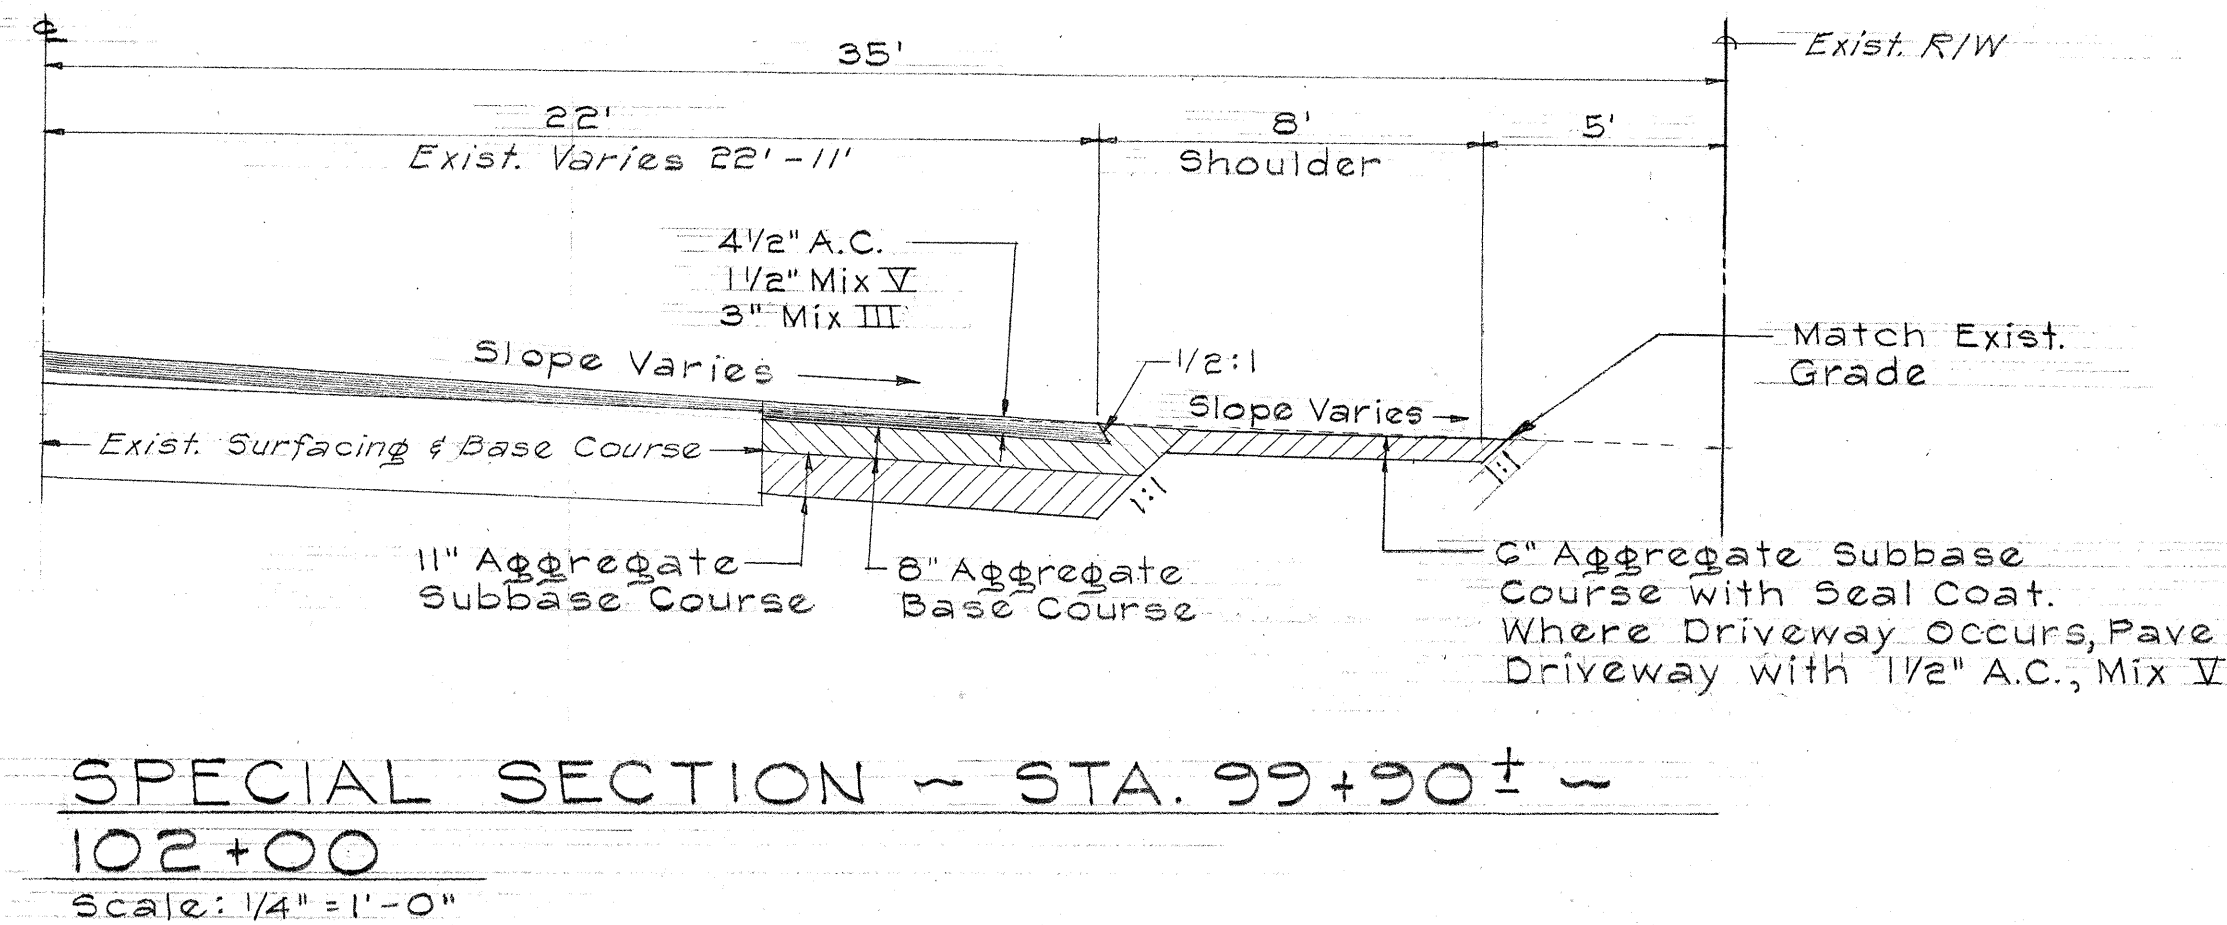
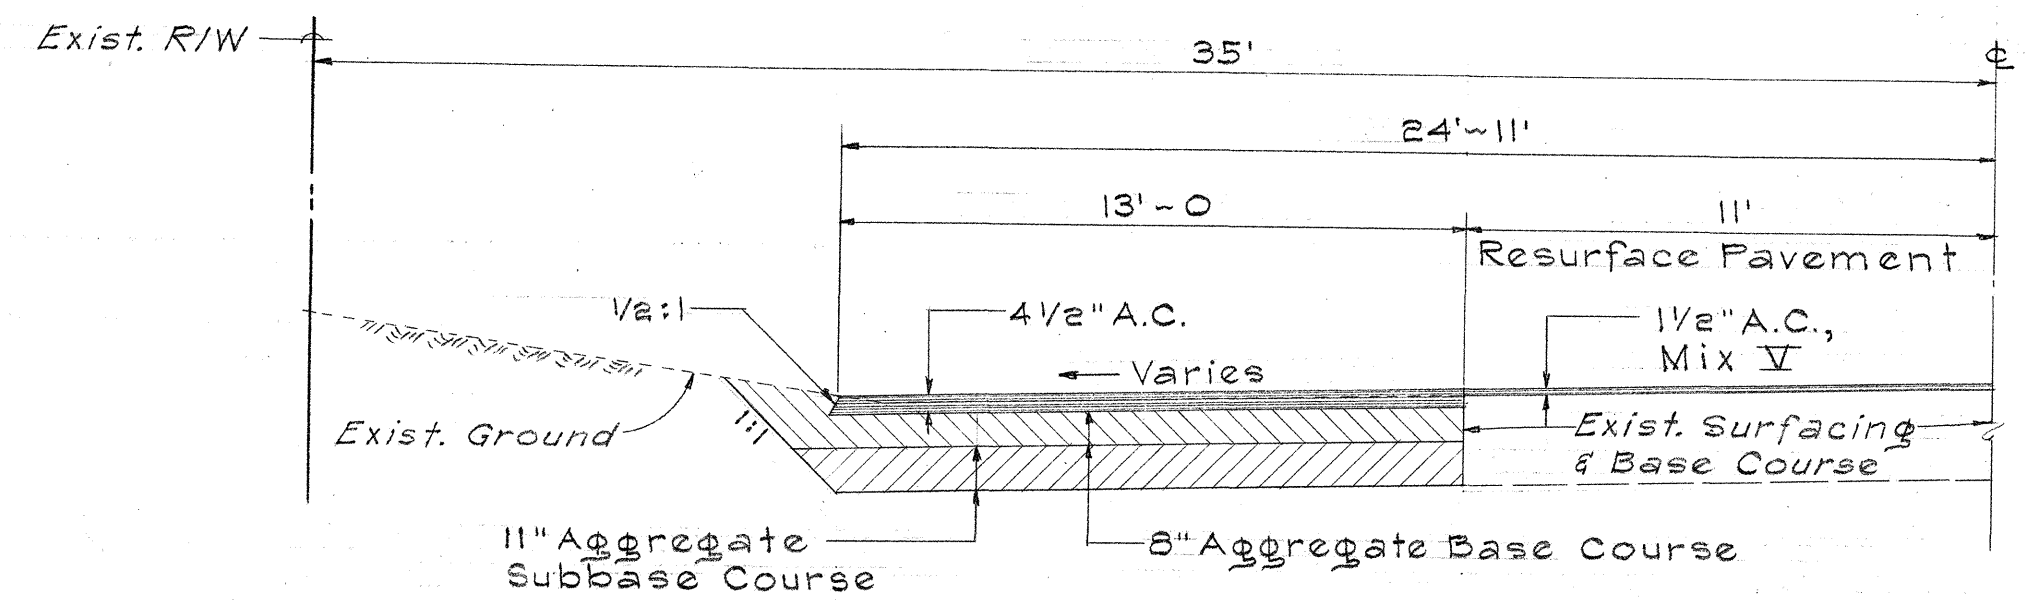
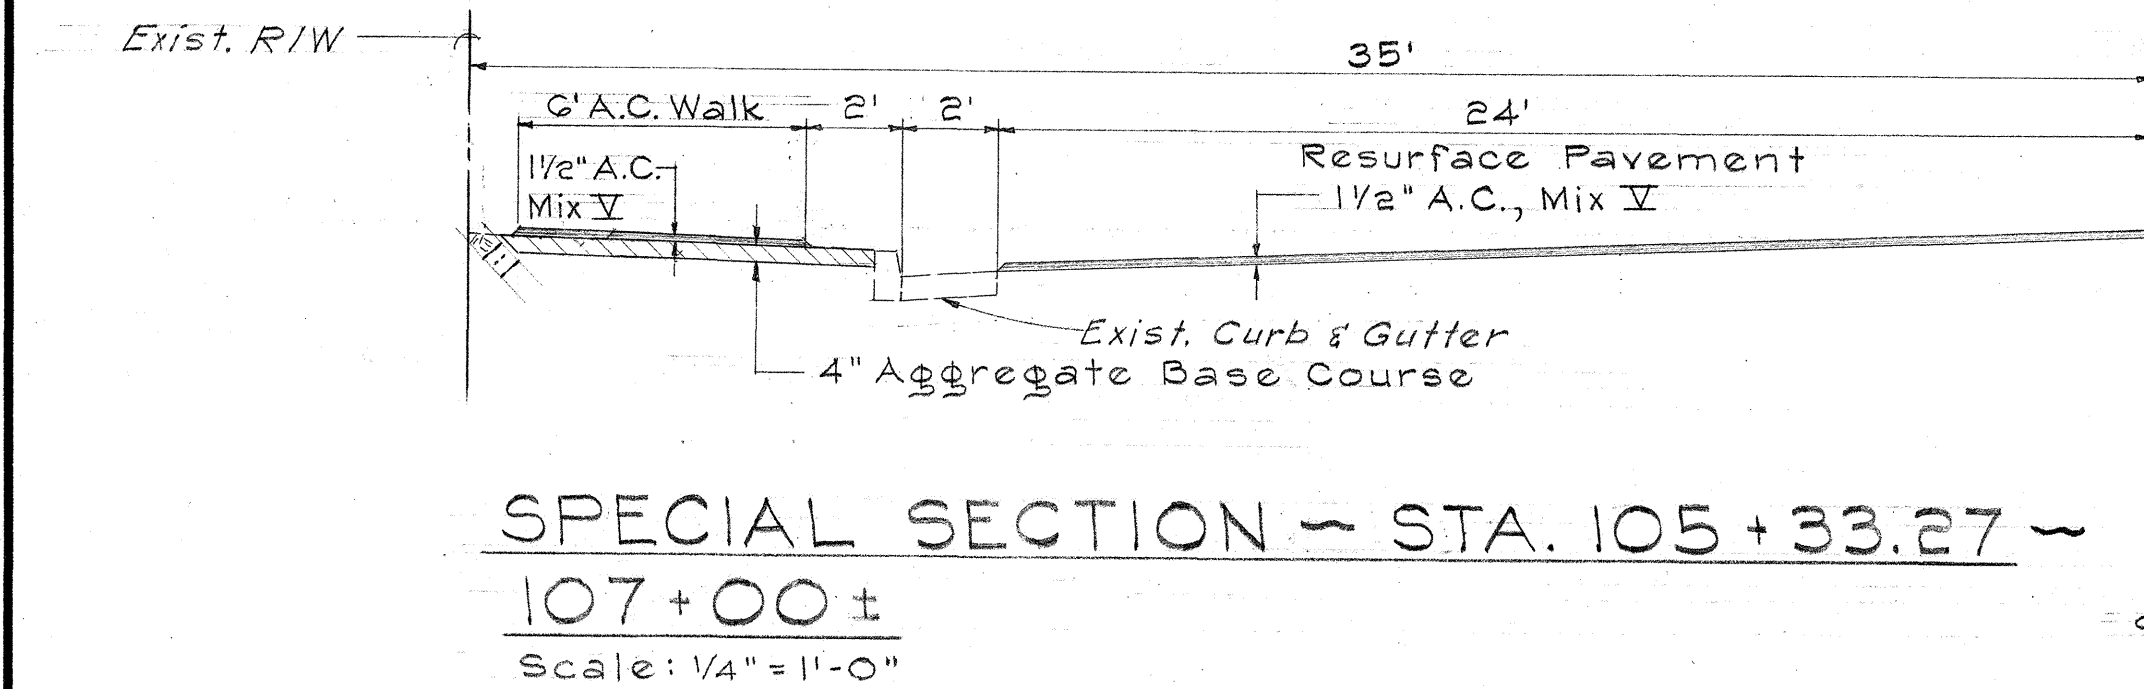
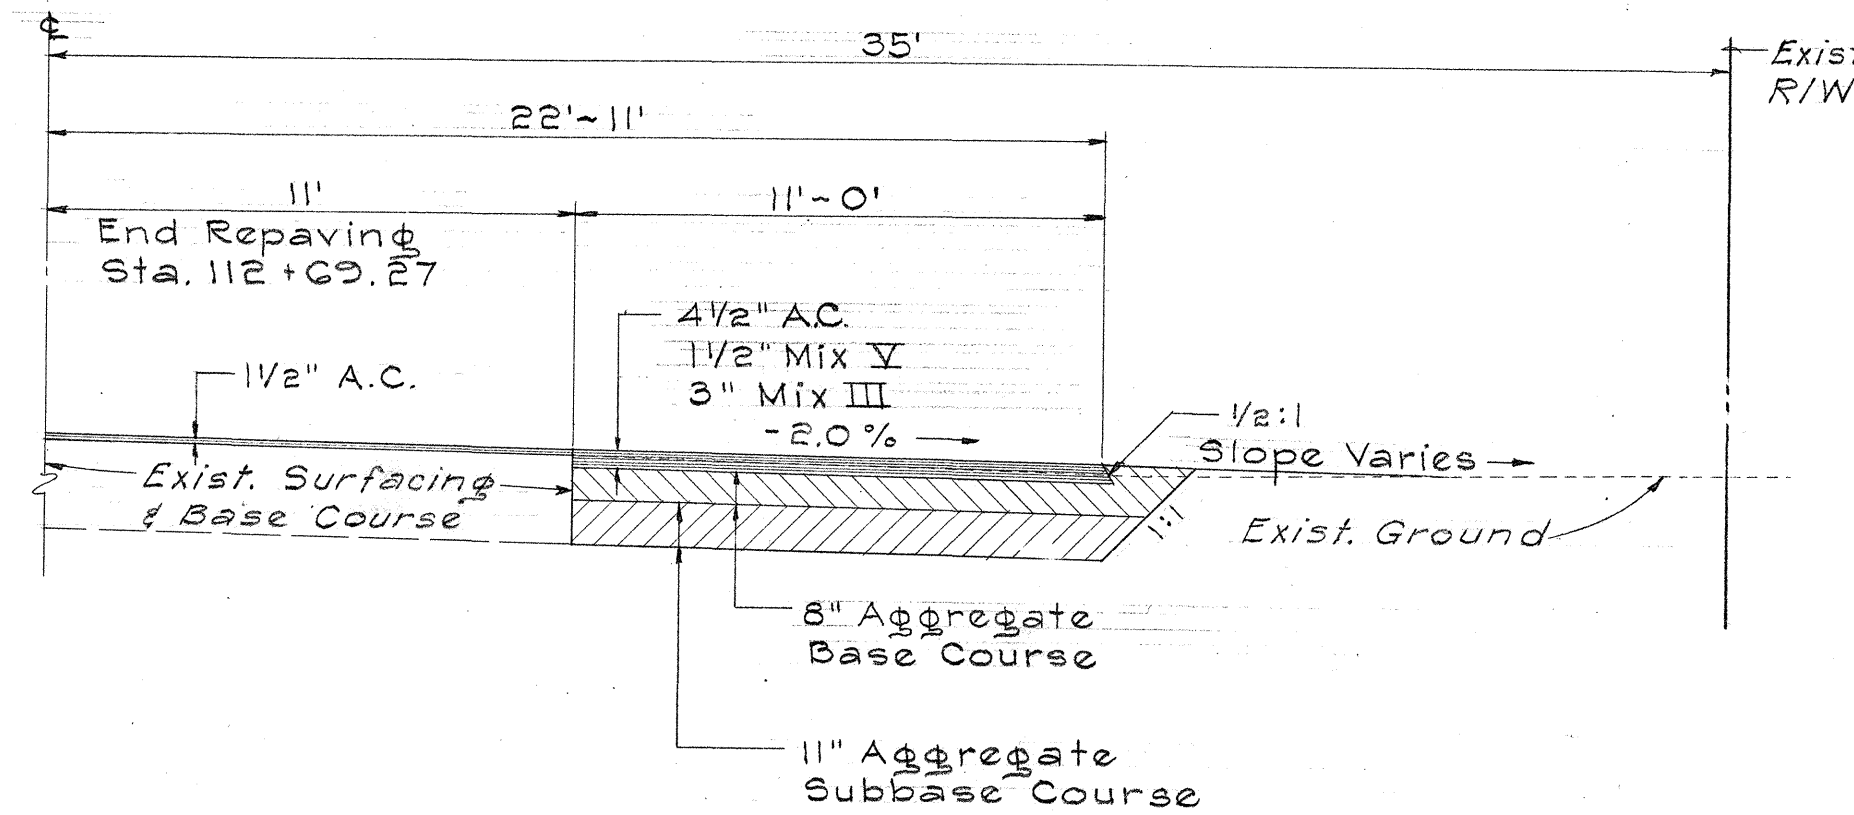
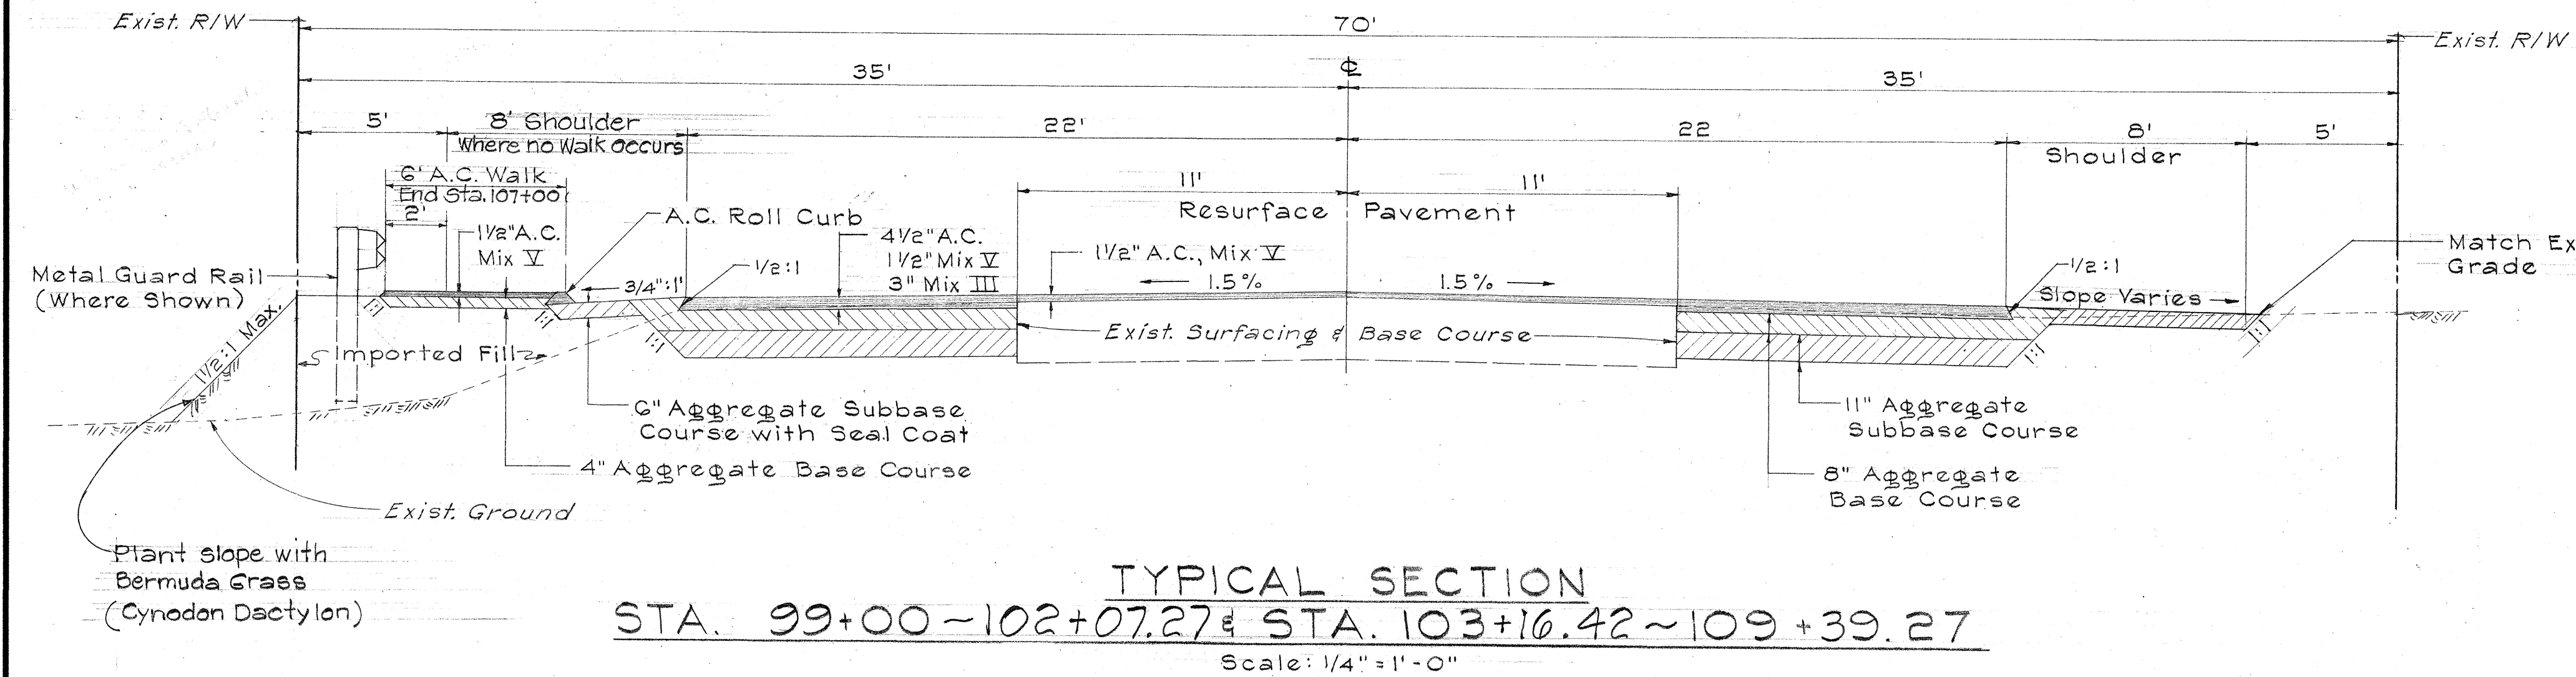
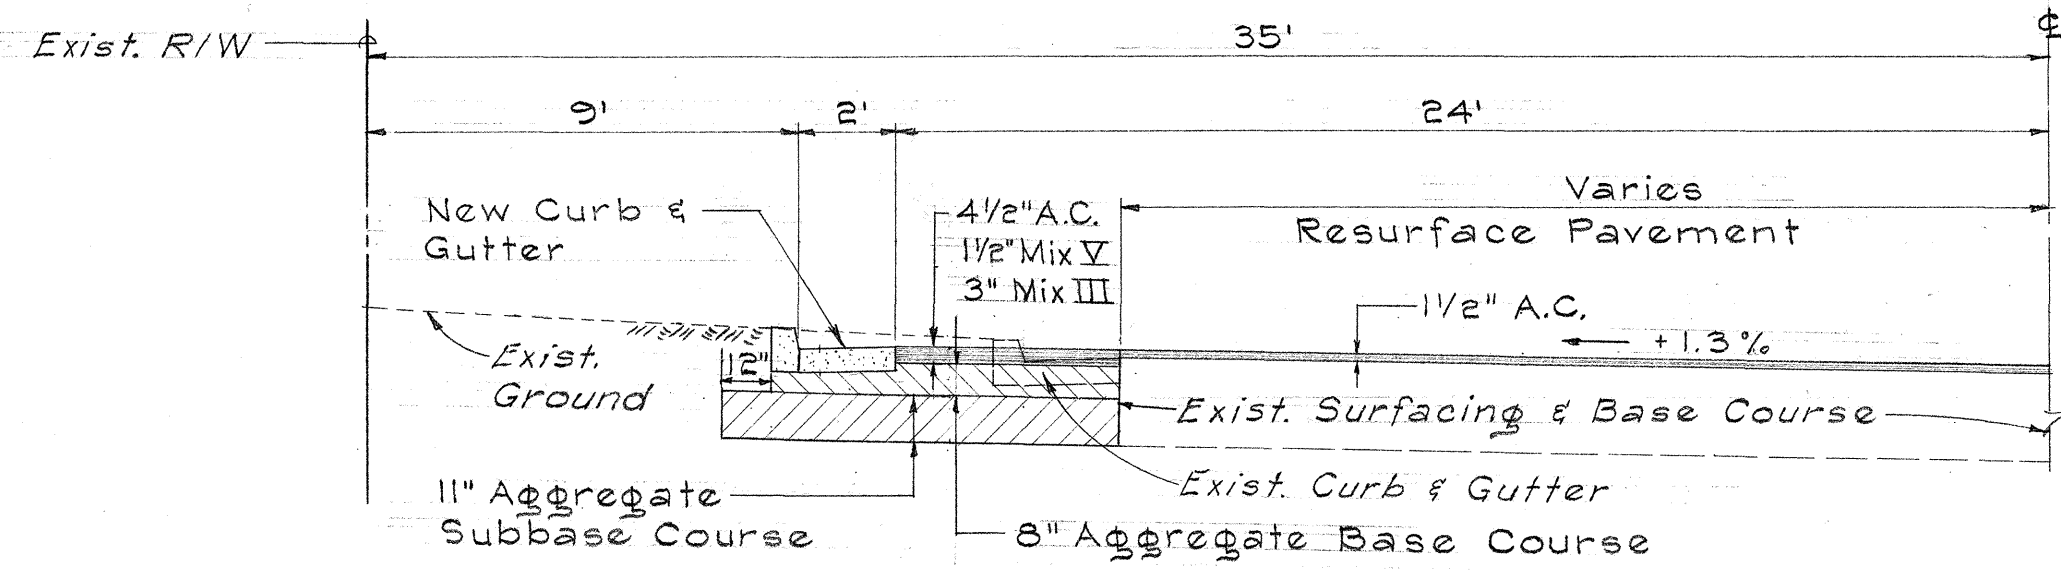


FED. ROAD DIST. NO.	STATE	PROJ. NO.	FISCAL YEAR	SHEET NO.	TOTAL SHEETS
HAWAII	HAW.	740A-01-70	1970	2	40

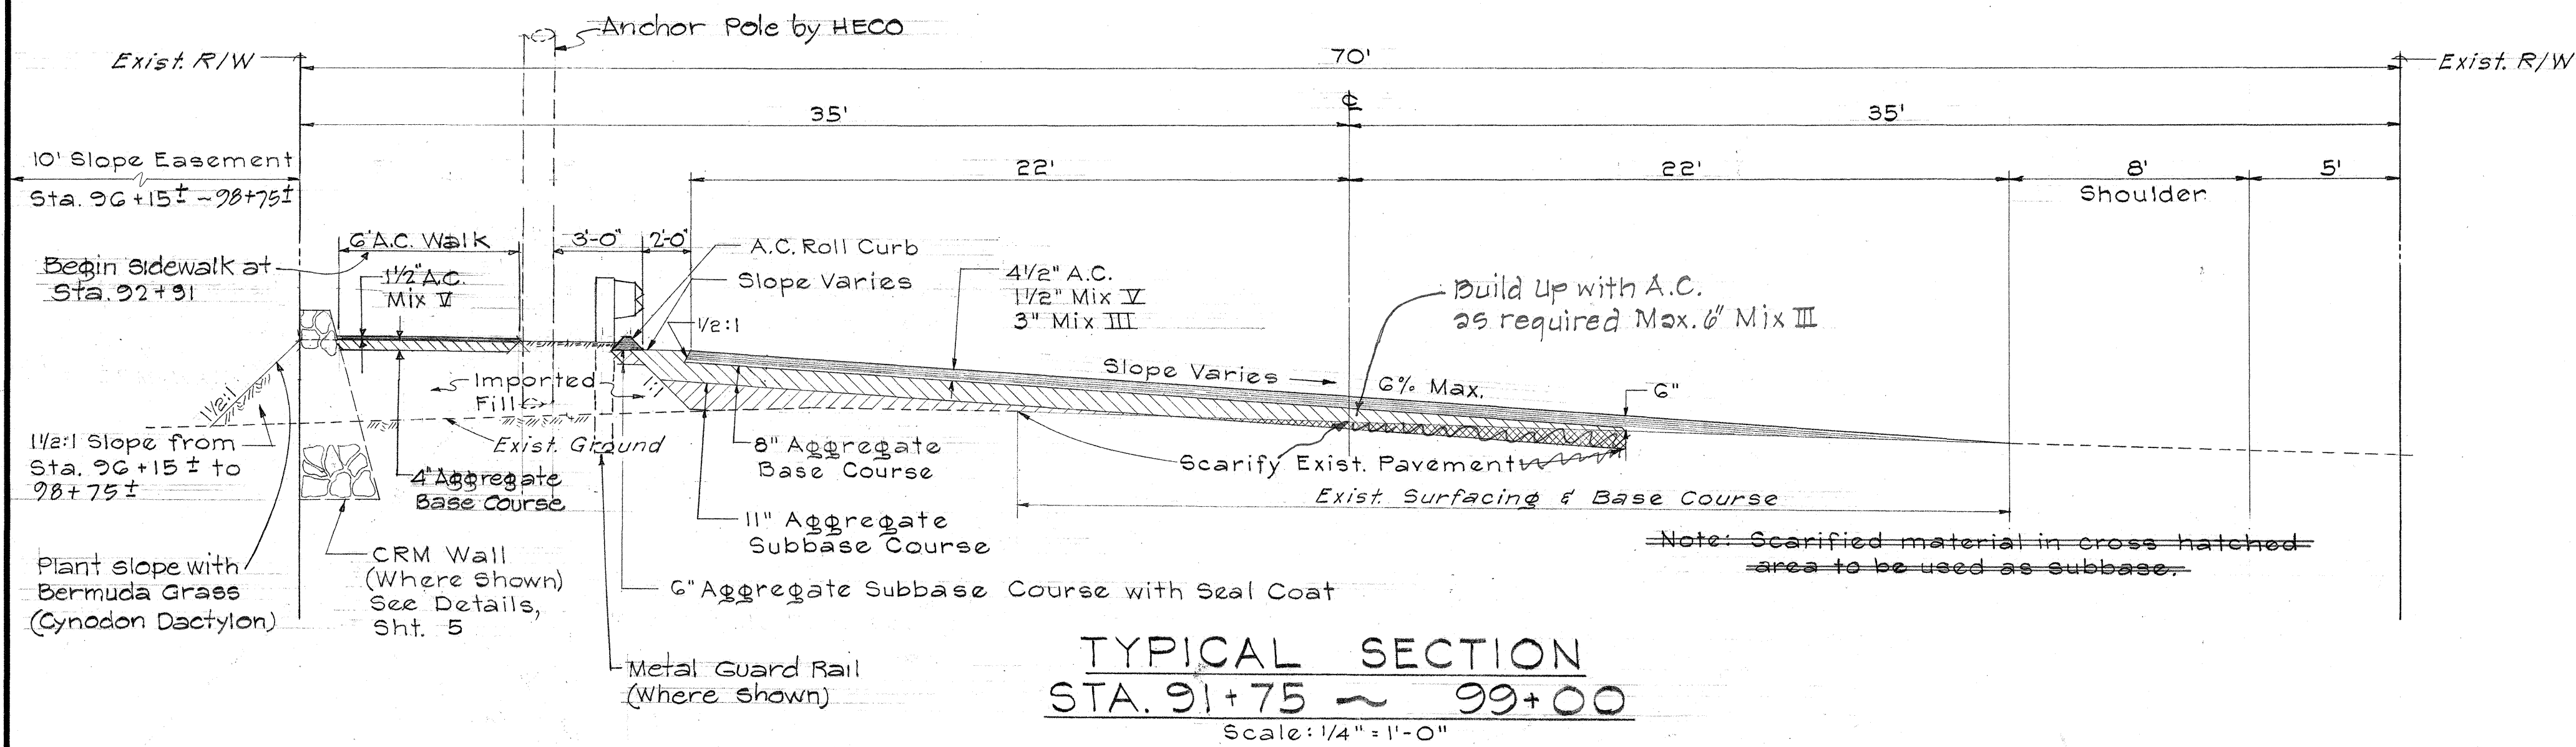

SURVEYED BY	DATE
DRAWN BY	
CHECKED BY	
DESIGNED BY	
NOTED BY	
QUANTITIES BY	
CHECKED BY	

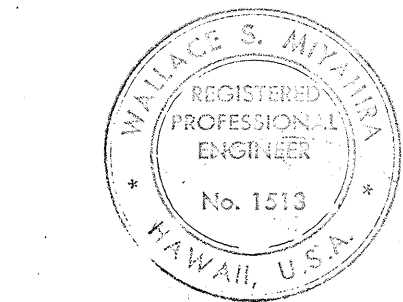

This work was prepared by me or under my supervision.
William S. Murphy

STATE OF HAWAII
DEPARTMENT OF TRANSPORTATION
HIGHWAYS DIVISION
KALANIANA'OLE HIGHWAY
WIDENING
TYPICAL & SPECIAL
SECTIONS

Proj. No. 740A-01-70
Scale: As Shown
Date: Oct., 1970
SHEET No. 1 OF 1 SHEETS