





FED. ROAD DIST. NO.	STATE	PROJ. NO.	FISCAL YEAR	SHEET NO.	TOTAL SHEETS
HAWAII	HAW.	72A-02-71	1971	5	8

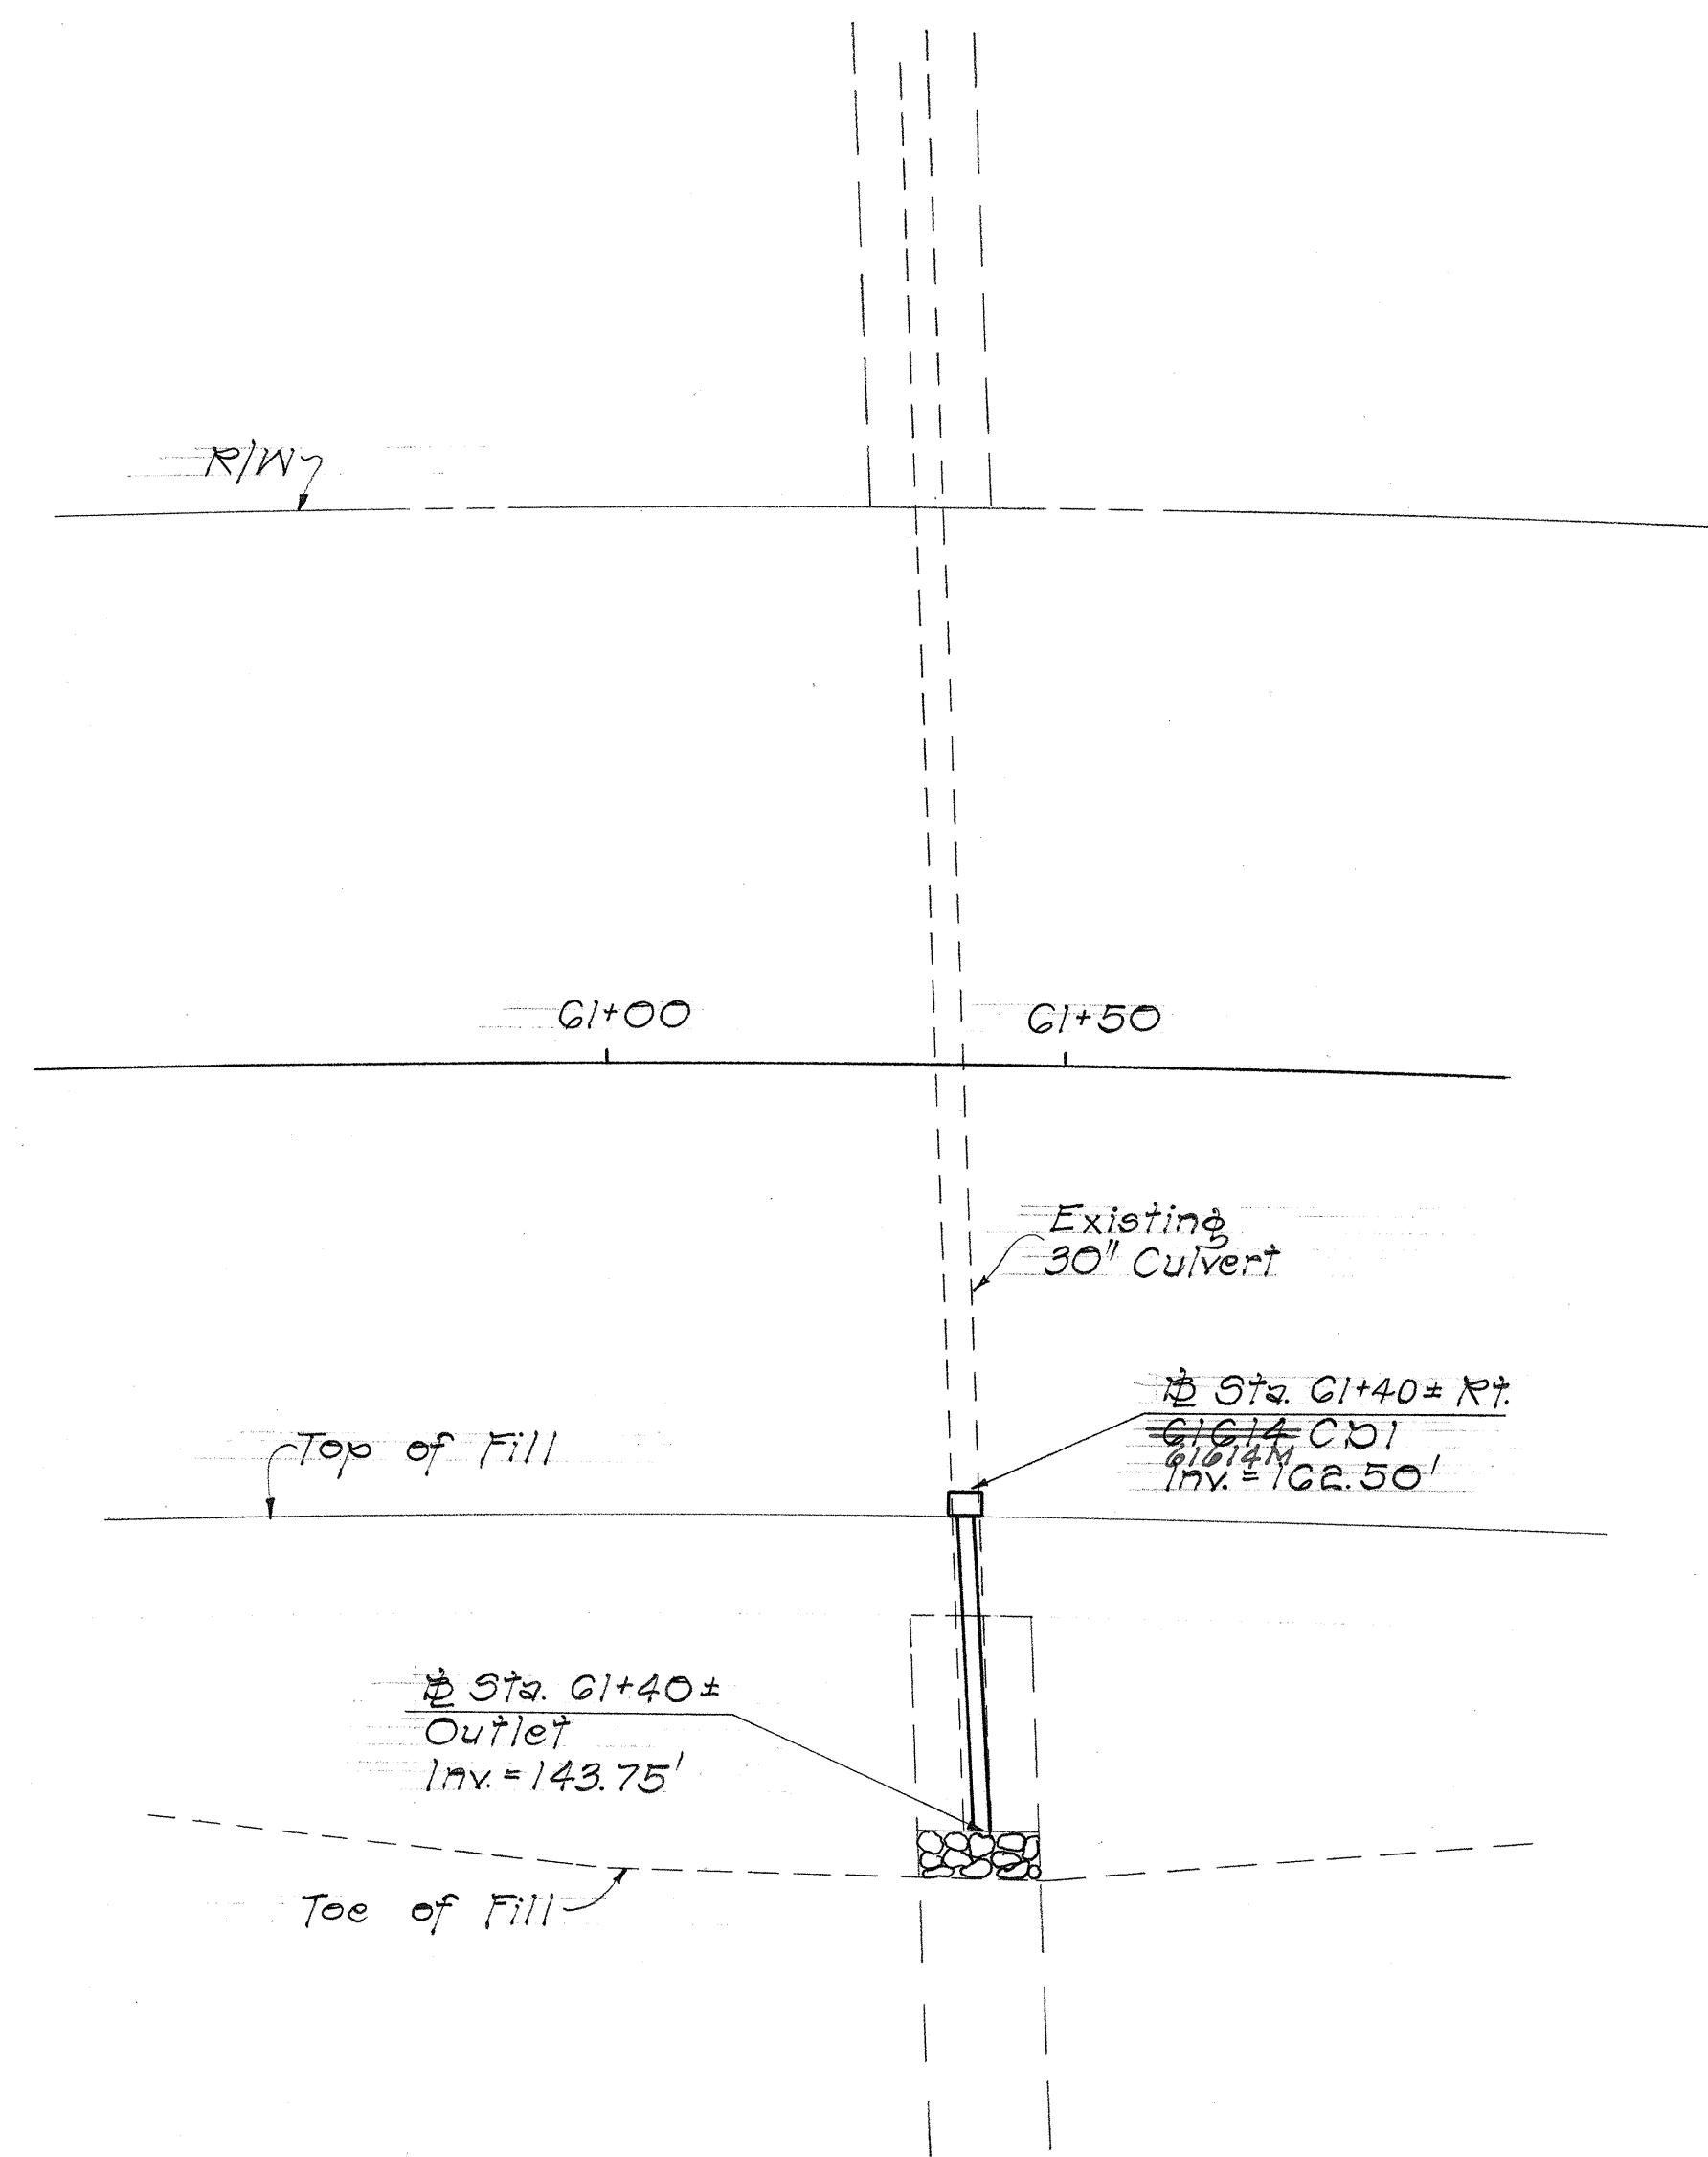


PLAN
Scale: 1"=20'

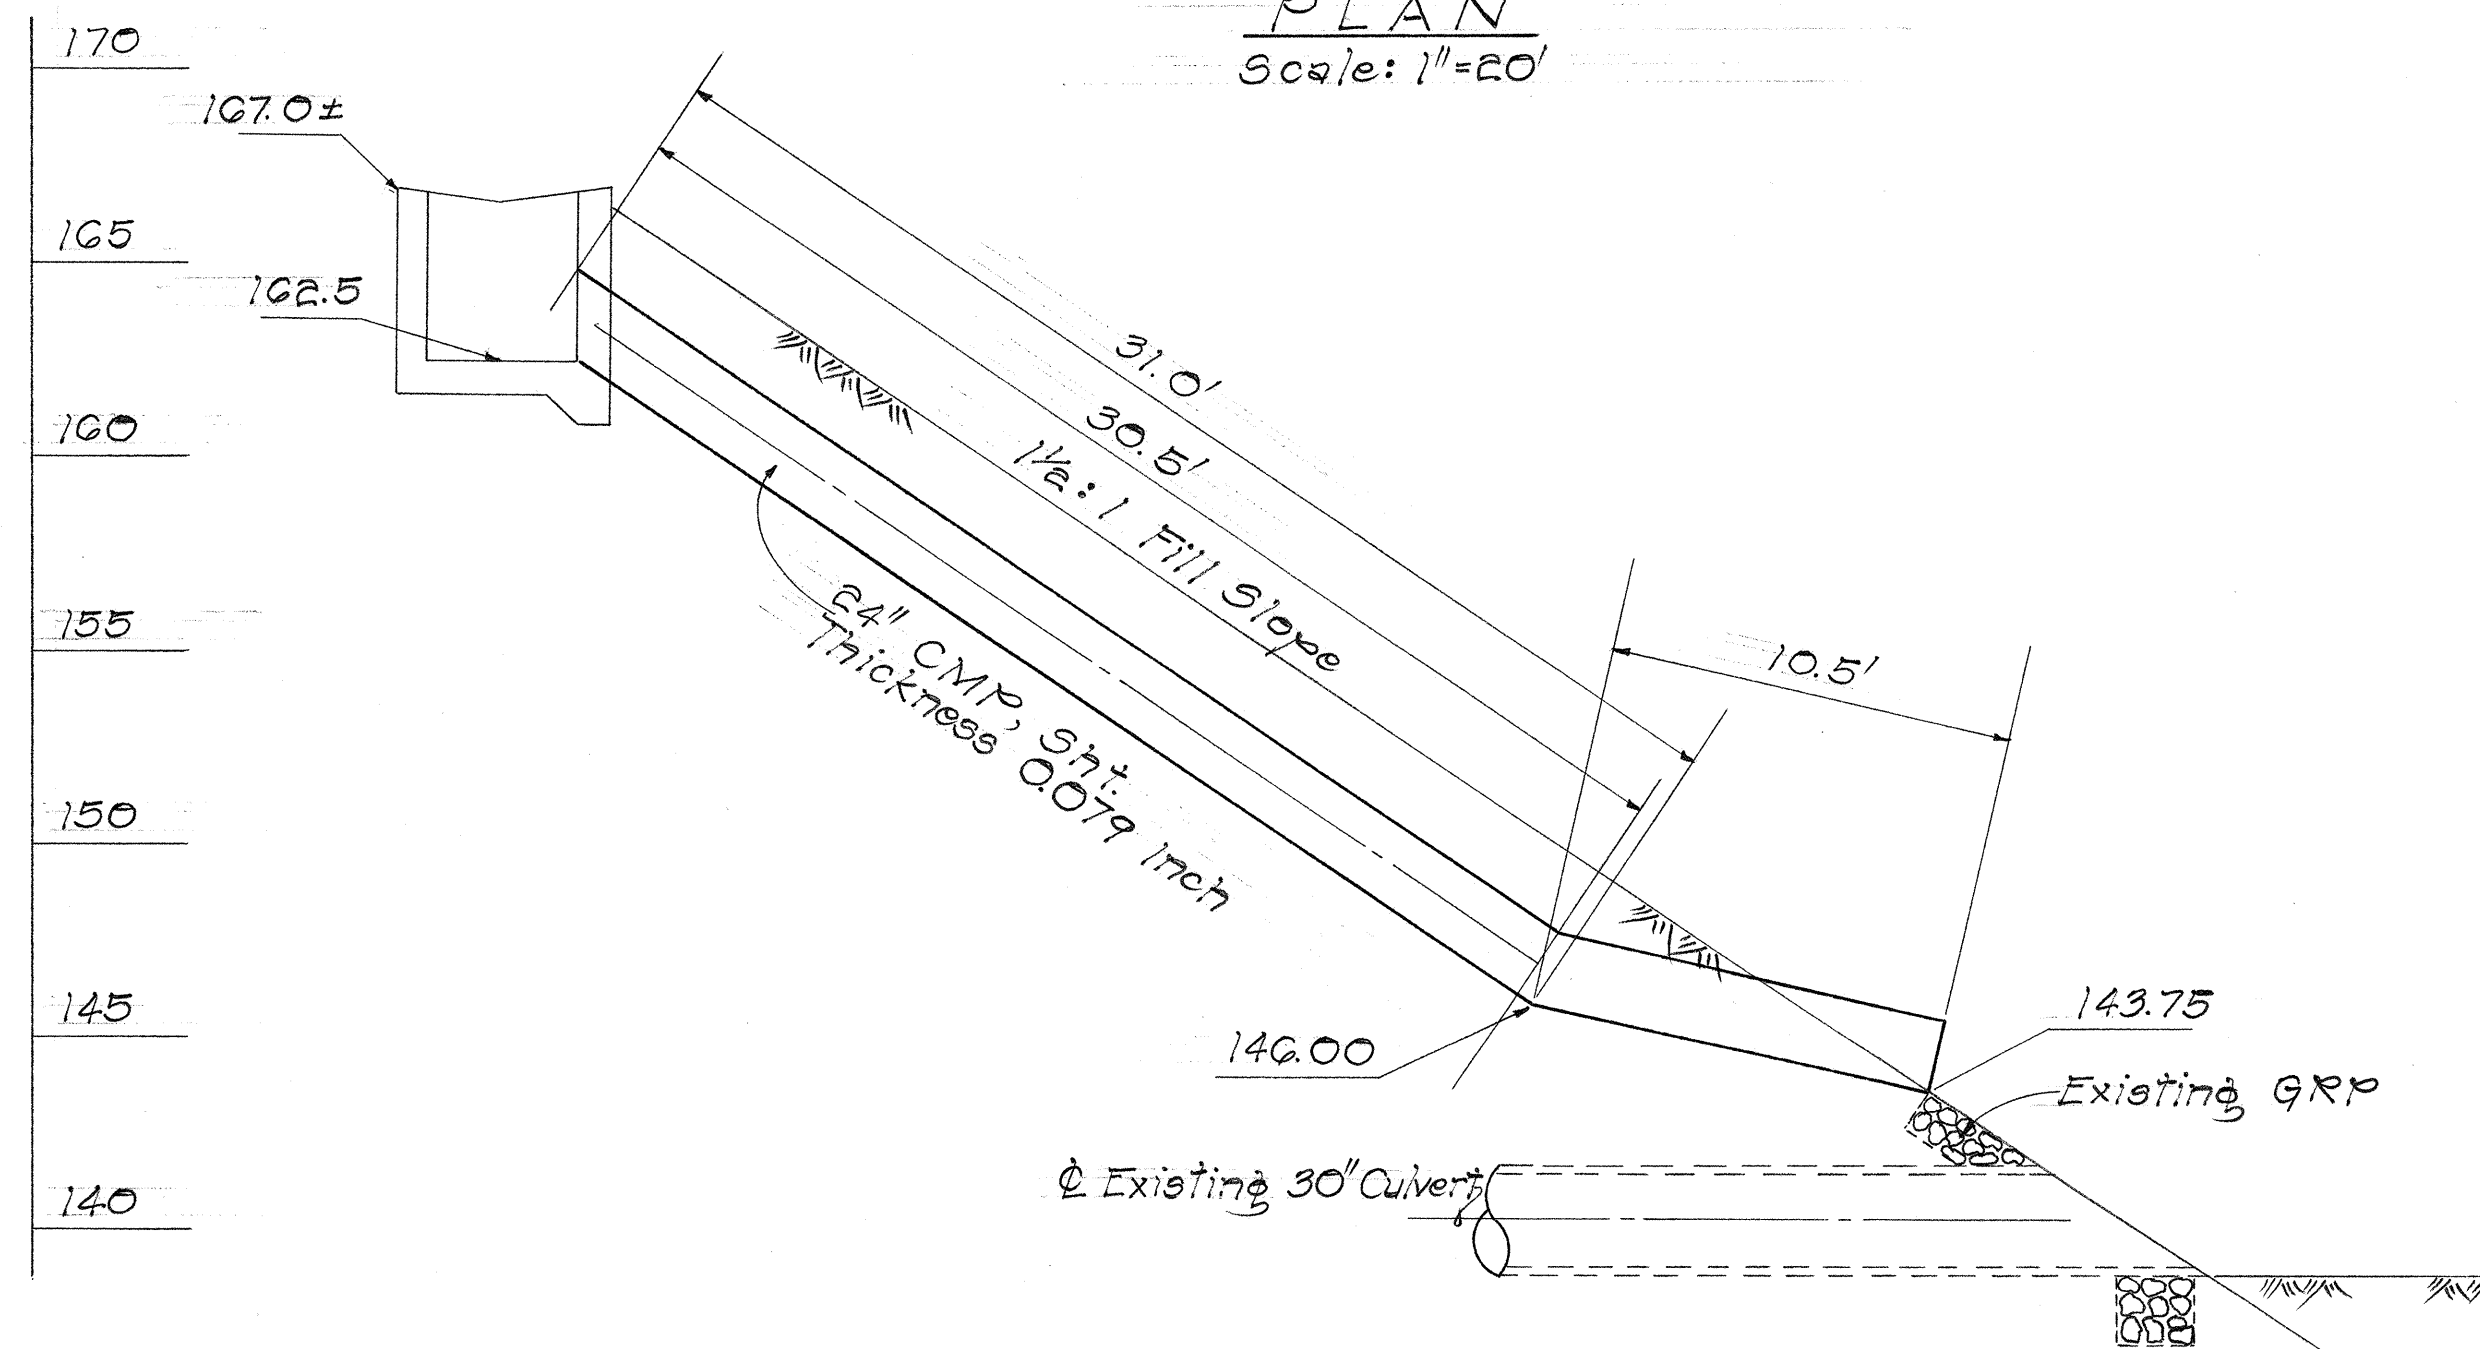

PROFILE OF CULVERT @ STA. 61+40± RT.
Scale: 1"=50'

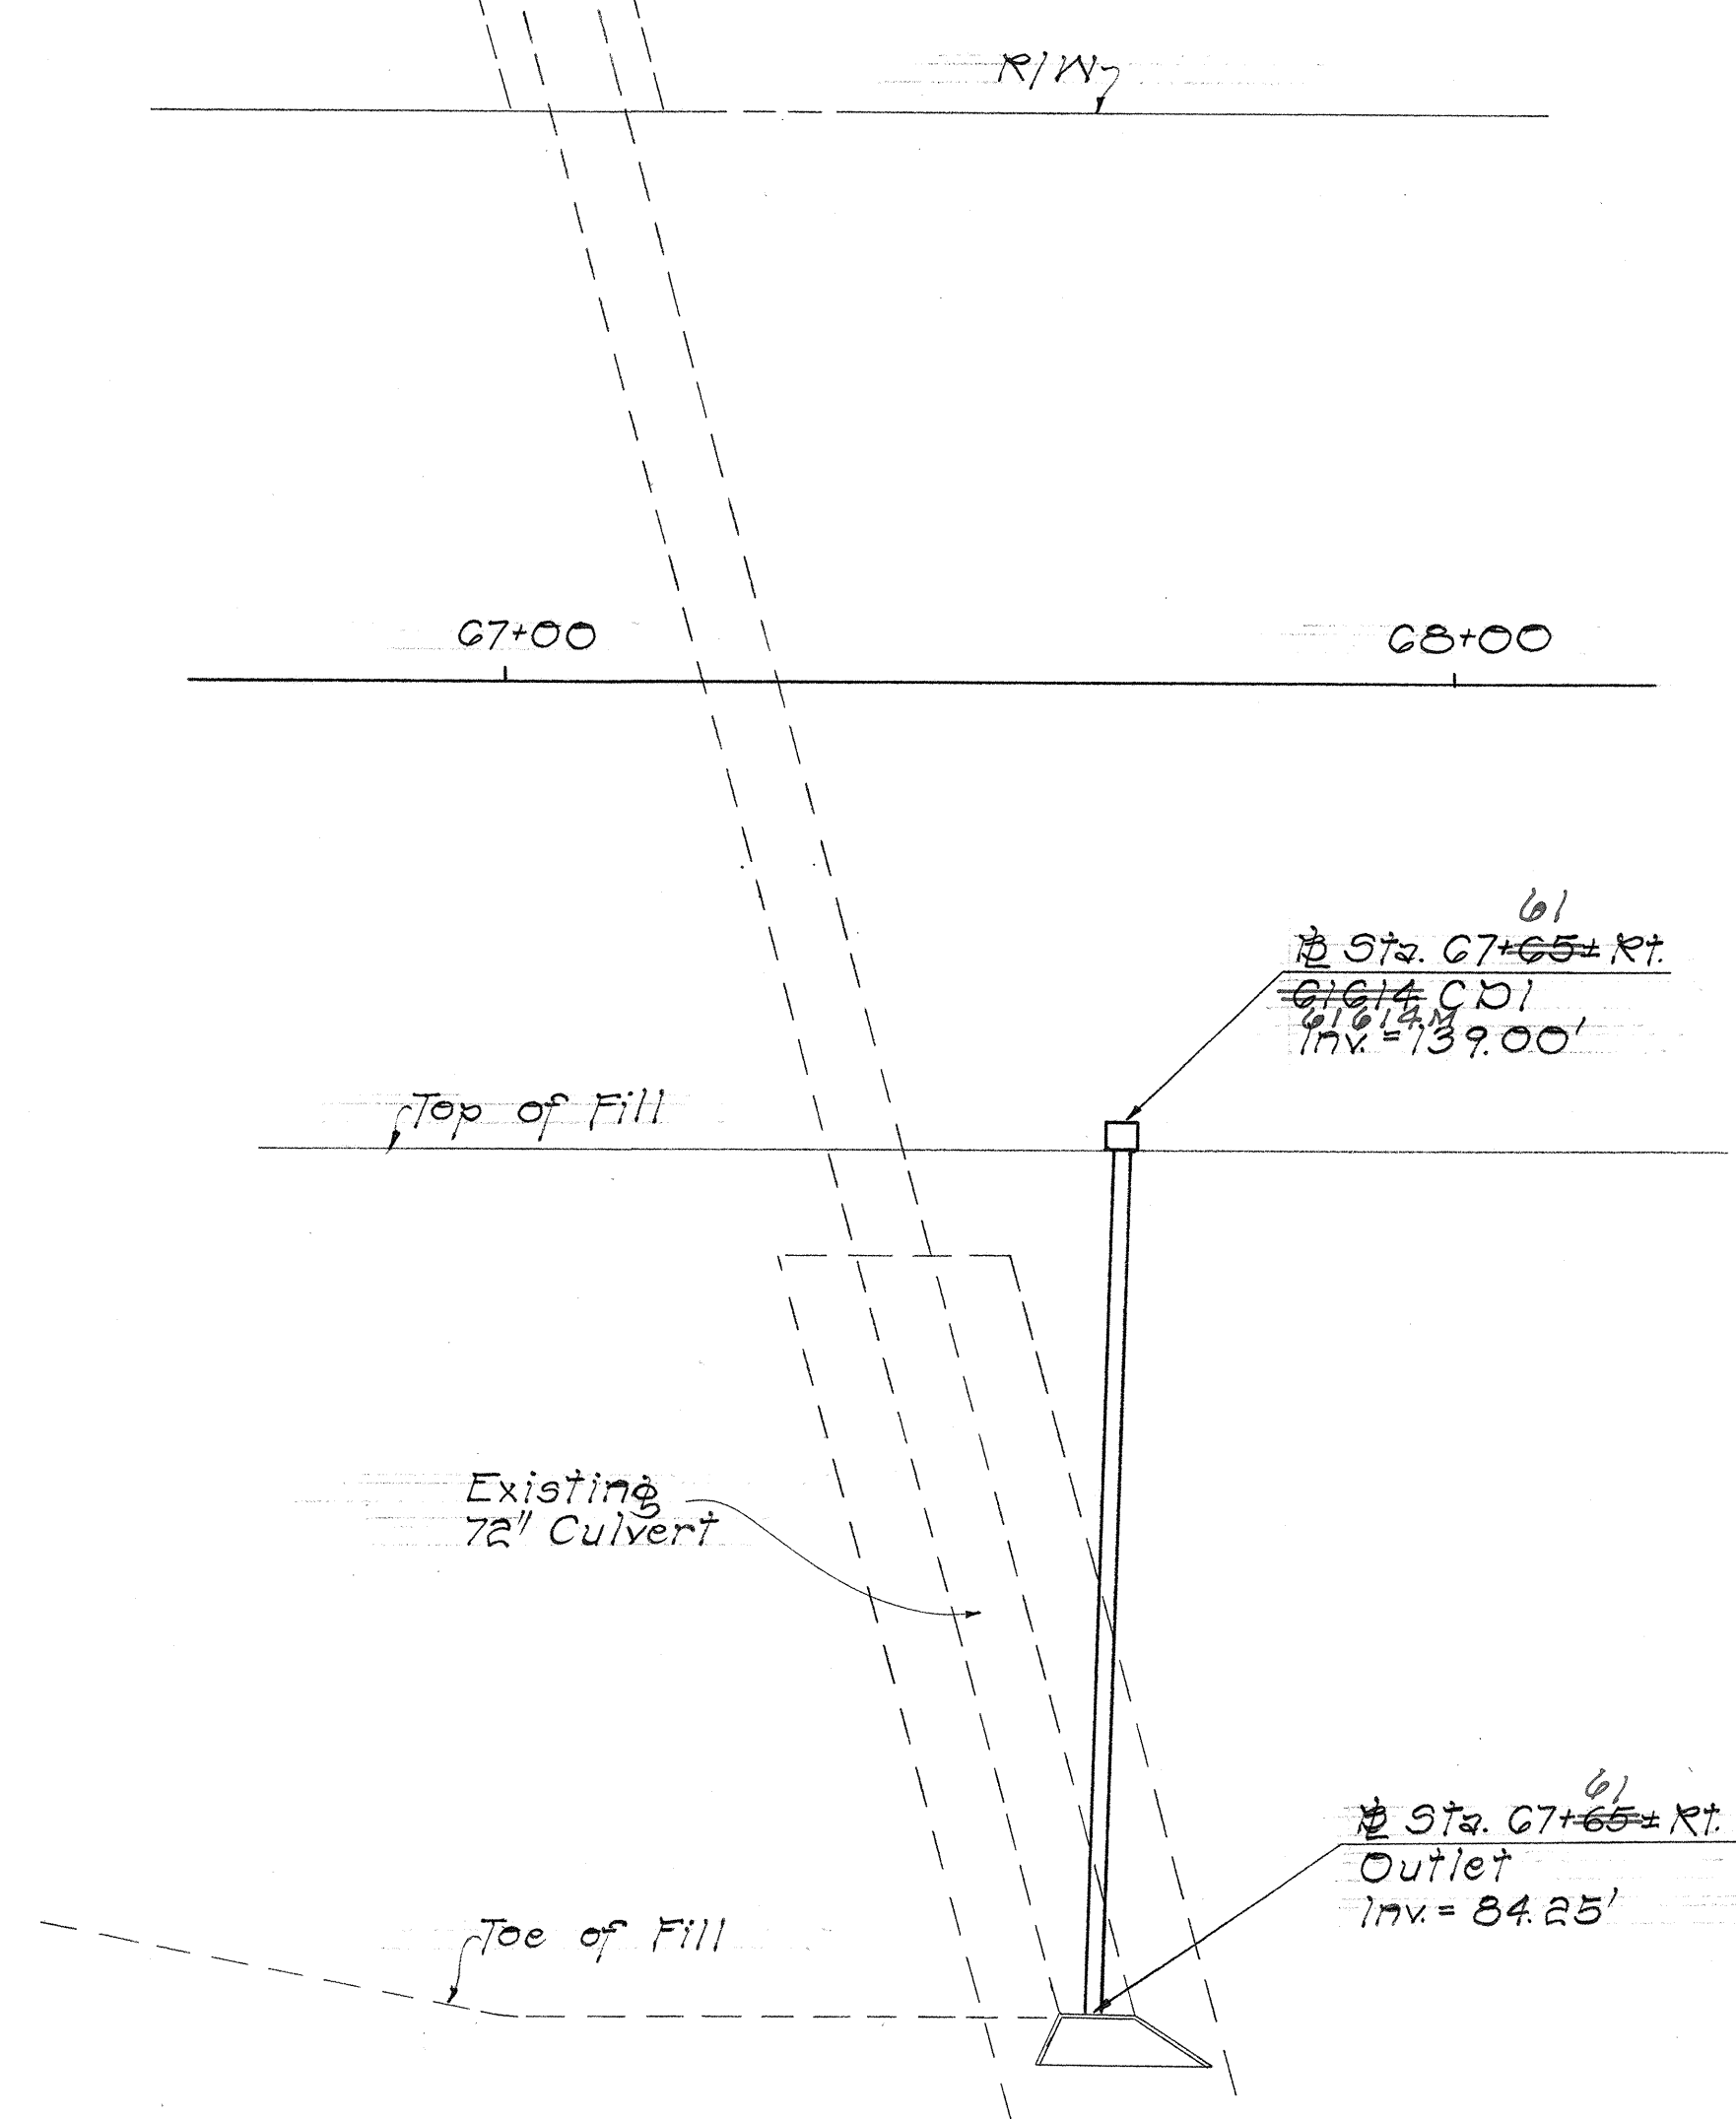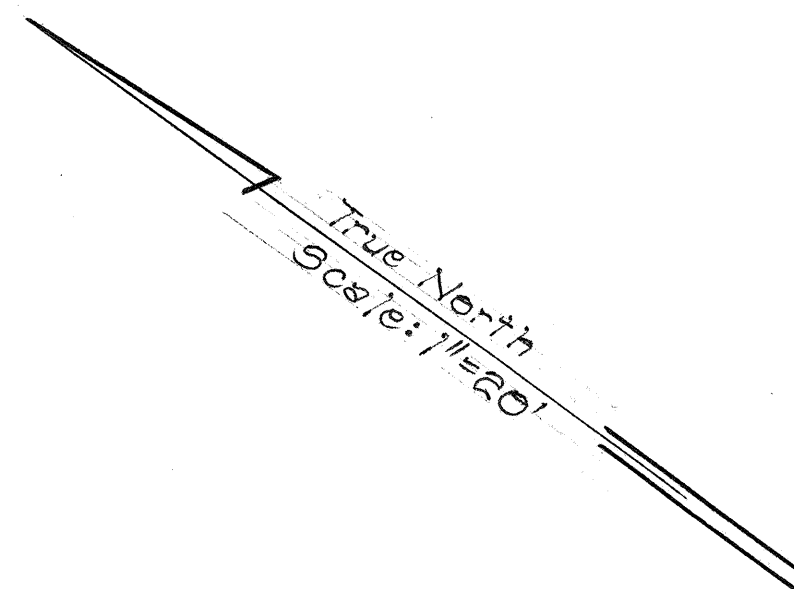

PLAN
Scale: 1"=20'

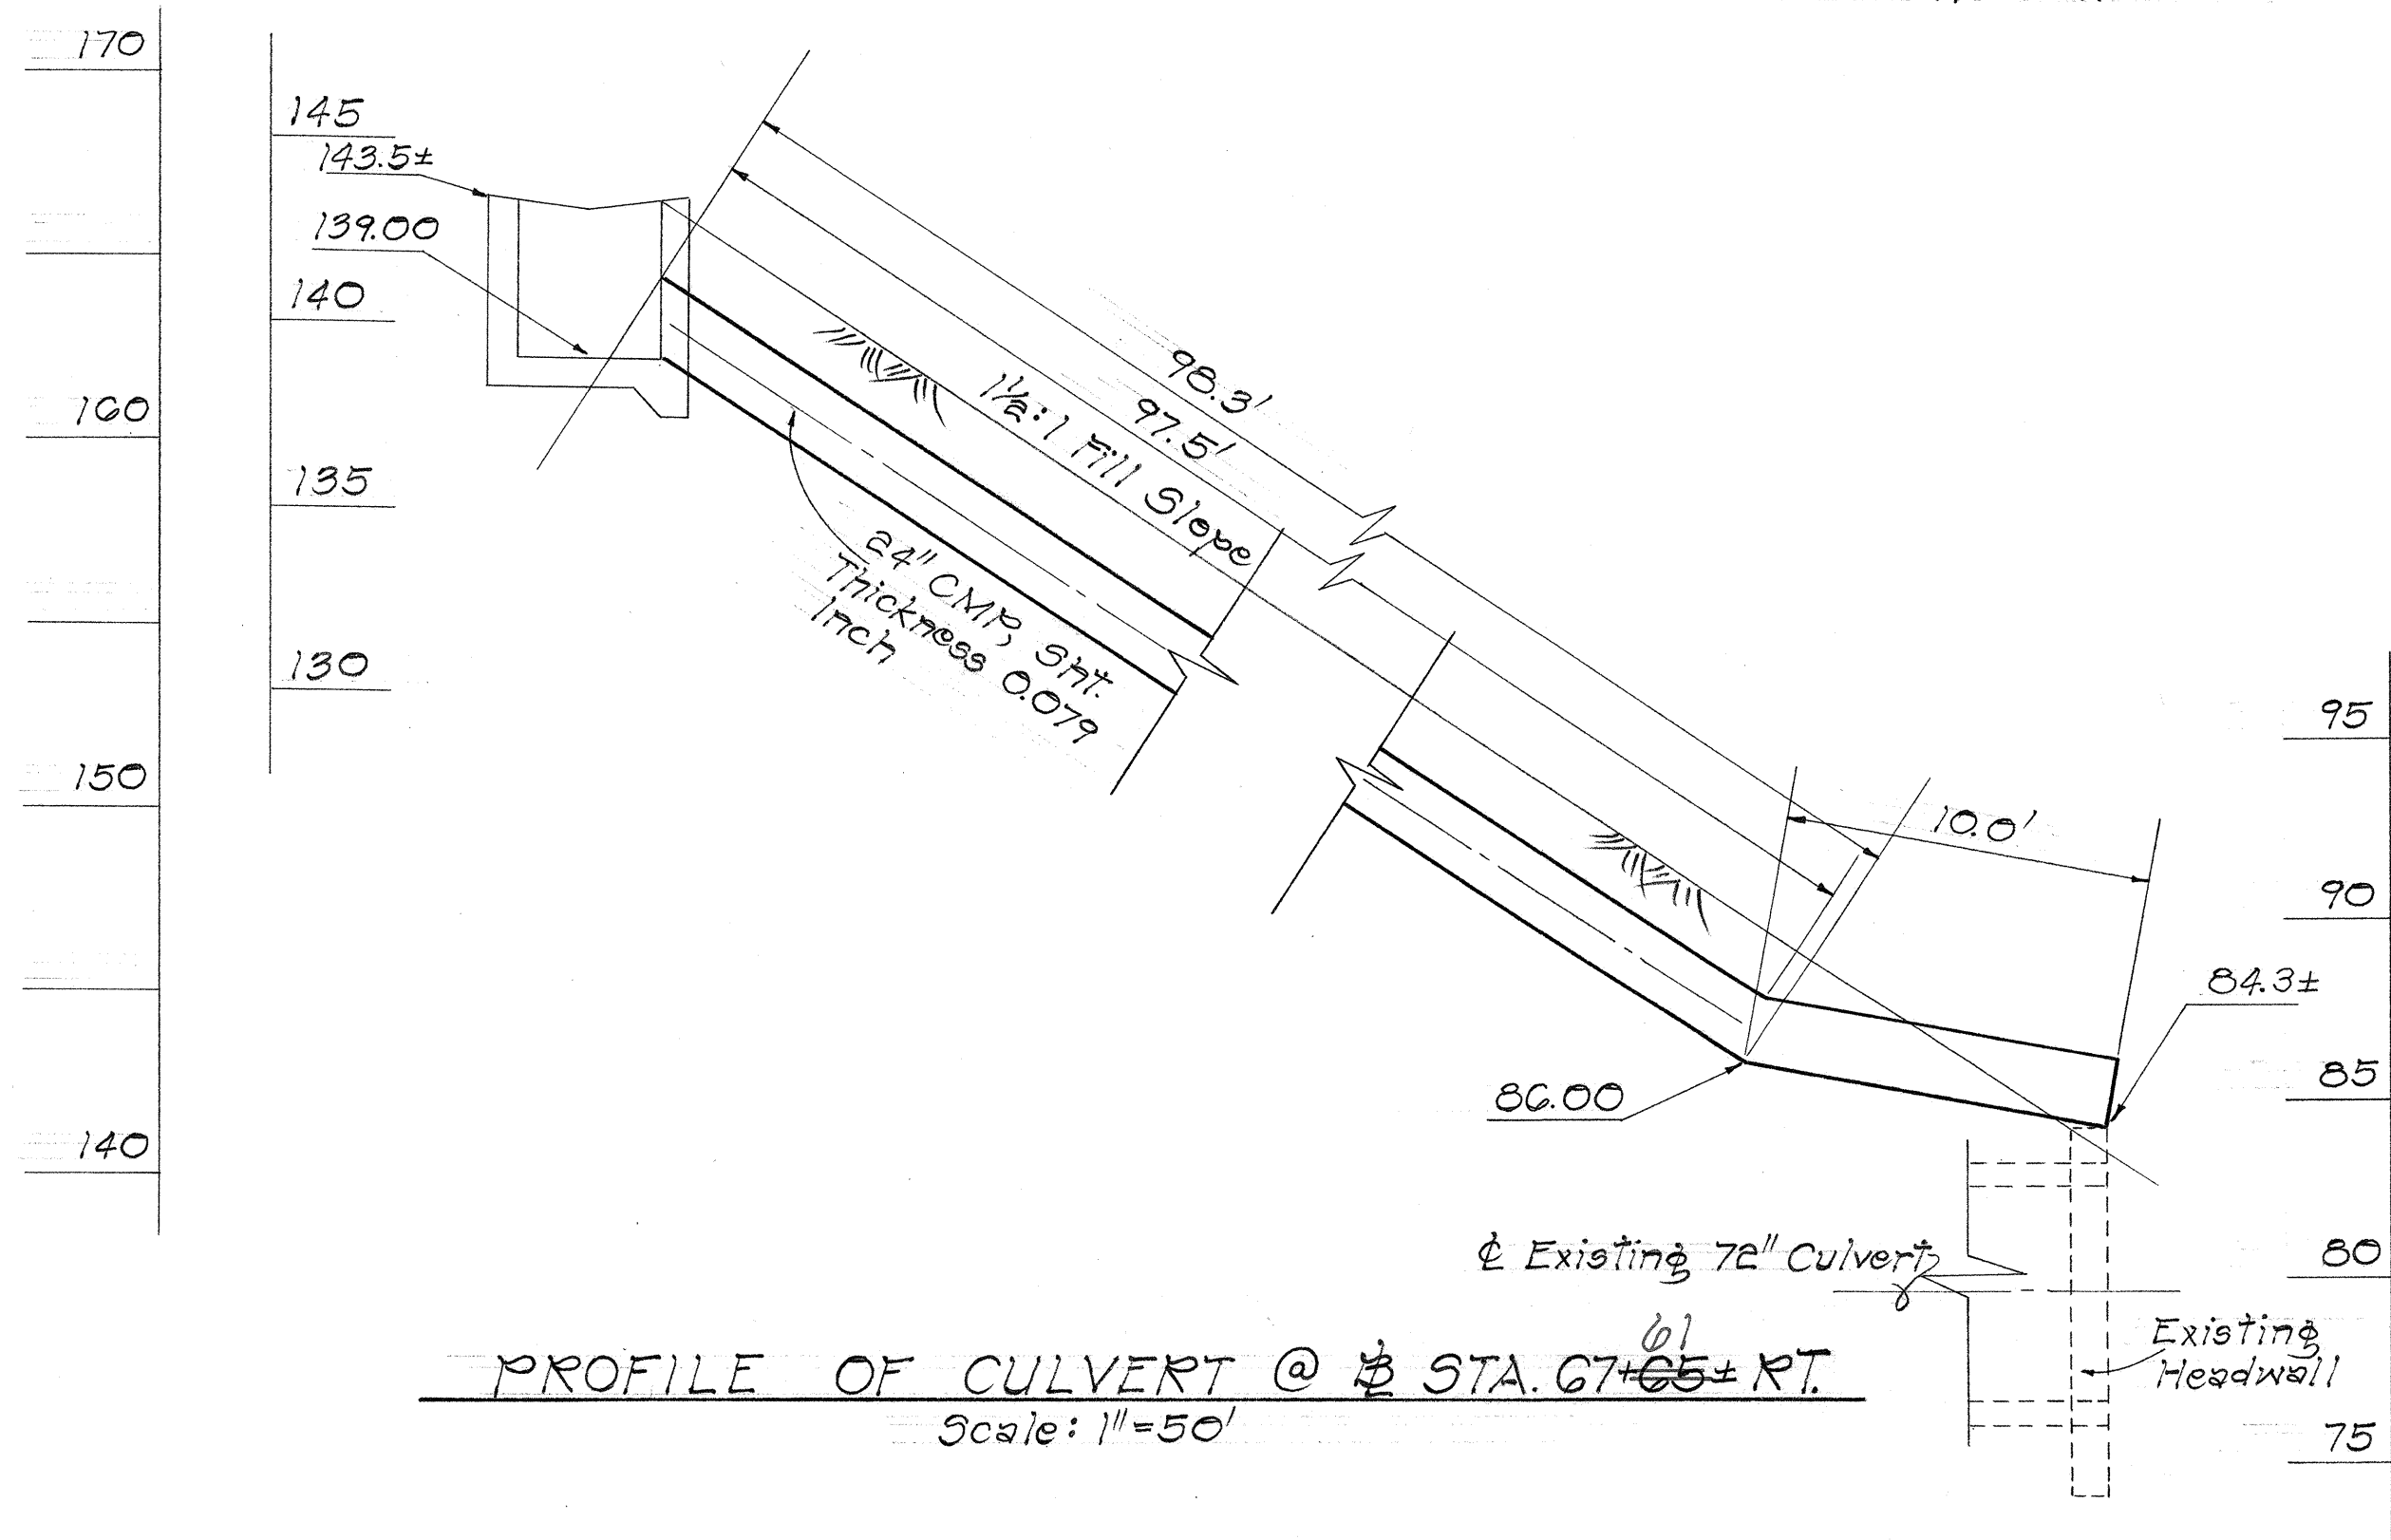

PROFILE OF CULVERT @ STA. 67+65± RT.
Scale: 1"=50'

STATE OF HAWAII
DEPARTMENT OF TRANSPORTATION
HIGHWAYS DIVISION

DRAINAGE DETAILS
PLAN AND PROFILES OF CULVERT

KALANIANA'OLE HIGHWAY
DRAINAGE IMPROVEMENTS
PROJECT NO. 72A-02-71

Scale: As Shown Date: Jan. 1971

