


FED. ROAD DIST. NO.	STATE	FED. AID PROJ. NO.	FISCAL YEAR	SHEET NO.	TOTAL SHEETS
HAWAII	HAW.	EHS-T-9001(11)	1972	C02	7

CONSTRUCTION NOTES



1. All Traffic Marking work will be performed by the State
2. The exact locations of Traffic Standards, Controller and Cabinet and Pull Boxes shall be determined in Field by the Engineer
3. Contractor to call Phone 548-2126 for Field Location of gas lines a minimum of 48 hours before starting Project Excavation
4. All Traffic Signal Pull-Boxes shall be Type "B", except the Controller Pull-Box which shall be Type "A".
5. Traffic Signs indicated as "Remove" shall be delivered to the State Highway Maintenance Yard at 727 Kakoi St.
6. See Special Provisions. Section 623 for Materials & Equipment to be furnished by State.

SURVEY PLOTTED BY	DATE
DESIGNED BY	
TRACED BY	
NOTED BY	
CHECKED BY	
ORIGINAL PLAN	
NOTE BOOK	
No.	

C-6-7

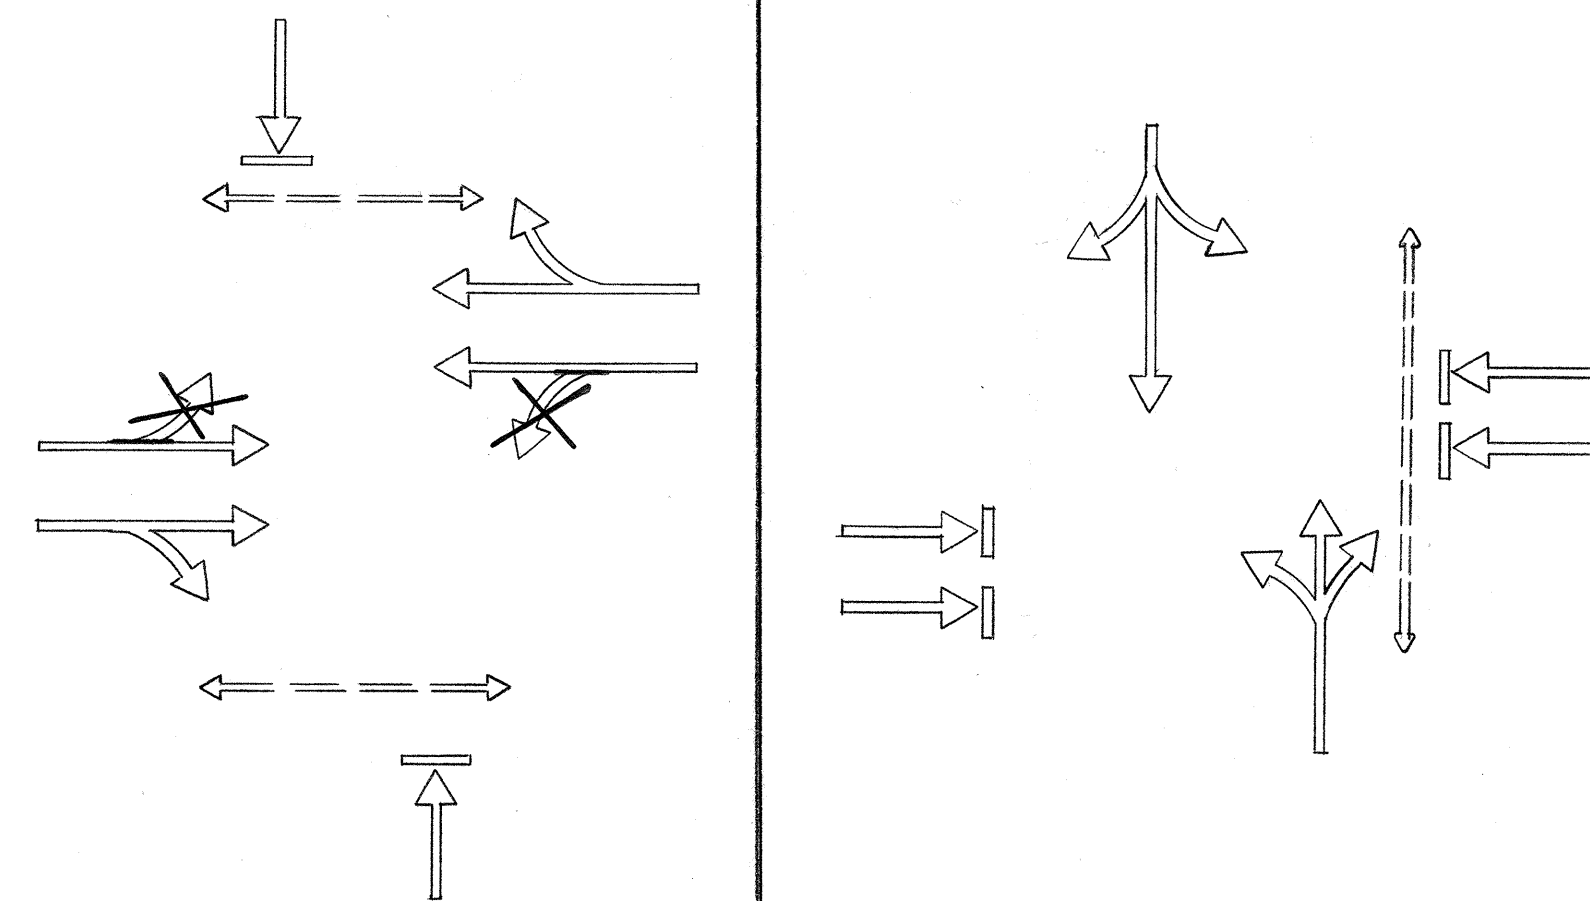

PHASE 1
PHASE 2
PHASE DIAGRAMS

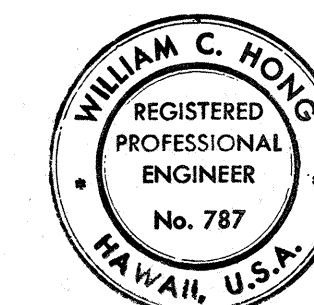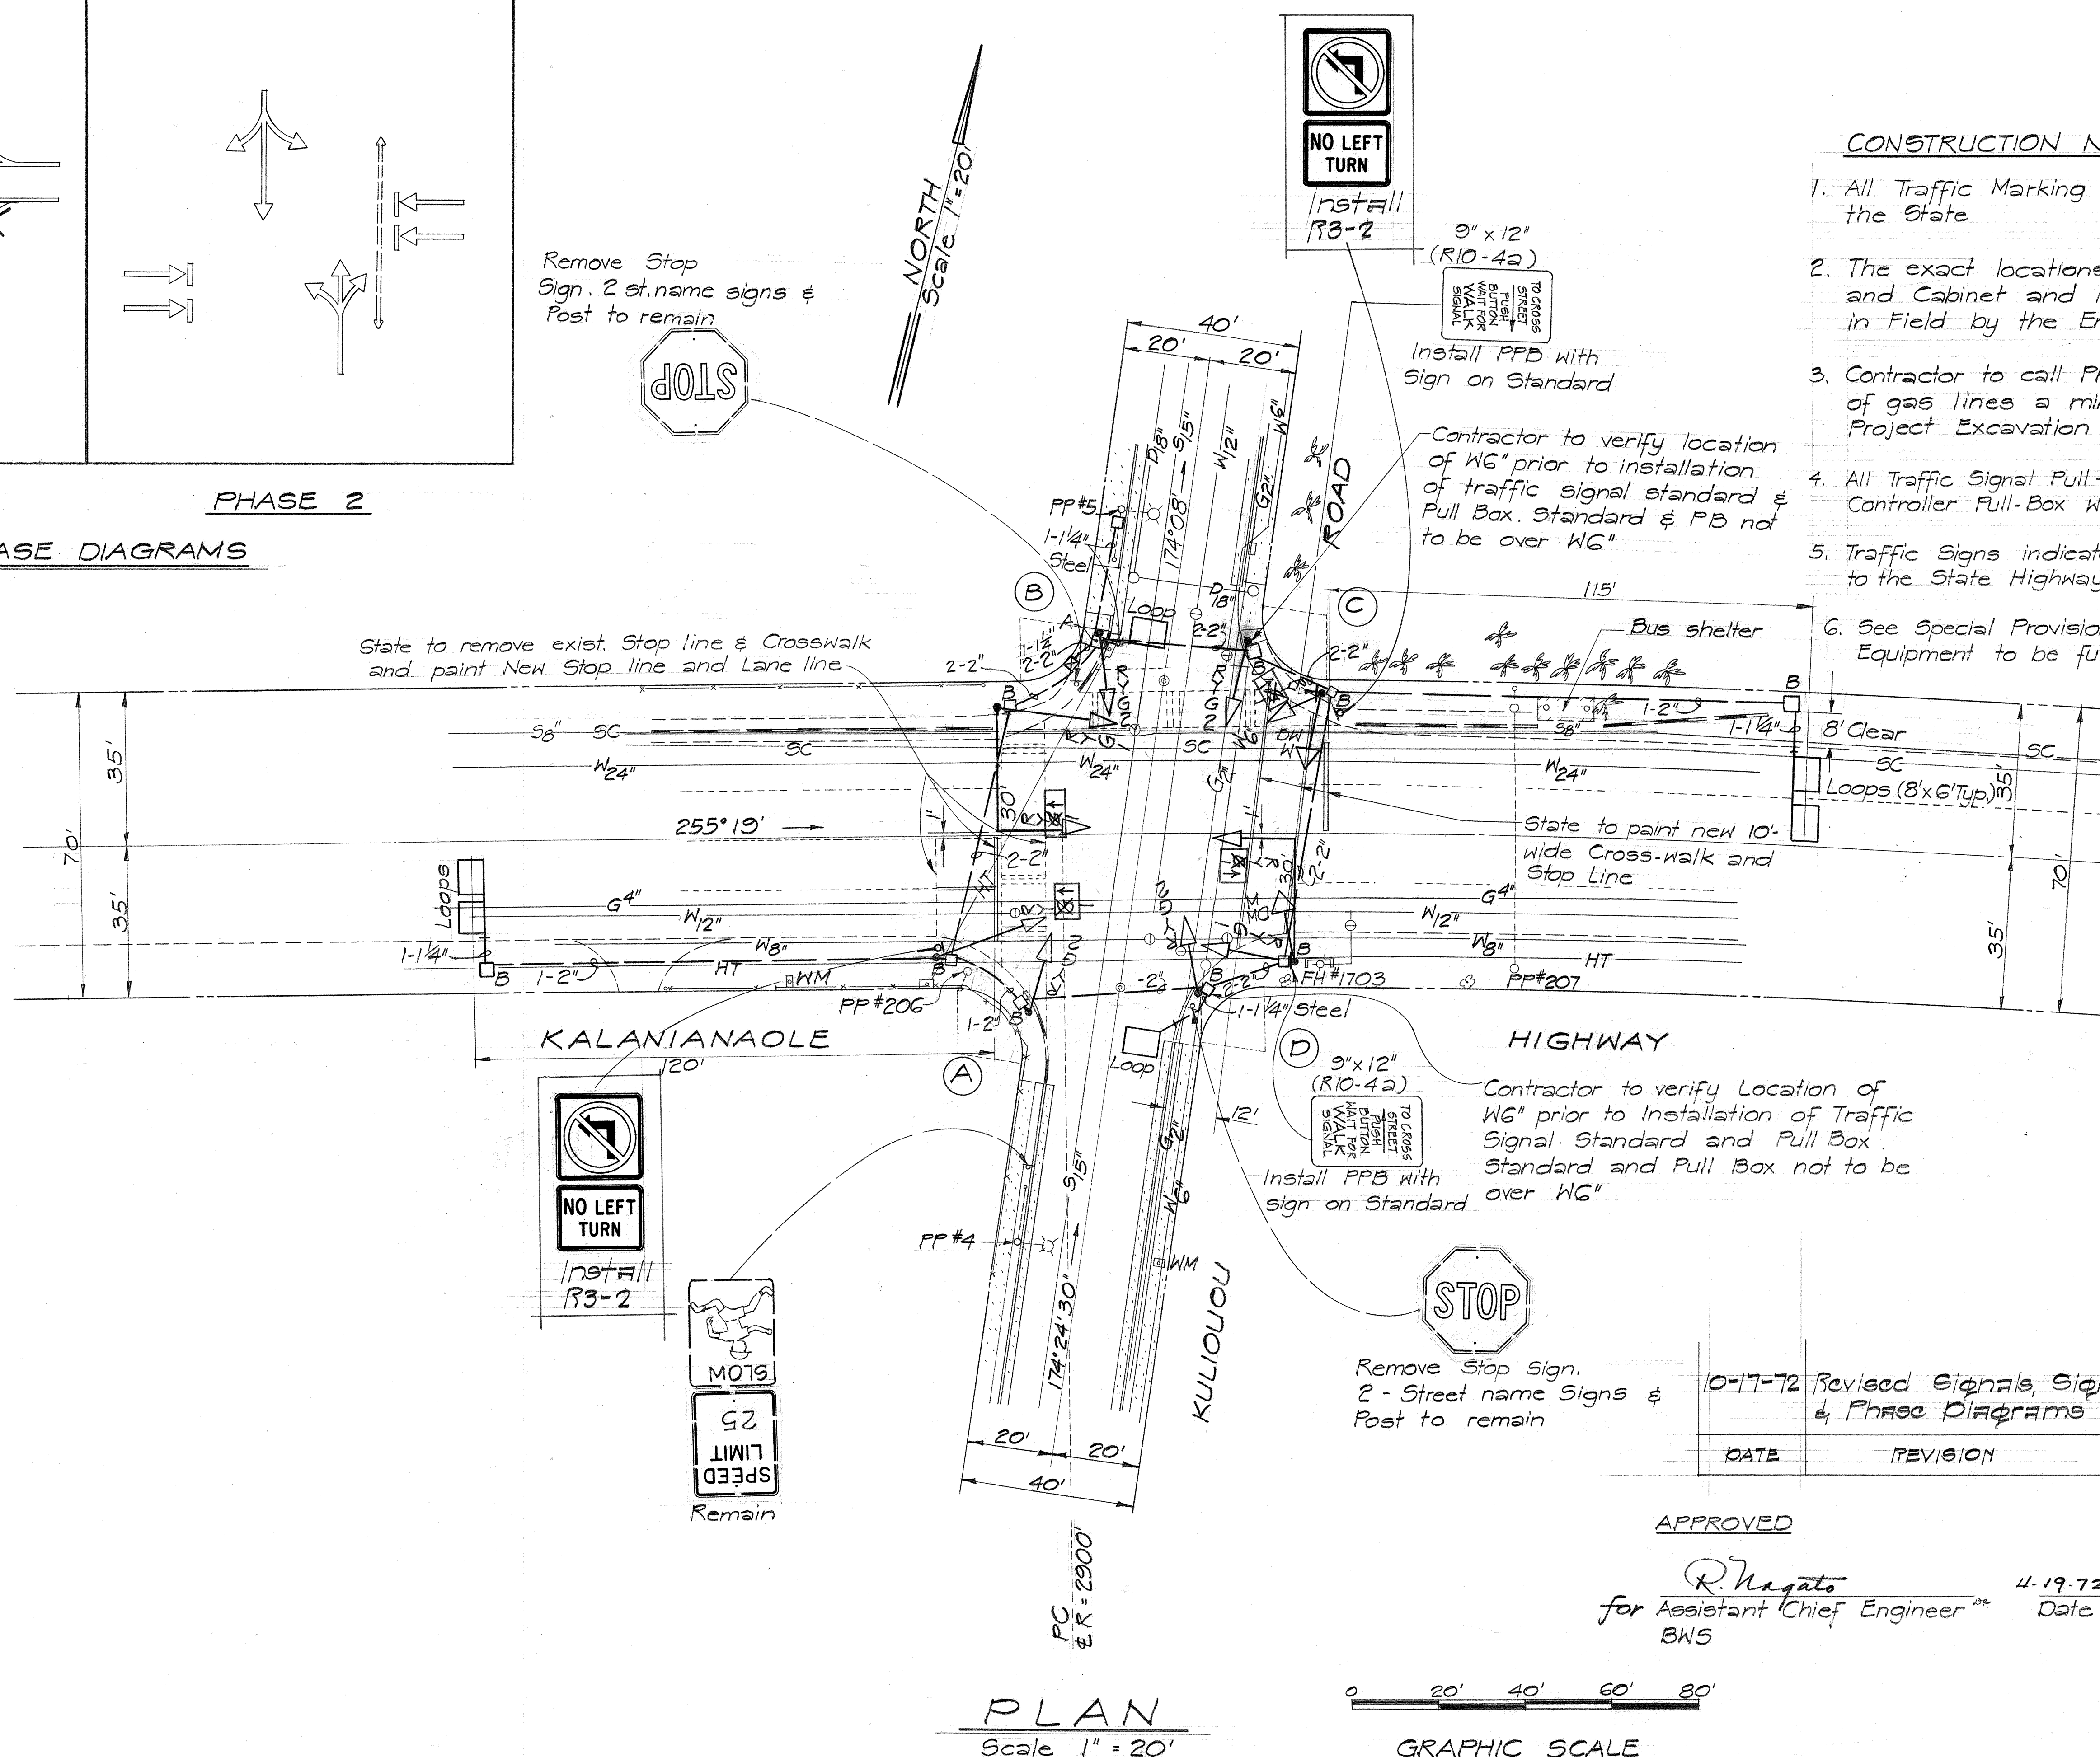

THIS WORK WAS PREPARED BY
ME OR UNDER MY SUPERVISION
William C. Hong

STATE OF HAWAII
DEPARTMENT OF TRANSPORTATION
HIGHWAYS DIVISION

PLAN FOR
INSTALLATION OF TRAFFIC SIGNALS
ON
KALANIANA'OLE HIGHWAY AT
KULIOUOU ROAD
PROJECT No. EHS-T-9001(11)
Scale: as shown Date: June 9, 1972
SHEET No. 1 OF 1 SHEETS

C.O. 2