INDEX TO DRAWINGS	
SHEET NO.	DESCRIPTION
l .	TITLE SHEET
2	PLAN
3	MISCELLANEOUS DETAILS
4	CONSTRUCTION NOTES
5-7	STANDARD DETAILS
,	
	·



STATE OF HAWAII



TRANSPORTATION DEPARTMENT OF DIVISION HIGHWAYS

HAWAII HONOLULU,

"AS BUILT"

PLANS FOR

THE INSTALLATION OF TRAFFIC SIGNALS

ON

KALANIANAOLE HIGHWAY AT KULIOUOU ROAD

FEDERAL-AID TOPICS PROJECT NO. EHS-T-9001(II) DISTRICT OF HONOLULU

ISLAND OF OAHU

LEGEND

EXISTING EDGE OF PAVEMENT

EXISTING CONCRETE CURB & GUTTER

EXISTING POWER POLE (#23) WITH STREET LIGHT

EXISTING UNDERGROUND TELEPHONE LINE

EXISTING DRAIN LINE (24") AND MANHOLE

EXISTING GAS LINE (4")

EXISTING SEWER LINE (8") AND MANHOLE

EXISTING WATER LINE (24") AND MANHOLE EXISTING PAVEMENT MARKINGS

STANDARD

NEW PAVEMENT MARKINGS

WITH NEW CONDUIT (1-2")

EXISTING TRAFFIC SIGN AND POST

NEW VEHICLE DETECTOR (LOOP INDICATED)

NEW TRAFFIC SIGNAL PULL BOX (TYPE "B")

CONTROLLER, TYPE "G" CABINET, ACCESSORIES

AND AUXILIARY EQUIPMENT ON 4' TYPE I

EXISTING BITUMINOUS (A/C) CURB

VEHICULAR SIGNAL HEADS R-Y-G


G-15~


& E. BY

NEW TYPE I TRAFFIC SIGNAL STANDARD (10' HEIGHT) WITH STANDARD VEHICULAR SIGNAL HEAD R-Y-G, PEDESTRIAN SIGNAL HEAD DW-W AND PEDESTRIAN PUSH - BUTTON WITH INSTRUCTION SIGN (PPB), ARROW AS INDICATED.

NEW TYPE II TRAFFIC SIGNAL STANDARD WITH

MAST ARM (ARM SPREAD INDICATED) AND STANDARD

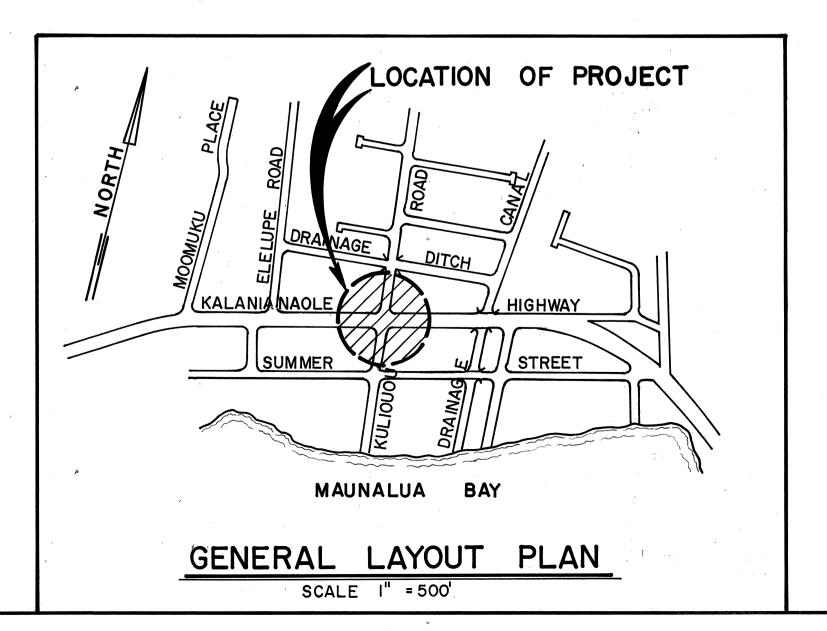


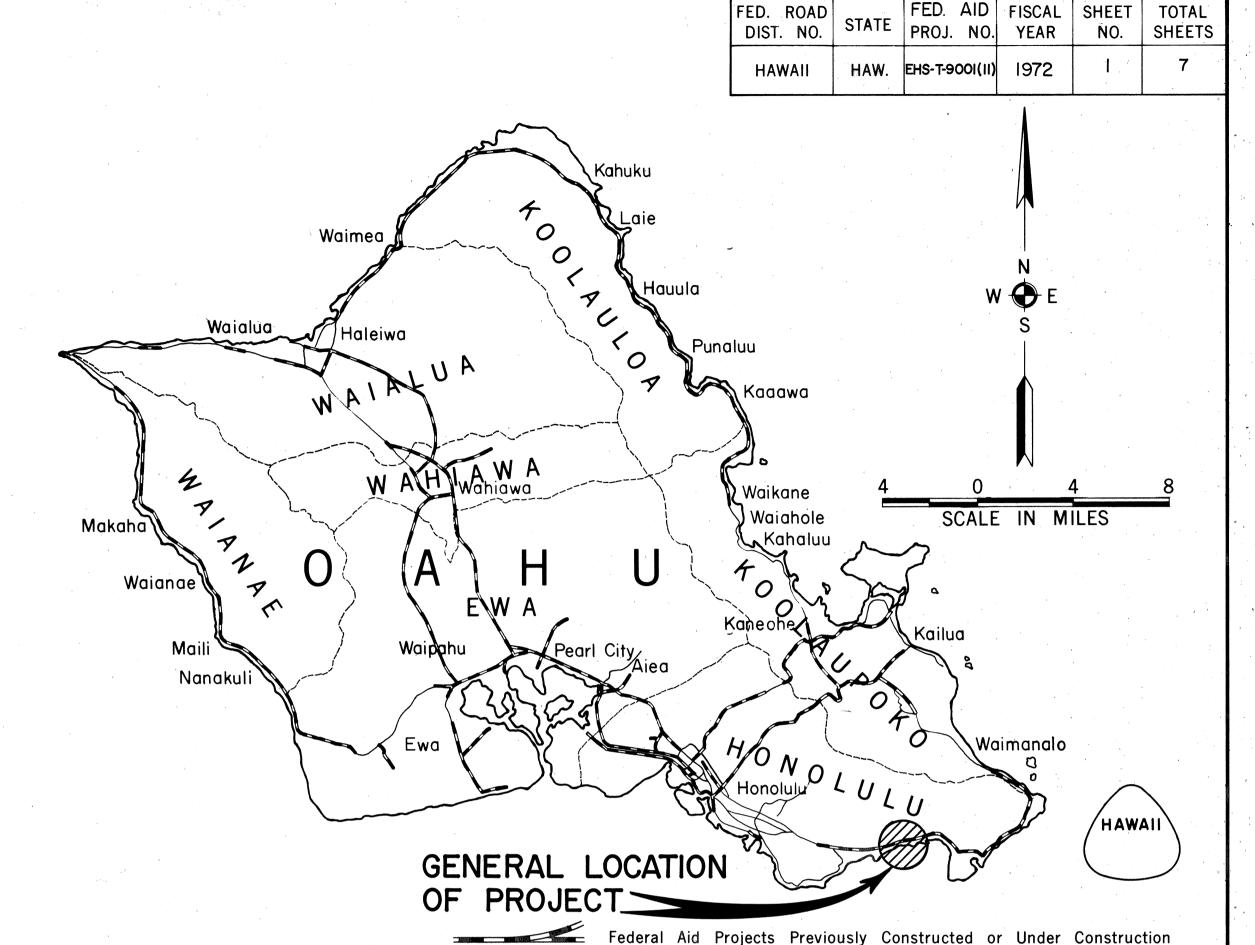

NOTE:

ALL CHANGES MADE DURING CONSTRUCTION HAVE BEEN NOTED IN RED ON THESE TRACINGS AND CHECKED BY:

> PROJECT ENGINEER 6/26/73 DATE

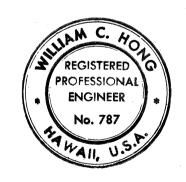

THIS WORK WAS PREPARED BY

DEPARTMENT OF TRANSPORTATION FEDERAL HIGHWAY ADMINISTRATION APPROVED: DIVISION ENGINEER

DEPARTMENT OF TRANSPORTATION STATE OF HAWAII APPROVED: **G/20/72**DATE FOR DIR. OF TRANSPORTATION