INDEX TO DRAWINGS	
SHEET NO.	DESCRIPTION
l	TITLE SHEET
2	DETAILS AND NOTES
3 - 5	PLANS
4	
:	
·	
	·



STATE OF HAWAII



TRANSPORTATION DEPARTMENT OF HIGHWAYS DIVISION

> HONOLULU, HAWAII

> > PLANS FOR

FURNISHING DELIVERING AND **EQUIPMENT** TRAFFIC SIGNAL

PROJECT NO. EHS-T-9001 (13) TOPICS FEDERAL- AID

FOR

INTERSECTION

ISLAND

VINEYARD BLVD. OAHU

KALANIANAOLE HWY. - KULIOUOU RD.


OAHU

FARRINGTON HWY. - LEOOLE ST. & LEOKU ST. OAHU LEGEND

STANDARD VEHICLE SIGNAL HEAD

PROGRAMMED VISIBILITY VEHICLE SIGNAL HEAD

PEDESTRIAN SIGNAL HEAD

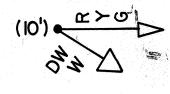

HEAD (S) AND BRACKET MOUNTED PEDESTRIAN SIGNAL HEAD (S)


TYPE II TRAFFIC SIGNAL MASTARM STANDARD

(TYPE II-A INDICATED) WITH 2. DISTANCE BETWEEN MASTARM MOUNTED HEHICLE


3. BRACKET MOUNTED VEHICLE AND PEDESTRIAN

TYPE G CABINET MOUNTED ON 4-FOOT TYPE I STANDARD - TYPE M CABINET MOUNTED ON CONCRETE

VEHICLE DETECTOR (LOOP INDICATED)

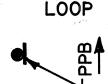

(ARROW ON SIGN TO LEFT, RIGHT OR BOTH)

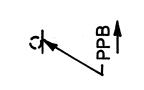

NO "AS-BUILT" CHANGES MADE



DEPARTMENT OF TRANSPORTATION FEDERAL HIGHWAY ADMINISTRATION 1.29.73

DEPARTMENT OF TRANSPORTATION STATE OF HAWAII APPROVED: