| INDEX TO DRAWINGS | |
|--|------------------------------|
| SHEET NO. | DESCRIPTION |
| | TITLE SHEET |
| 2 | TYPICAL SECTION AND |
| | MISC. ROADWAY DETAILS |
| 3 – 5 | DETAIL PLAN OF ROADWAY |
| 6-12 | DRAINAGE PLANS & DETAILS |
| 13-28 | TRAFFIC CONTROL DEVICES & |
| The state of the s | UTILITIES, PLANS AND DETAILS |
| | |
| | |
| , | |
| | |
| | |
| | A |
| | · |
| | |
| | |
STATE OF HAWAII

DEPARTMENT OF TRANSPORTATION HIGHWAYS DIVISION

HONOLULU, HAWAII

AS BUILT

PLANS FOR

CONSTRUCTION OF


KALANIANAOLE HIGHWAY


Intersection Improvements At (East)Halemaumau Street Project No. 72C-01-74

AND

Drainage Improvements From (East) Halemaumau Street To Paiko Drive Project No. 72C-02-72

DISTRICT OF HONOLULU ISLAND OF OAHU

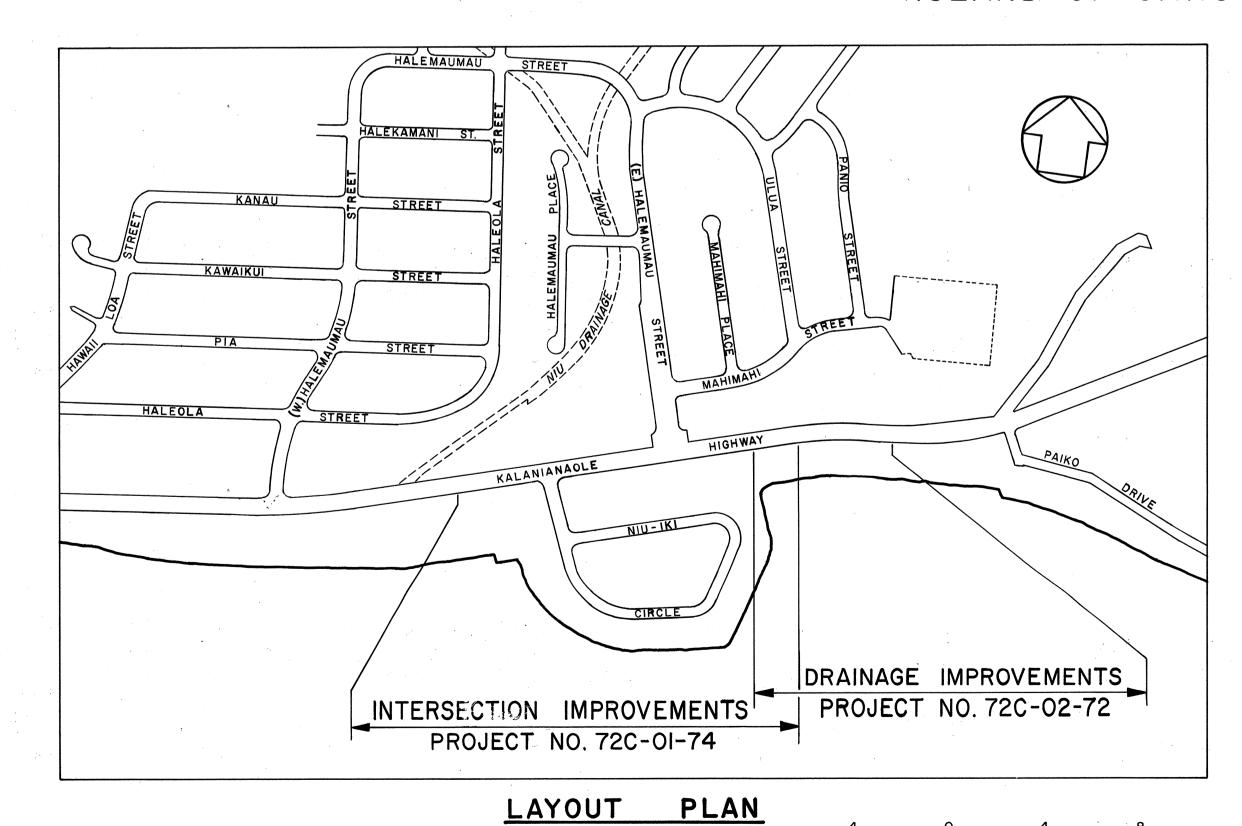

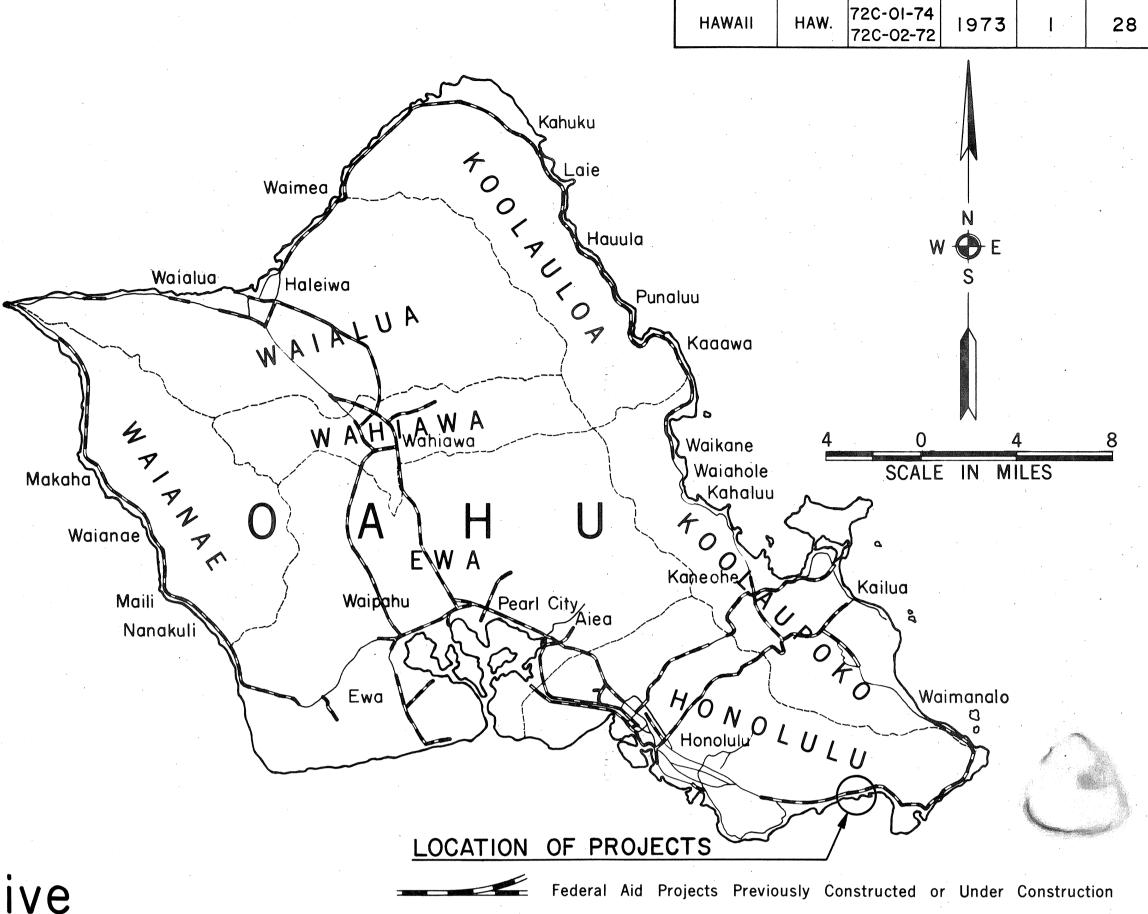

ALL CHANGES MADE DURING CONSTRUCTION HAVE BEEN INCORPORATED ON THESE PLANS IN RED, EXCEPT CHANGES IN THE ORIGINAL THEORETICAL QUANTITIES. FOR ACTUAL QUANTITIES, REFER TO PROJECT LEDGER AND/OR COMPUTATION BOOK.

STATE PROJ. NO. YEAR NO. SHEETS

Ralph T. Horie 2/12/75
PROJECT ENGINEER DATE



DEPARTMENT OF TRANSPORTATION STATE OF HAWAII

APPROVED:

4/2/74 DATE