




DIST. NO.	STATE	PROJ. NO.	FISCAL YEAR	SHEET NO.	TOTAL SHEETS
HAWAII	HAW.	72C-01-74	1973	2	28

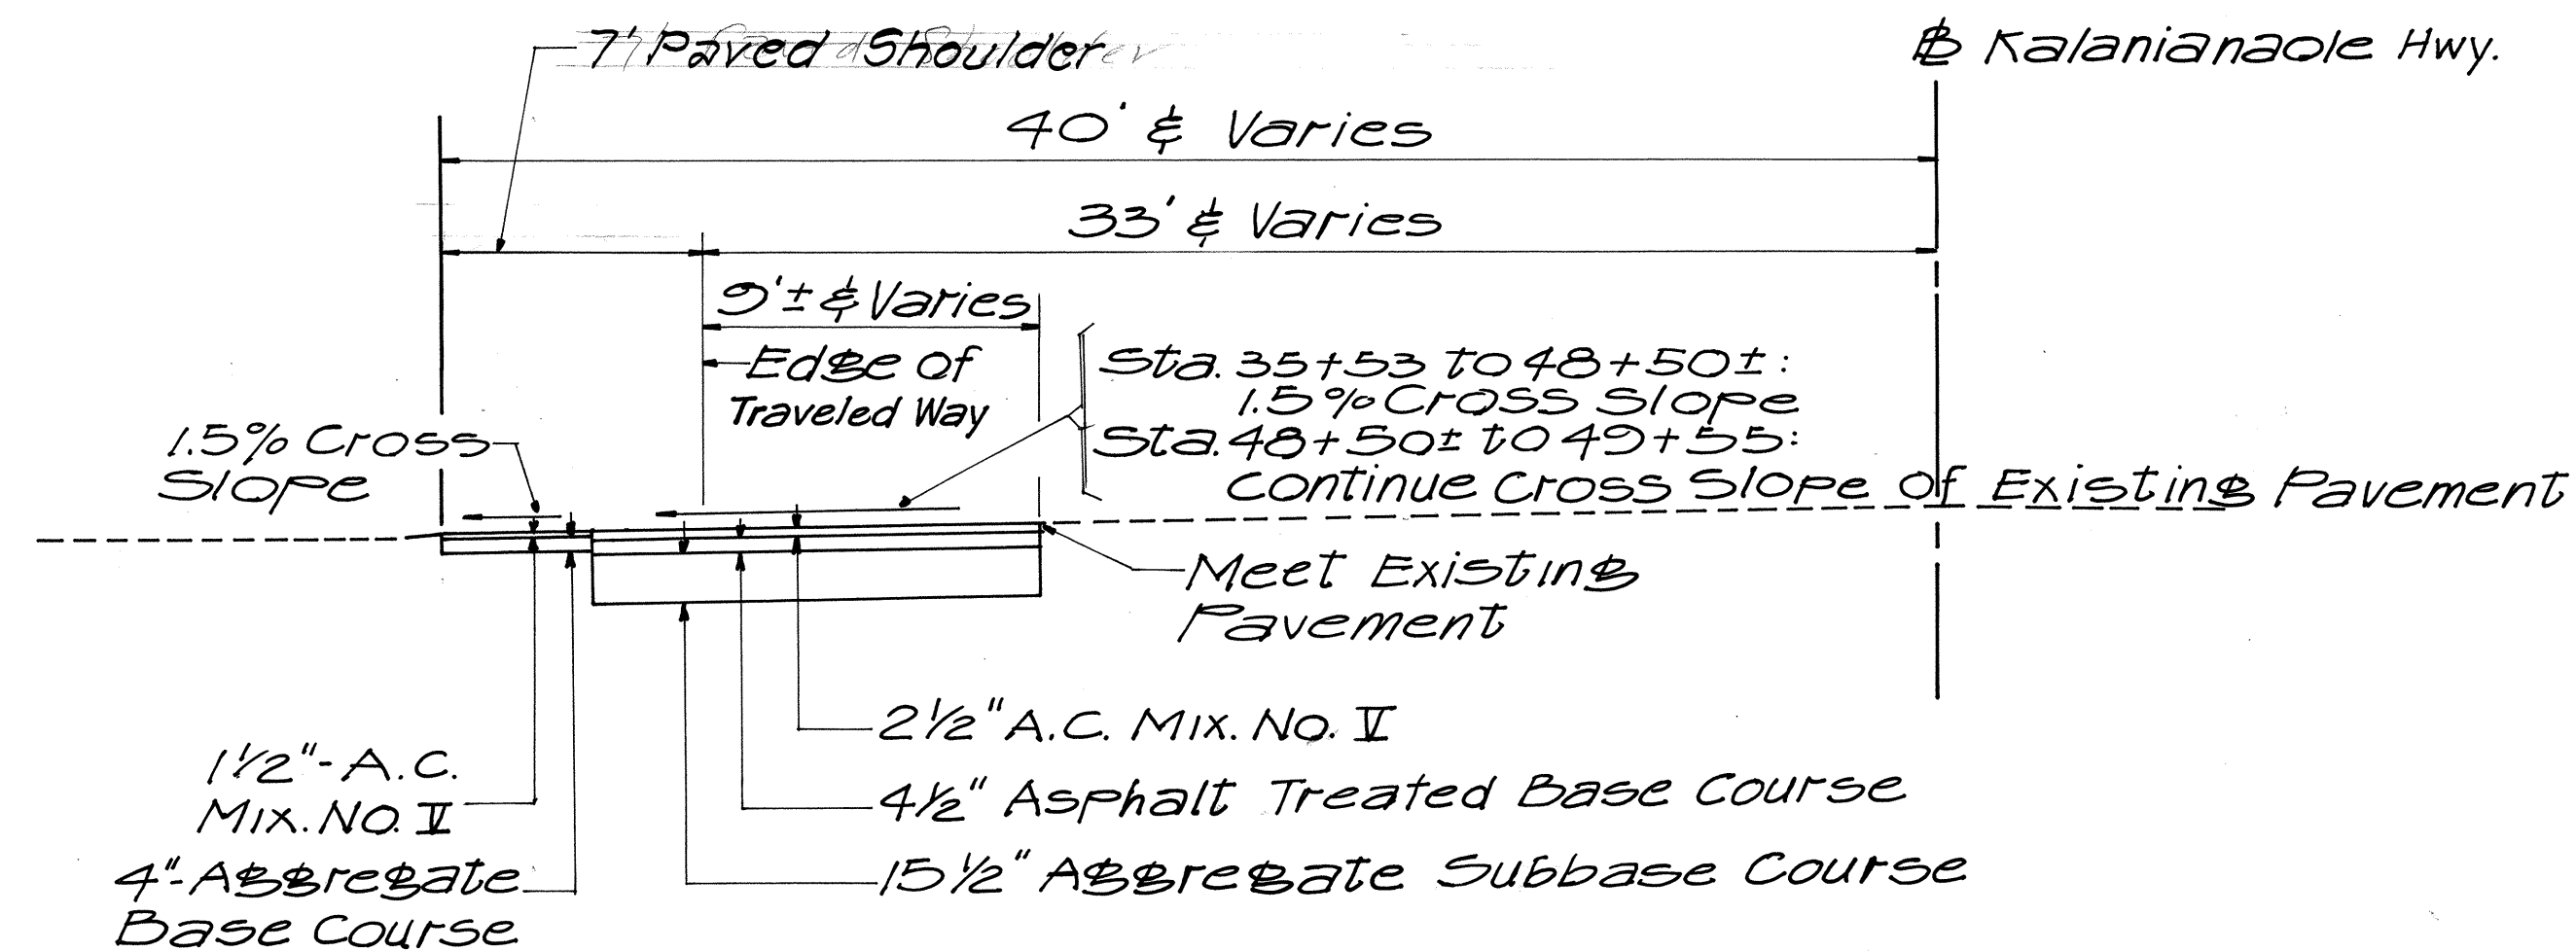


TYPICAL SECTION
Scale: 1" = 5'

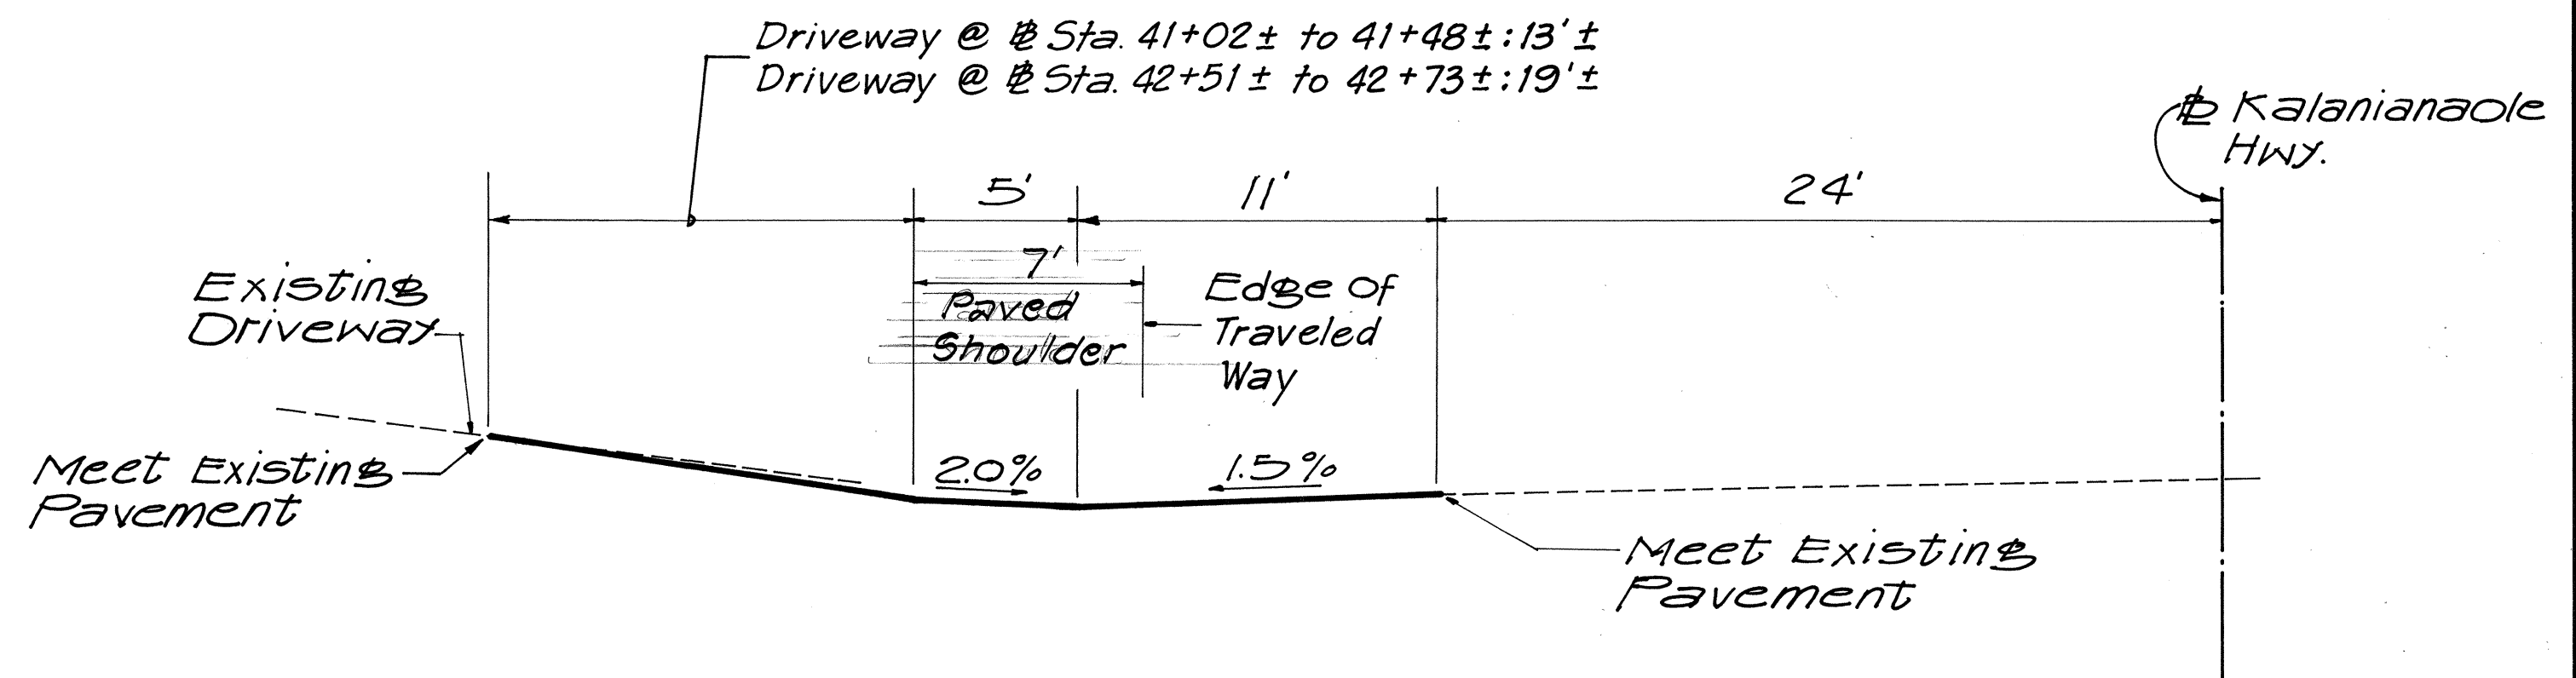


**PROFILE - DRIVEWAY @ STA. 41+02± TO STA. 41+48±
& DRIVEWAY @ STA. 42+51± TO STA. 42+73±**
Scales: Horiz. 1" = 5'
Vert. 1" = 2.5'

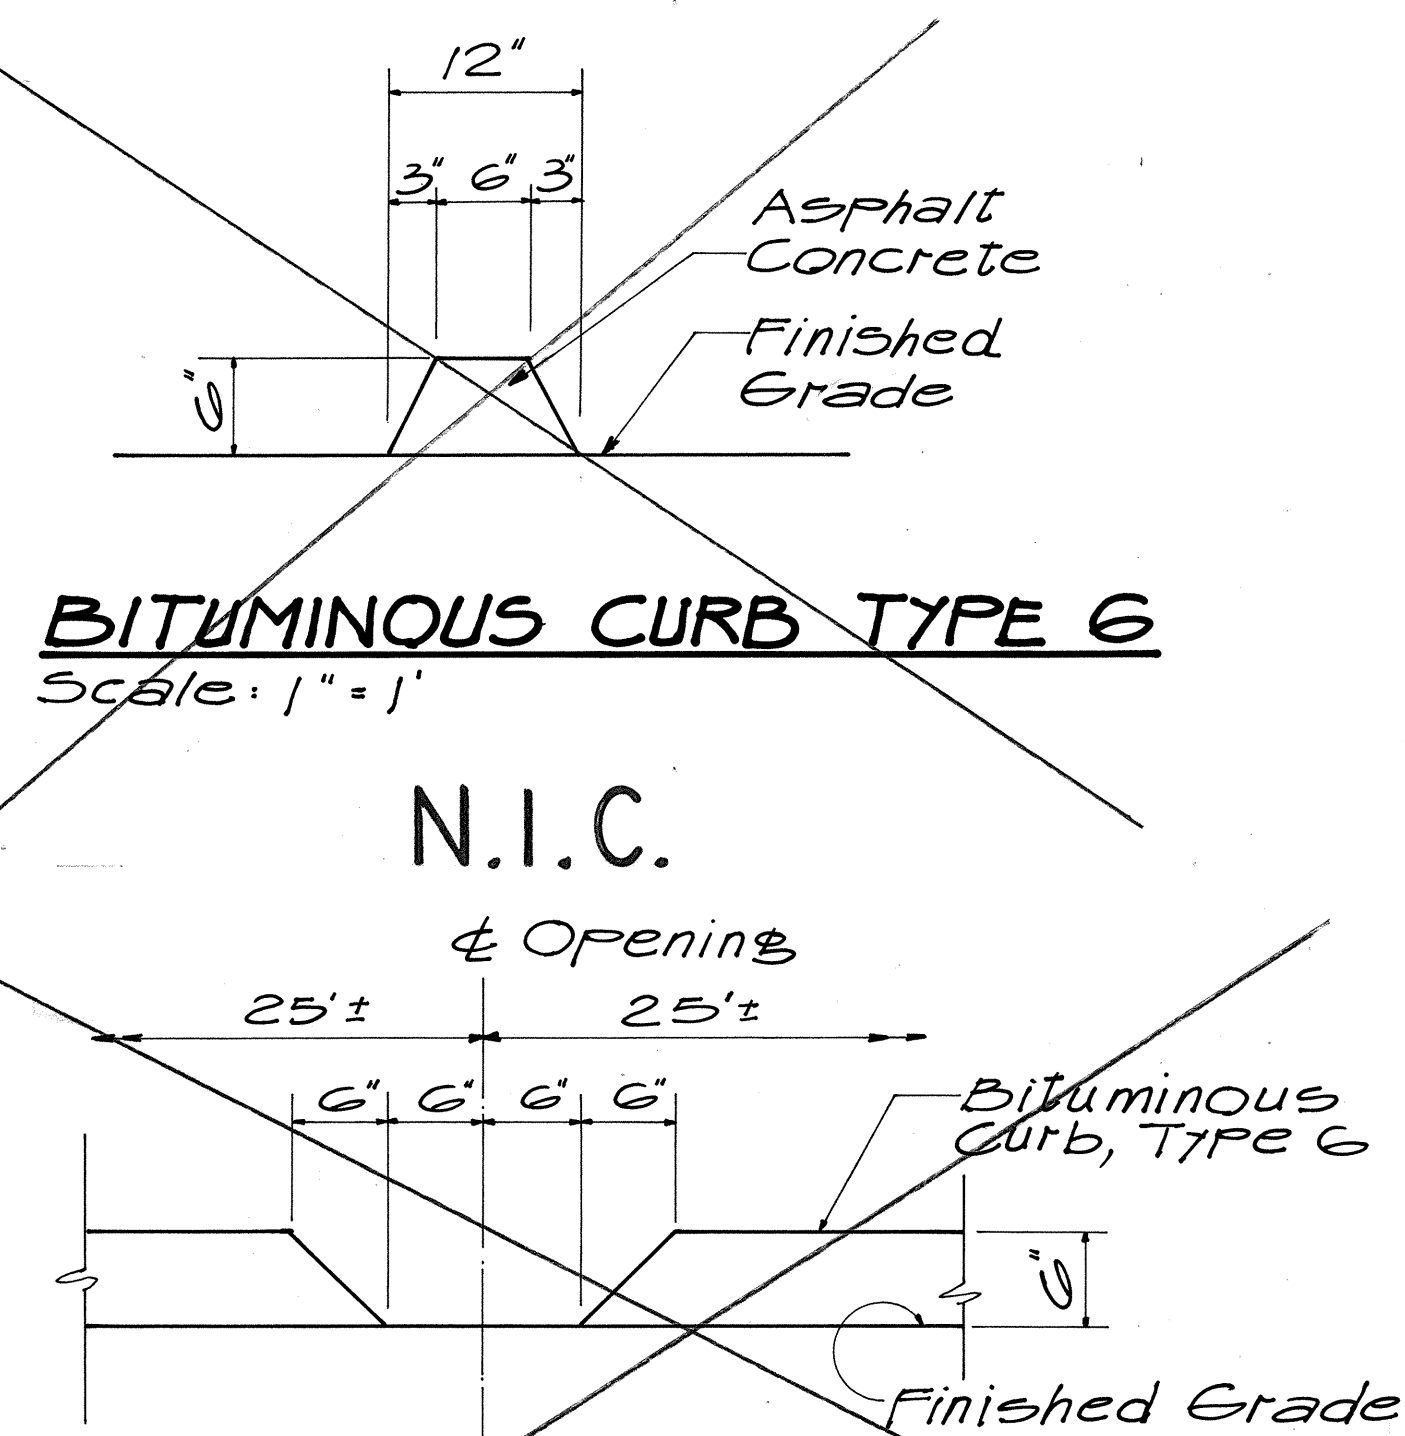


BITUMINOUS CURB TYPE 6
Scale: 1" = 1'

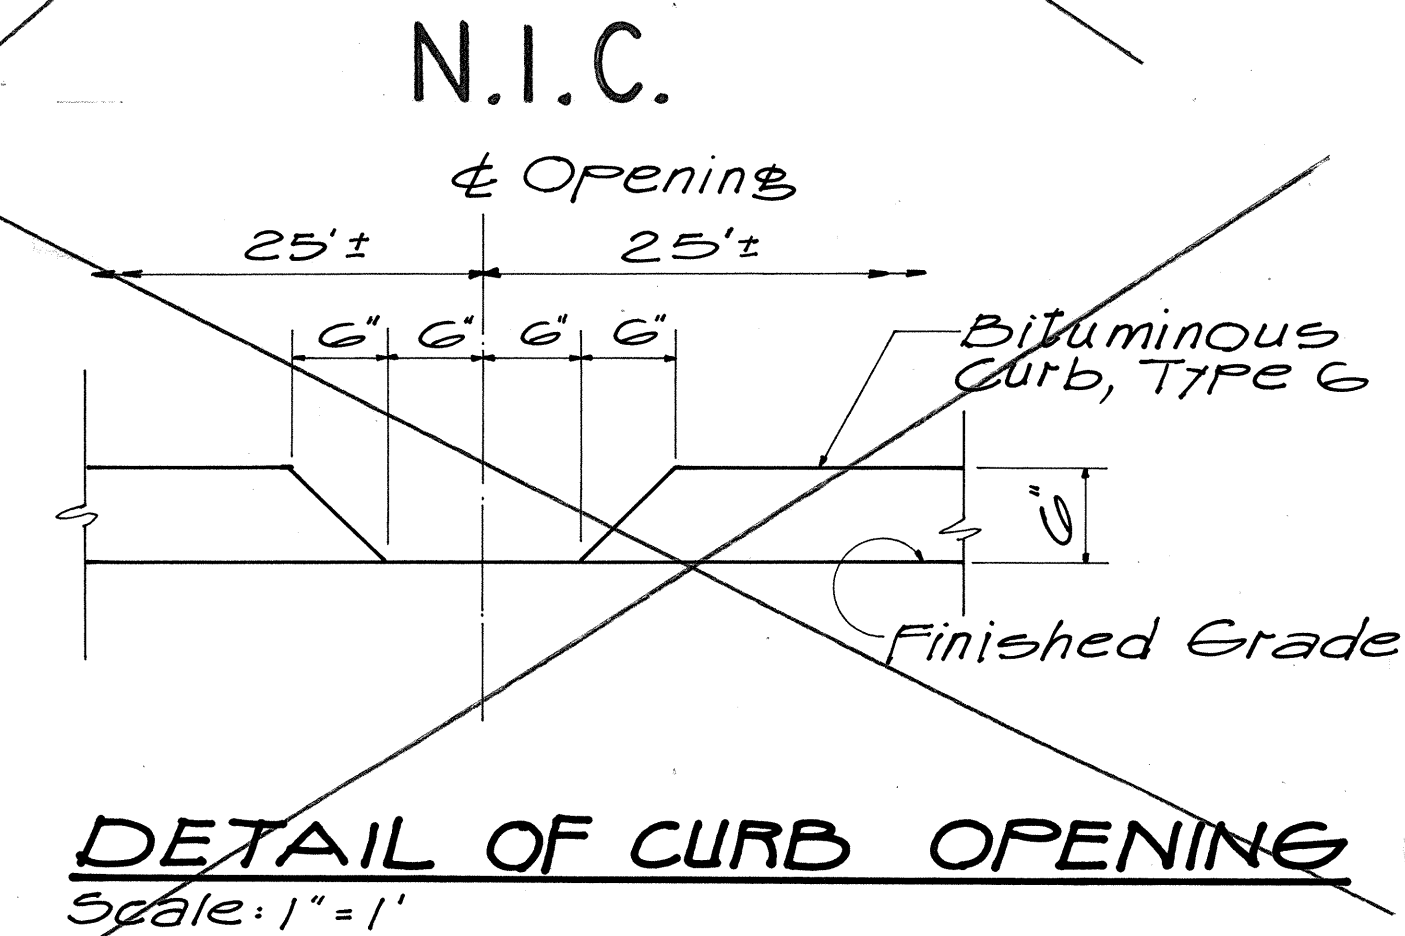


DETAIL OF CURB OPENING
Scale: 1" = 1'

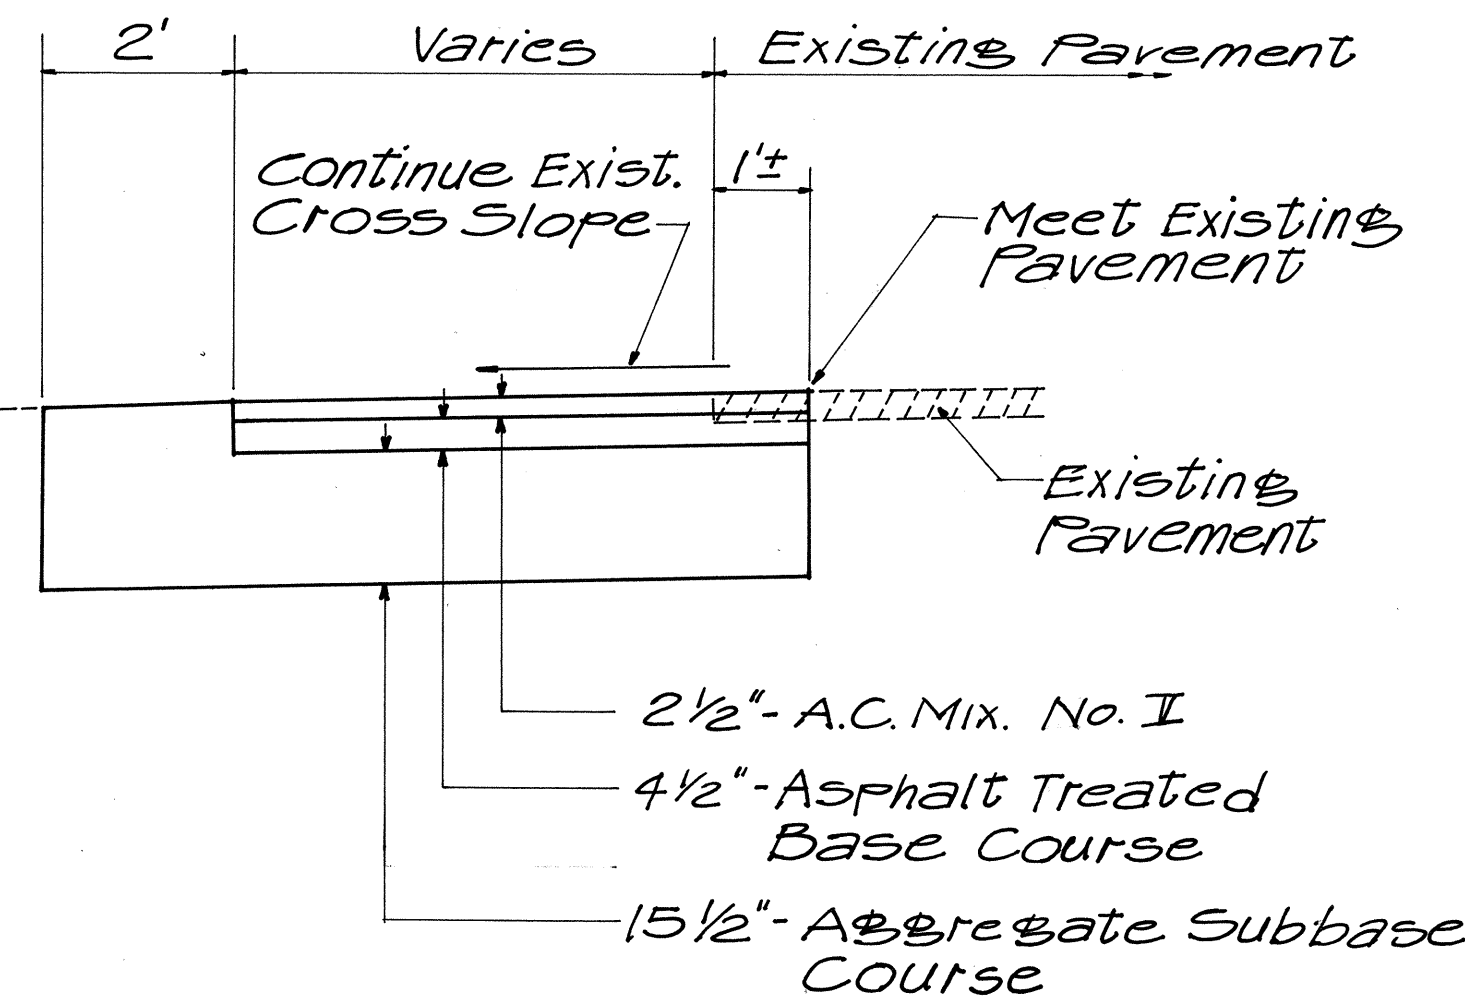


DETAIL A
Scale: 1" = 2'

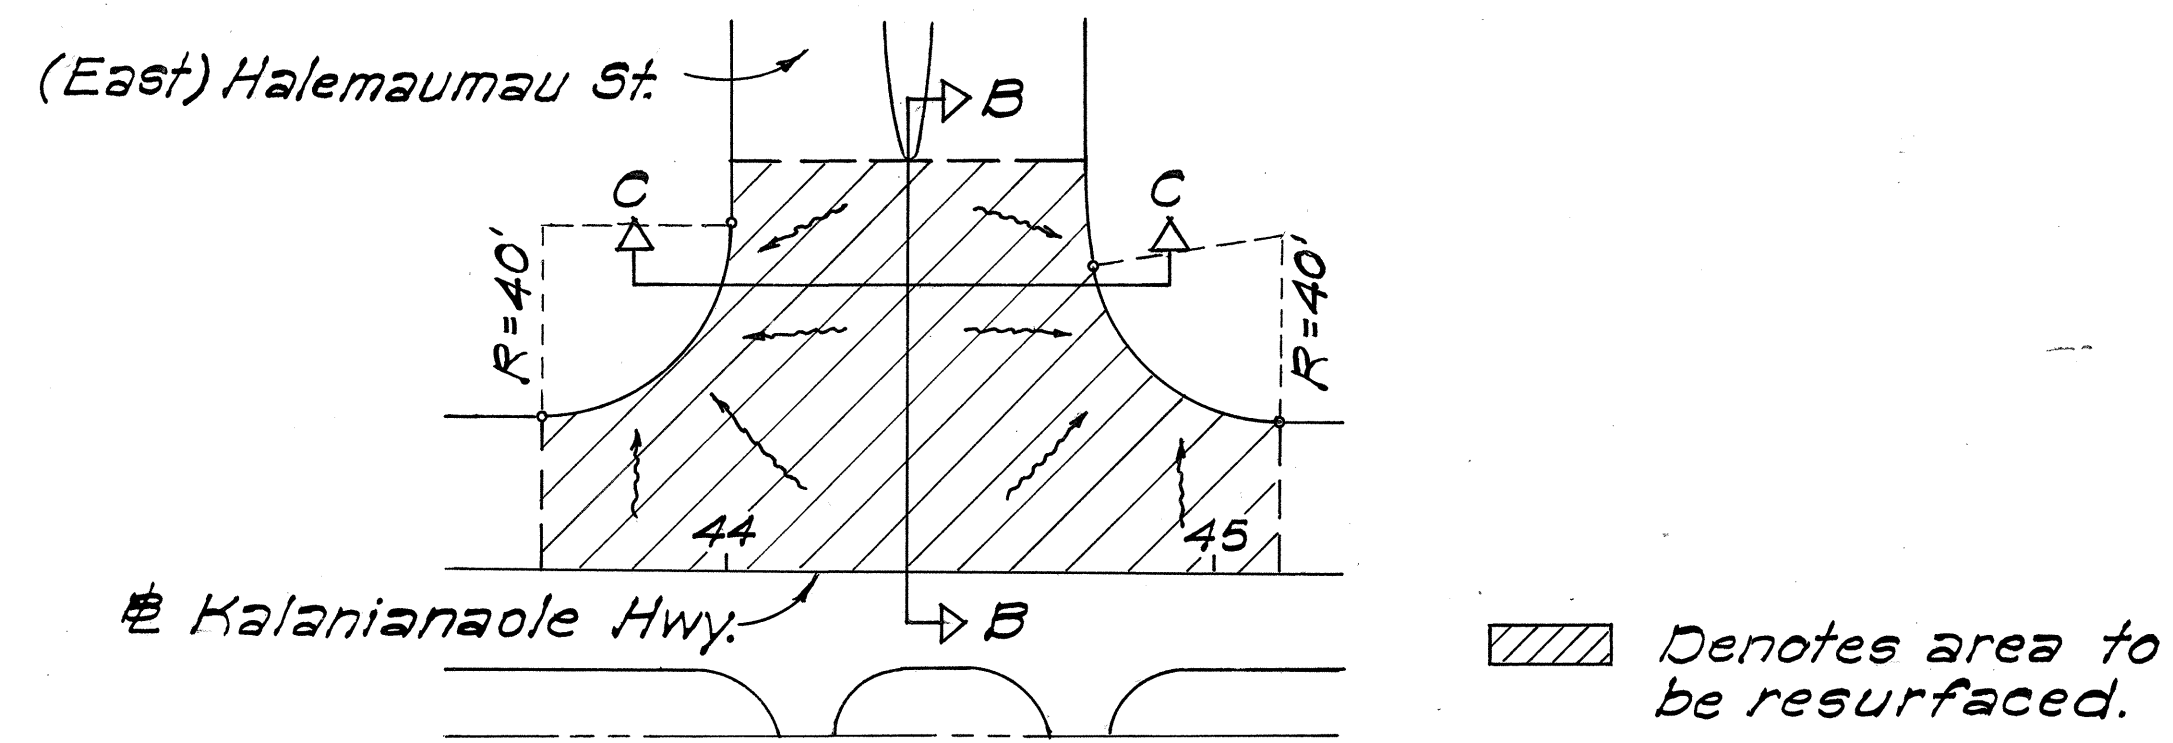


PLAN
MIX I RESURFACING AT INTERSECTION
Scale: 1" = 40'

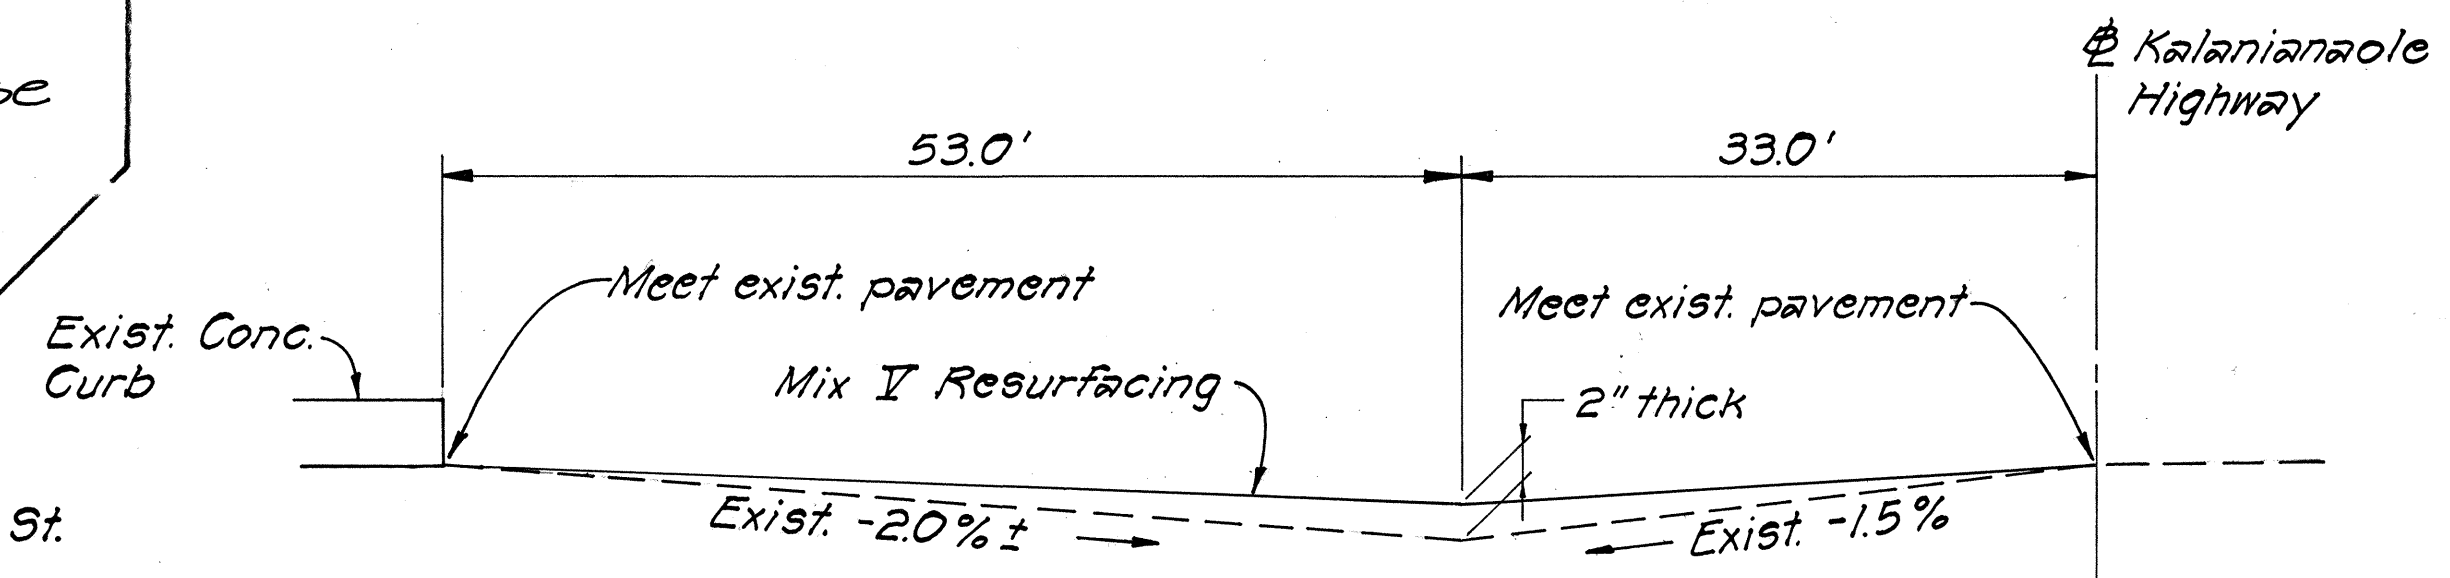

SECTION B-B
Not to Scale

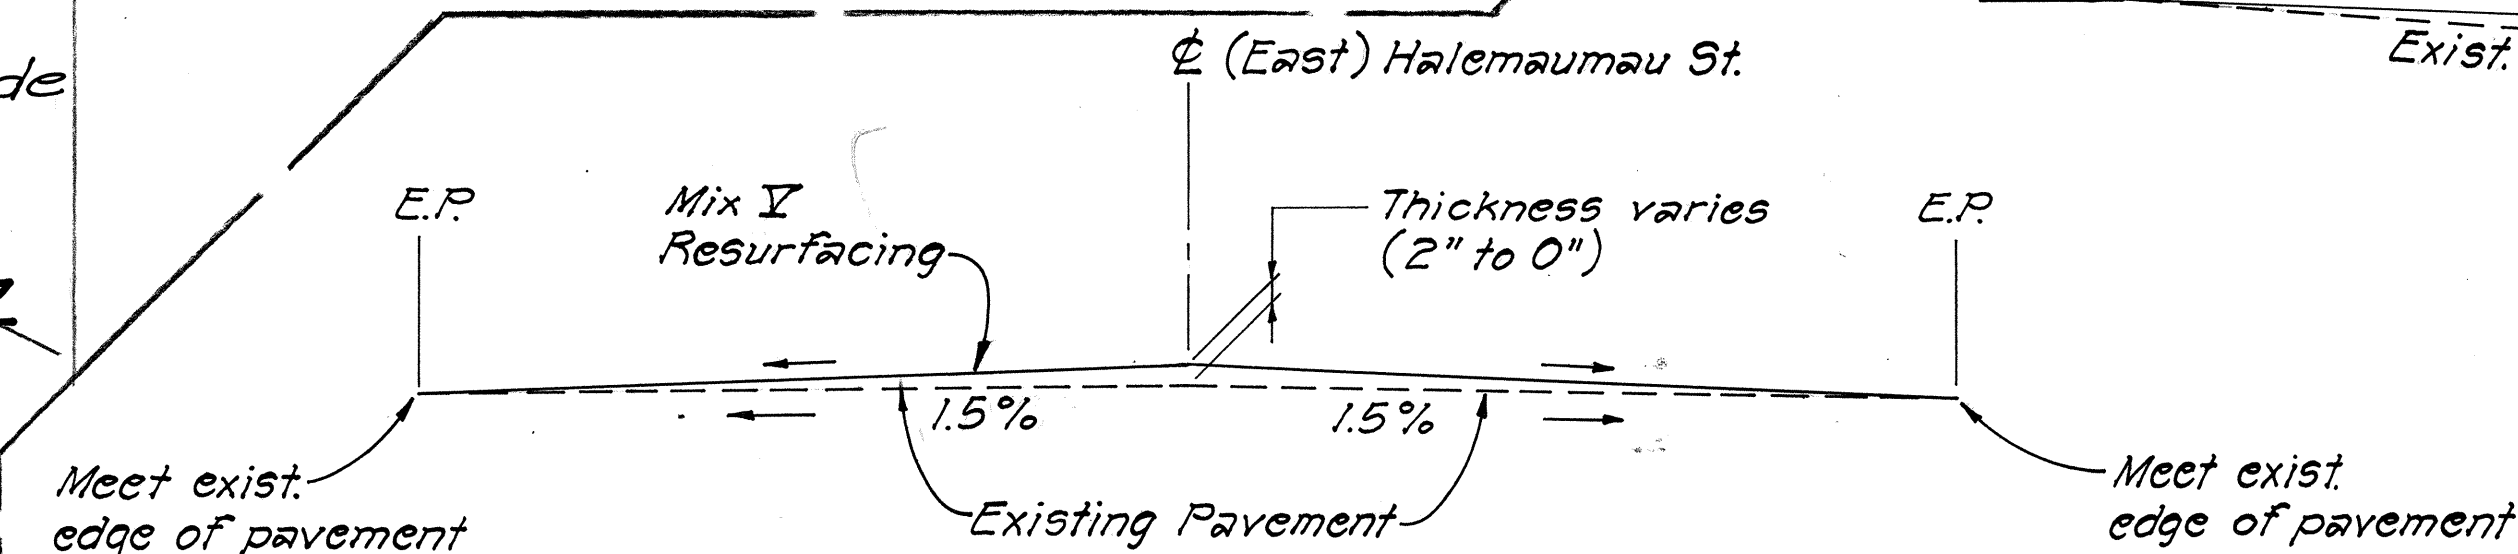

SECTION C-C
Not to Scale

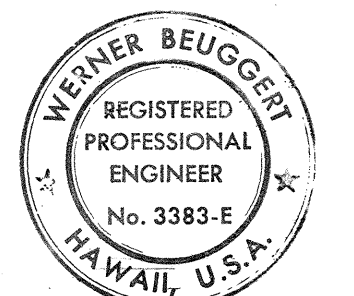

THIS WORK WAS PREPARED BY
ME OR UNDER MY SUPERVISION.
Werner Beuggert

STATE OF HAWAII DEPARTMENT OF TRANSPORTATION HIGHWAYS DIVISION	
TYPICAL SECTION 8 MISC. ROADWAY DETAILS	
KALANIANA'OLE HIGHWAY Intersection Improvements At (E.) Halemaumau St. Proj. No. 72C-01-74	
Scale: As Shown	Oct. 1973
SHEET No. 1 OF 1 SHEETS	

5/13/74	Deletion of Bituminous Curb Type 6 and 6" white pavement striping.
DATE	REVISION