



STATE OF HAWAII

DEPARTMENT OF TRANSPORTATION HIGHWAYS DIVISION

HONOLULU, HAWAII

"AS-BUILT"

PLANS FOR

INSTALLATION OF TRAFFIC SIGNALS AT THREE INTERSECTIONS


KALANIANAOLE HWY. AT KALANIIKI ST.

KALANIANAOLE HWY. AT LAUKAHI ST.

KALANIANAOLE HWY. AT WEST HALEMAUMAU ST.


FEDERAL AID PROJECT NO. U-072-1(26)

DISTRICT OF HONOLULU ISLAND OF OAHU

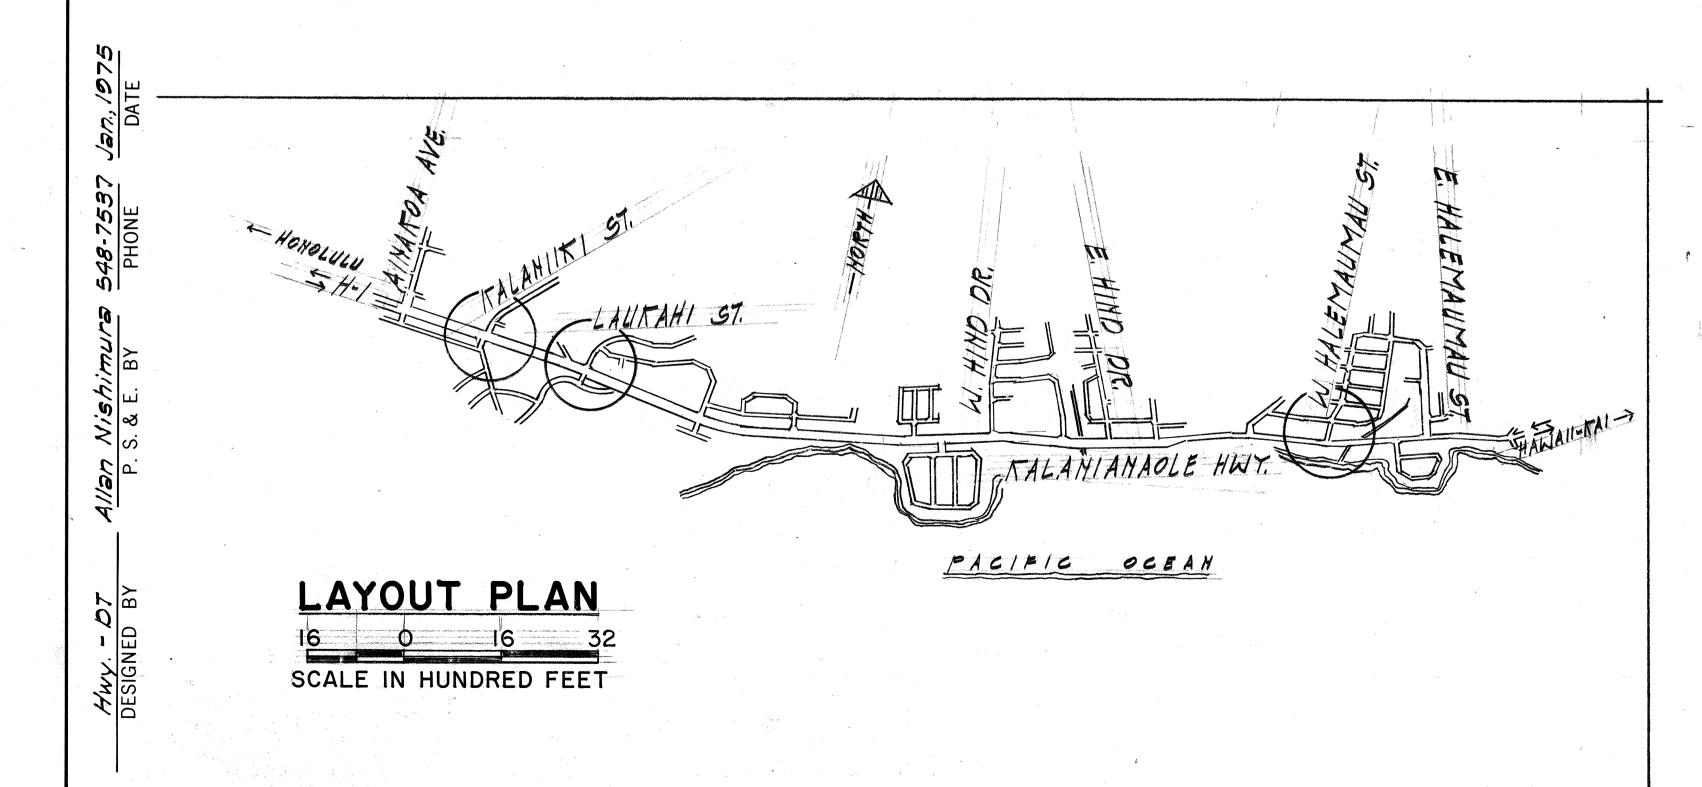



WHEREVER THE PROJECT NO. 72C-02-74
APPEARS IN THESE PLANS, IT SHALL BE
AMENDED TO READ "FEDERAL AID PROJECT
NO. ##=072-1(26)".
U-T-072-1(26)."

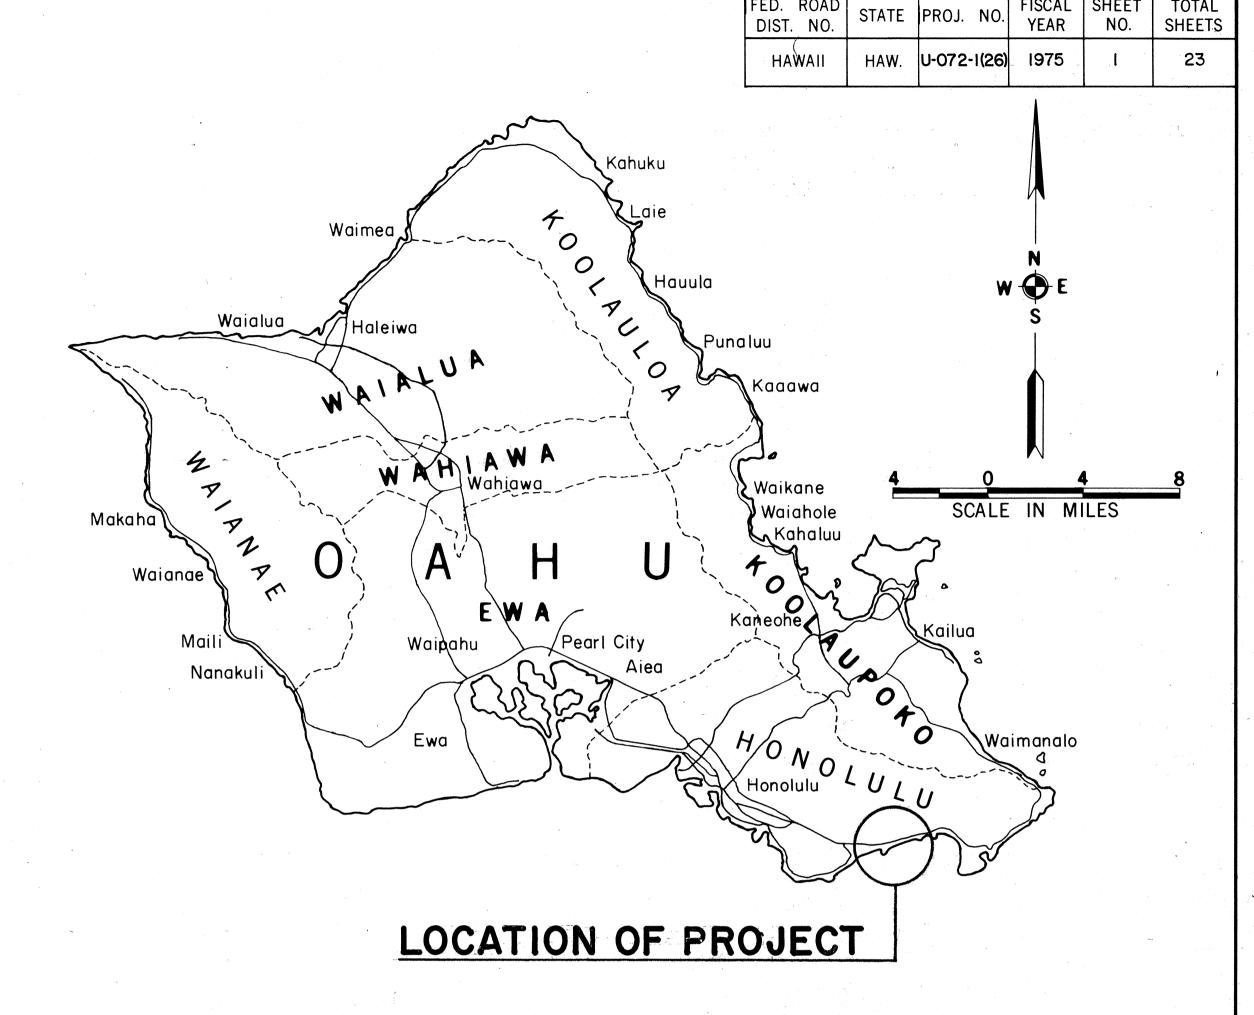

ALL CHANGES MADE DURING CONSTRUCTION HAVE BEEN INCORPORATED ON THESE PLANS IN RED, EXCEPT CHANGES IN THE ORIGINAL THEORETICAL QUANTITIES. FOR ACTUAL QUANTITIES, REFER TO PROJECT LEDGER AND/OR COMPUTATION BOOK.

Phillet J. Alexand 3/10/18
Project Engineer Date

DESIGN	CLASSIFICATION
ADT (1975)	47,800
ADT (1995)	104,000
DHV	
)	
<u>T</u>	
T ₂₄	1 1/2%
V	50 MPH

DEPARTMENT OF TRANSPORTATION FEDERAL HIGHWAY ADMINISTRATION APPROVED:

ISION ENGINEER

4.2.15 DATE

DEPARTMENT OF TRANSPORTATION
STATE OF HAWAII

APPROVED:

C. Olwey Warned 2/13/25

DIR. OF TRANSPORTATION DATE