

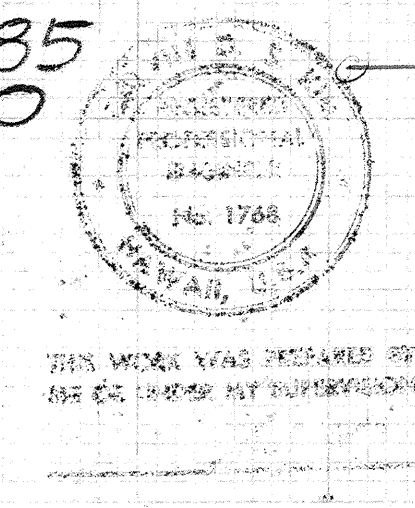
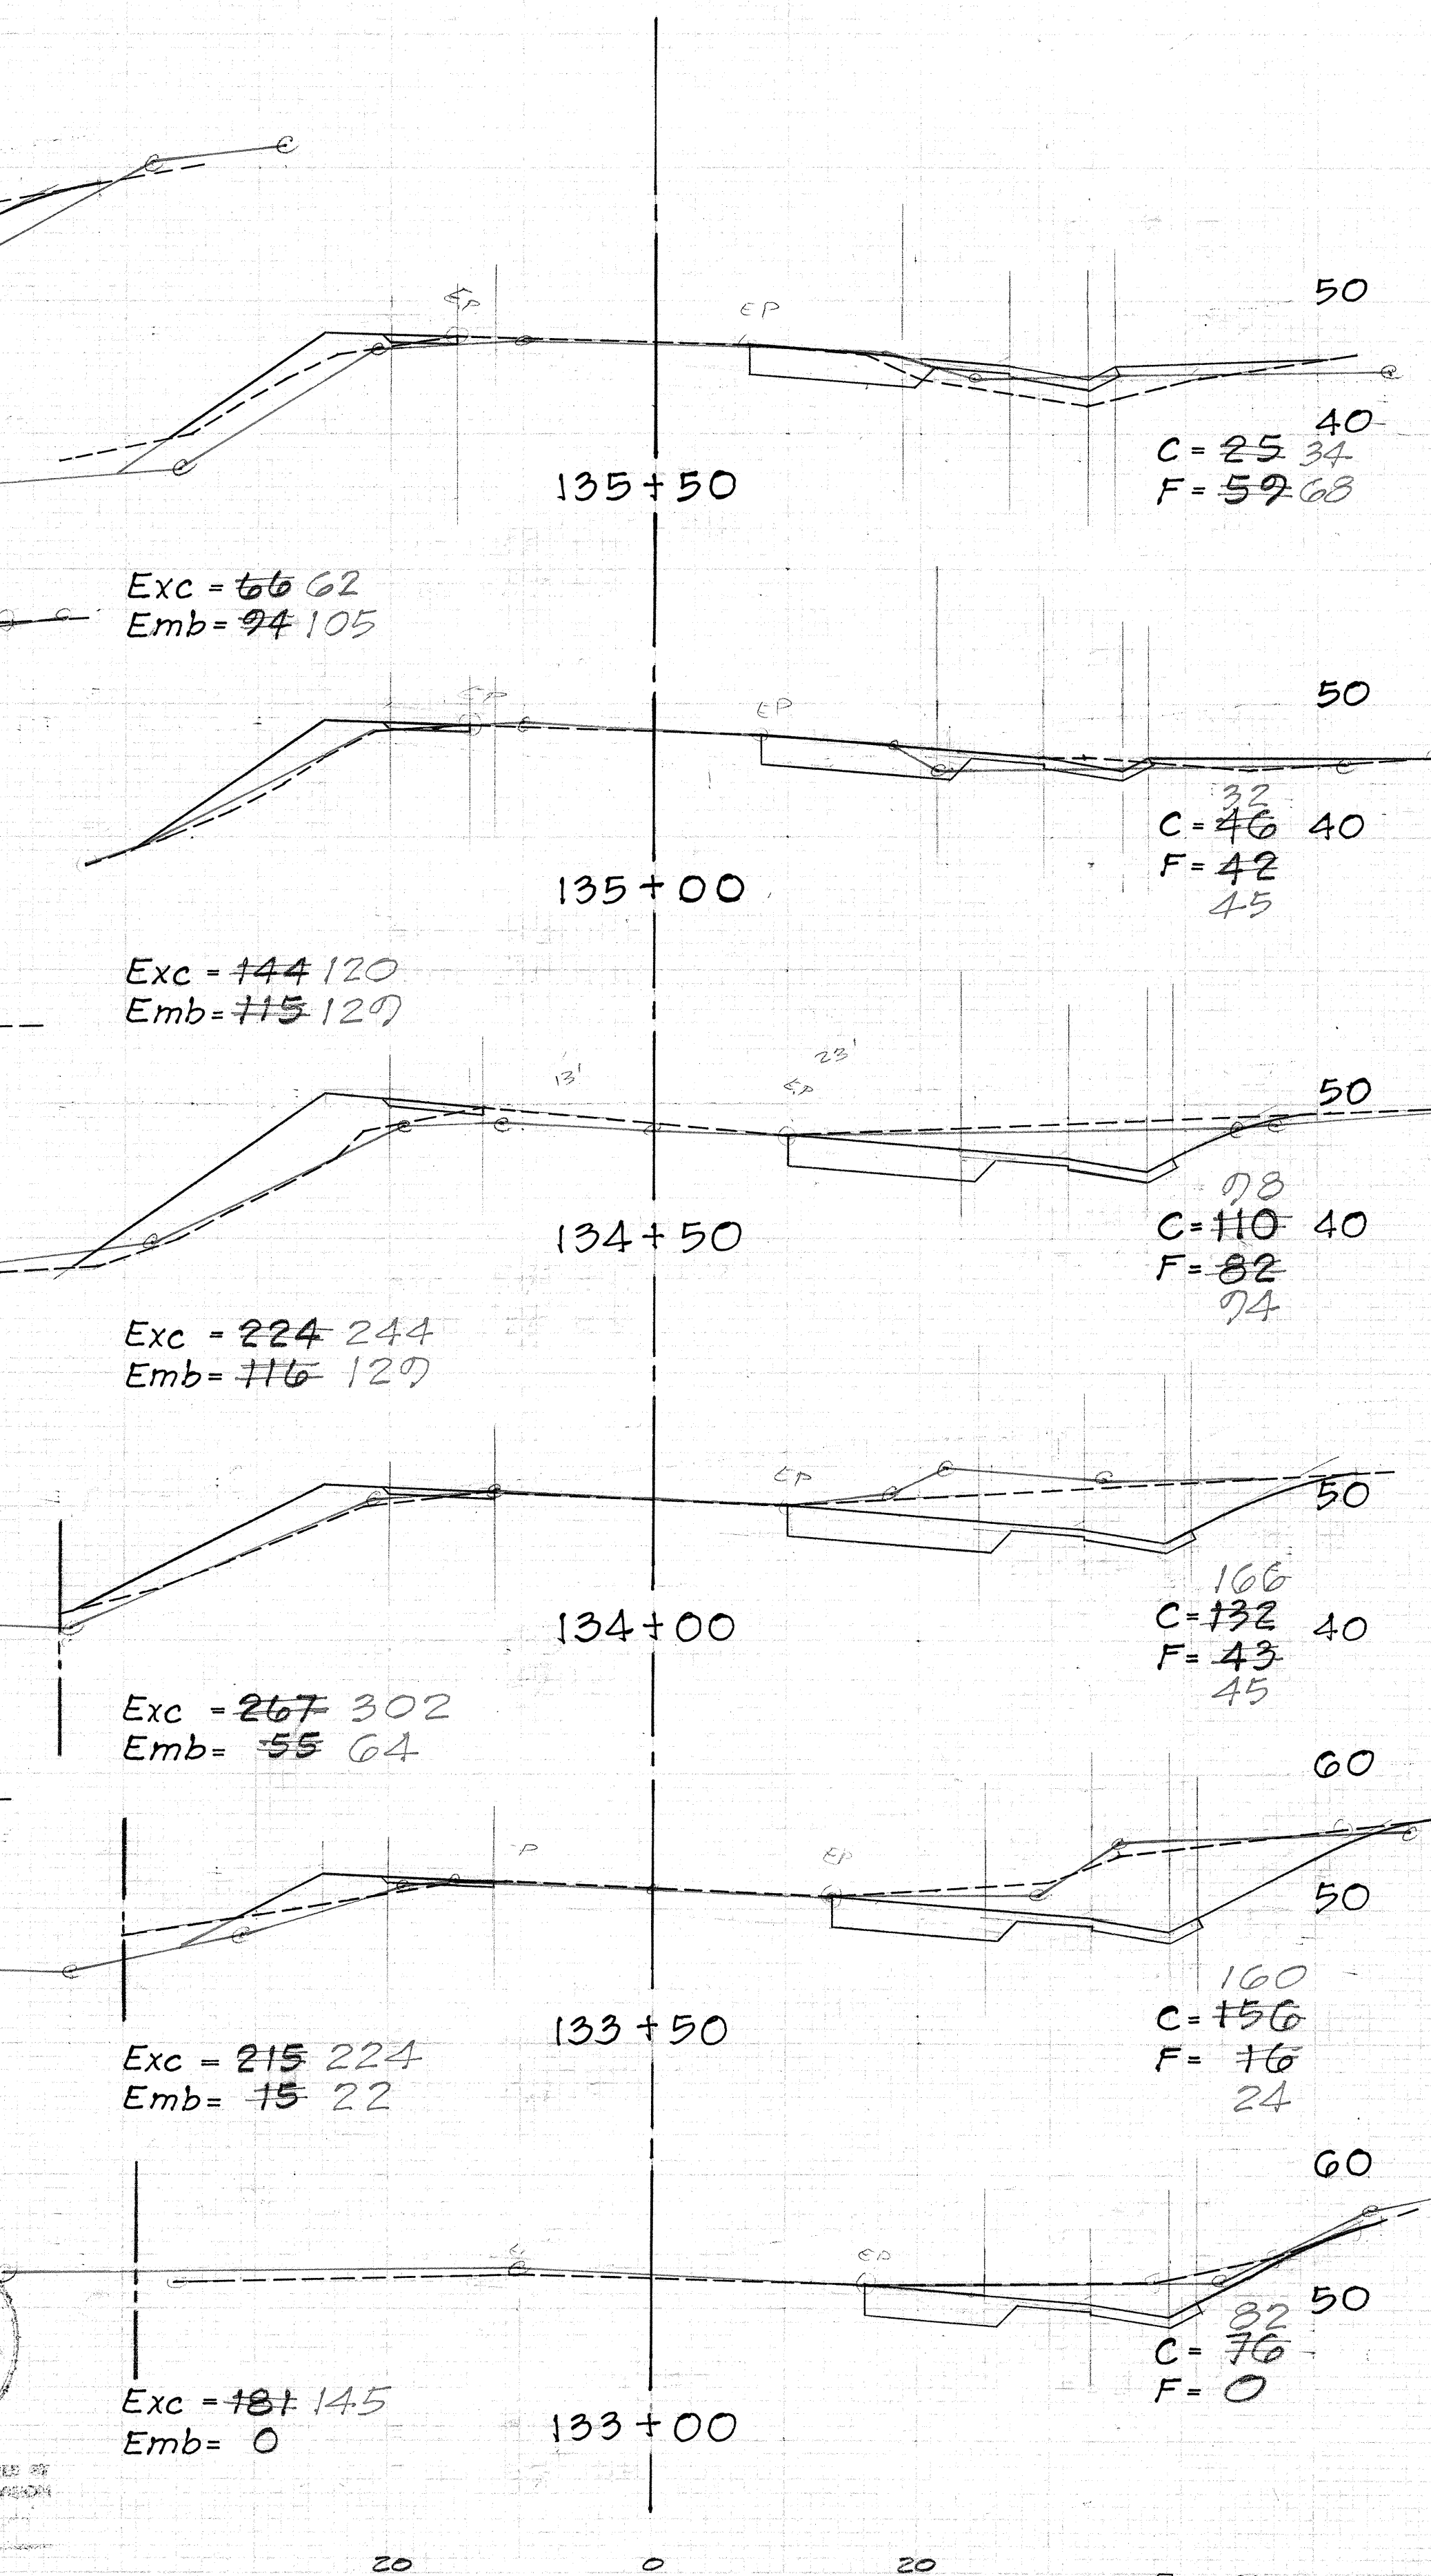


| FED. ROAD DIST. NO. | STATE | PROJ. NO. | FISCAL YEAR | SHEET NO. | TOTAL SHEETS |
|---------------------|-------|-----------|-------------|-----------|--------------|
| HAWAII              | HAW.  | 72A-01-71 | 1975        | 40        | 42           |


FINAL SURVEY  
REVISIONS  
DATE  
BY  
CHECKED  
DATE  
BY

GENERAL NOTES  
1. ALL ELEVATIONS ARE IN FEET  
2. ALL DISTANCES ARE IN FEET  
3. ALL ANGLES ARE IN DEGREES  
4. ALL CURVES ARE IN FEET  
5. ALL GRADES ARE IN PERCENT

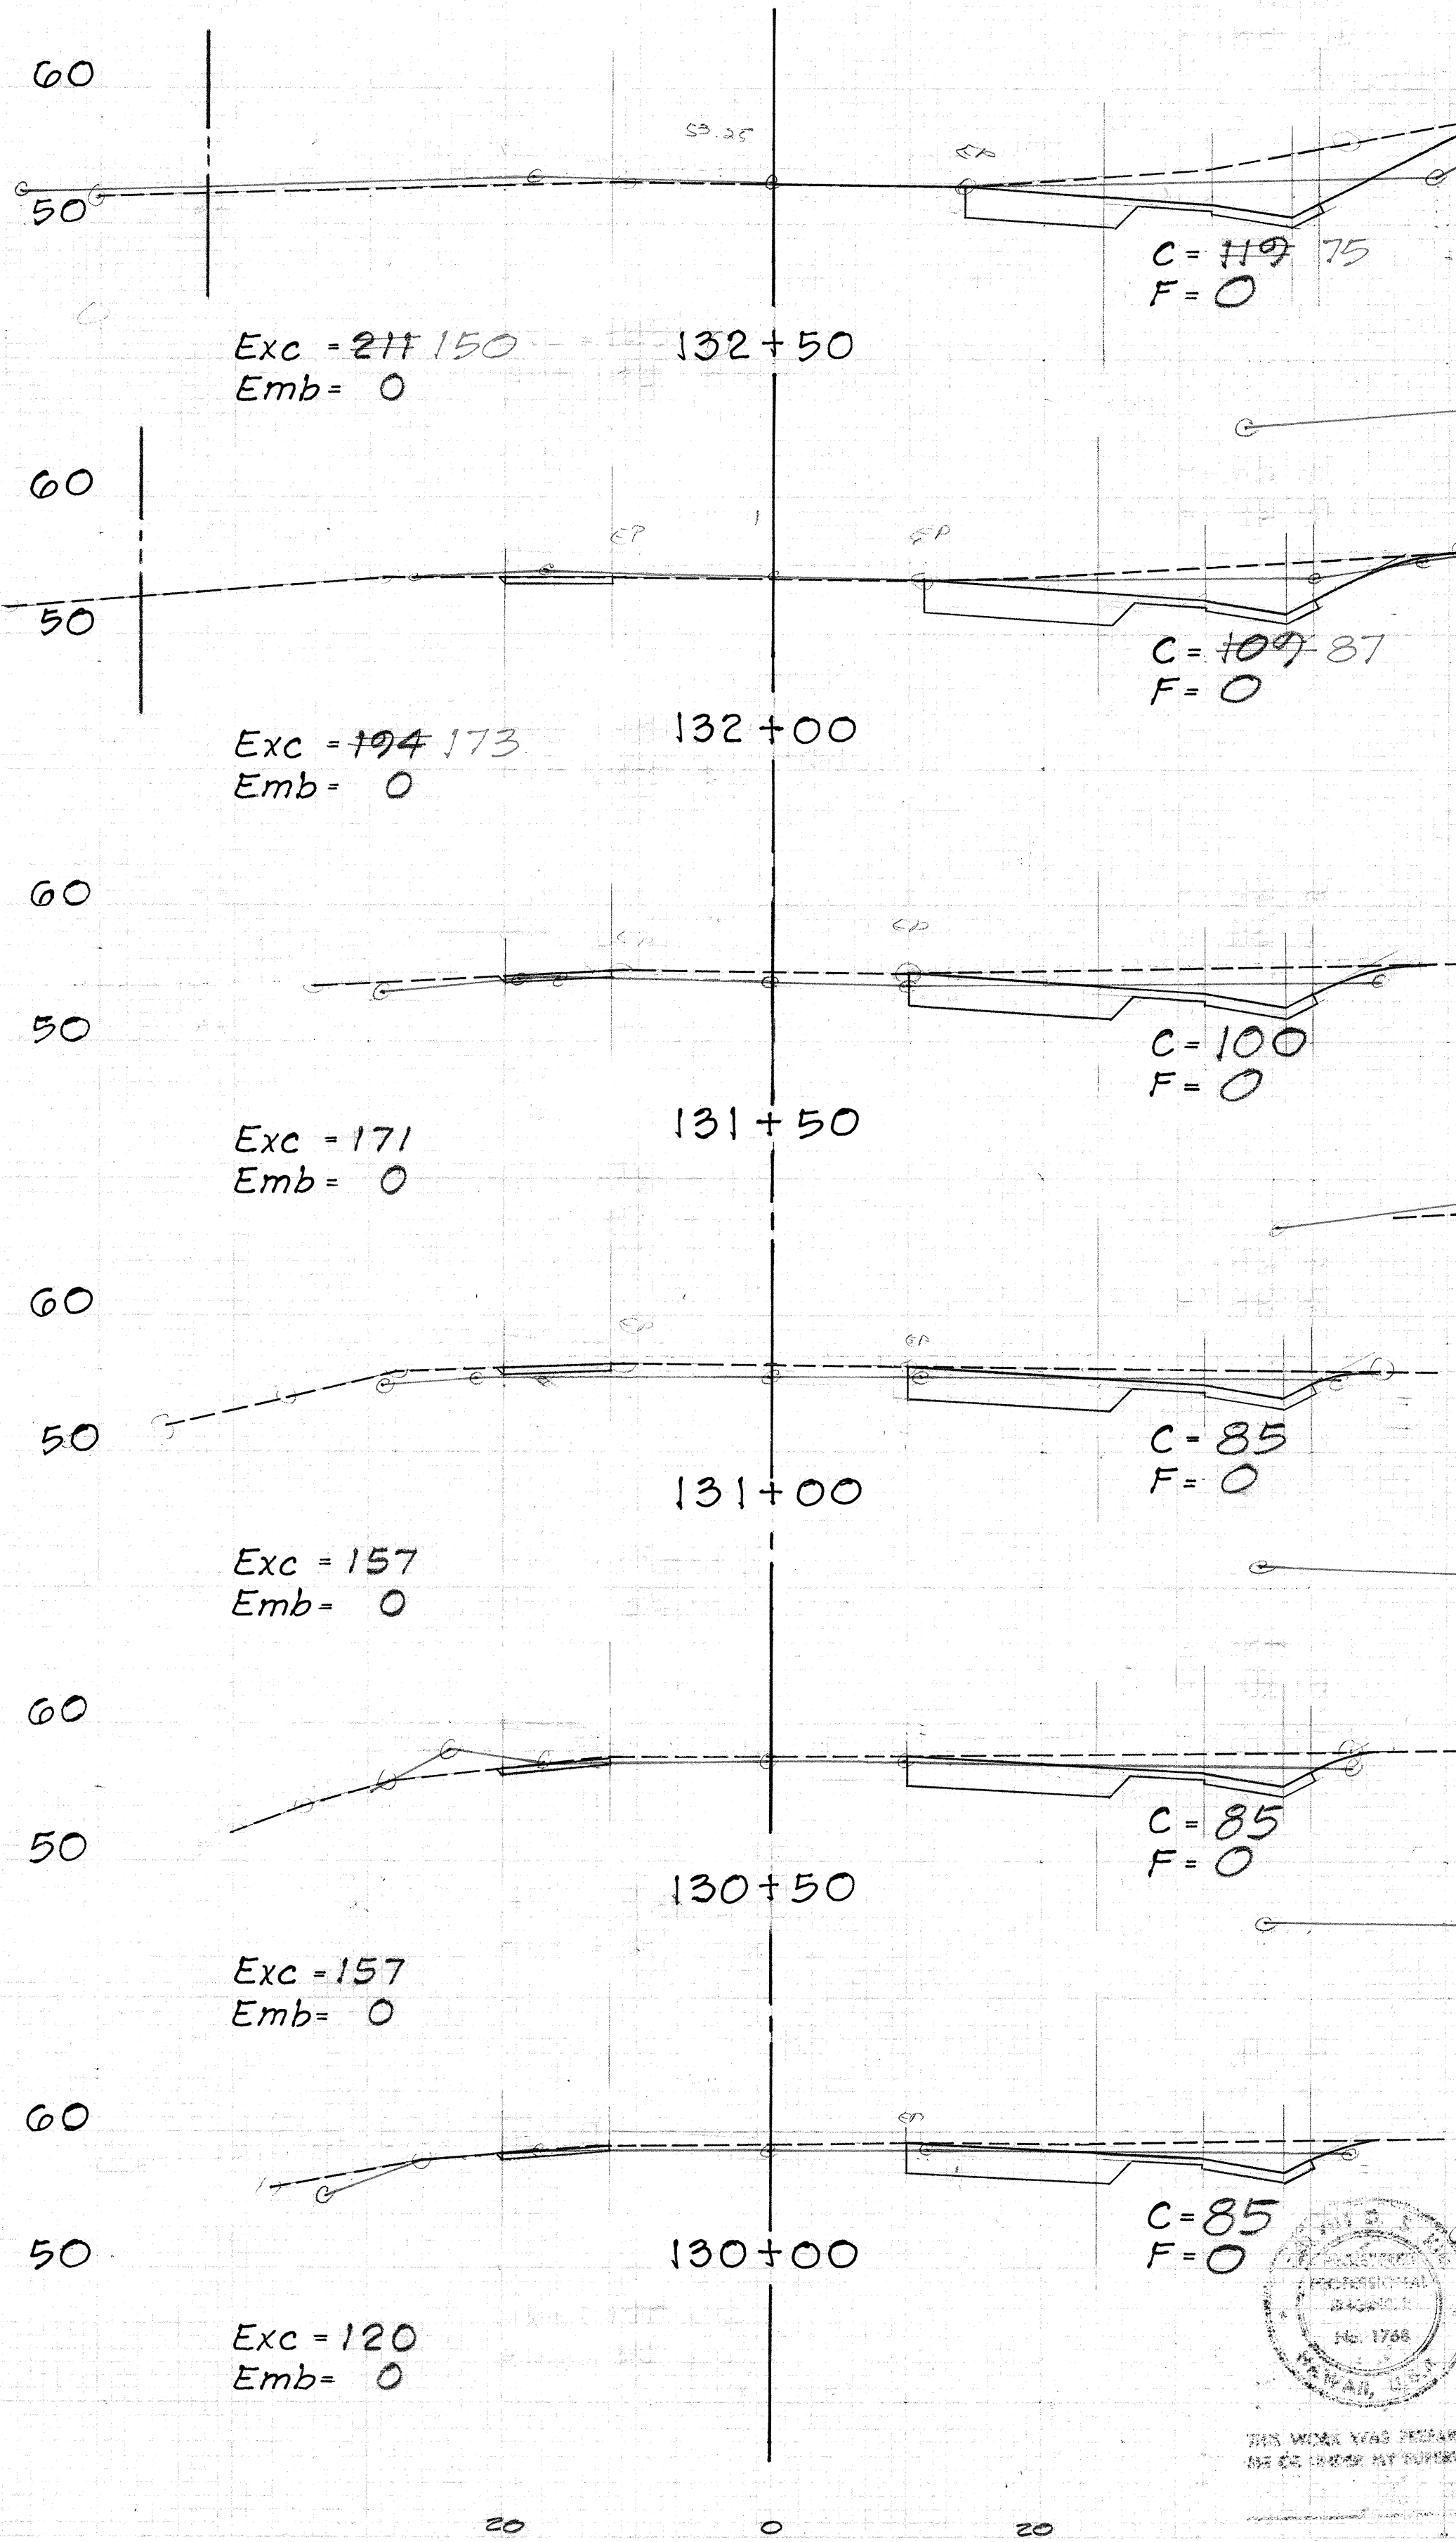

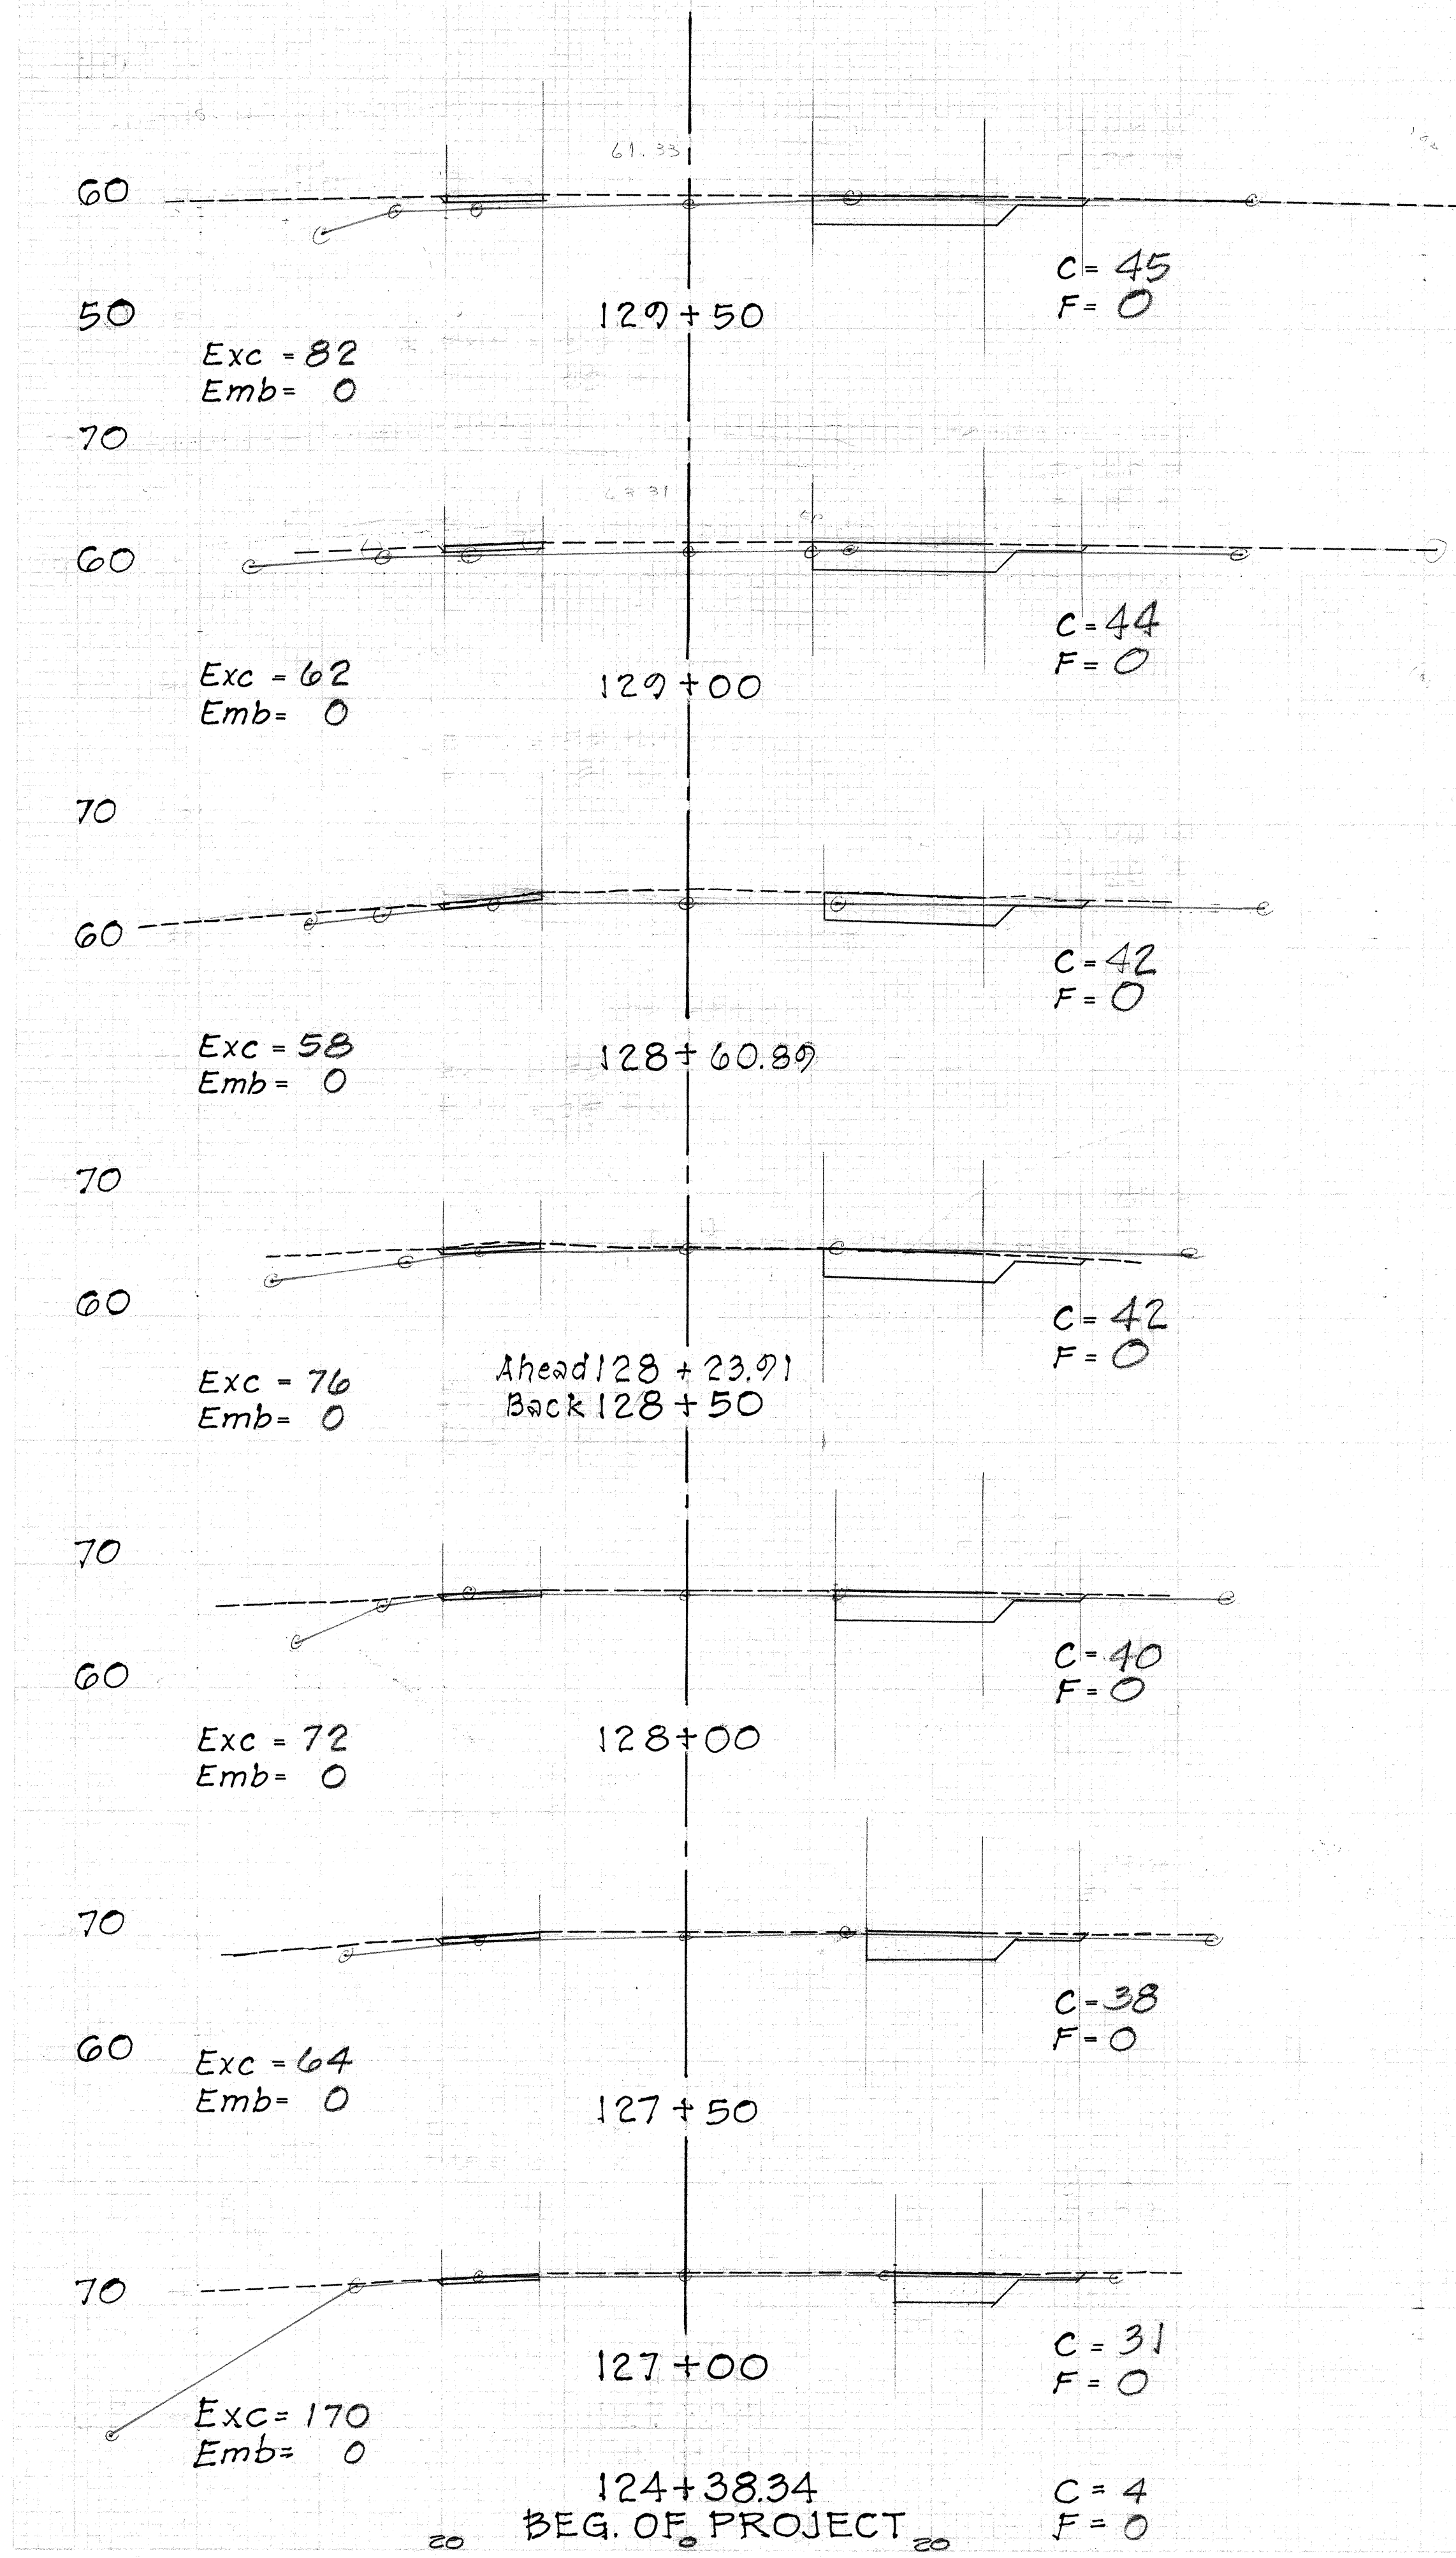

| FED. ROAD DIST. NO. | STATE | PROJ. NO. | FISCAL YEAR | SHEET NO. | TOTAL SHEETS |
|---------------------|-------|-----------|-------------|-----------|--------------|
| HAWAII              | HAW.  | 72A-01-71 | 1975        | 41        | 42           |

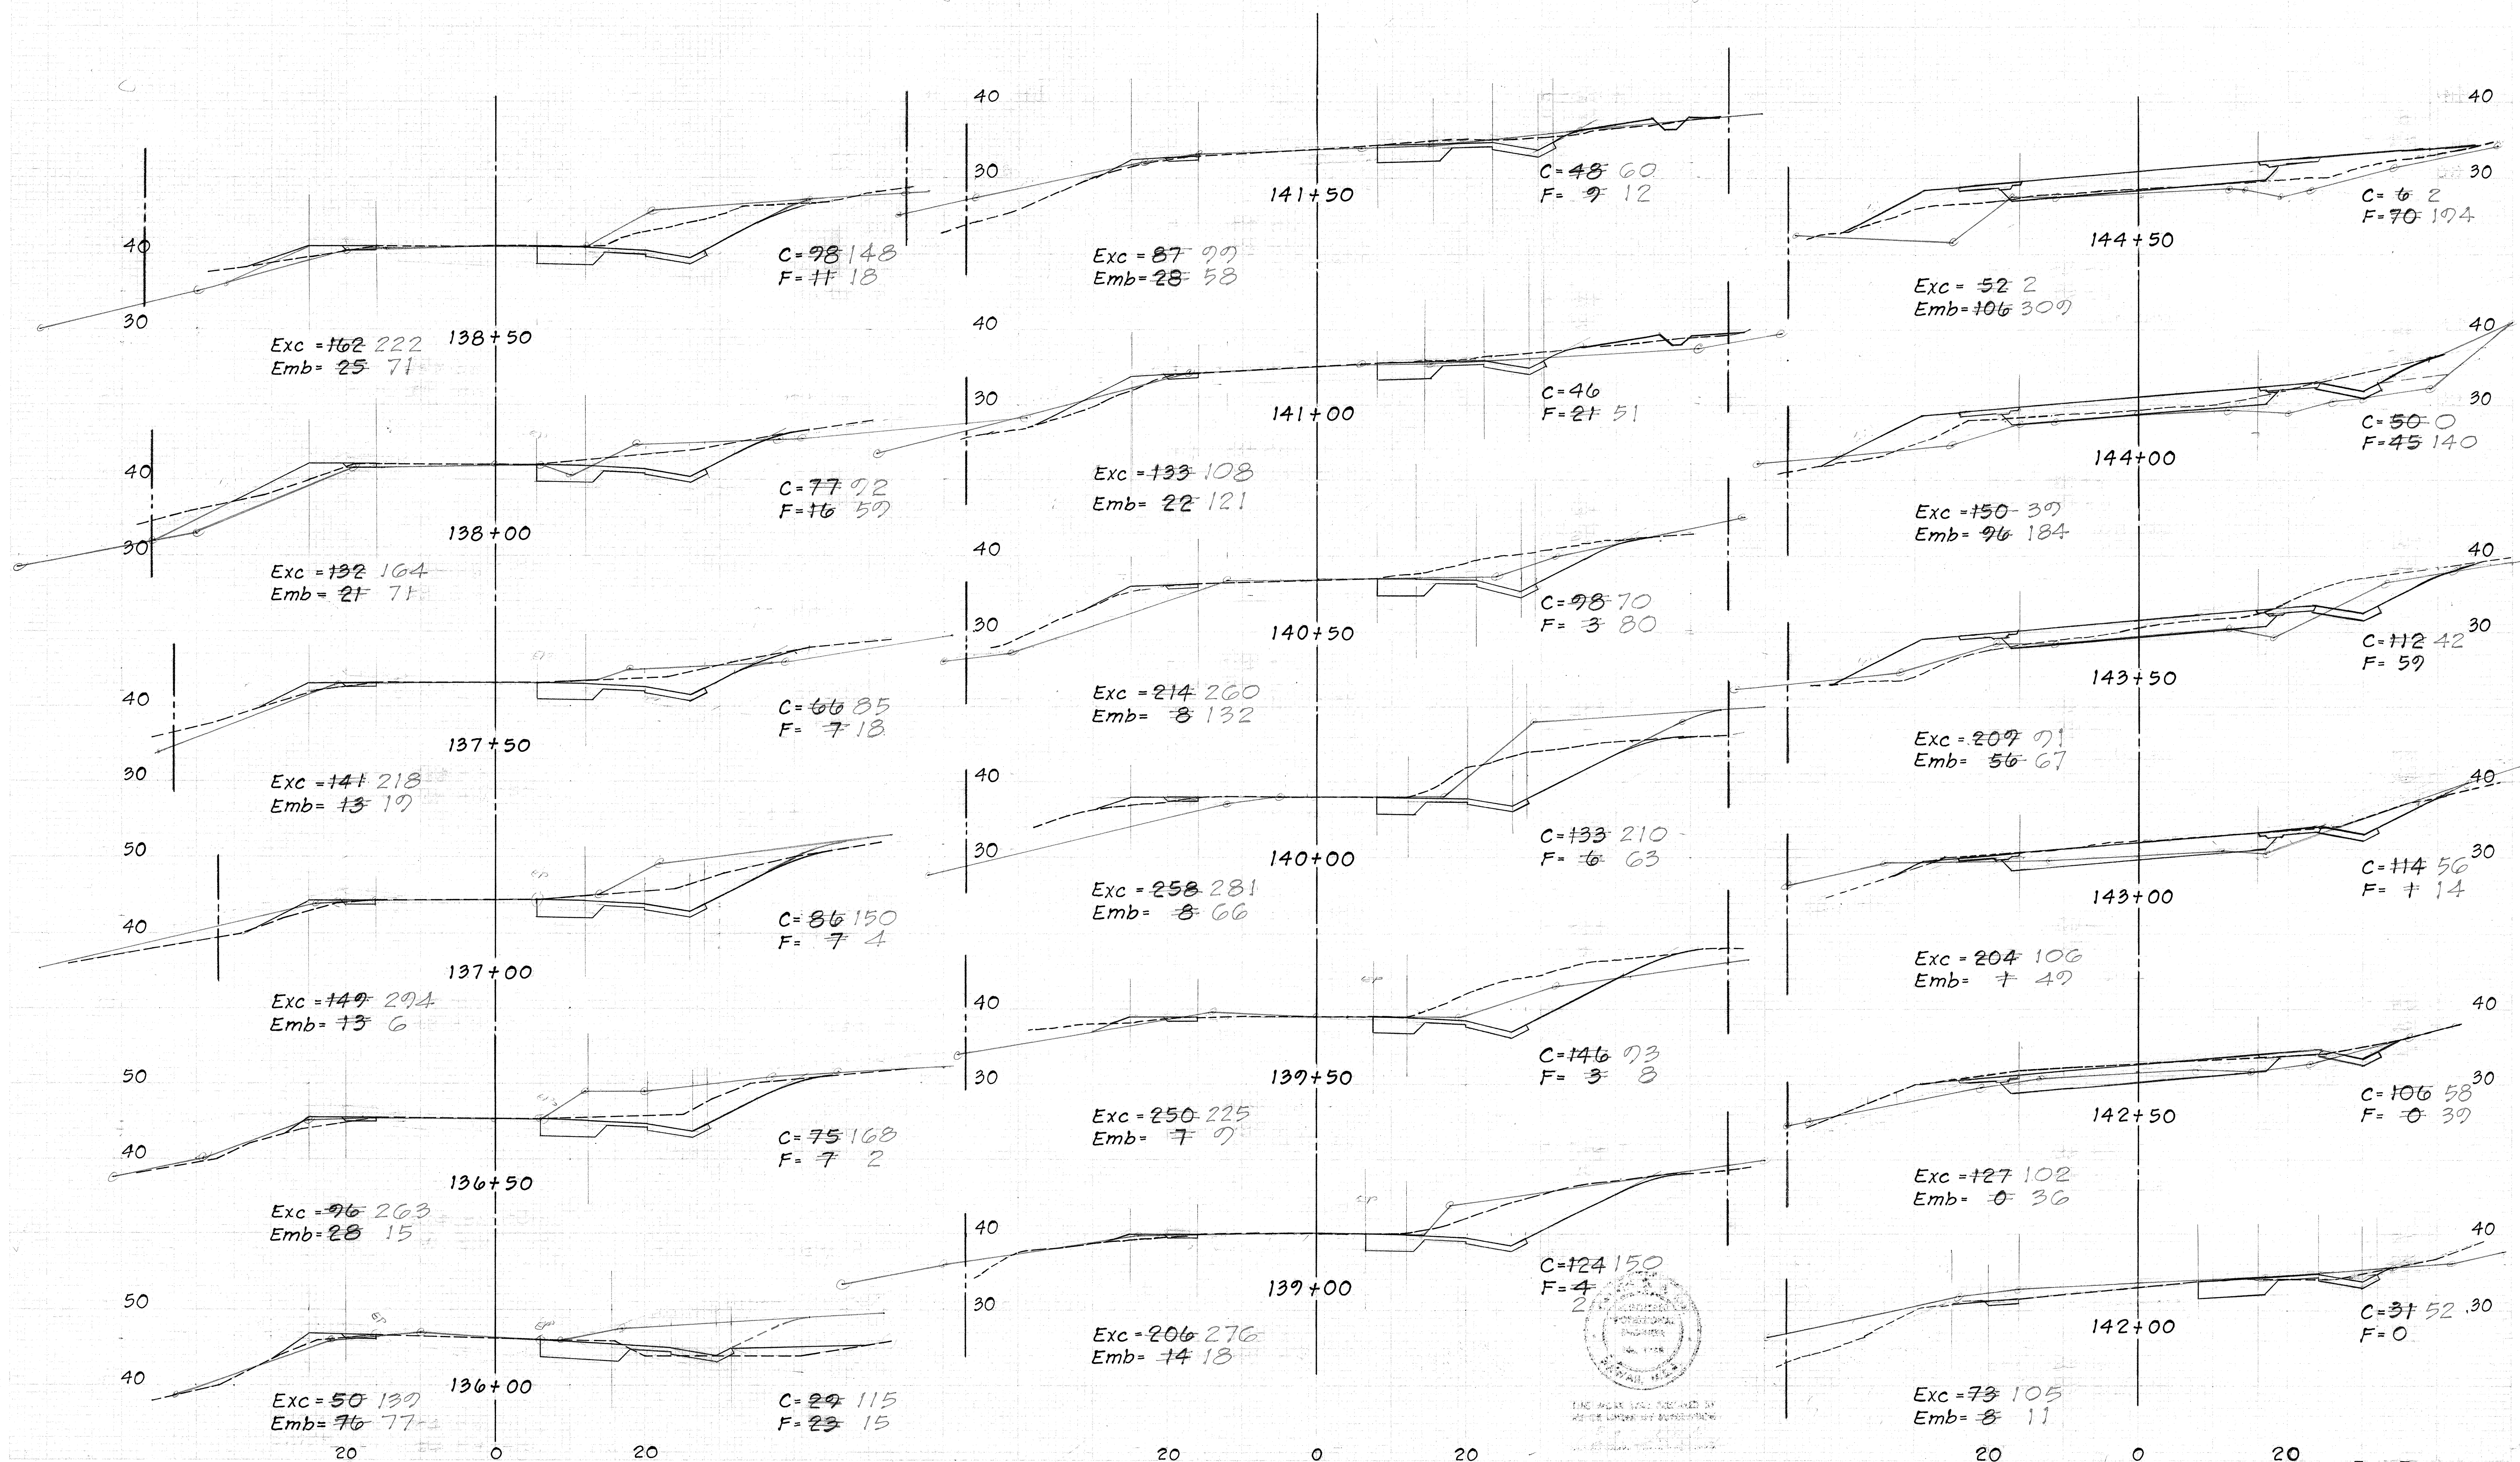



| FED. ROAD DIST. NO. | STATE | PROJ. NO. | FISCAL YEAR | SHEET NO. | TOTAL SHEETS |
|---------------------|-------|-----------|-------------|-----------|--------------|
| HAWAII              | HAW.  | 72A-01-71 | 1975        | 42        | 42           |

# EARTHWORK SUMMARY

Total Excavation 5,757 C.Y.  
Total Embankment 1,474 C.Y.

ADJUSTED TOTAL  
5,773.4  
2,947.3

