INDEX		TO	DRAWINGS
SHEET NO.	DESCRIPTION		
	TITLE	SHEET	
* ~ 2 *** ×	- 10 Maria	n gi rmaniani en az on girazotanian no	TING PLAN, SINGLE LINE SYMBOLS
3	STREE	T LIGH	T STANDARD AND DETAILS
4	PULL BOX DETAILS		
		:	
		,	
	,		
Material Control of the Control of t			



STATE OF HAWAII


DEPARTMENT OF TRANSPORTATION HIGHWAYS DIVISION


> HONOLULU, HAWAII

> > "AS BUILT"

PLANS FOR KALANIANAOLE HIGHWAY, HIGHWAY LIGHTING AT KEOLU DRIVE PROJECT NO. 72A-01-75

> DISTRICT OF KOOLAUPOKO ISLAND OF OAHU

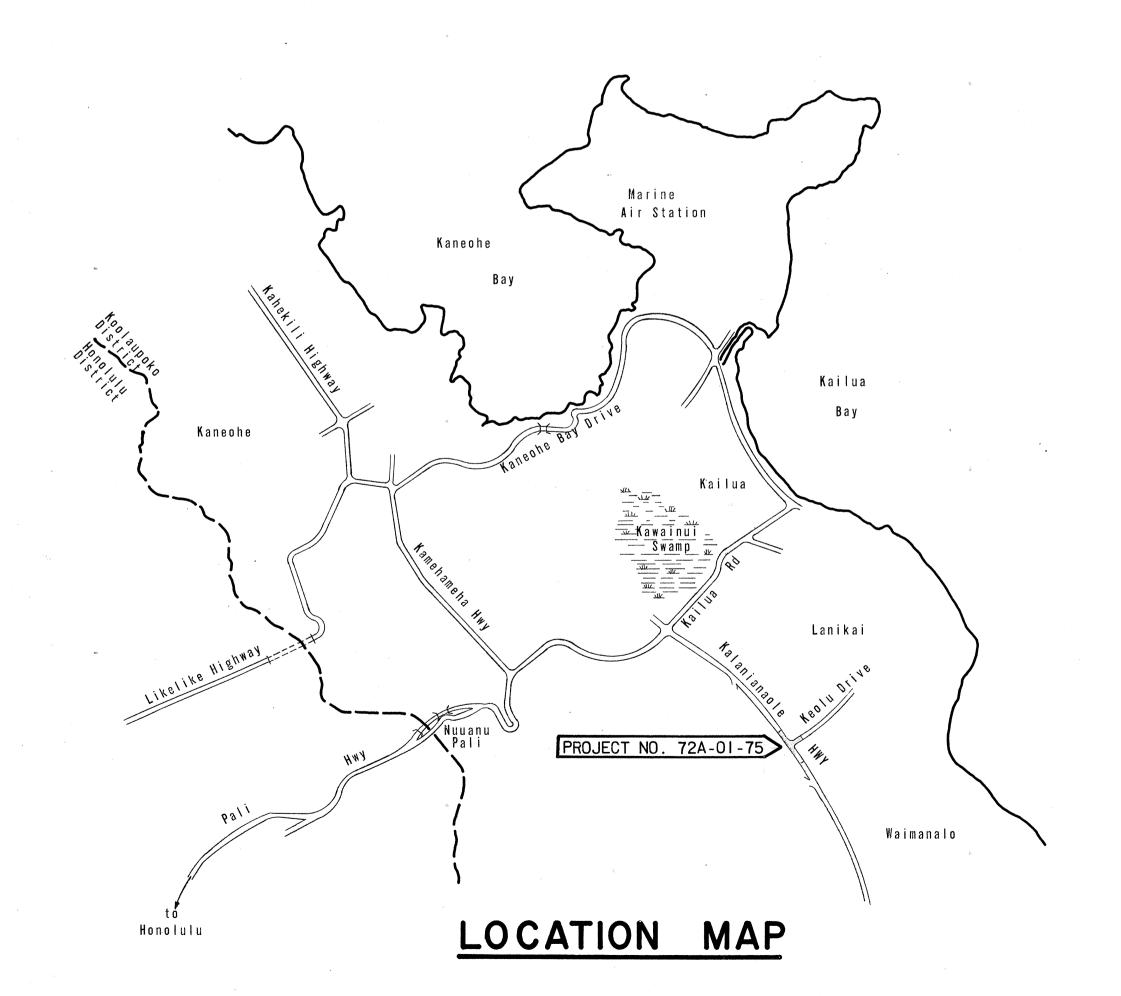

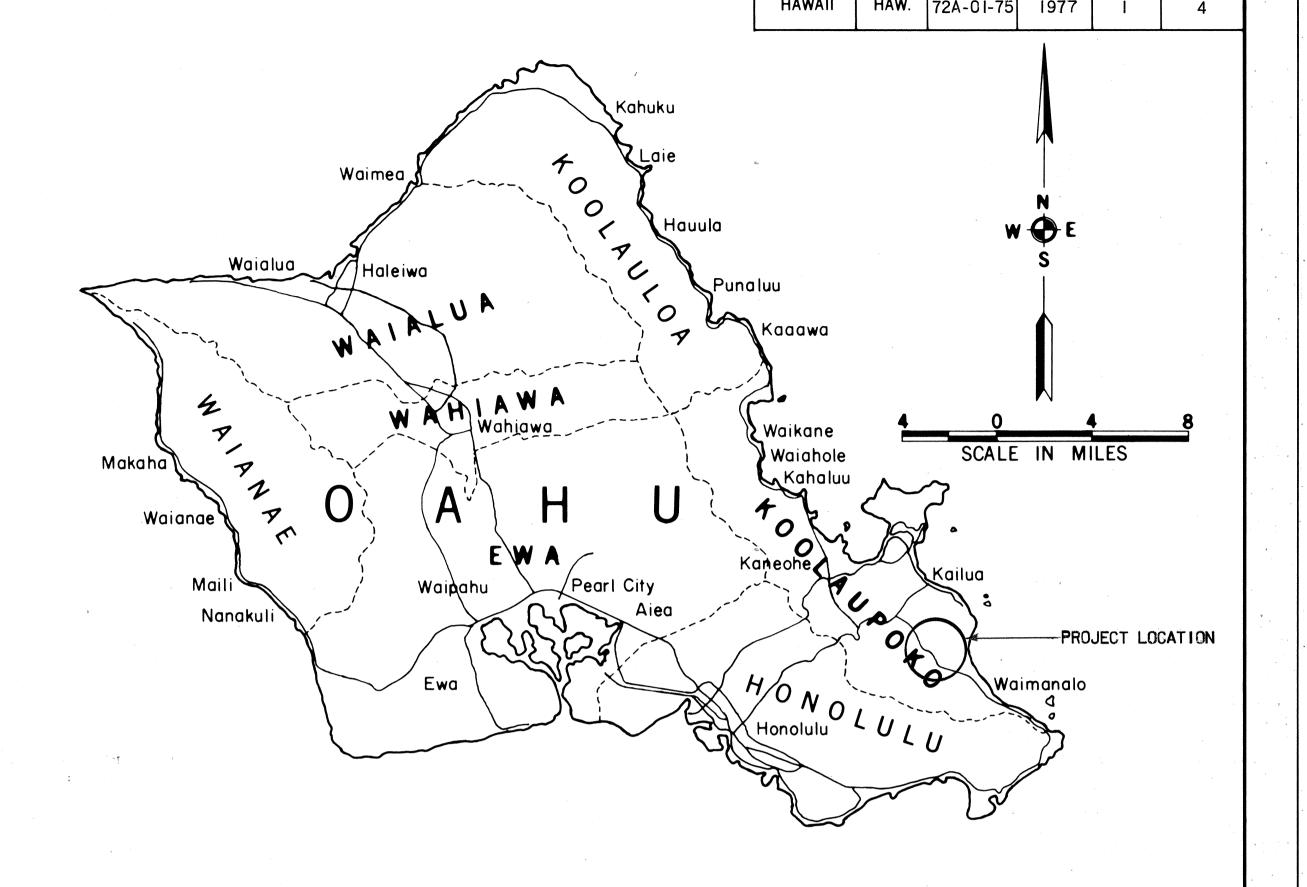

ALBERT CHONG ASSOCIATES, INC. 765 AMANA ST., SUITE 408 HONOLULU, HAWAII 96814

DEPARTMENT OF TRANSPORTATION STATE OF HAWAII APPROVED: DIR. OF FRANSPORTATION