


FED. ROAD DIST. NO.	STATE	FED. AID PROJ. NO.	FISCAL YEAR	SHEET NO.	TOTAL SHEETS
HAWAII	HAW.	F-2001(28)	1978	2	39

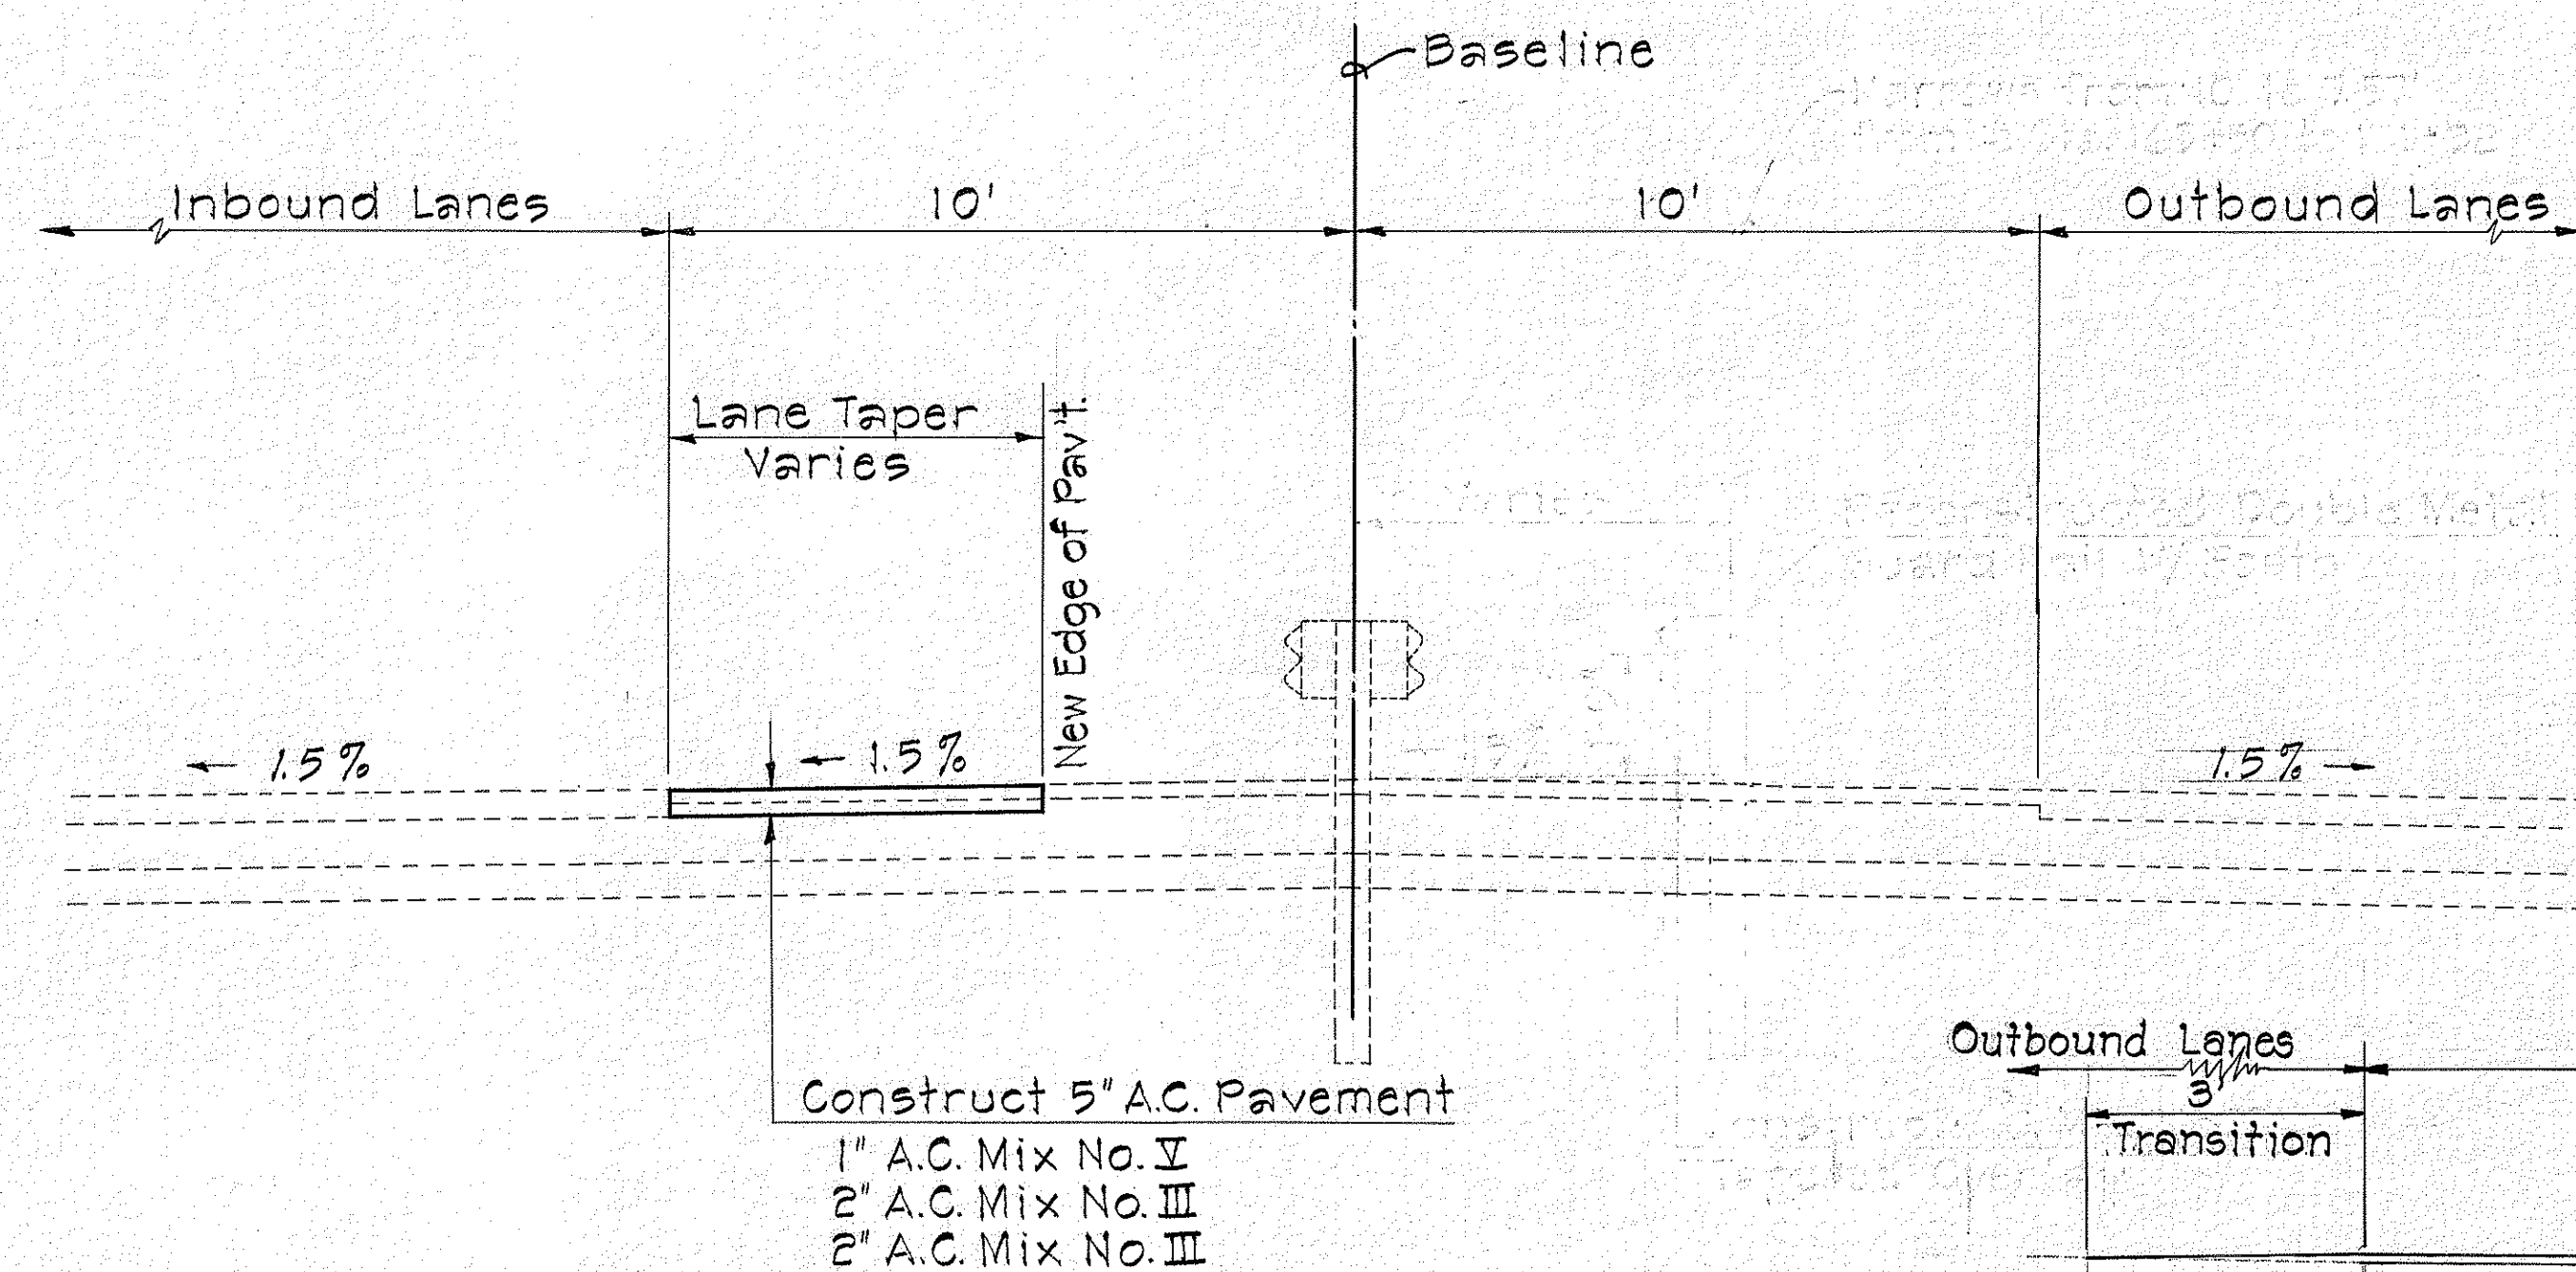


TYPICAL SECTION

B STA. 165+60 TO 171+32

§ STA. 171+80.08 TO 172+05


Scale: $\frac{3}{8}'' = 1' - 0''$

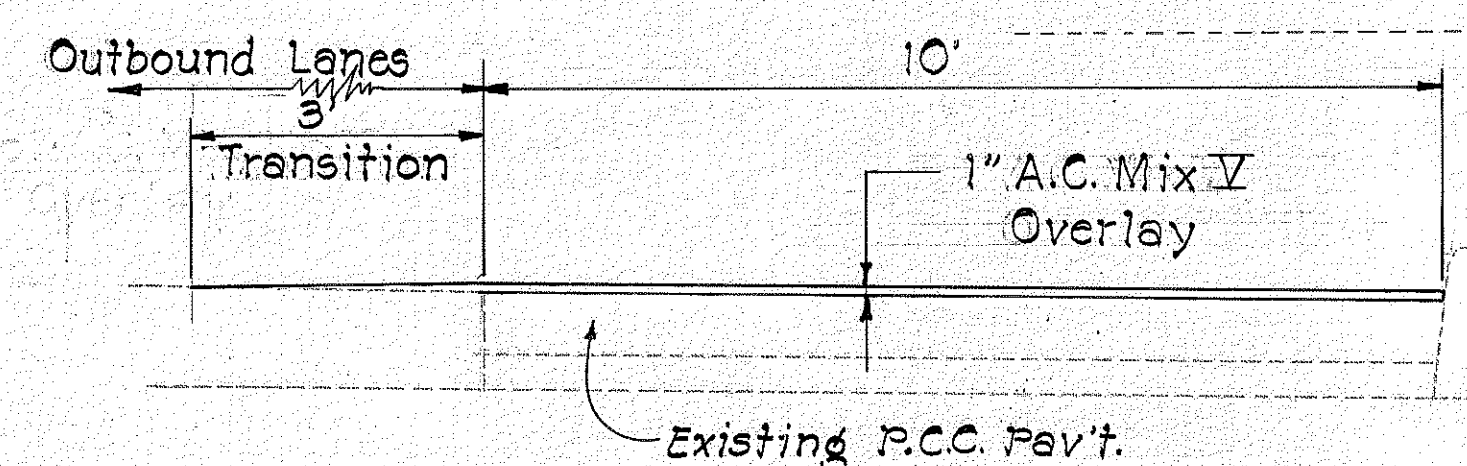

TYPICAL SECTION AT BUS STOP

§ STA. 0 + 52 TO 2 + 90 RT.


Scale: $1/2" = 1' - 0"$

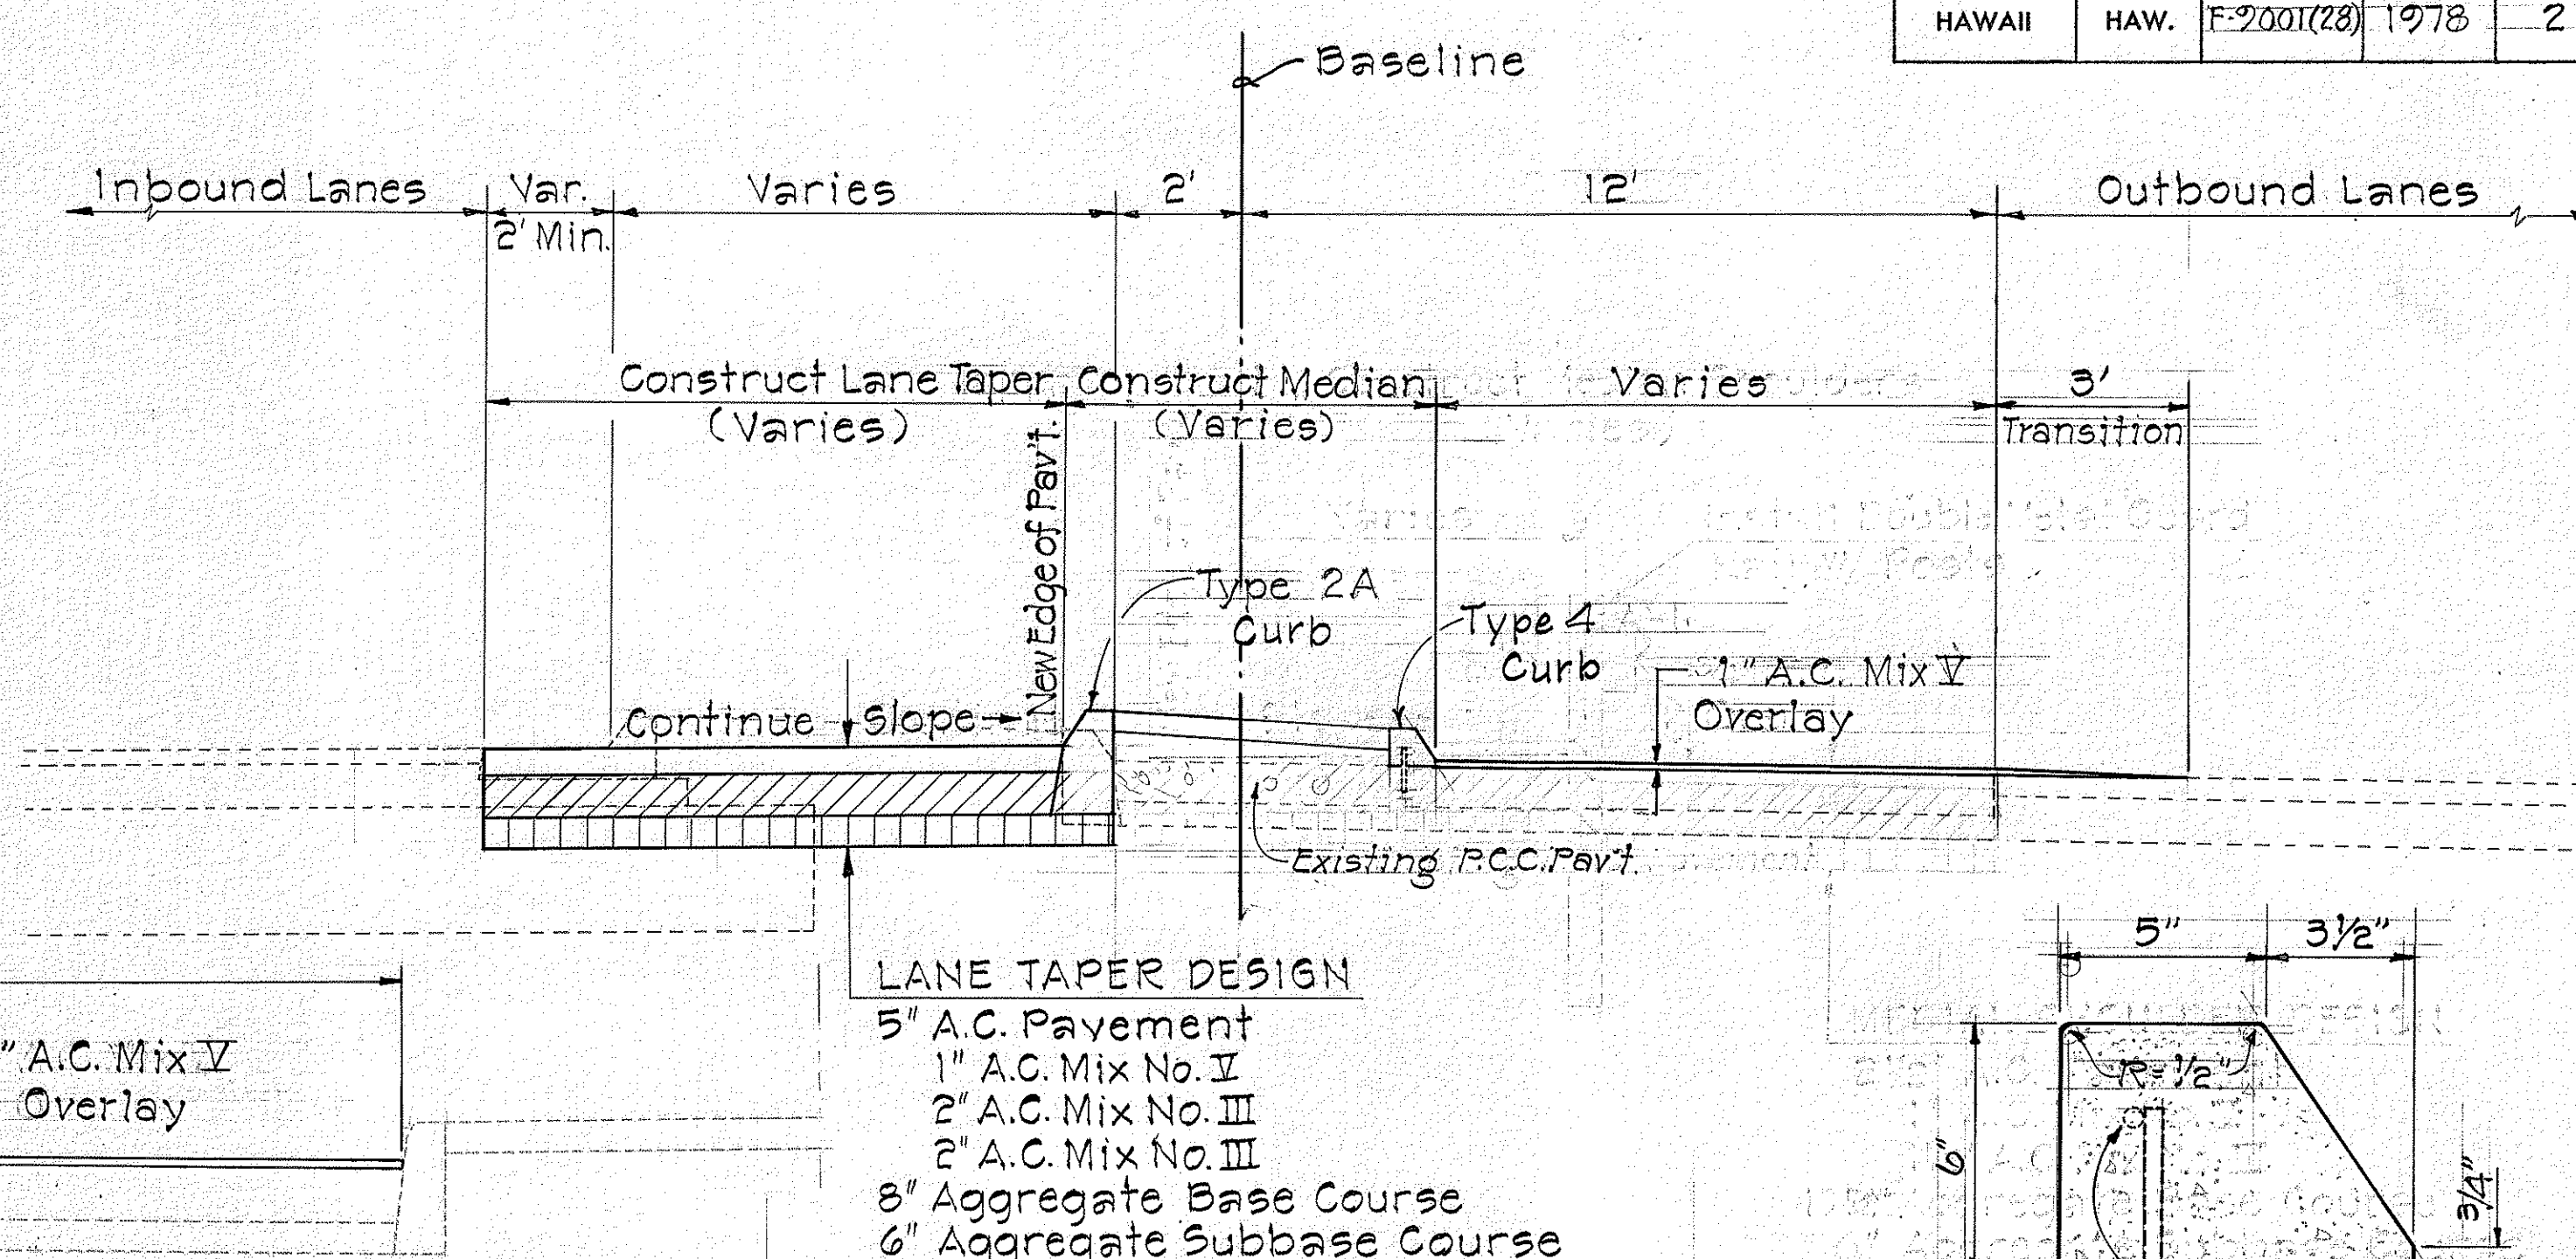

TYPICAL SECTION


§ STA. 173+25 TO 175+13

Scale: $\frac{3}{8}'' = 1' - 0''$

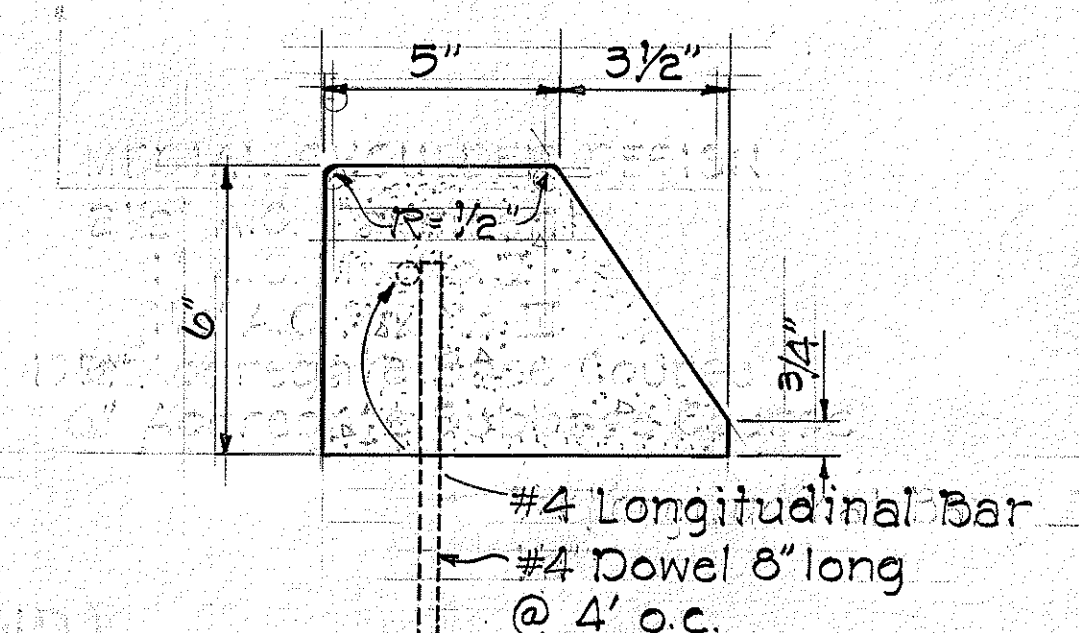

CURB TYPE 4
CAST-IN-PLACE


Scale: 3" = 1' - 0"

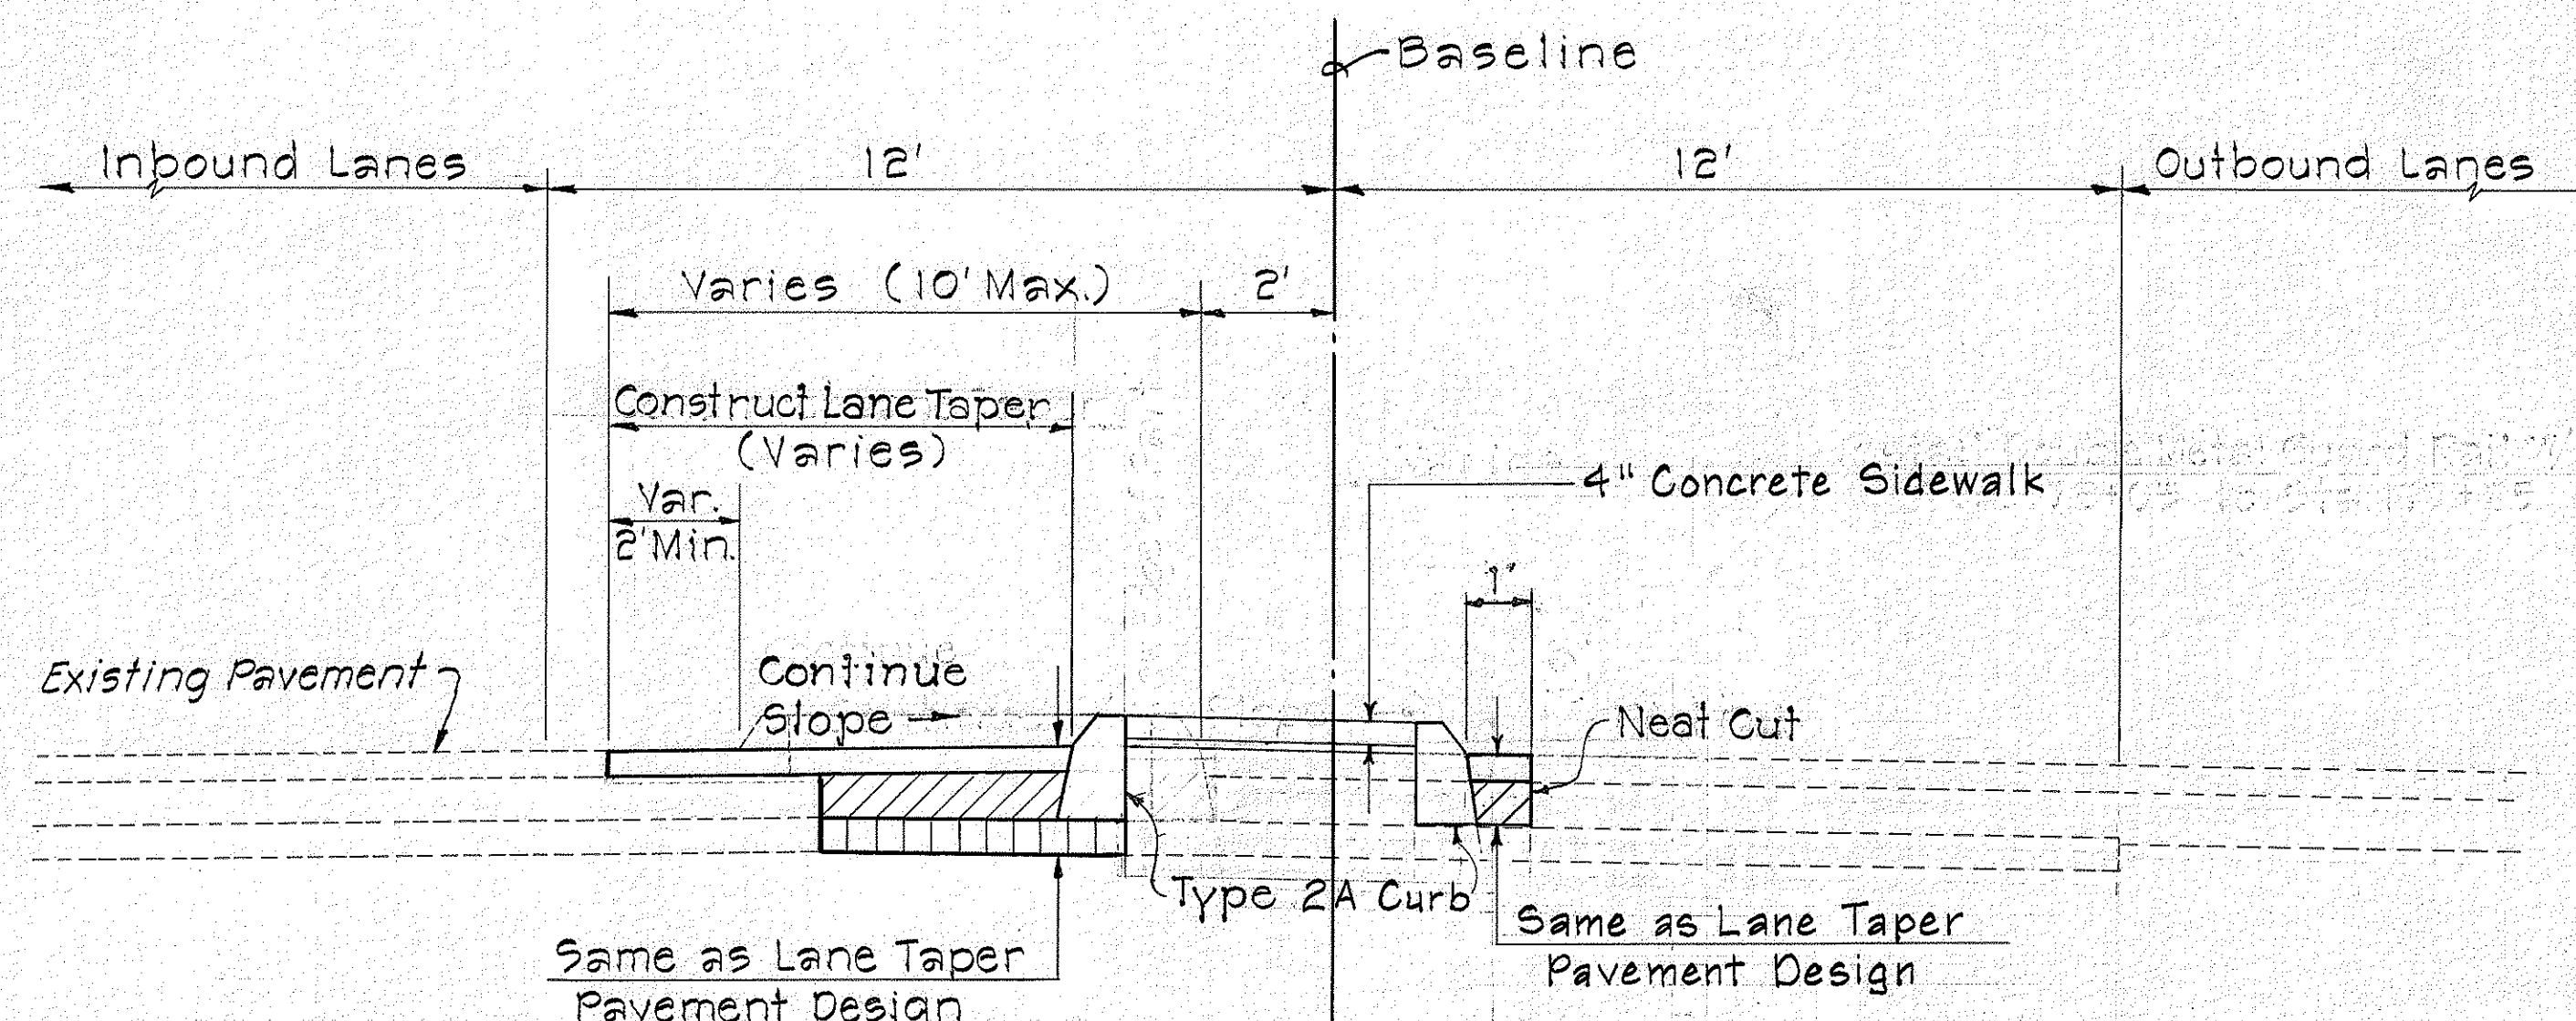

TYPICAL SECTION

§ STA. 172 + 05 TO 173 + 25

Scale: $\frac{3}{8}'' = 1' - 0''$

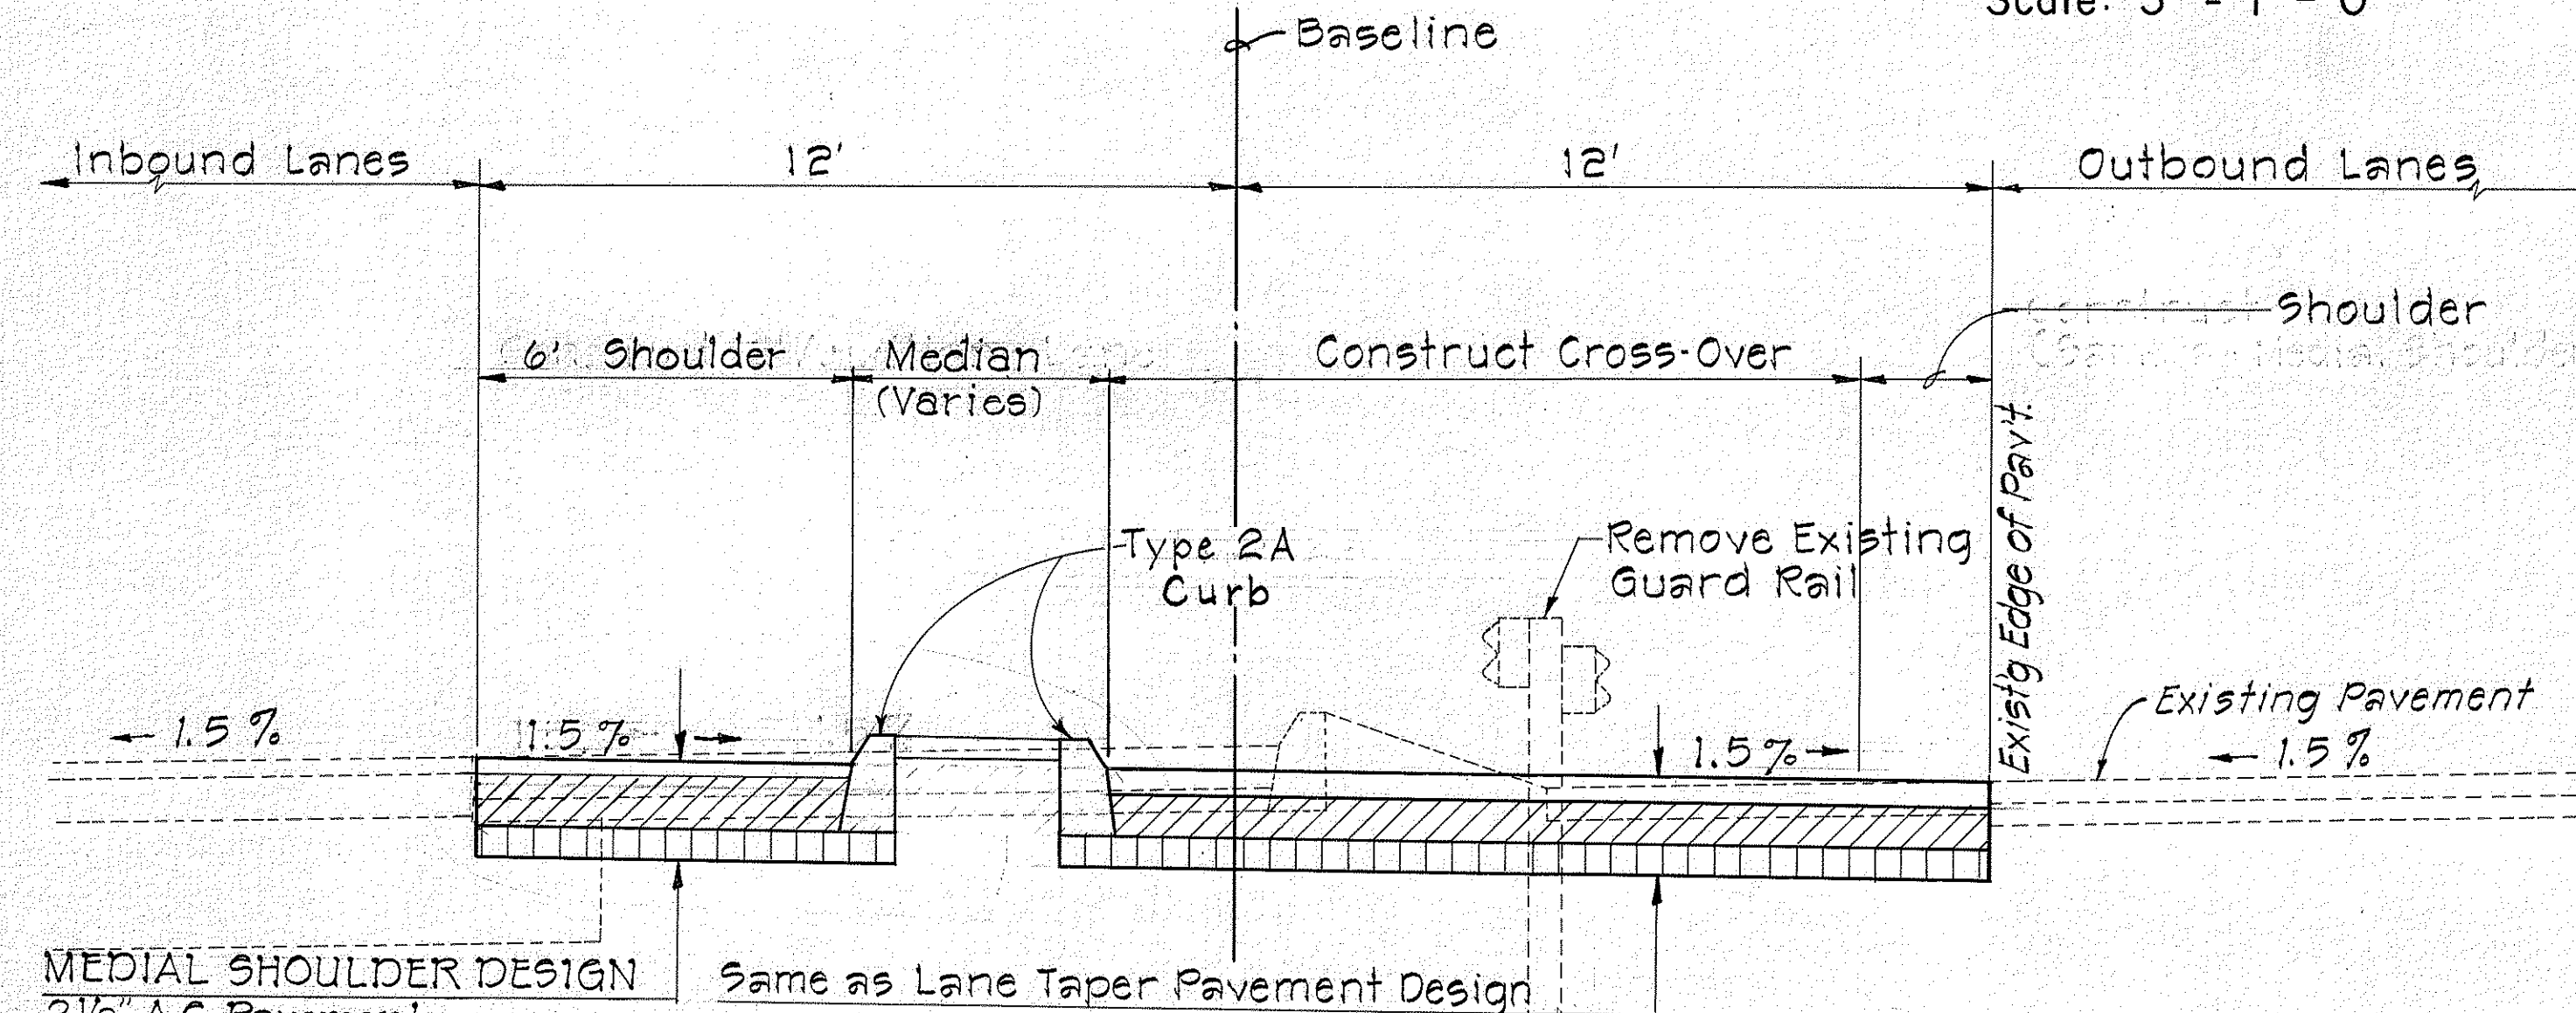

TYPICAL SECTION

CROSS-OVER, VICINITY OF AINAKOA AVE.

Scale: $\frac{3}{8}'' = 1' - 0''$

ORIGINAL PLAN	SURVEY PLOTTED BY	DATE
	DRAWN BY	"
	TRACED BY	"
NOTE BOOK	DESIGNED BY	"
	QUANTITIES BY	"
No.	CHECKED BY	"

STATE OF HAWAII
DEPARTMENT OF TRANSPORTATION
LAND TRANSPORTATION FACILITIES DIVISION

TYPICAL SECTIONS

KALANIANA'OLE HIGHWAY
CONTRA-FLOW LANE VICINITY OF AINAKOA AVE
TO KIRKWOOD STREET

PROJECT NO. F-9001 (28)

SHEET No. 1 OF 1 SHEETS