11	NDEX TO DRAWI	NGS
SHEET NO	DESCRIPTION	ON
	TITLE SHEET	
2	LAYOUT - STA.0+00 TO ST	ΓΑ. 24+00
3	LAYOUT - STA.24+00 TO S	STA.54+00
4	LAYOUT - STA.54+00 TO S	STA. 82+00
.5	LAYOUT - STA.82+00 TO S	STA. 108+00
6	MISCELLANEOUS DETAILS	
t .	·	
^	·	
		. (
,		1
•		
,	,	
1		
		<del></del>



STATE OF HAWAII

## DEPARTMENT OF TRANSPORTATION LAND TRANSPORTATION FACILITIES DIVISION

HONOLULU, HAWAII
"AS-BUILT"
PLANS FOR

KALANIANAOLE HIGHWAY


STREET LIGHT IMPROVEMENTS,


KIRKWOOD TO HAWAII KAI DRIVE

PROJECT NO. 72C-OI-75

DISTRICT OF HONOLULU

ISLAND OF OAHU

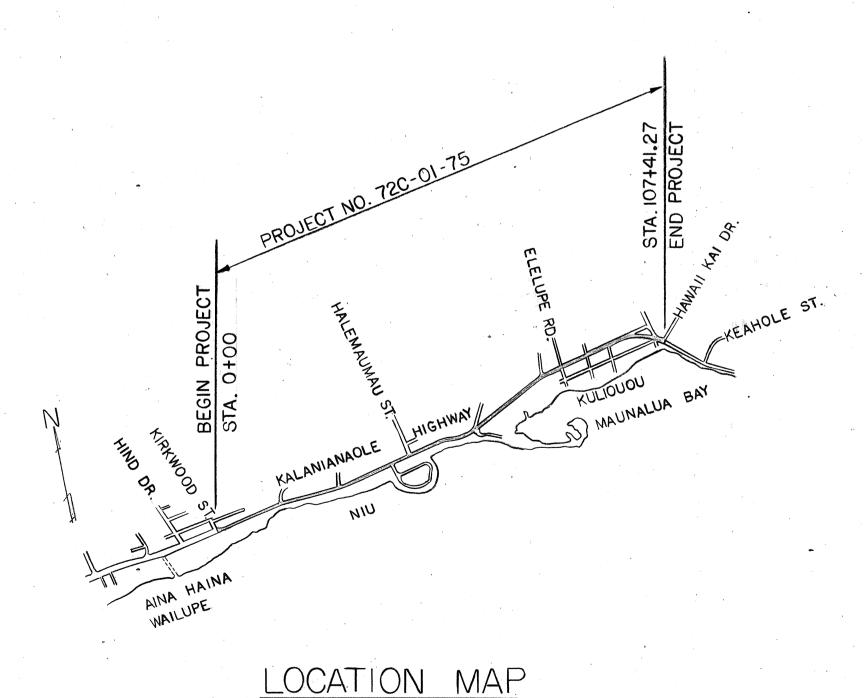

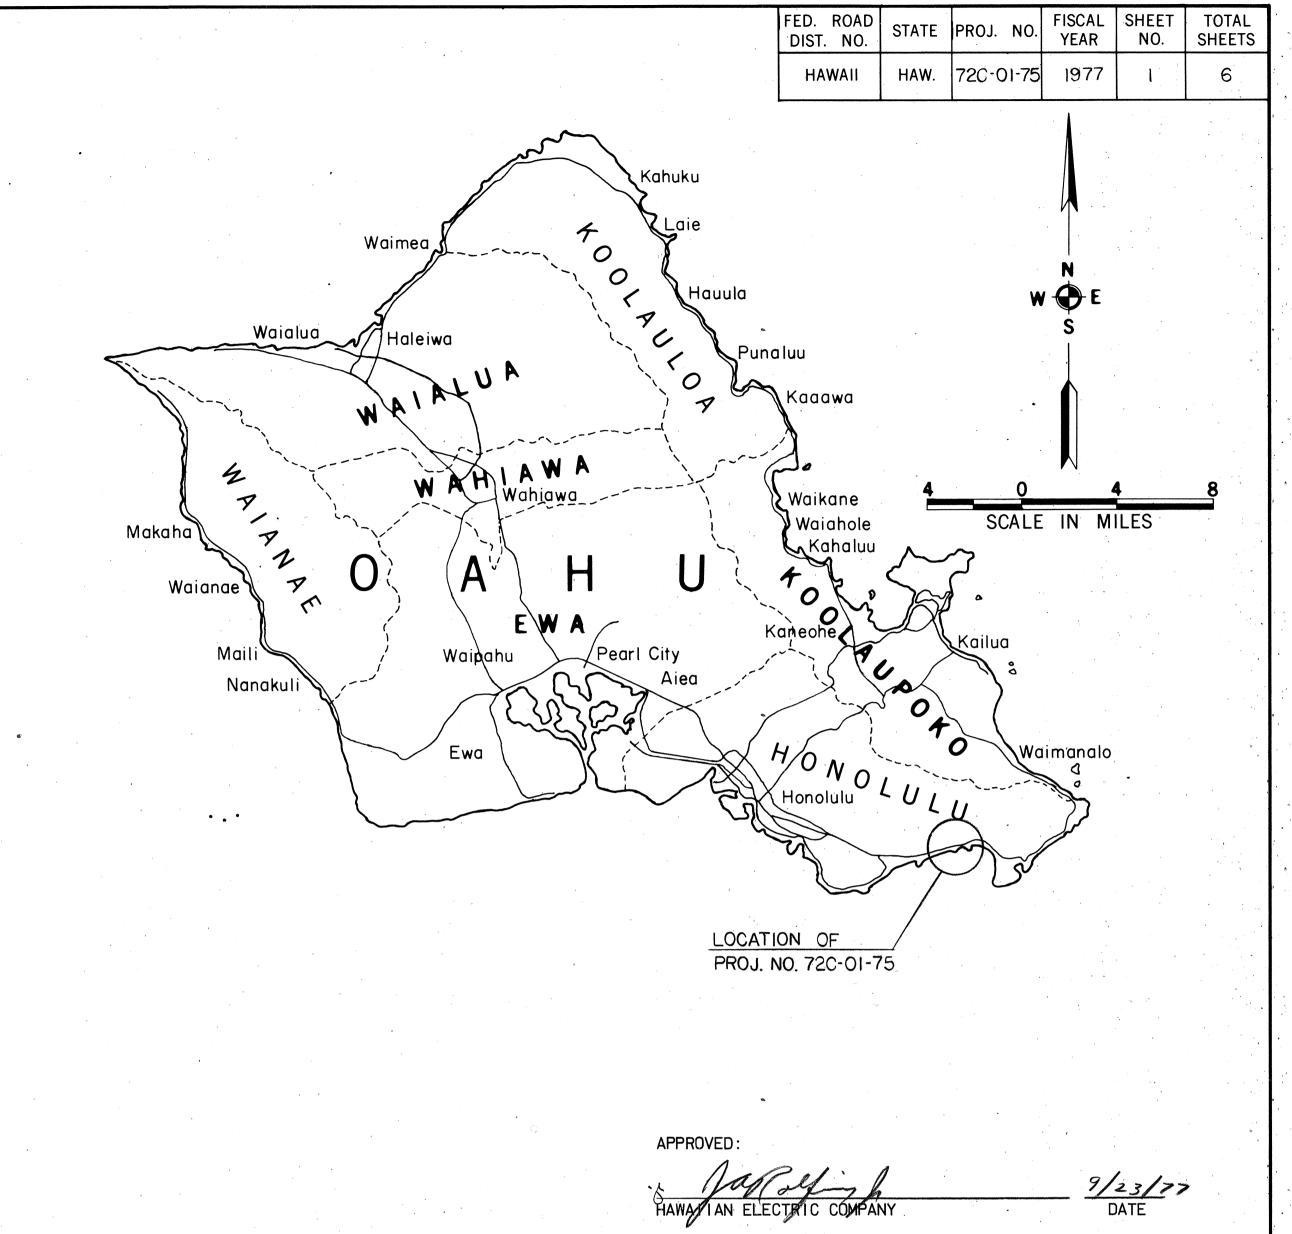

ALL CHANGES MADE DURING CONSTRUCTION HAVE BEEN INCORPORATED ON THESE PLANS IN RED EXCEPT CHANGES IN THE ORIGINAL THEORETICAL QUANTITIES. FOR ACTUAL QUANTITIES, REFER TO PROJECT LEDGER AND/OR COMPUTATION BOOK.

Dennis T. High RESIDENT ENGINEER Nov. 18, 1981 DATE

DEPARTMENT OF TRANSPORTATION
STATE OF HAWAII

APPROVED:

R Higashianna 11/22/77

DIR. OF TRANSPORTATION DATE

ASSOC. JAMES SUGIHARA 548-6932 SEP

SCALE: 1" = 2000'